


TNK-S220A
1:25


ITEM No.	SIZE	SERVICE
A	200	VENT
B	50	FILL
C	75	FILL
D	100	LEVEL ELEMENT
E	600	MANWAY
F	50	SUCTION
G	750	MANWAY
H	100	OVERFLOW C/W INTERNAL LR 90° ELBOW
I	50	DRAIN
J	50	LEVEL GAUGE

NOTE:


- SEE STRUCTURAL DRAWINGS FOR HOUSE KEEPING PAD DETAILS.

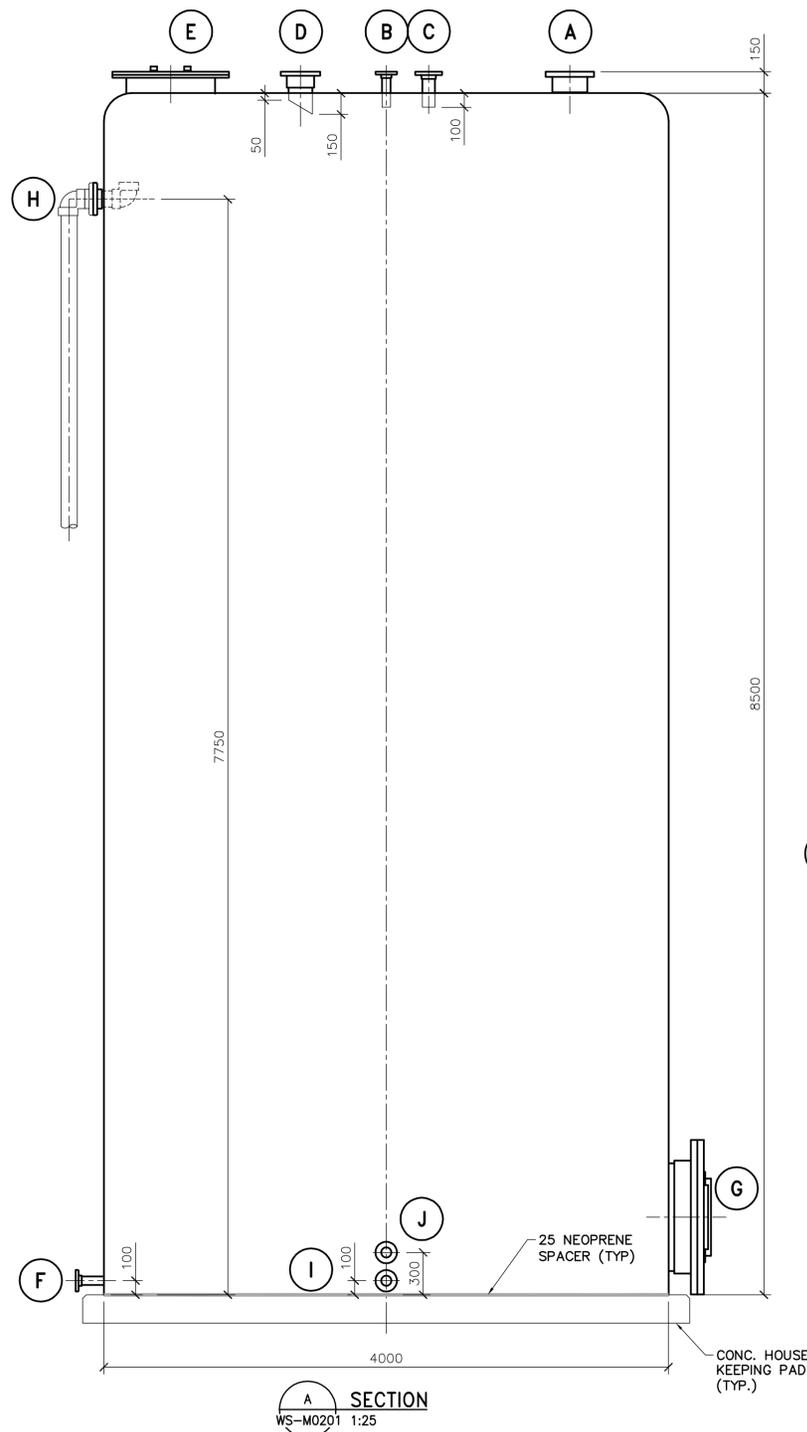

SECTION A
WS-M0201 1:25

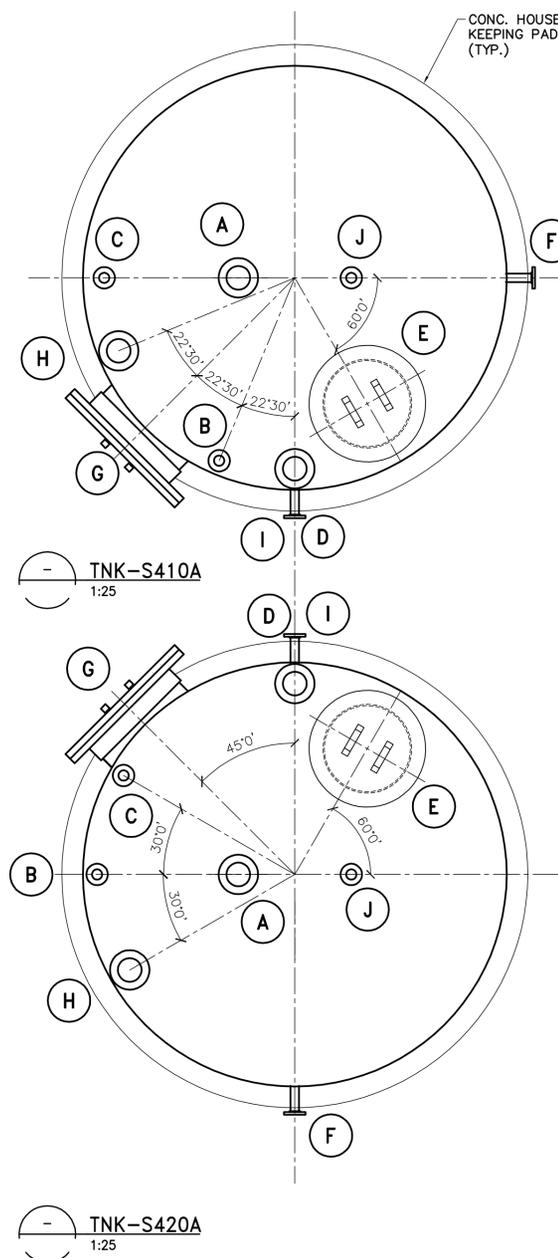

TNK-S420A
1:25

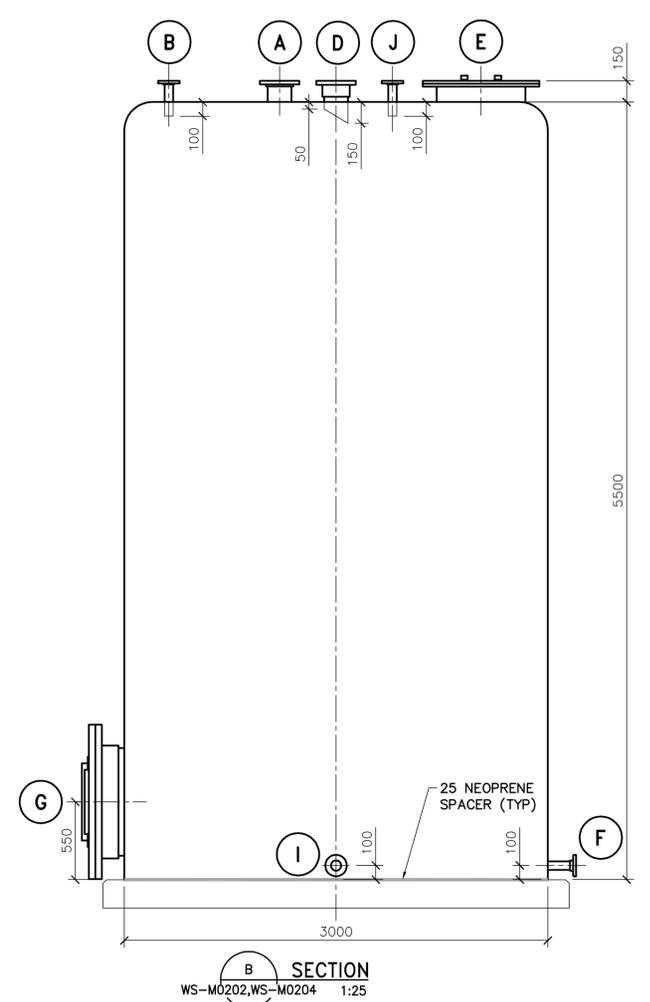

SECTION B
WS-M0202, WS-M0204 1:25

ITEM No.	SIZE	SERVICE
A	150	VENT
B	50	FILL
C	50	VACUUM RELIEF
D	100	LEVEL ELEMENT
E	600	MANWAY
F	50	SUCTION
G	750	MANWAY
H	100	LEVEL ELEMENT
I	50	DRAIN
J	50	TRAP DRAIN

AECOM

As of January 3, 2009, EarthTech became AECOM Canada Ltd.

AECOM AS-CONSTRUCTED

SIG..... DATE.....

AECOM
Certificate of Authorization
AECOM Canada Ltd.
Original dated on:
No. 4671 Date: 2007/01/31

NO.	REVISIONS	DATE	BY	DATE	BY
02	AS CONSTRUCTED	2009/07/03	GLG		
01	ISSUED FOR CONSTRUCTION	07/05/25	LAE		
00	ISSUED FOR TENDER	07/01/31	JBC		

DESIGNED BY	SBW	CHECKED BY	SRB
DRAWN BY	JBC	APPROVED BY	AHL
SCALE:	AS NOTED	RELEASED FOR CONSTRUCTION BY:	R. SOROKOWSKI
DATE	2006/03/15	DATE	2007/01/31

ENGINEER'S SEAL
ORIGINAL SIGNED BY
S.B. WILLIAMSON
2007/01/31
CONSULTANT DRAWING NO.
WS-M0452

THE CITY OF WINNIPEG
WATER AND WASTE DEPARTMENT
ENGINEERING DIVISION
Winnipeg
WATER TREATMENT PLANT
BULK CHEMICAL BUILDING
SODIUM HYPOCHLORITE AND CHEMICAL STORAGE BUILDING
PROCESS MECHANICAL
SULPHURIC ACID / AQUA AMMONIA
TANK DETAILS
CITY FILE NUMBER
SHEET OF
CITY DRAWING NUMBER
1-0601S-M0049-001-02