




SEUNING 40-105-500-11-74 #

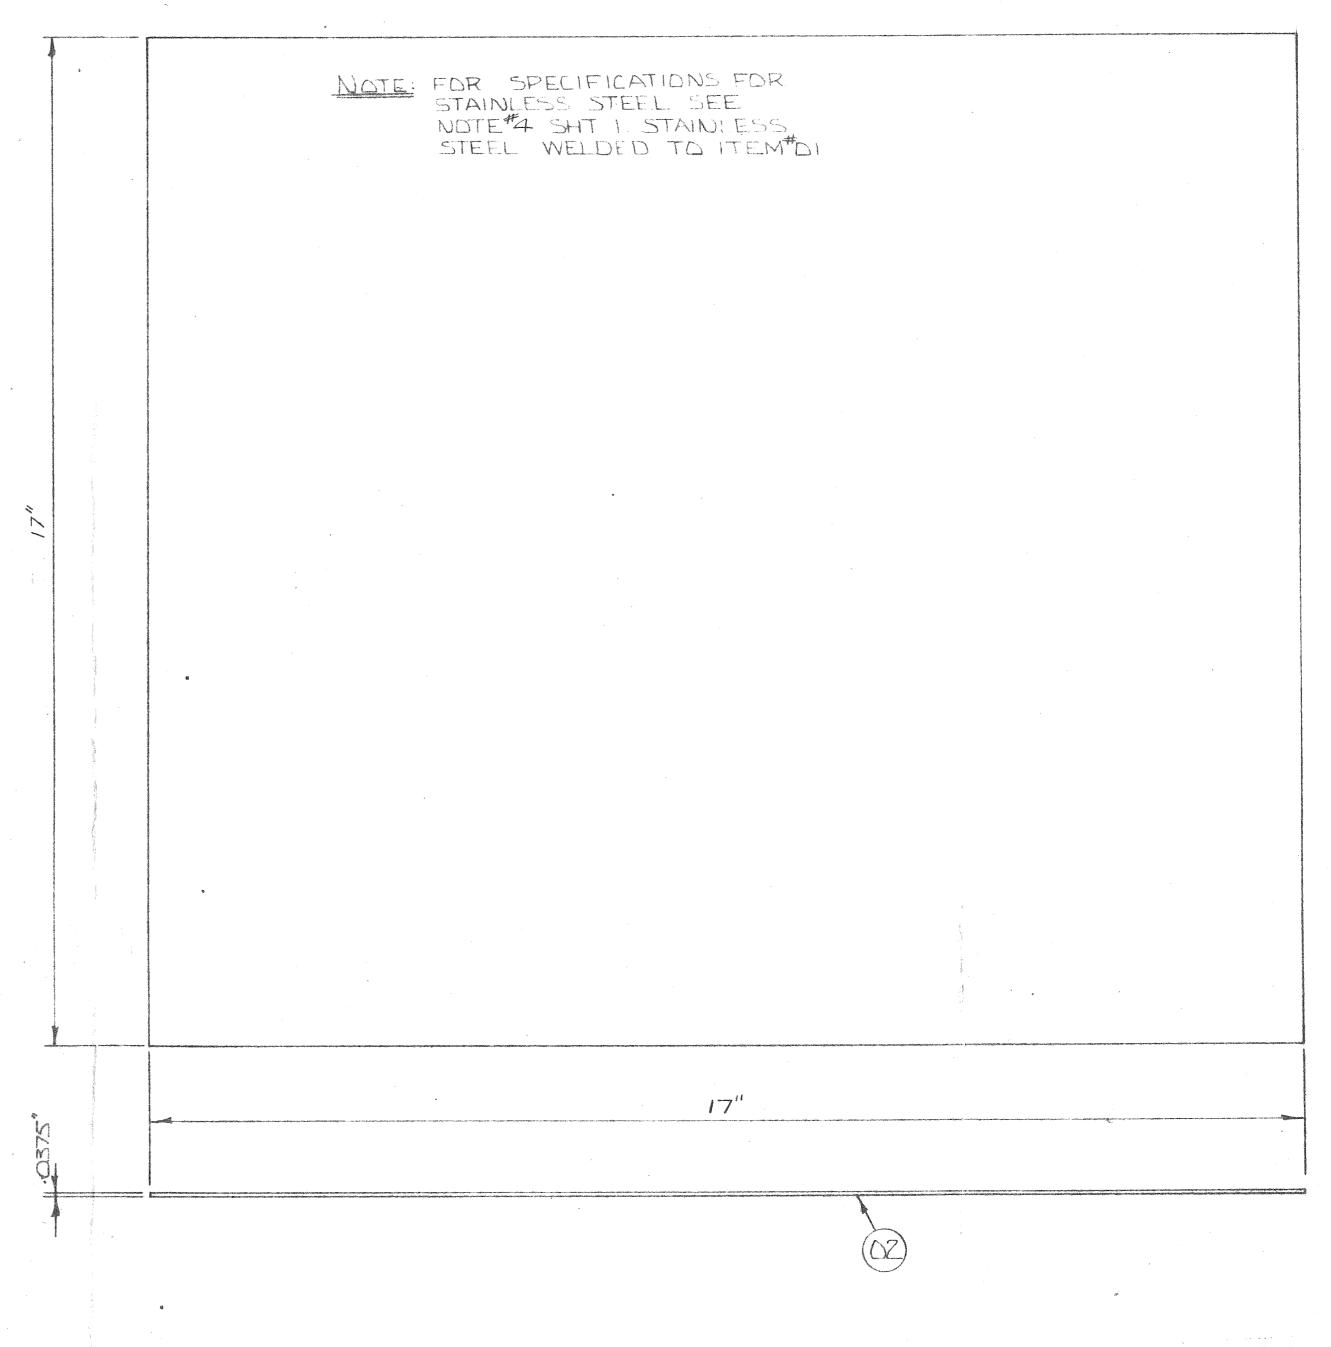

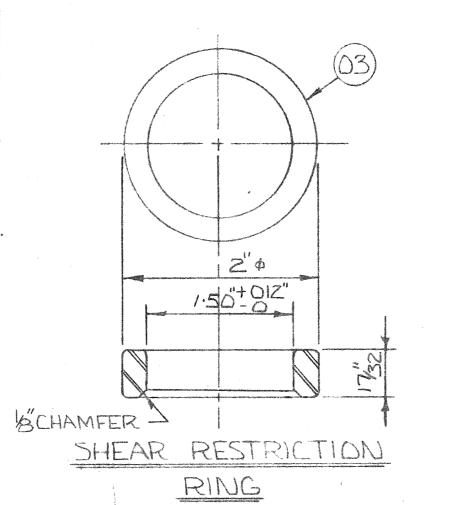

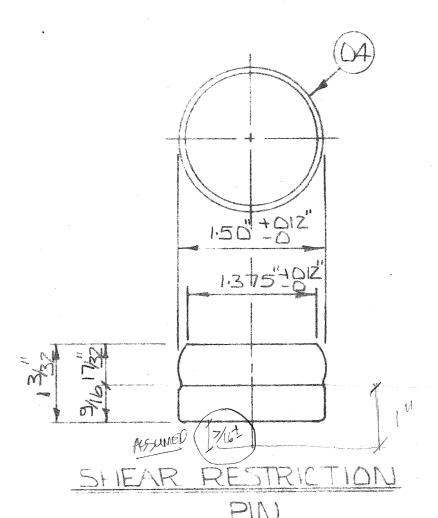

REID, CROWTHER & PARTNERS LIMITED

REVIEWED ONLY

MATERIAL MUST MEET REQUIREMENTS OF SPECIFICATIONS
AND DRAWINGS. APPROVAL OF DIMENSIONS AND OTHER
GENERAL CONSTRUCTION FEATURES NOT IMPLIED.
CORRECTIONS ARE REQUIRED WHERE NOTED IN RED

- NOTE 
INFORMATION AND KNOWHOW

ON THIS DRAWING IS THE

PROPERTY OF

ELASTOMETAL LIMITED

USE OR REPRODUCTIONS

OF THIS DRAWING IS

PROHIBITED WITHOUT

DWG. NO.: E-669

PROJECT: OSBORNE ST. BRIDGE

ELASTOMETAL LIMITED

DRAWN BY: EVAN TAYLOR PROJECT #62-71 DATE: JAN 201

CHECKED BY: SHEET 2 OF 3 SCALE: N.T.S.

WABO-FYFE MULTIDIRECTIONA 75 TON BRI