


- CONSTRUCTION NOTES**
- 250 RAS - PVC SERIES 160
  - 200 WAS - PVC SERIES 160
  - 50 FW - HDPE SERIES DR11 IPS

- GENERAL NOTES:**
- BASELINE MEASURED DOWN CENTERLINE OF TRENCH.
  - EARTH TECH FIELD BOOK No. 4401
  - LOCATION OF UNDERGROUND STRUCTURES AS SHOWN ARE BASED ON THE BEST INFORMATION AVAILABLE, BUT NO GUARANTEE IS GIVEN THAT ALL EXISTING UTILITIES ARE SHOWN OR THAT THE GIVEN LOCATIONS ARE EXACT. CONFIRMATION OF EXISTENCE AND EXACT LOCATION OF ALL SERVICES MUST BE OBTAINED FROM THE INDIVIDUAL UTILITIES BEFORE PROCEEDING WITH CONSTRUCTION.

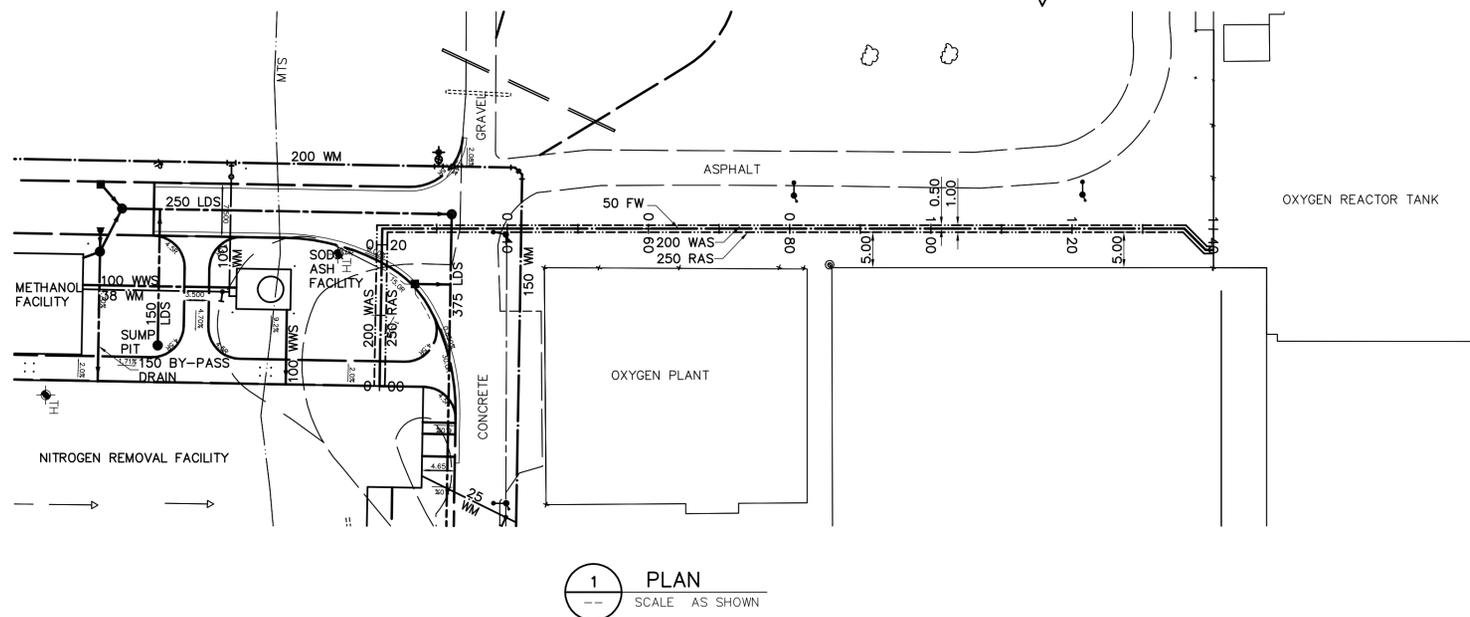

**AECOM**  
As of January 3, 2009, EarthTech became AECOM Canada Ltd.

**AECOM AS-CONSTRUCTED**  
SIG..... DATE.....

150 mm W.M.	WATERMAIN	150 mm W.M.	HYDRO	M.T.S.	LIGHT STANDARD
300mm L.D.S.	LAND DRAINAGE SEWER	300mm L.D.S.	CONCRETE	ASPHALT	PROPERTY LINE
250mm W.W.S.	WASTEWATER SEWER	250mm W.W.S.	TEST HOLES	ELEVATION (32.750)	TREE
	MANHOLE		ANODE	CONCRETE SIDEWALK	FENCE
	CATCH BASIN				
	CURB INLET				
	JUNCTIONS				
	CULVERT				
	GAS				
EXISTING	LEGEND - PLAN	PROPOSED	EXISTING	LEGEND - PLAN	PROPOSED

**APEGN**  
Certificate of Authorization  
AECOM Canada Ltd.  
Original dated on: No. 4671 Date: 2006/05/15

02	AS-CONSTRUCTED DRAWING	09/04/06	DEP
01	ISSUED FOR CONSTRUCTION	06/08/30	GLG
00	ISSUED FOR TENDER	06/05/15	FC
NO.	REVISIONS	DATE	BY

**EarthTech**  
A Tyco International Ltd. Company

DESIGNED BY: GSK	CHECKED BY: KWF
DRAWN BY: FC	APPROVED BY: JEH
SCALE: HOR: 1:500 VERT: 1:50	RELEASED FOR CONSTRUCTION BY: K. MARTENS
DATE: 2006/01/16	DATE: 2006/05/15

ENGINEER'S SEAL  
ORIGINAL SIGNED BY: K.W. FITCHETT  
2006/05/15  
CONSULTANT DRAWING NO. C5.01

**THE CITY OF WINNIPEG**  
WATER AND WASTE DEPARTMENT  
ENGINEERING DIVISION

NEWPCC CENTRATE NUTRIENT TREATMENT NITROGEN REMOVAL FACILITY

CITY FILE NUMBER  
SHEET OF  
CITY DRAWING NUMBER  
1-0101C-C0007-001-02