




TNK-S310A
1:25

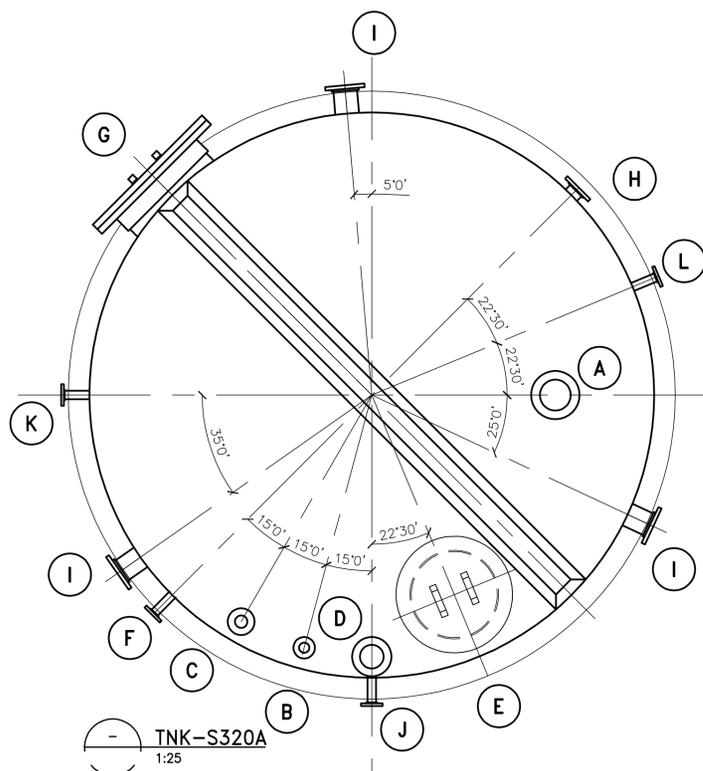

TNK-S320A
1:25

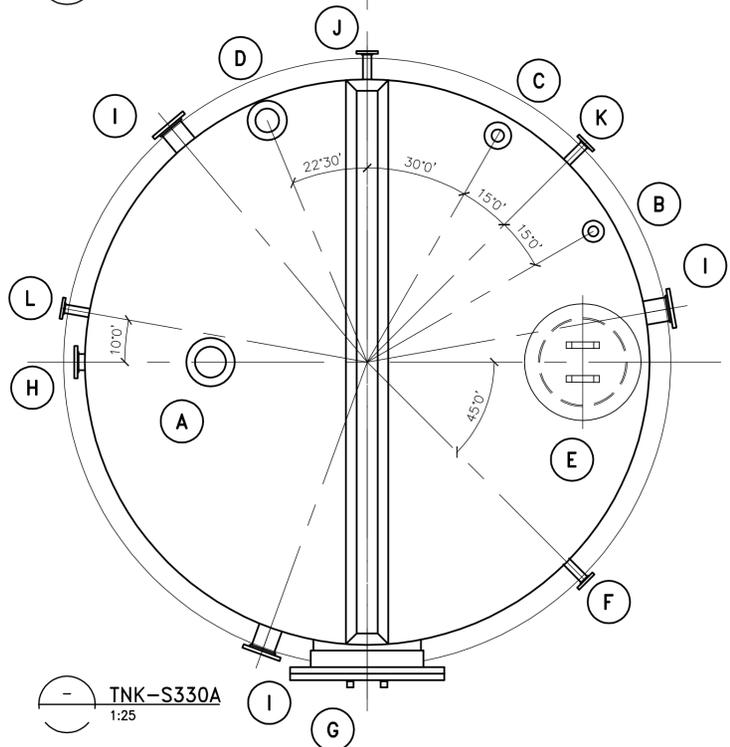


TNK-S330A
1:25

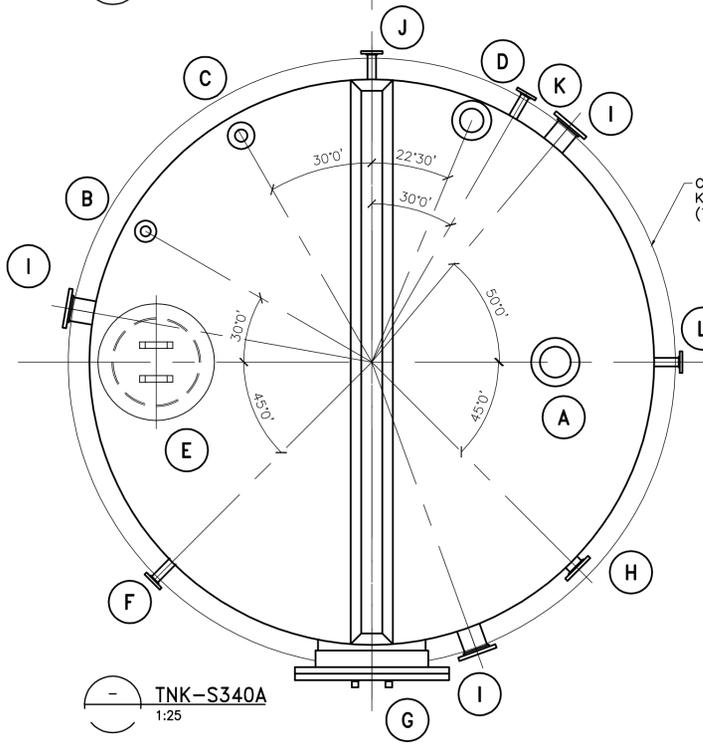

TNK-S340A
1:25

NOZZLE SCHEDULE		
ITEM No.	SIZE	SERVICE
A	200	VENT
B	50	FILL
C	75	FILL
D	100	LEVEL ELEMENT
E	600	MANWAY
F	50	SUCTION
G	750	MANWAY
H	100	OVERFLOW C/W INTERNAL LR 90° ELBOW
I	-	HEATER
J	50	DRAIN
K	50	LEVEL GAUGE
L	50	TEMPERATURE TRANSMITTER

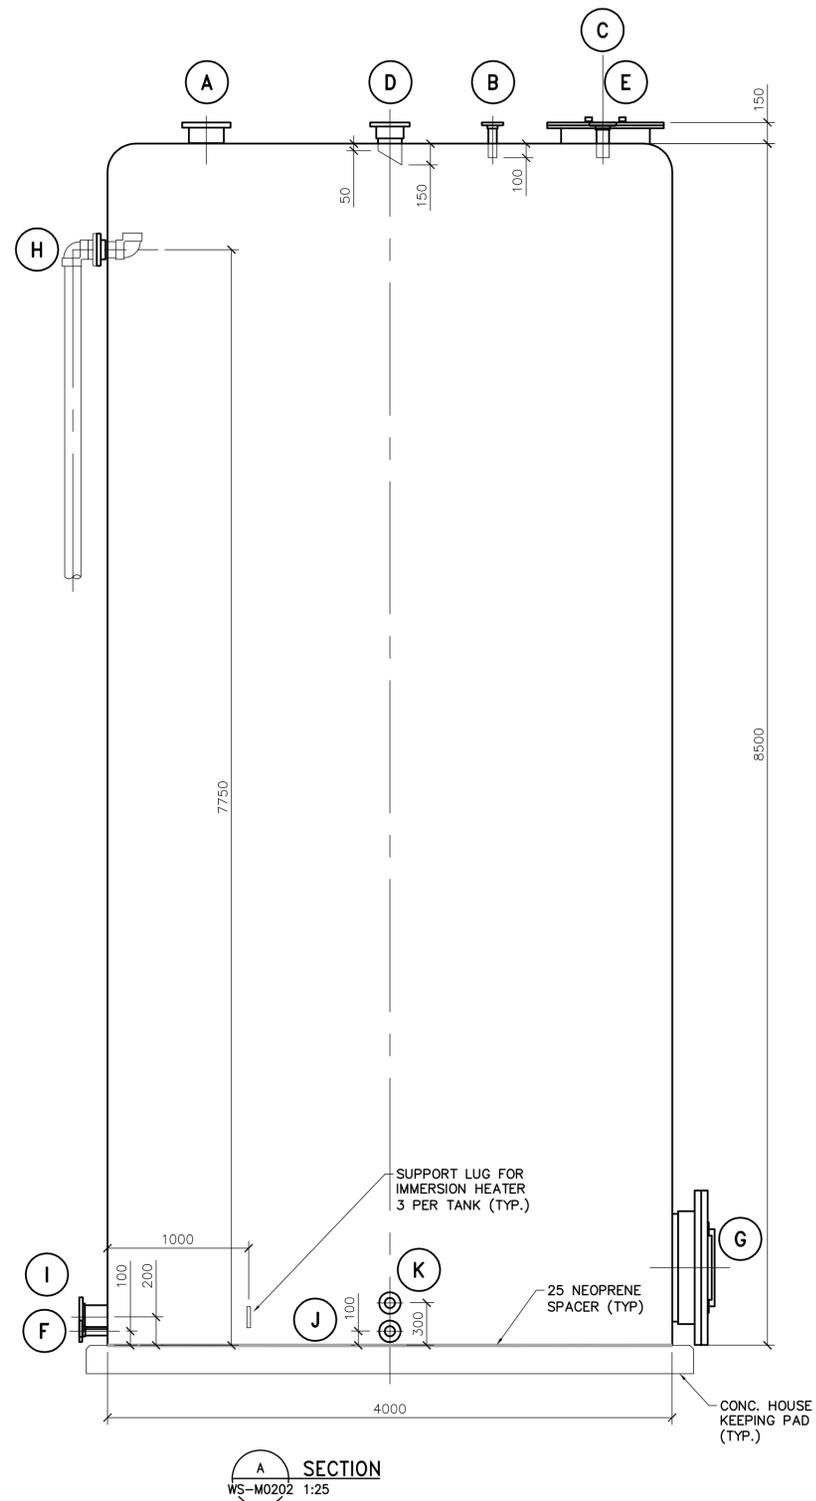

SECTION A-A
WS-M0202 1:25

NOTE:

- SEE STRUCTURAL DRAWINGS FOR HOUSE KEEPING PAD DETAILS.

AECOM

As of January 3, 2009, EarthTech became AECOM Canada Ltd.

AECOM AS-CONSTRUCTED

SIG. _____ DATE _____

 Certificate of Authorization AECOM Canada Ltd. Original dated on: No. 4671 Date: 2007/01/31	B.M. ELEV.	 Frederickson Cooper ARCHITECTS 	ENGINEER'S SEAL	 THE CITY OF WINNIPEG WATER AND WASTE DEPARTMENT ENGINEERING DIVISION WATER TREATMENT PLANT BULK CHEMICAL BUILDING SODIUM HYPOCHLORITE AND CHEMICAL STORAGE BUILDING PROCESS MECHANICAL SODIUM HYDROXIDE TANK DETAILS	CITY FILE NUMBER	
	DESIGNED BY: SBW		CHECKED BY: SRB		ORIGINAL SIGNED BY: S.B. WILLIAMSON	SHEET OF
	DRAWN BY: JBC		APPROVED BY: AHL		2007/01/31	CITY DRAWING NUMBER
	SCALE: AS NOTED		RELEASED FOR CONSTRUCTION BY: R. SOROKOWSKI		CONSULTANT DRAWING NO. WS-M0451	1-0601S-M0048-001-02
NO. REVISIONS	DATE BY	DATE	2006/03/15	DATE	2007/01/31	