



3 BUILDING SECTION
WS-B0100 1:75

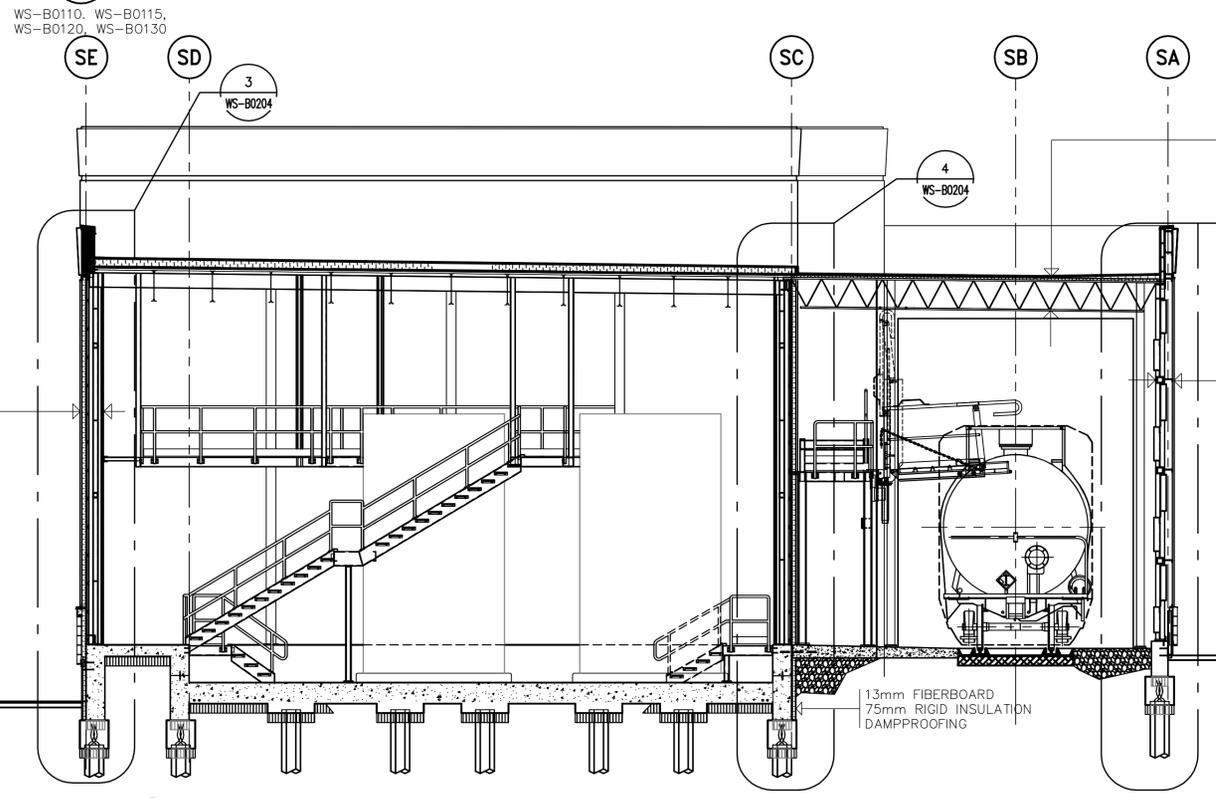

4 BUILDING SECTION
WS-B0100 1:75

8 SECTION DETAIL
WS-B0204 1:20

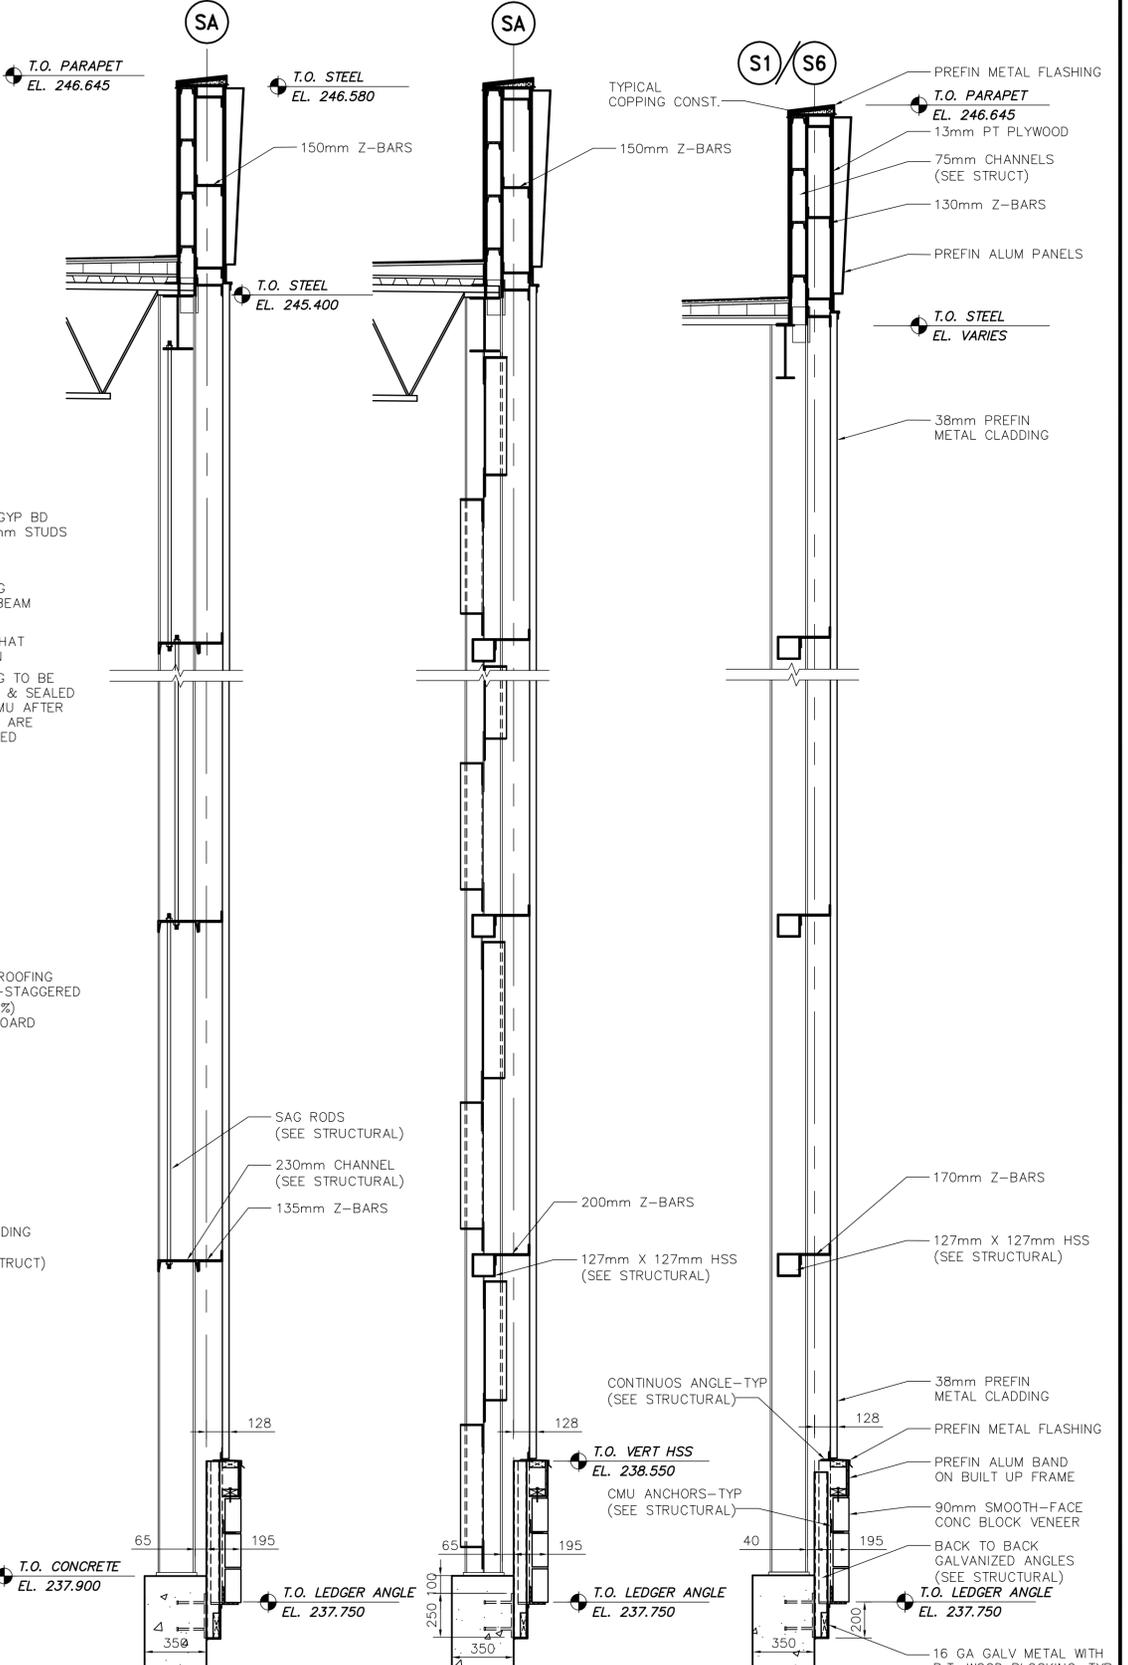

7 SECTION DETAIL
WS-B0202 1:20

6 SECTION DETAIL
WS-B0202 1:20

5 SECTION DETAIL
WS-B0115, WS-B0120 1:20

AECOM
As of January 3, 2009, EarthTech became AECOM Canada Ltd.

AECOM AS-CONSTRUCTED
SIG. _____ DATE _____



B.M. ELEV.		CH2M HILL		EarthTech		ENGINEER'S SEAL	
07	AS CONSTRUCTED	09/07/16	AL	DESIGNED BY	NC	CHECKED BY	LK
06	792-2006-FI-O-161-FC	08/05/30	AL	DRAWN BY	AL	APPROVED BY	AHL
05	792-2006-FI-O-156-FC	08/05/20	AL	SCALE:	AS SHOWN	RELEASED FOR CONSTRUCTION BY:	R. SOROKOWSKI
04	792-2006-FI-O-113-FC	08/01/16	AL	NO. REVISIONS	DATE	BY	DATE
03	ISSUED FOR CONSTRUCTION	07/06/01	AL	2006/09/01	2007/01/31		
02	792-2006 ADDENDUM 5	07/04/11	AL				
01	792-2006 ADDENDUM 4	07/04/05	AL				
00	ISSUED FOR TENDER	07/01/31	AL				

THE CITY OF WINNIPEG
WATER AND WASTE DEPARTMENT
ENGINEERING DIVISION

Winnipeg

WATER TREATMENT PLANT
BULK CHEMICAL BUILDING
SODIUM HYPOCHLORITE AND CHEMICAL STORAGE BUILDING

ARCHITECTURAL
BUILDING SECTIONS
SHEET 2 OF 2

CITY FILE NUMBER
SHEET OF
CITY DRAWING NUMBER
1-0601S-B0008-002-07