








Appendix D

LD-490 Mountain Avenue Siphon Detail As-Built Drawing

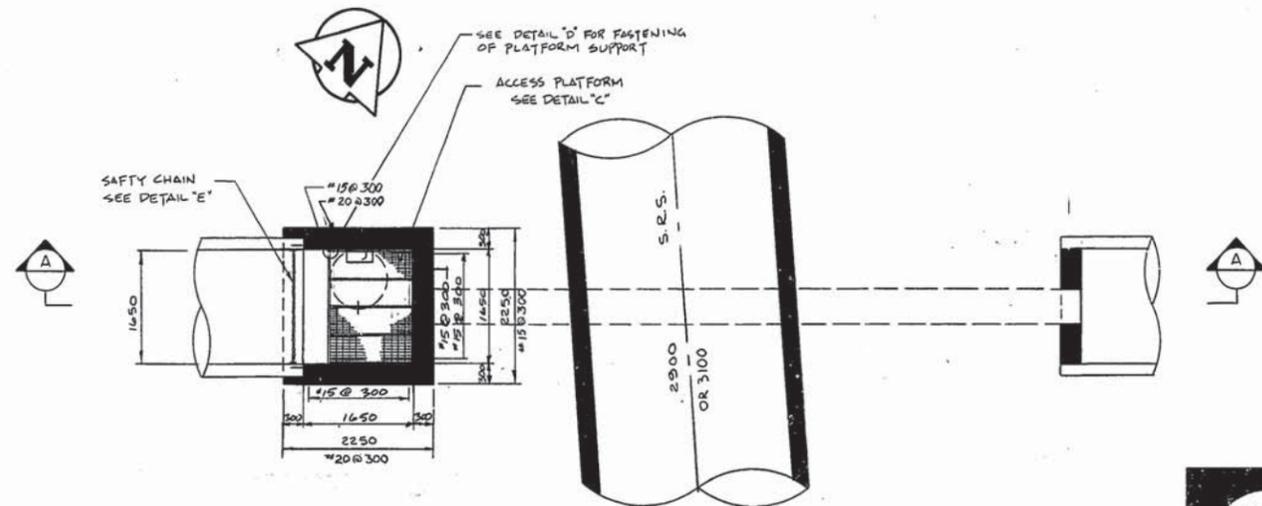

DETAIL OF SIPHON CROSSING AT M'PHILLIPS STREET
1:50

FOR LOCATION SEE DWG. NO. LD. 485

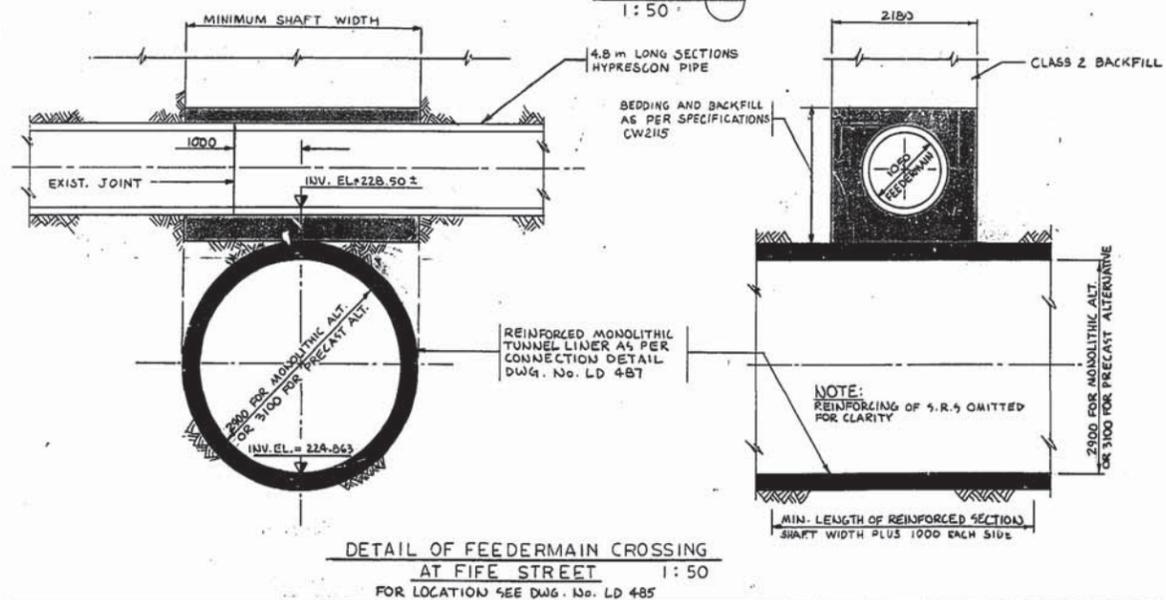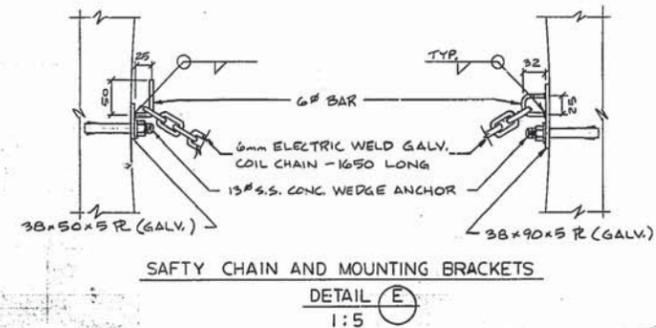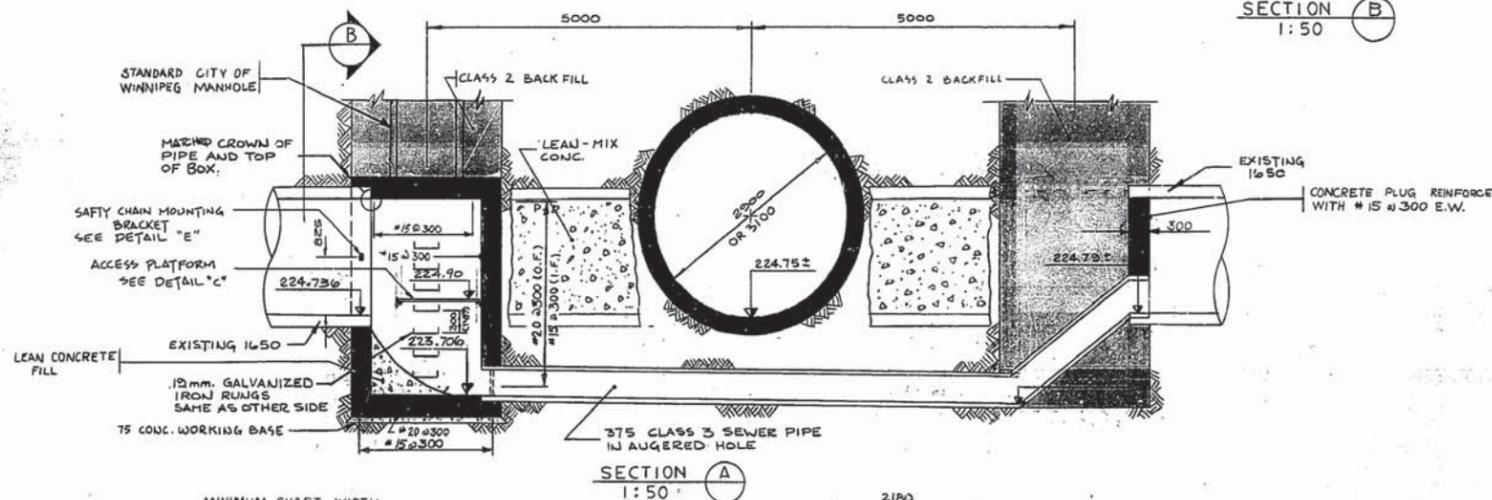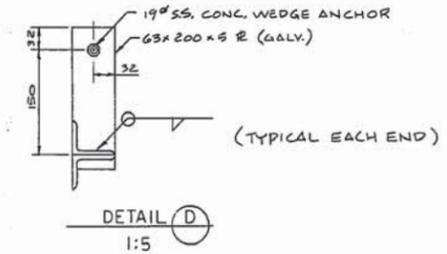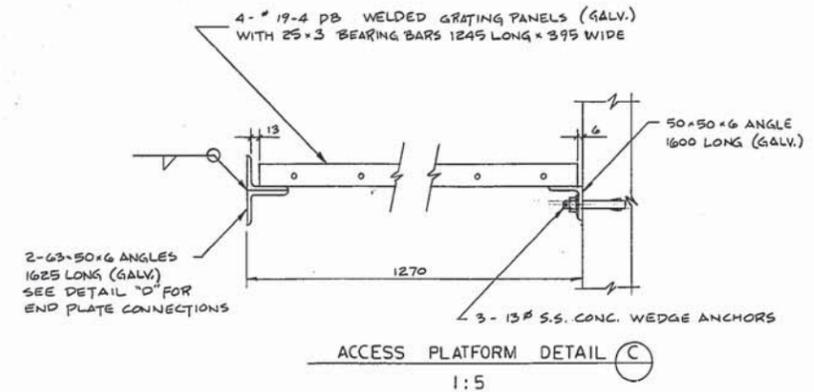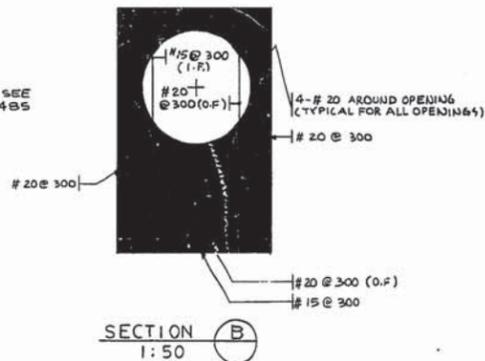

NOTE:
REVISED AS CONSTRUCTED NOTATION APPLIES TO ONLY THE SEWER RELIEF AND RELATED CONNECTIONS.
DATE 6/10/85 BY N.S.
CHECKED BY B.B. 20 DEC 85

		ide INTERDISCIPLINARY ENGINEERING COMPANY PROFESSIONAL ENGINEERS WINNIPEG MANITOBA	THE CITY OF WINNIPEG WORKS & OPERATIONS DIVISION WATERWORKS, WASTE & DISPOSAL DEPARTMENT	ST. JOHNS/POLSON SEWER RELIEF PROJECT SPECIAL DETAILS RELEASED FOR CONSTRUCTION DATE: <u>Feb. 5 '82</u> SCALE: AS SHOWN DRAWING NO: LD-490
DESIGNED BY: <u>D.S.</u>	DRAWN BY: <u>Norm G</u>			
CHECKED BY: <u>R.D.</u>	DATE: APRIL 15, 1981			
APPROVED BY: <u>RC Duke</u>	DATE: <u>7/25/82</u>			
2 REVISION TO ASBUILT 6/10/85 N.S.				
1 ADDED ACCESS PLATFORM & SAFETY CHAIN DETAILS 83-01-21 S.B.				
NO REVISIONS				