


SECTION 1
4/3

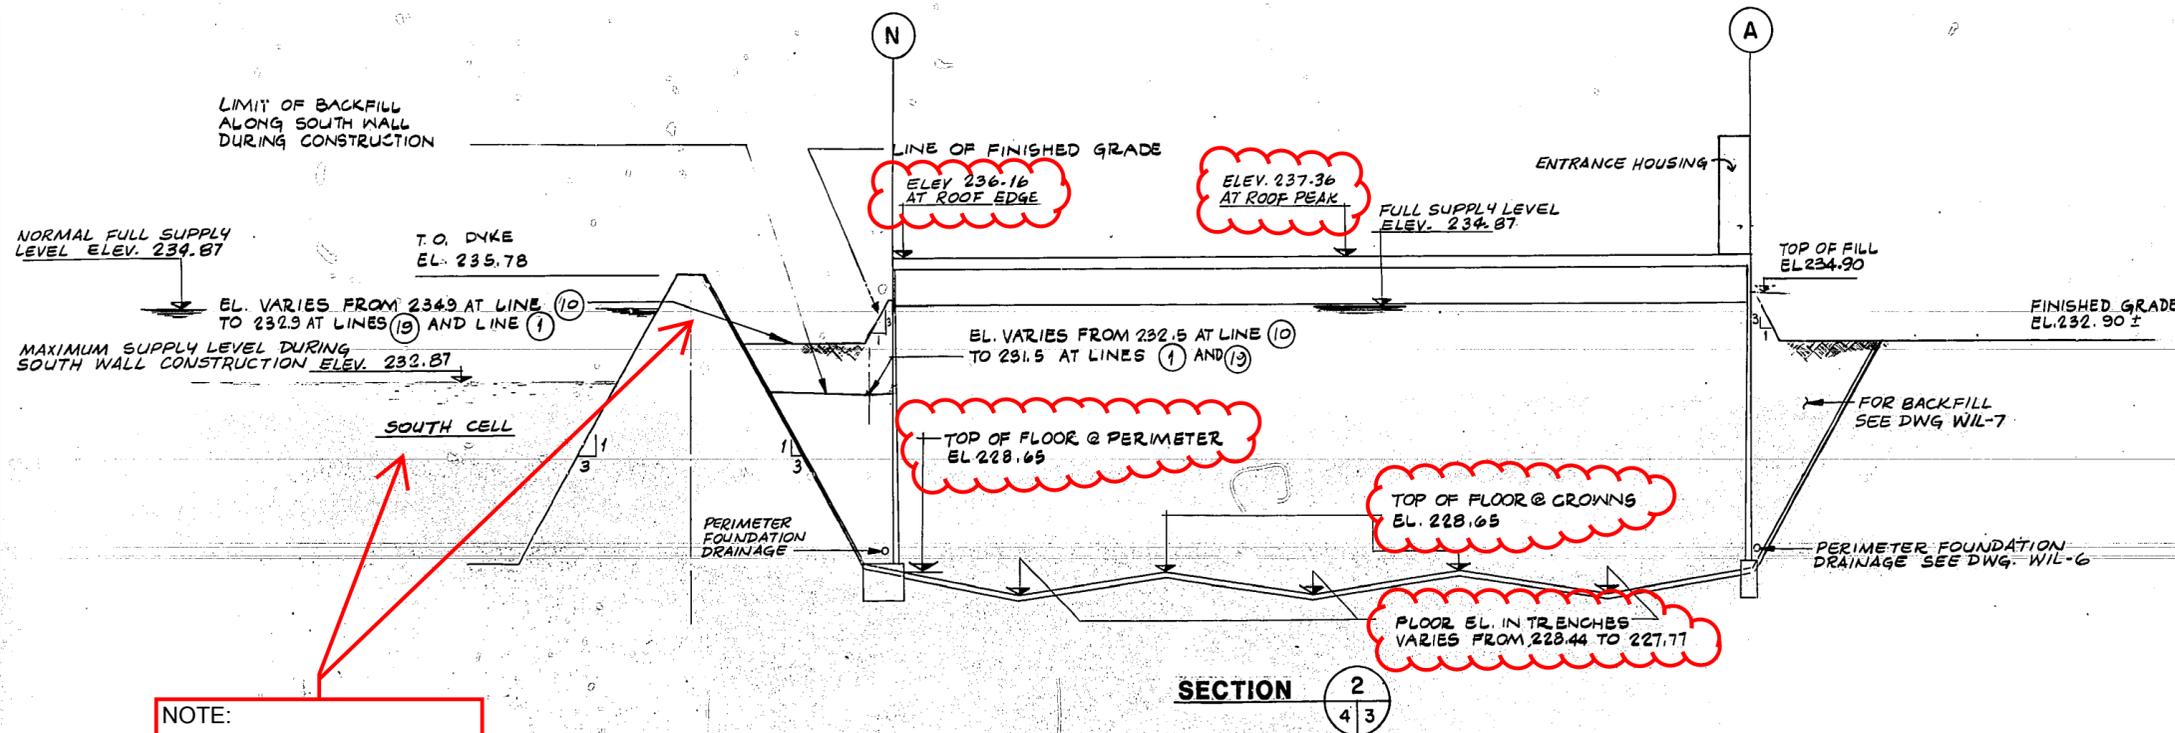

SECTION 2
4/3


NOTE:
Information regarding the South Cell and the landscaping elevations are not representative of current site conditions.

MICROFILMED

RECORD DRAWING

METRIC NOTES
WHOLE NUMBERS IND. MILLIMETRES
DECIMALIZED EXPRESSIONS IND. METRES

NO.	REVISIONS	DATE	APP.
2	RECORD DRWG.	NOV/5/88	FEEL
1	CONST. RECORD CHANGES	AUG/21/88	FEEL

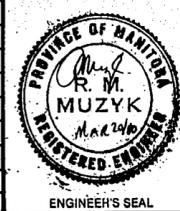

Underwood McLellan Ltd.
Consulting Engineers and Planners

DESIGNED BY: R.M.M. DRAWN BY: R.B.T.
CHECKED BY: DATE: MARCH 20, 1980
APPROVED BY: DATE: 20/3/80

THE CITY OF WINNIPEG
WORKS & OPERATIONS DEPARTMENT
WATERWORKS, WASTE & DISPOSAL DIVISION

WILKES AVENUE RESERVOIR RECONSTRUCTION
GENERAL SECTIONS
RELEASED FOR CONSTRUCTION DATE: 20/03/80
SCALE: 1:500 HORZ. 1:100 VERT.
DRAWING NO: WIL-4 REV 2