

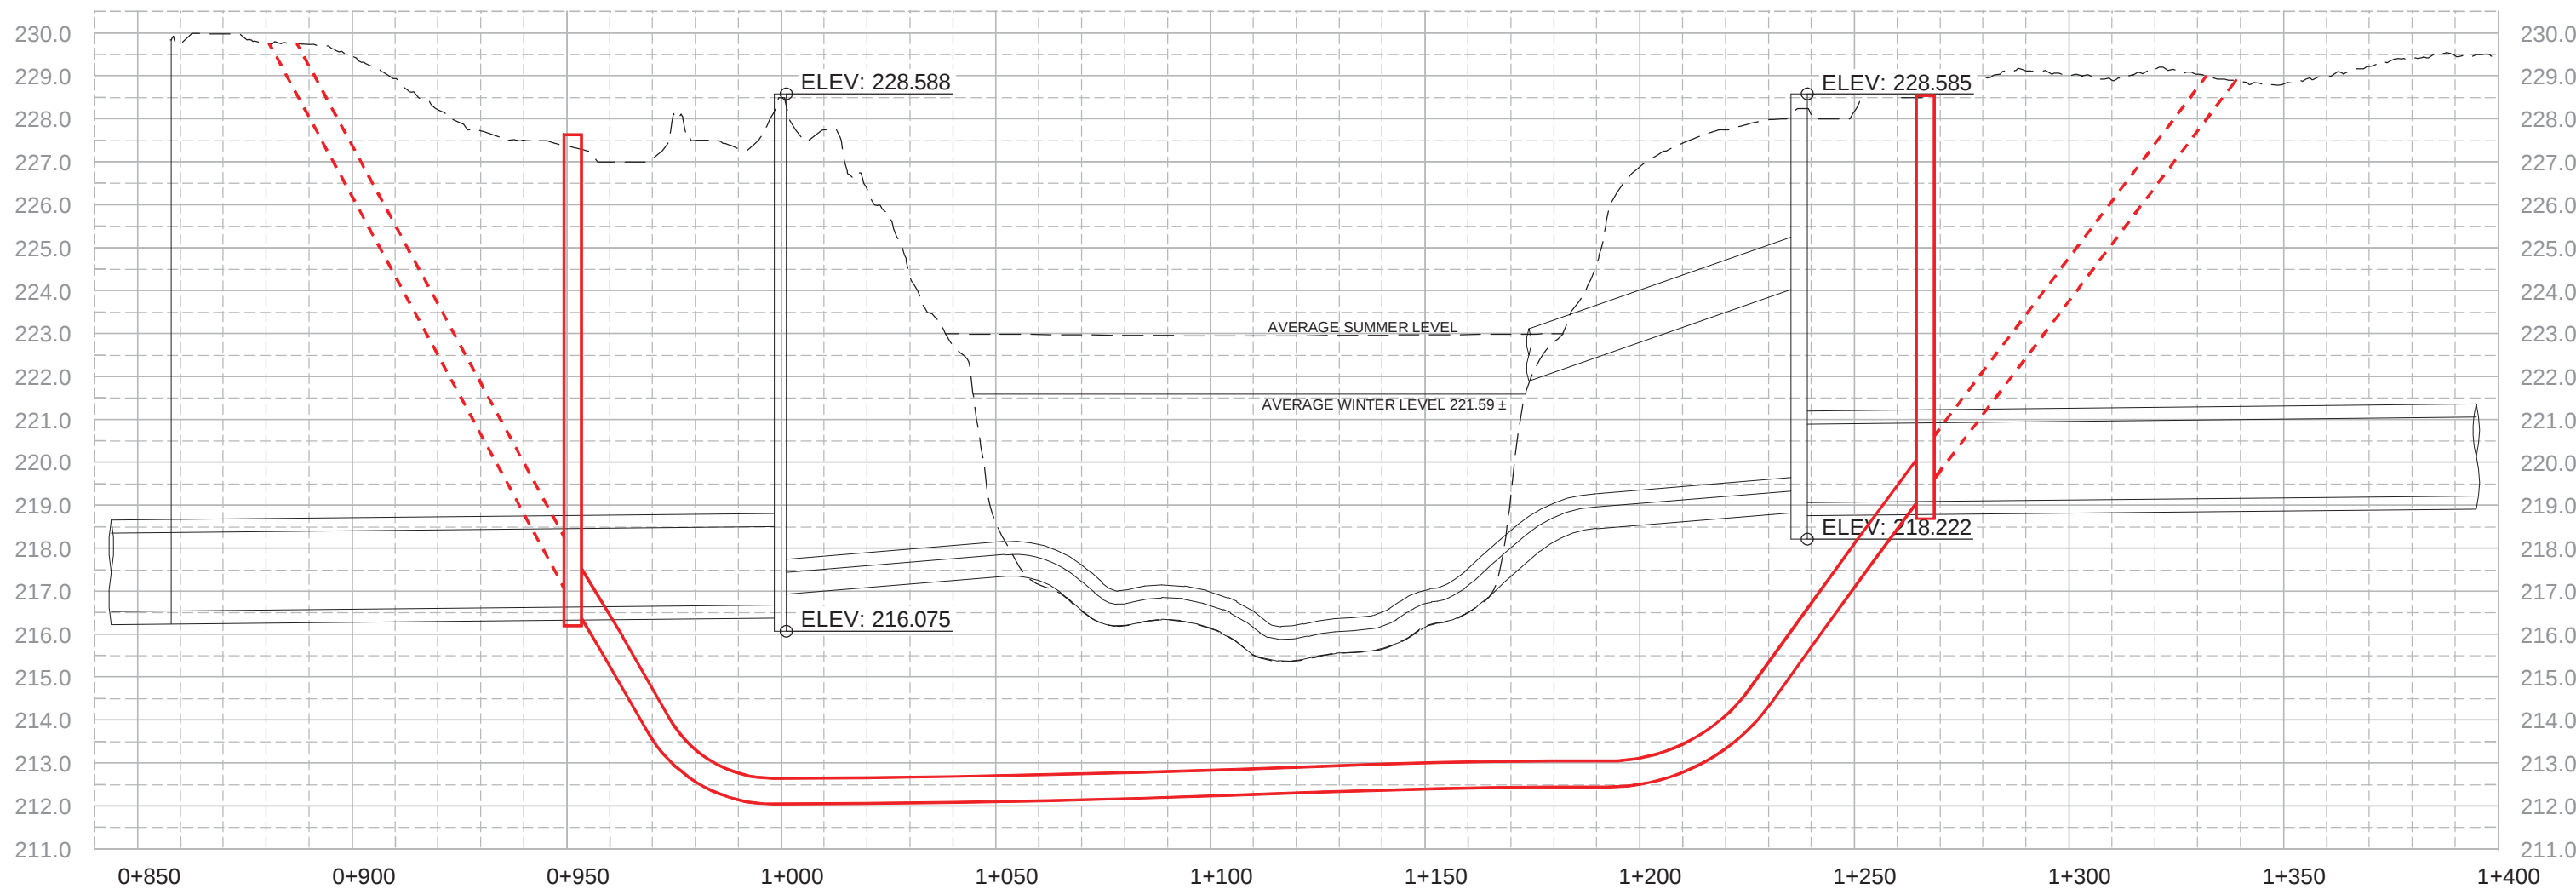


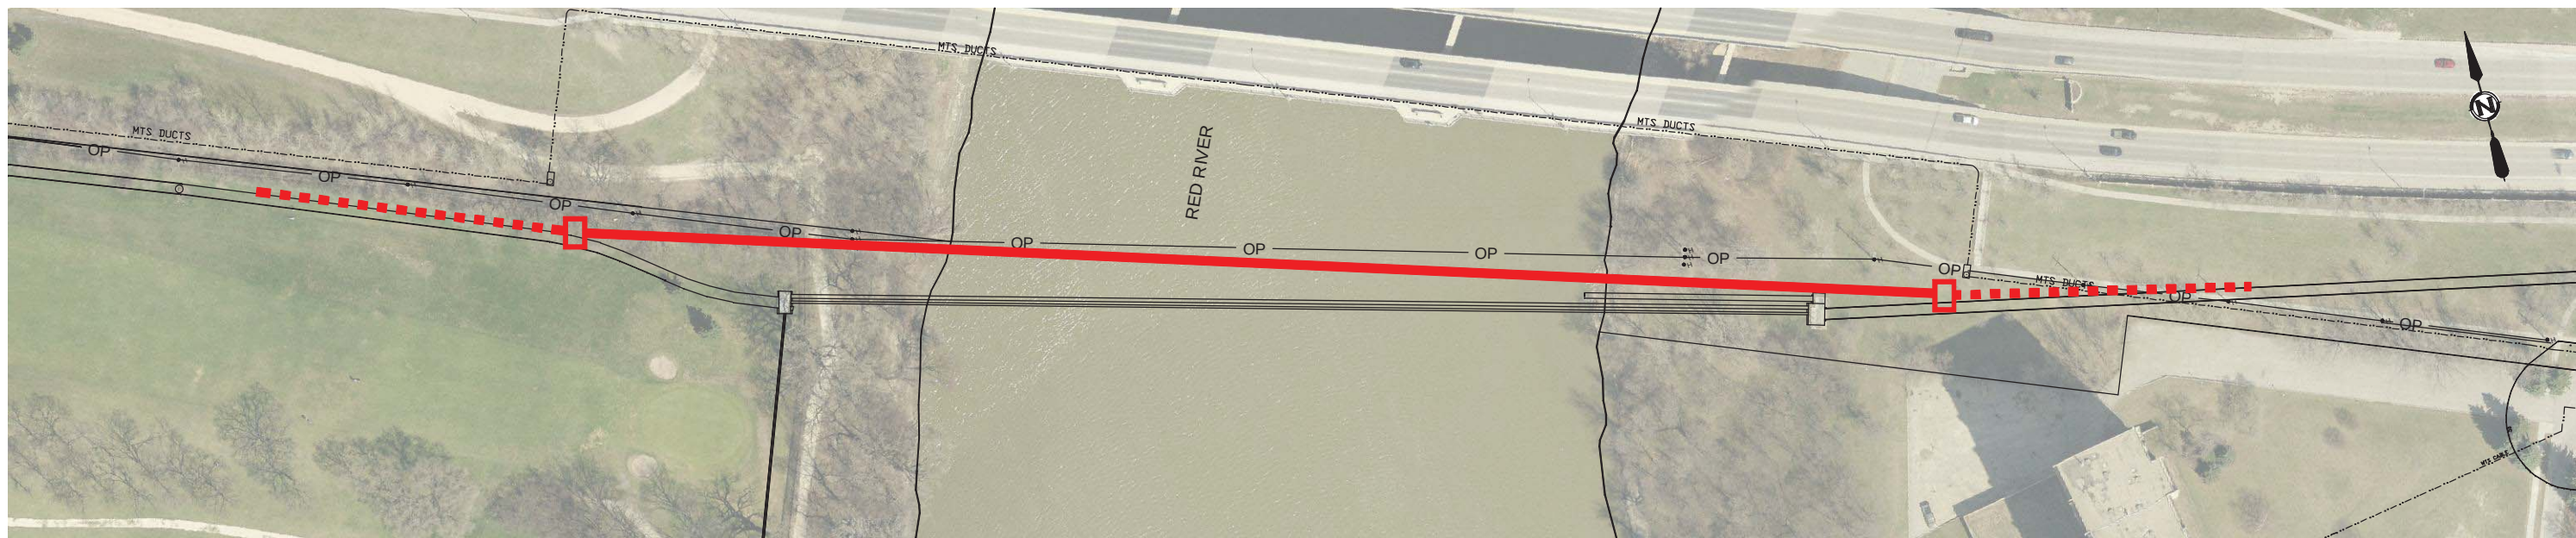


COMPILED FROM FIELD BOOKS F-13, F-190, F-224, F-300
AND LEGAL PLANS 3282, 5610, 7182, 9039, 9076
9085, 9133, 9070, 9207.

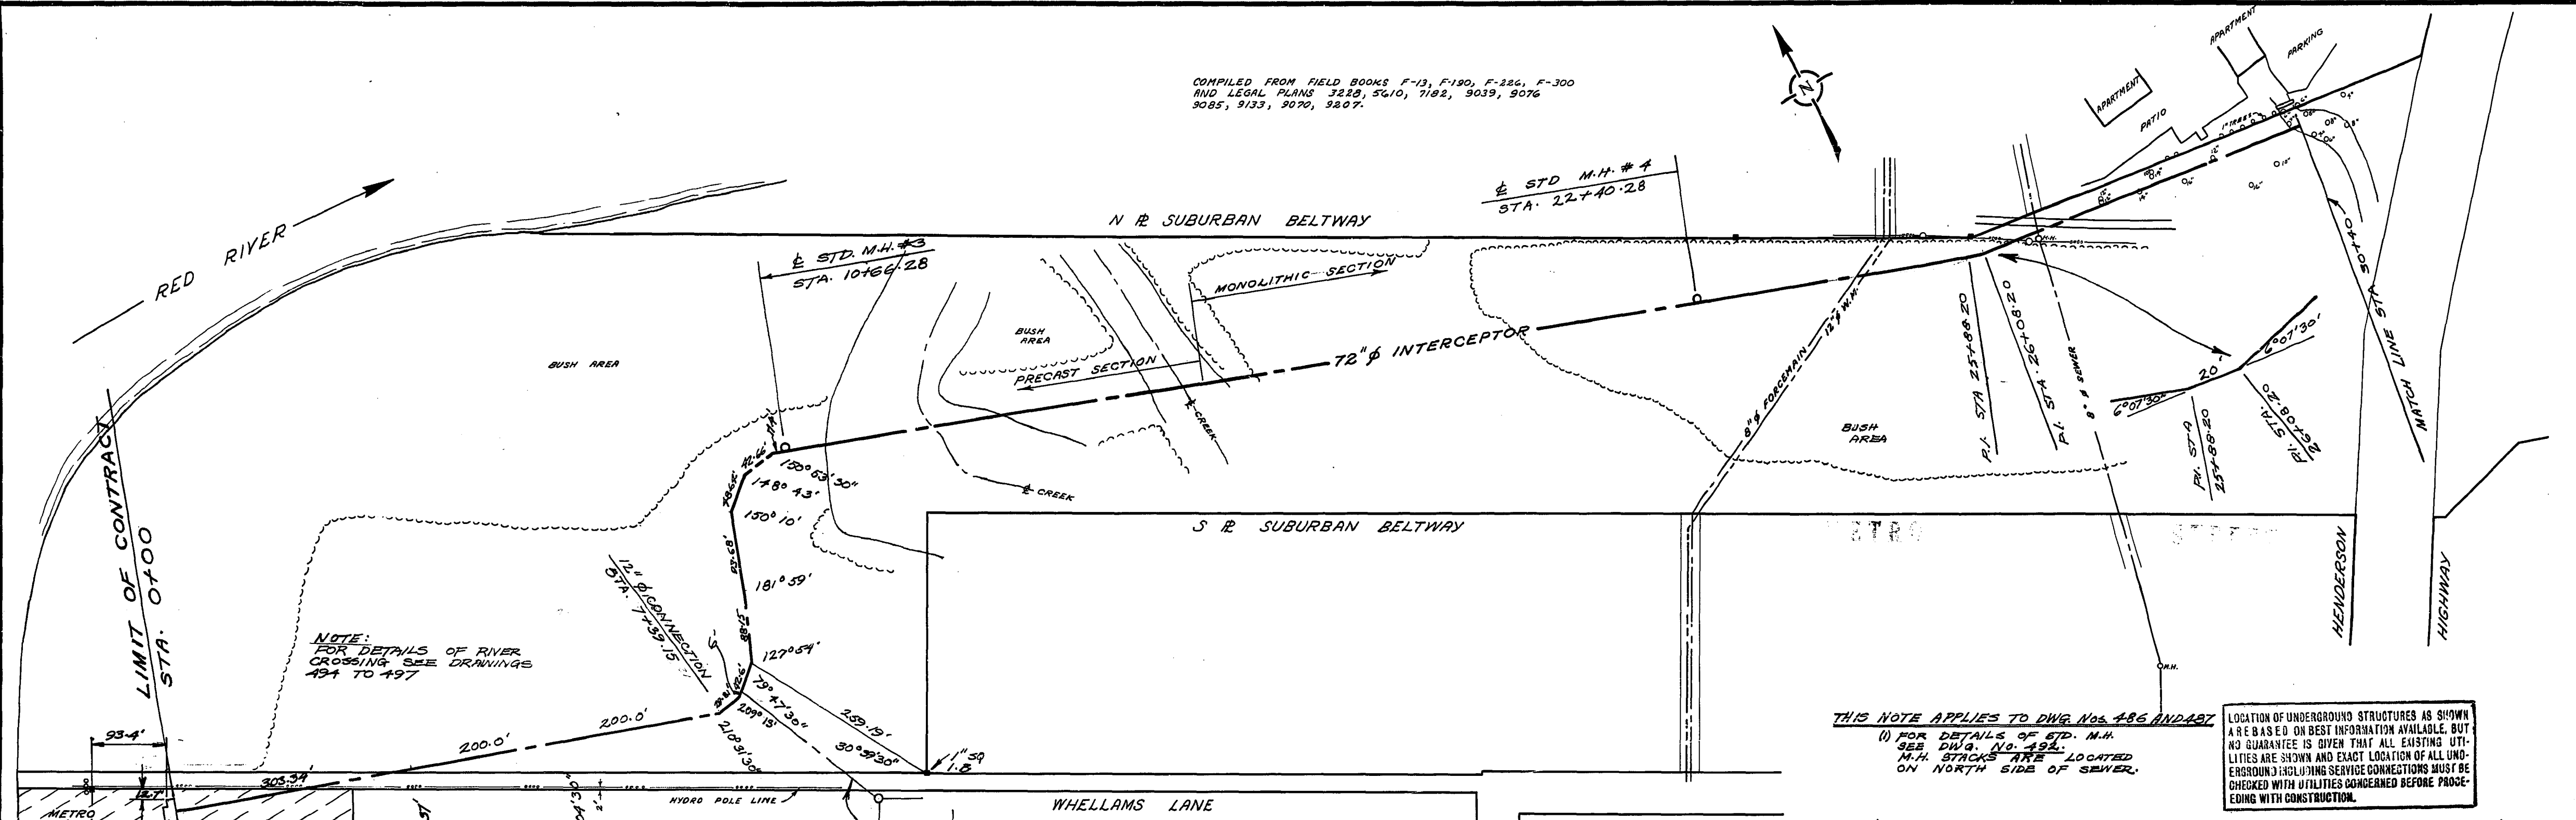

NOTE:
FOR DETAILS OF RIVER
CROSSING SEE DRAWINGS
494 TO 497




THIS NOTE APPLIES TO DWG. NOS. 486 AND 487
(1) FOR DETAILS OF STD. M.H.
SEE DWG. NO. 494.
M.H. STACKS ARE LOCATED
ON NORTH SIDE OF SEWER.

LOCATION OF UNDERGROUND STRUCTURES AS SHOWN
ARE BASED ON BEST INFORMATION AVAILABLE, BUT
NO GUARANTEE IS GIVEN THAT ALL EXISTING UTI-
LITIES ARE SHOWN AND EXACT LOCATION OF ALL UN-
DERGROUND INCLUDING SERVICE CONNECTIONS MUST BE
CHECKED WITH UTILITIES CONCERNED BEFORE PROCE-
EDING WITH CONSTRUCTION.

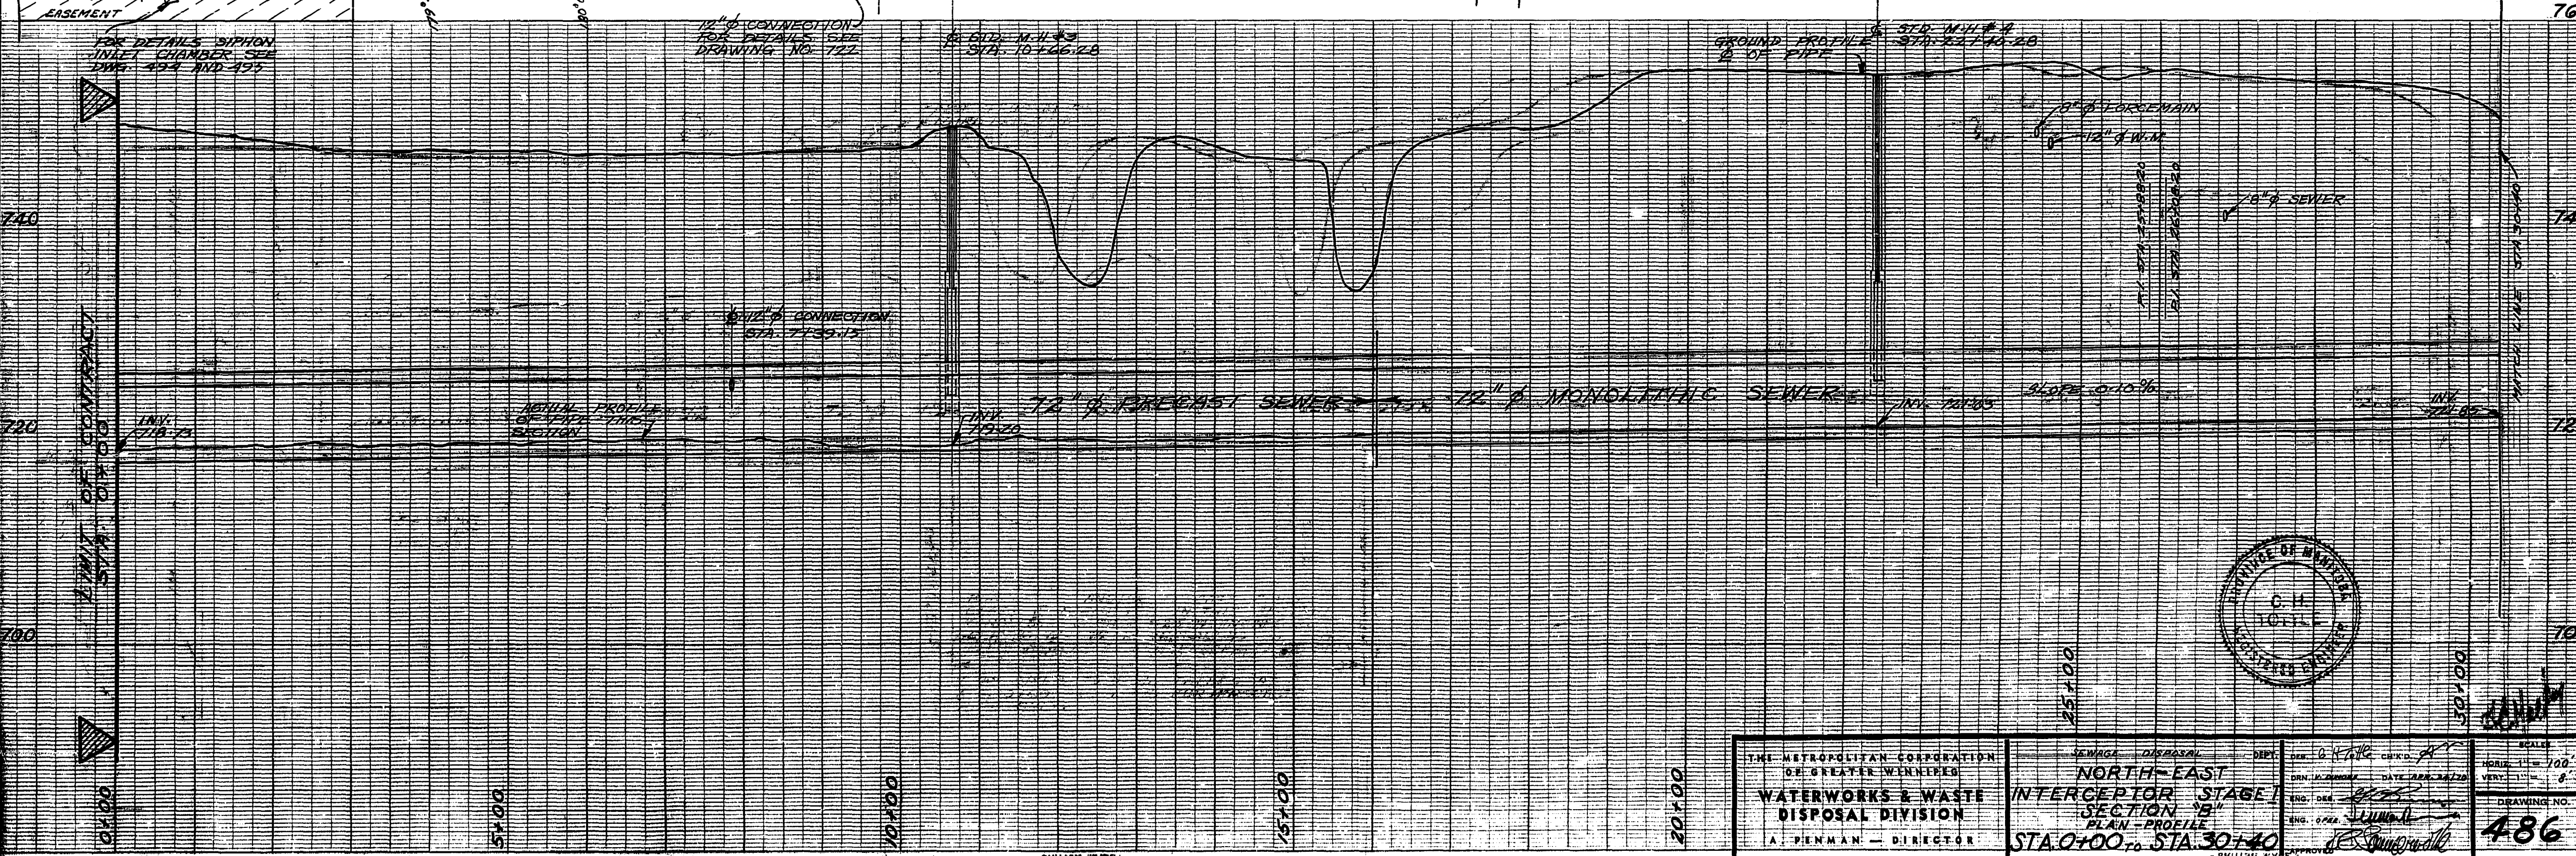


THE METROPOLITAN CORPORATION OF GREATER WINNIPEG		SEWAGE DISPOSAL DEPT.		REV. 6-1-1966	
WATERWORKS & WASTE DISPOSAL DIVISION		NORTH-EAST INTERCEPTOR STAGE I SECTION "B" PLAN - PROFILE		STA. 0+00 TO STA. 30+40	
A. PIENMAN - DIRECTOR		ENG. DES. [Signature]		ENG. CHECK [Signature]	
		APPROVED BY [Signature]		DRAWING NO. 486	

APPROVED AS BUILT
BY: V.D. April 20, 1966

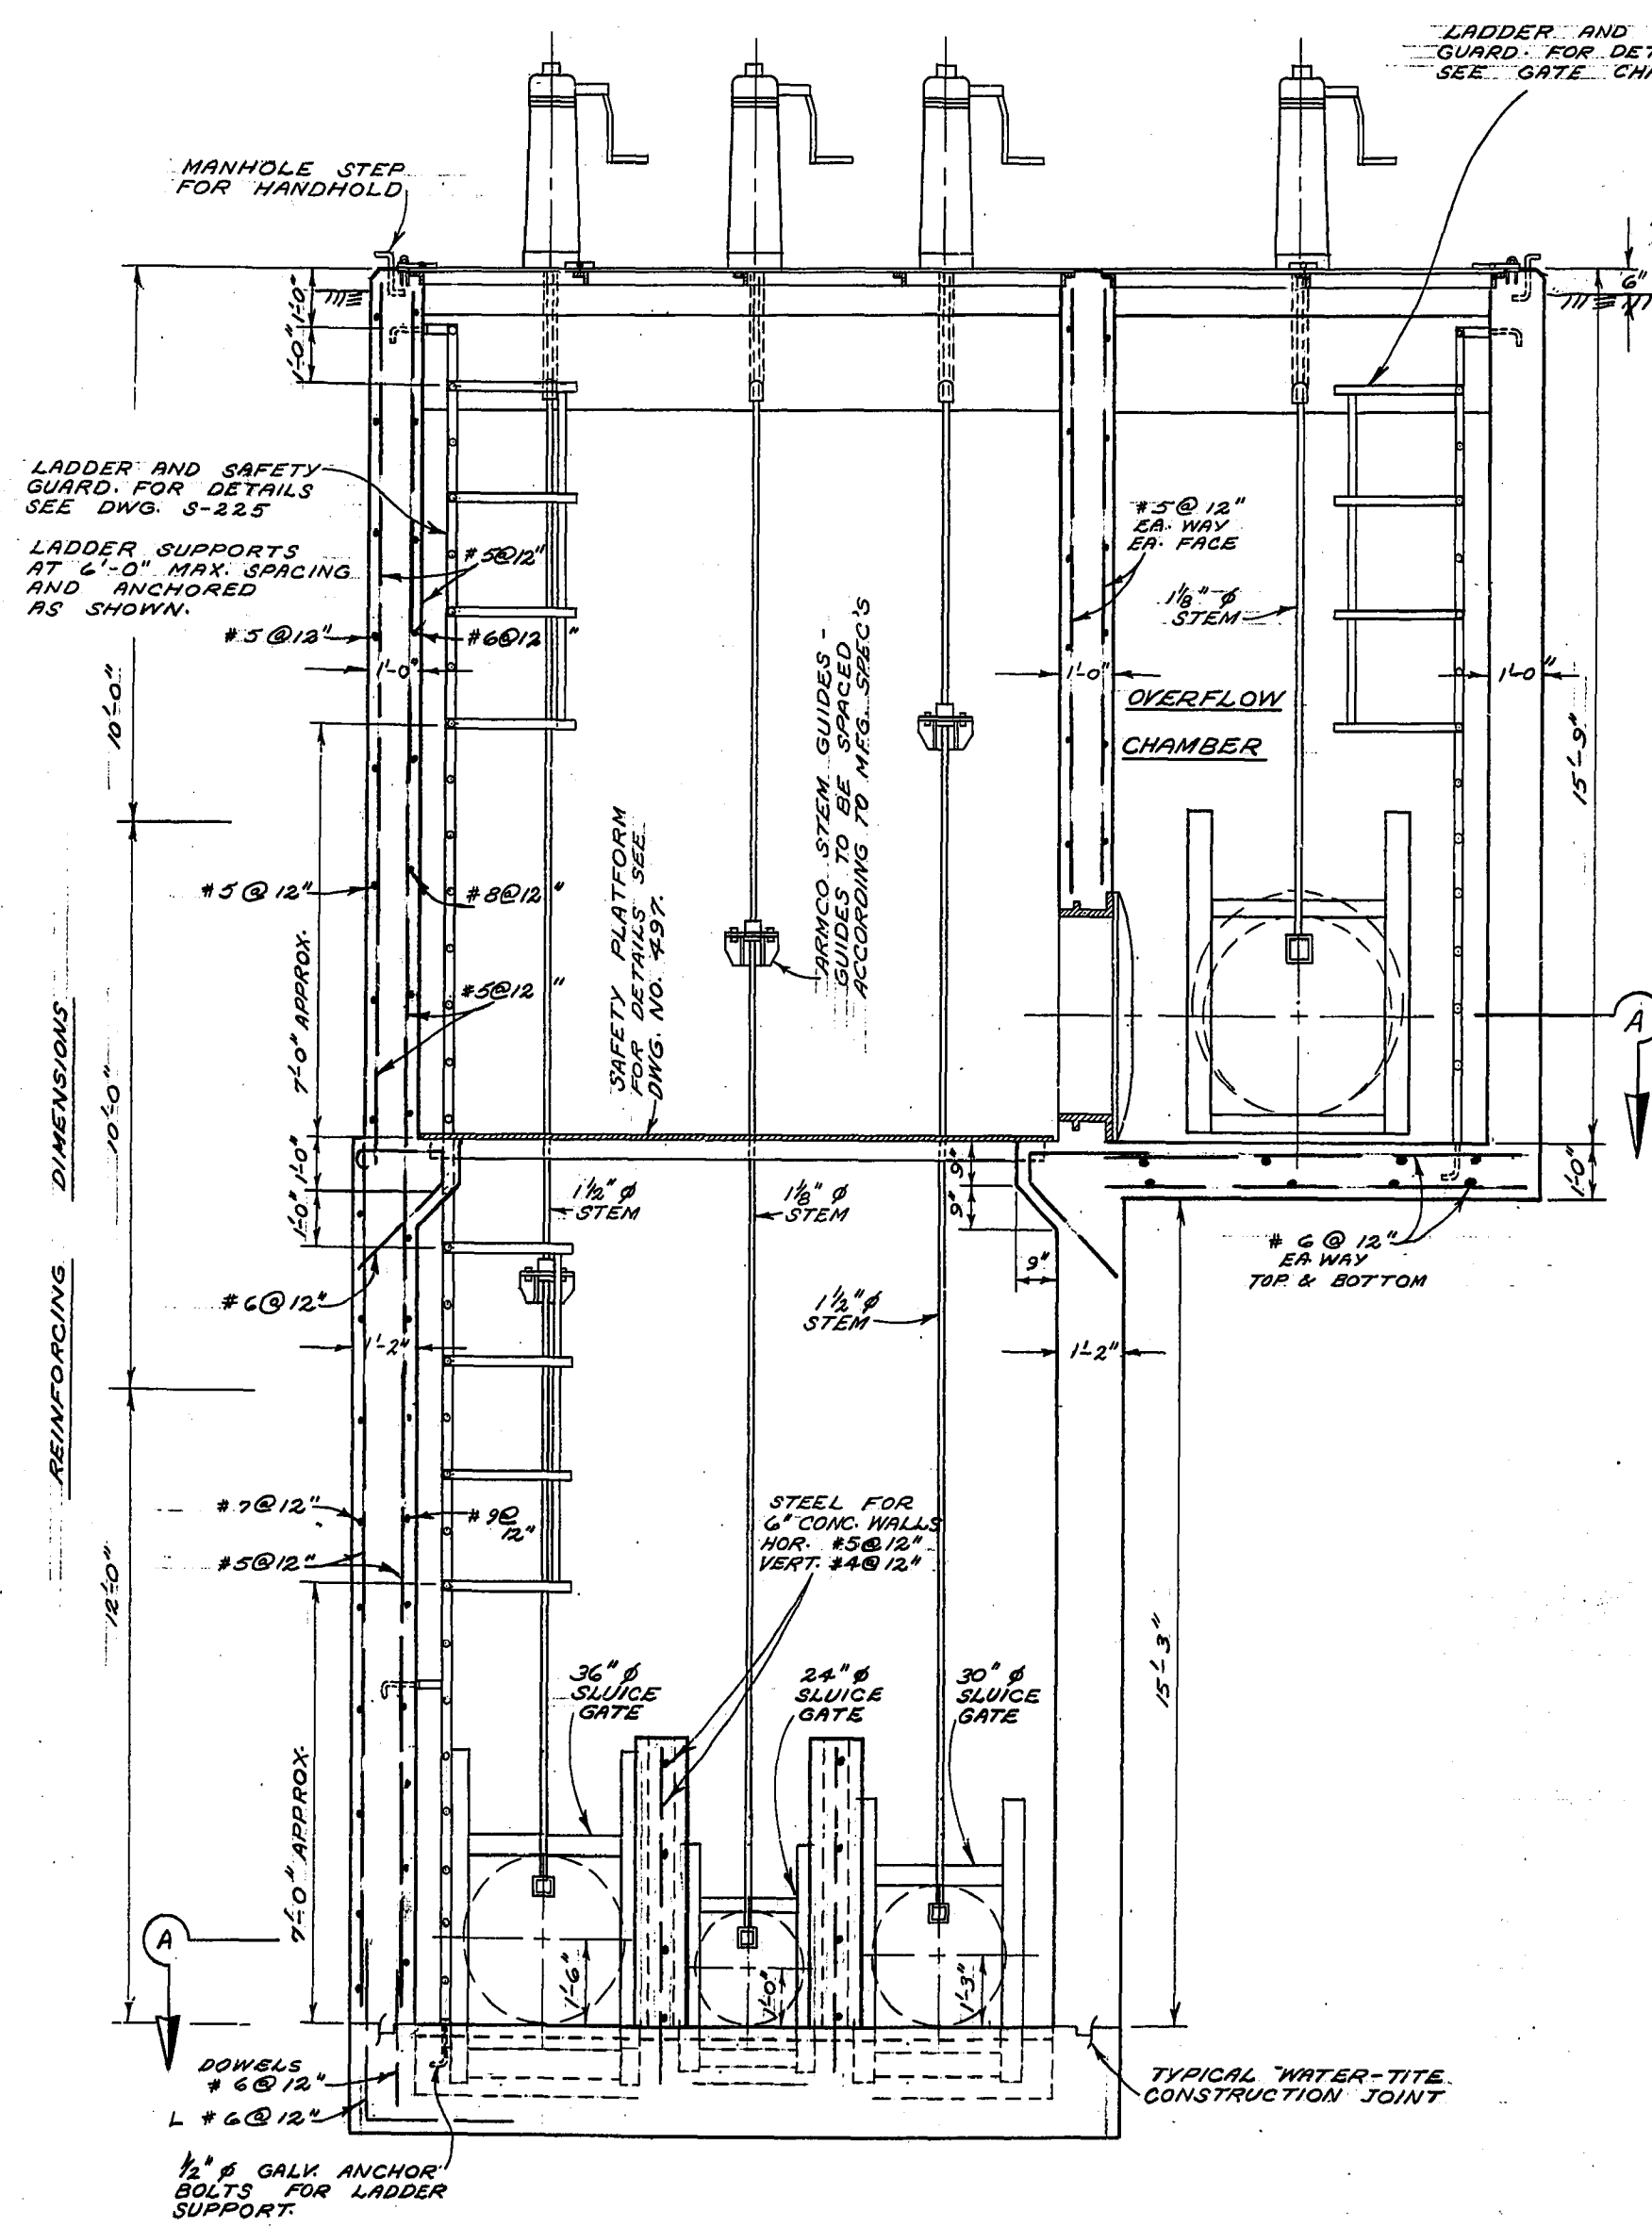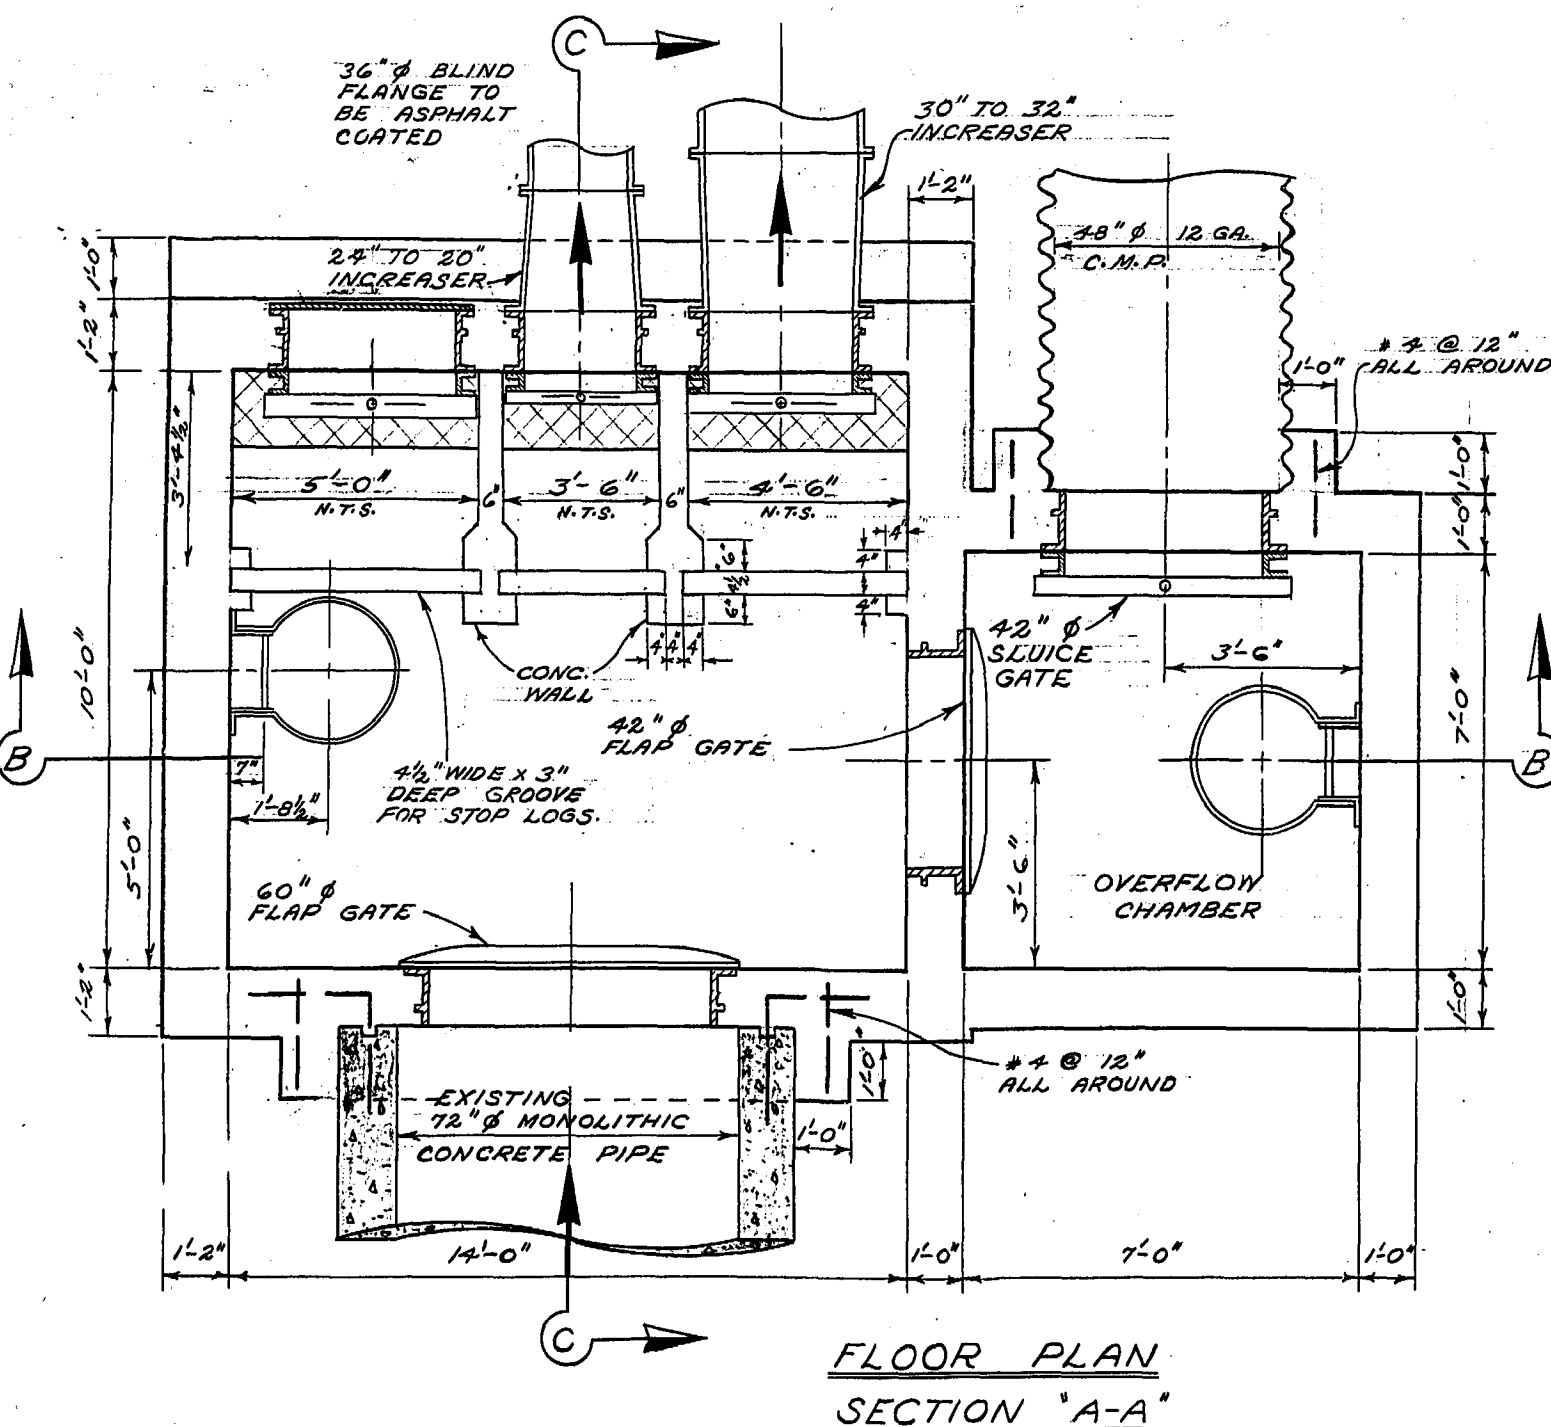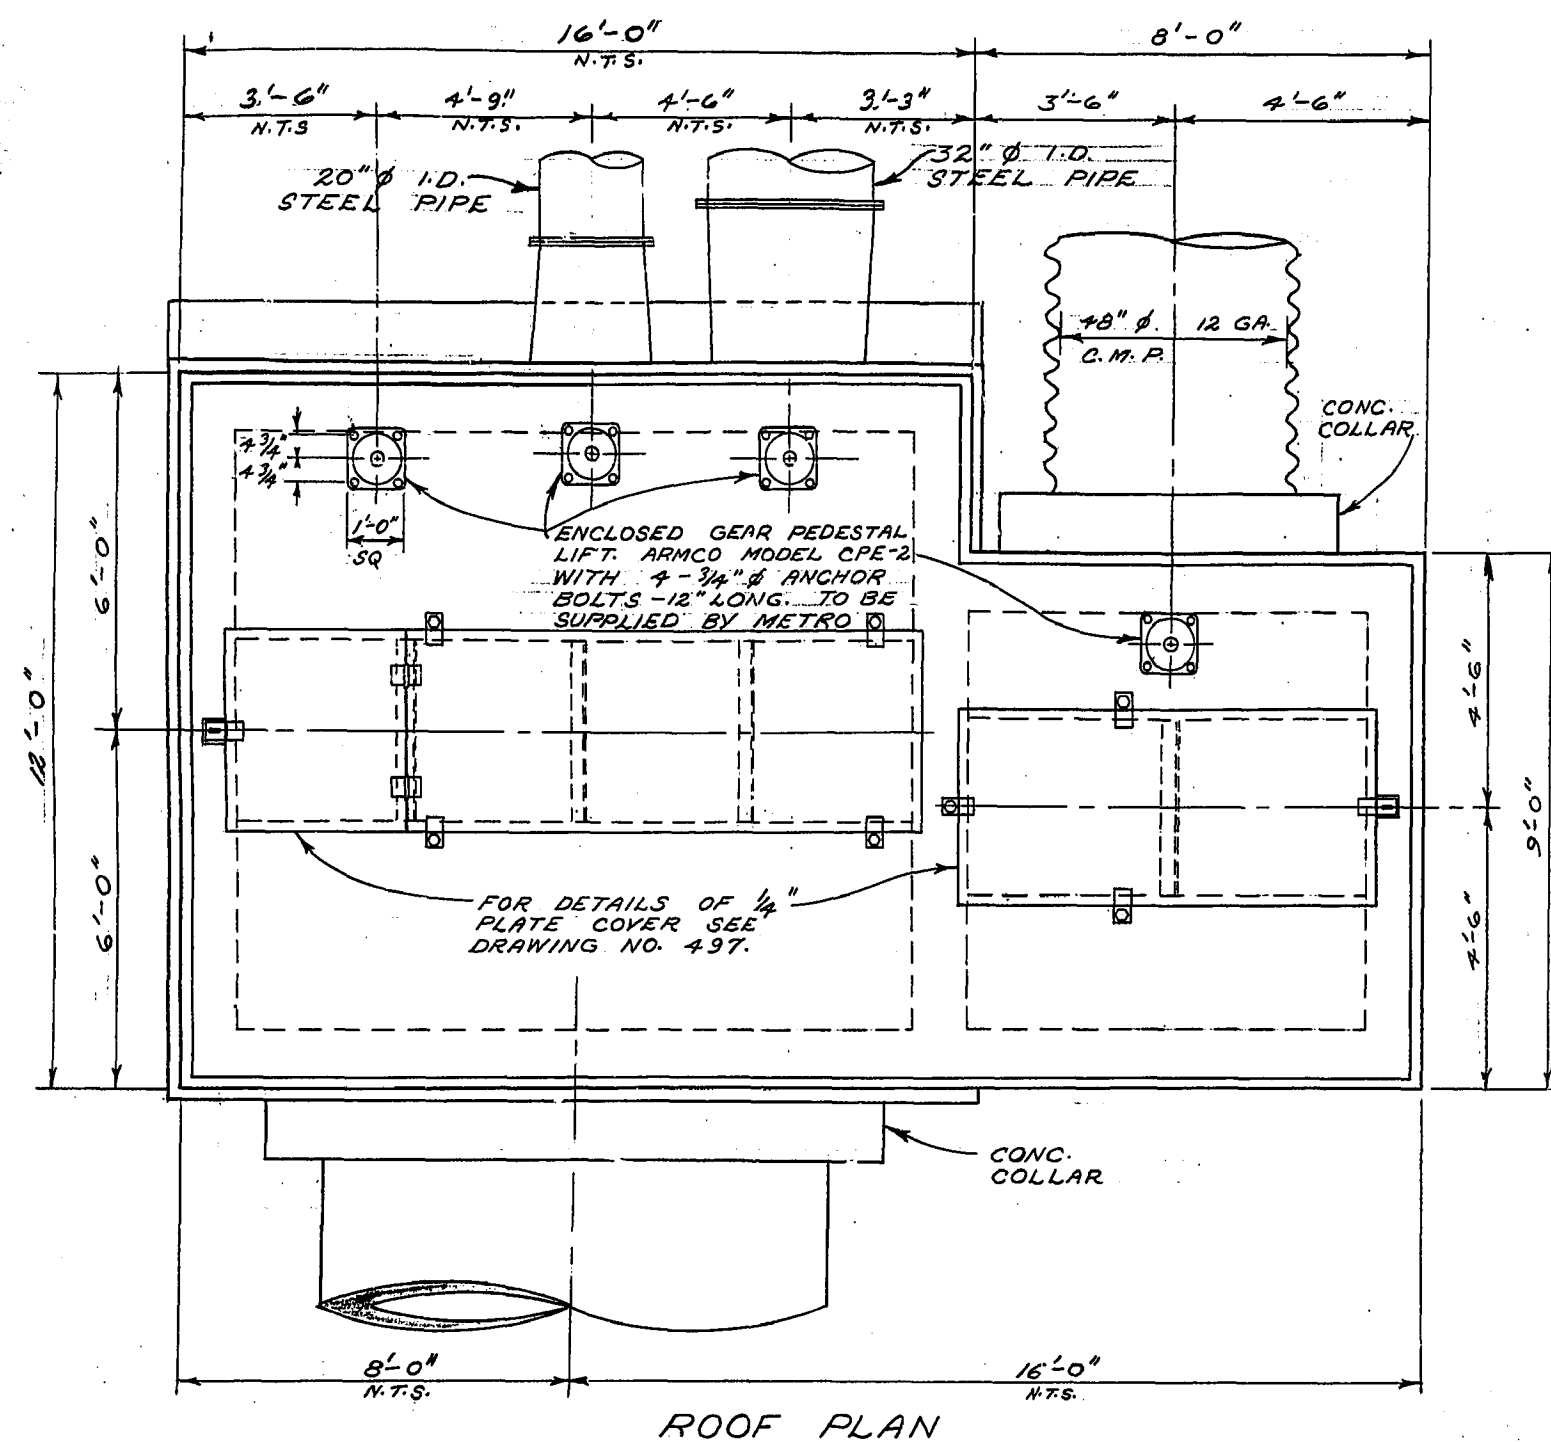


- NOTES**
1. 24", 30" & 36" SLUICE GATES TO BE ARMCO MODEL 55-10 FLANGE BACK FLUSH BOTTOM HEAVY DUTY.
 2. 42" SLUICE GATE TO BE MODEL 55-10 FLANGE BACK, STANDARD CLOSURE, MEDIUM DUTY.
 3. 42" & 60" FLAP GATE TO BE ARMCO FLAT BACK HEAVY DUTY.
 4. 24", 30" & 36" WALL THIMBLES TO BE SQUARE FLANGED ROUND OPENING ARMCO TYPE "E".
 5. 42" & 60" WALL THIMBLE TO BE SQUARE FLANGED ROUND OPENING ARMCO TYPE "F".

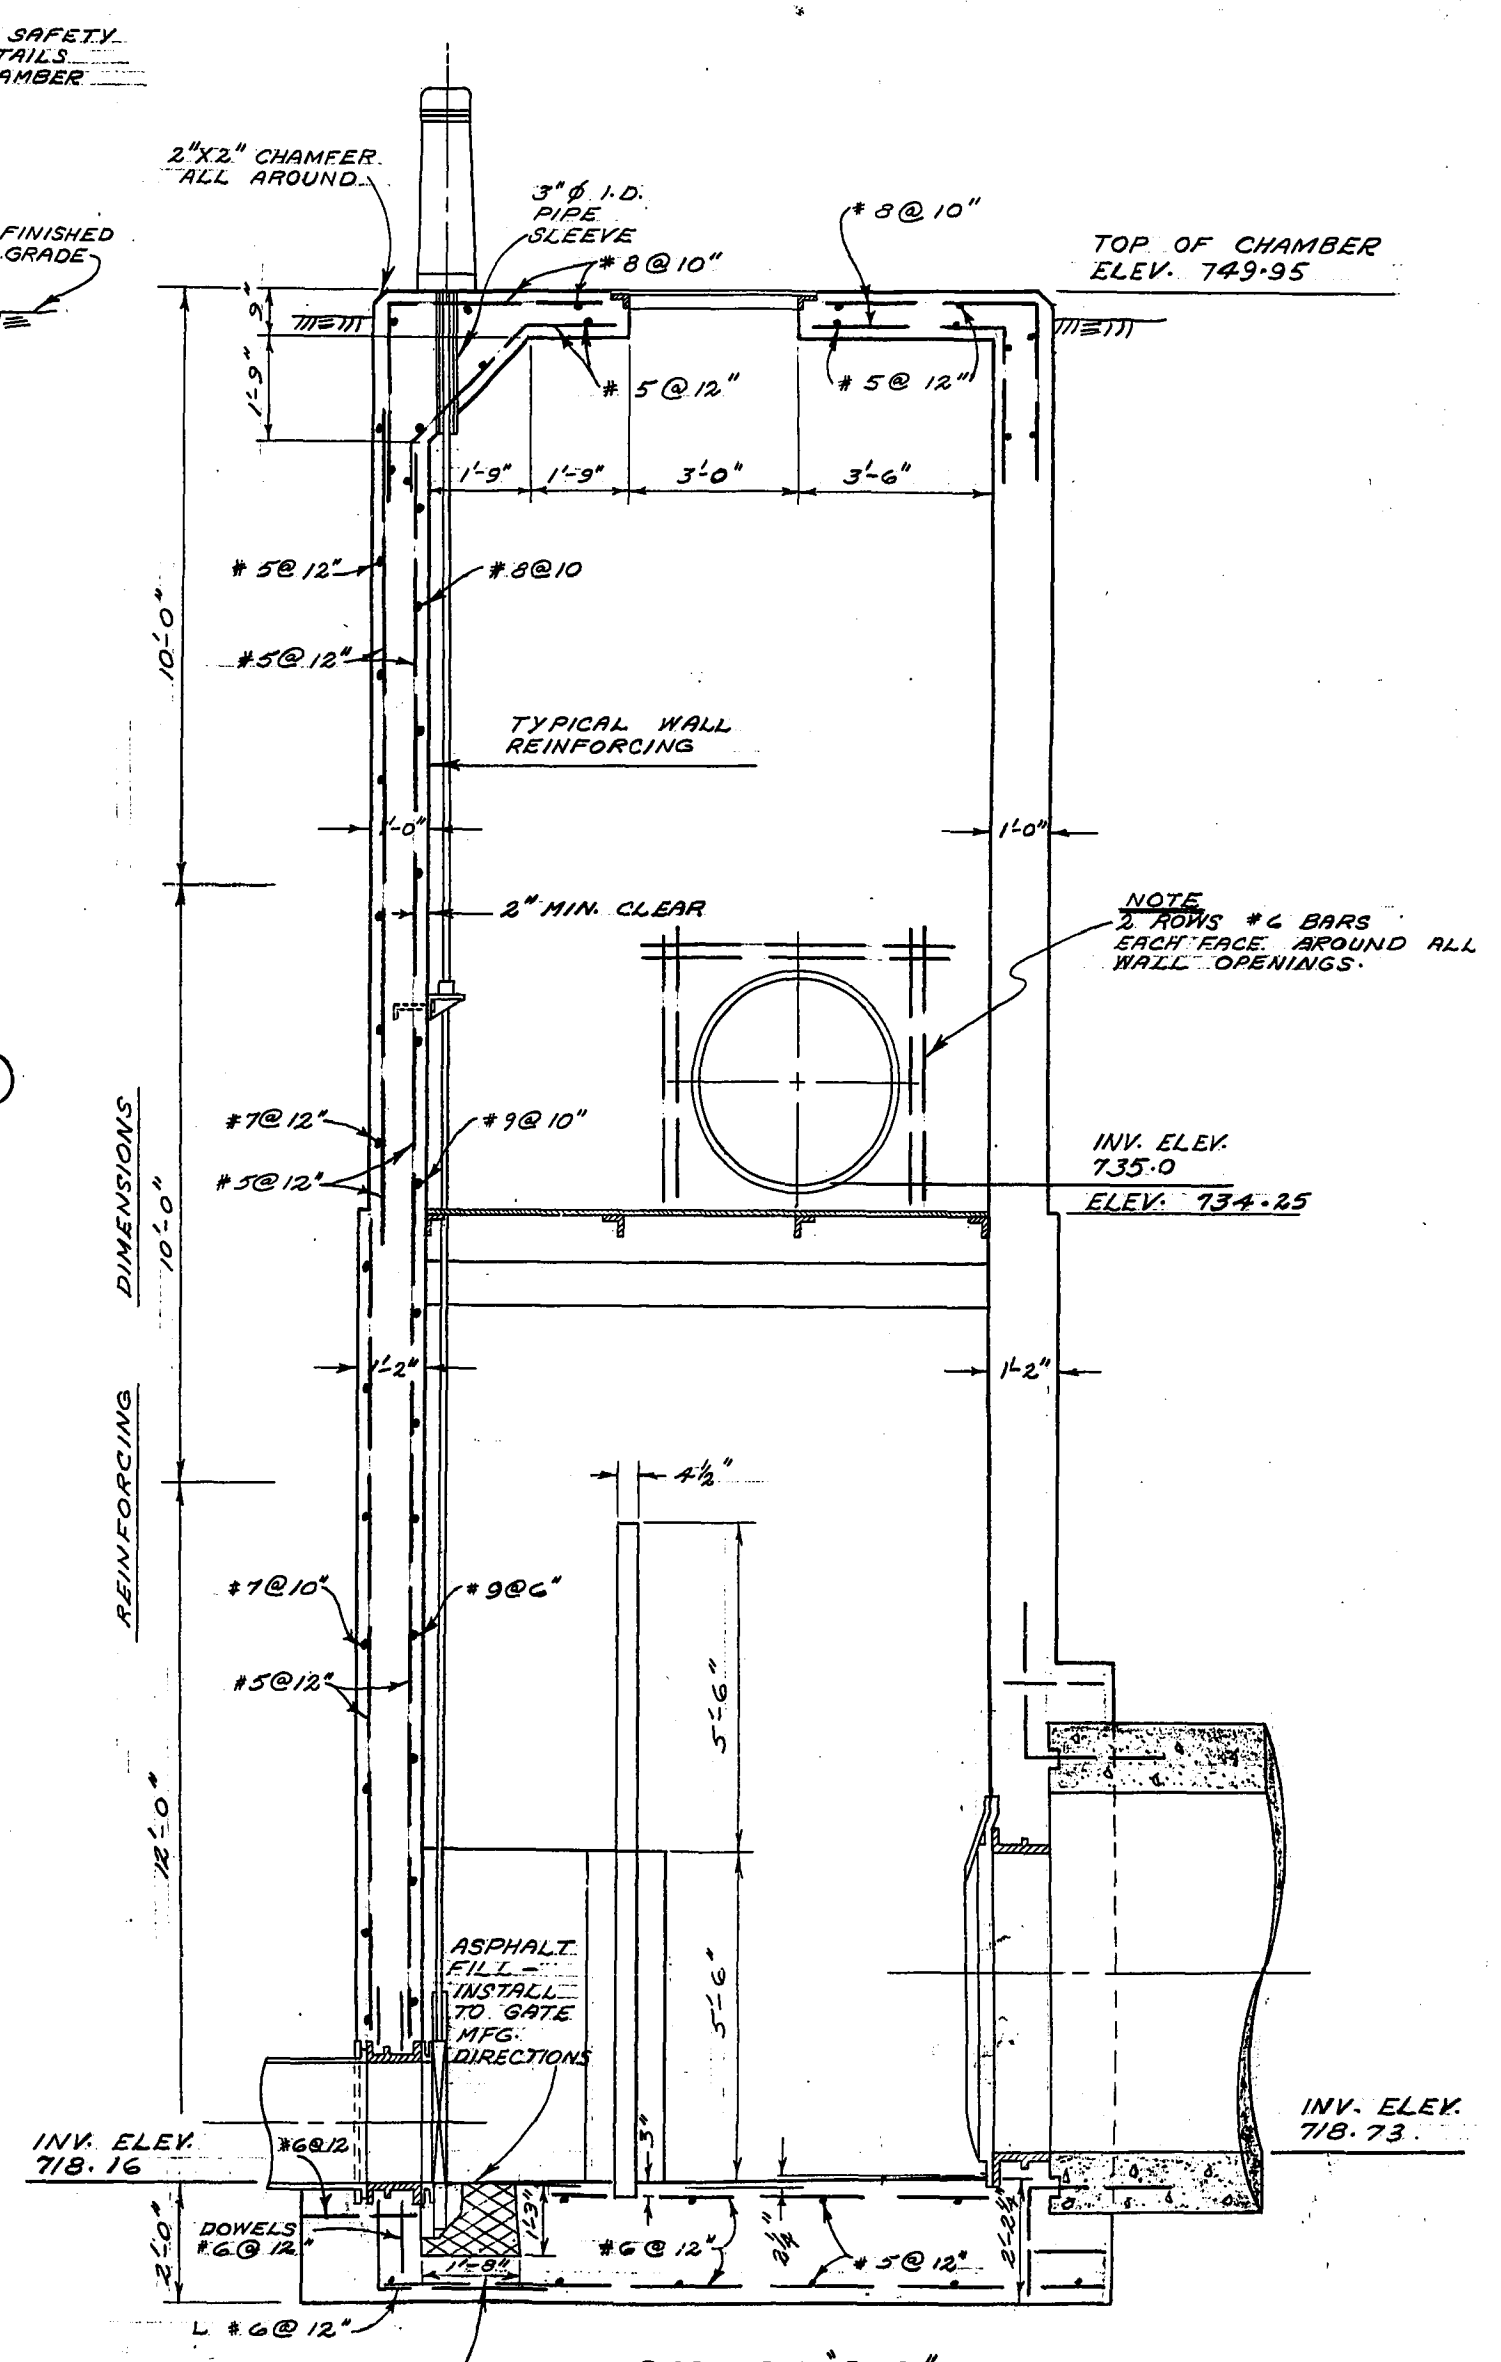


SURVEYED & PLAN CHECKED
BY: *[Signature]*
APPROVED AS BUILT
D. *[Signature]*
MAR 1972


THE METROPOLITAN CORPORATION
OF GREATER WINNIPEG
**WATERWORKS & WASTE
DISPOSAL DIVISION**
A. PENMAN - DIRECTOR

SEWAGE DISPOSAL DEPT.
**NORTH-EAST INTERCEPTOR
RIVER CROSSING
SIPHON INLET CHAMBER**
DES. *[Signature]* CH'KD. *[Signature]*
DRN. V. DUMORE DATE: Aug. 3/70
ENG. *[Signature]*
APPROVED: *[Signature]*
SCALES
3/8" = 1'-0"
DRAWING NO.
495

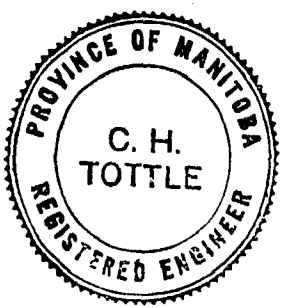


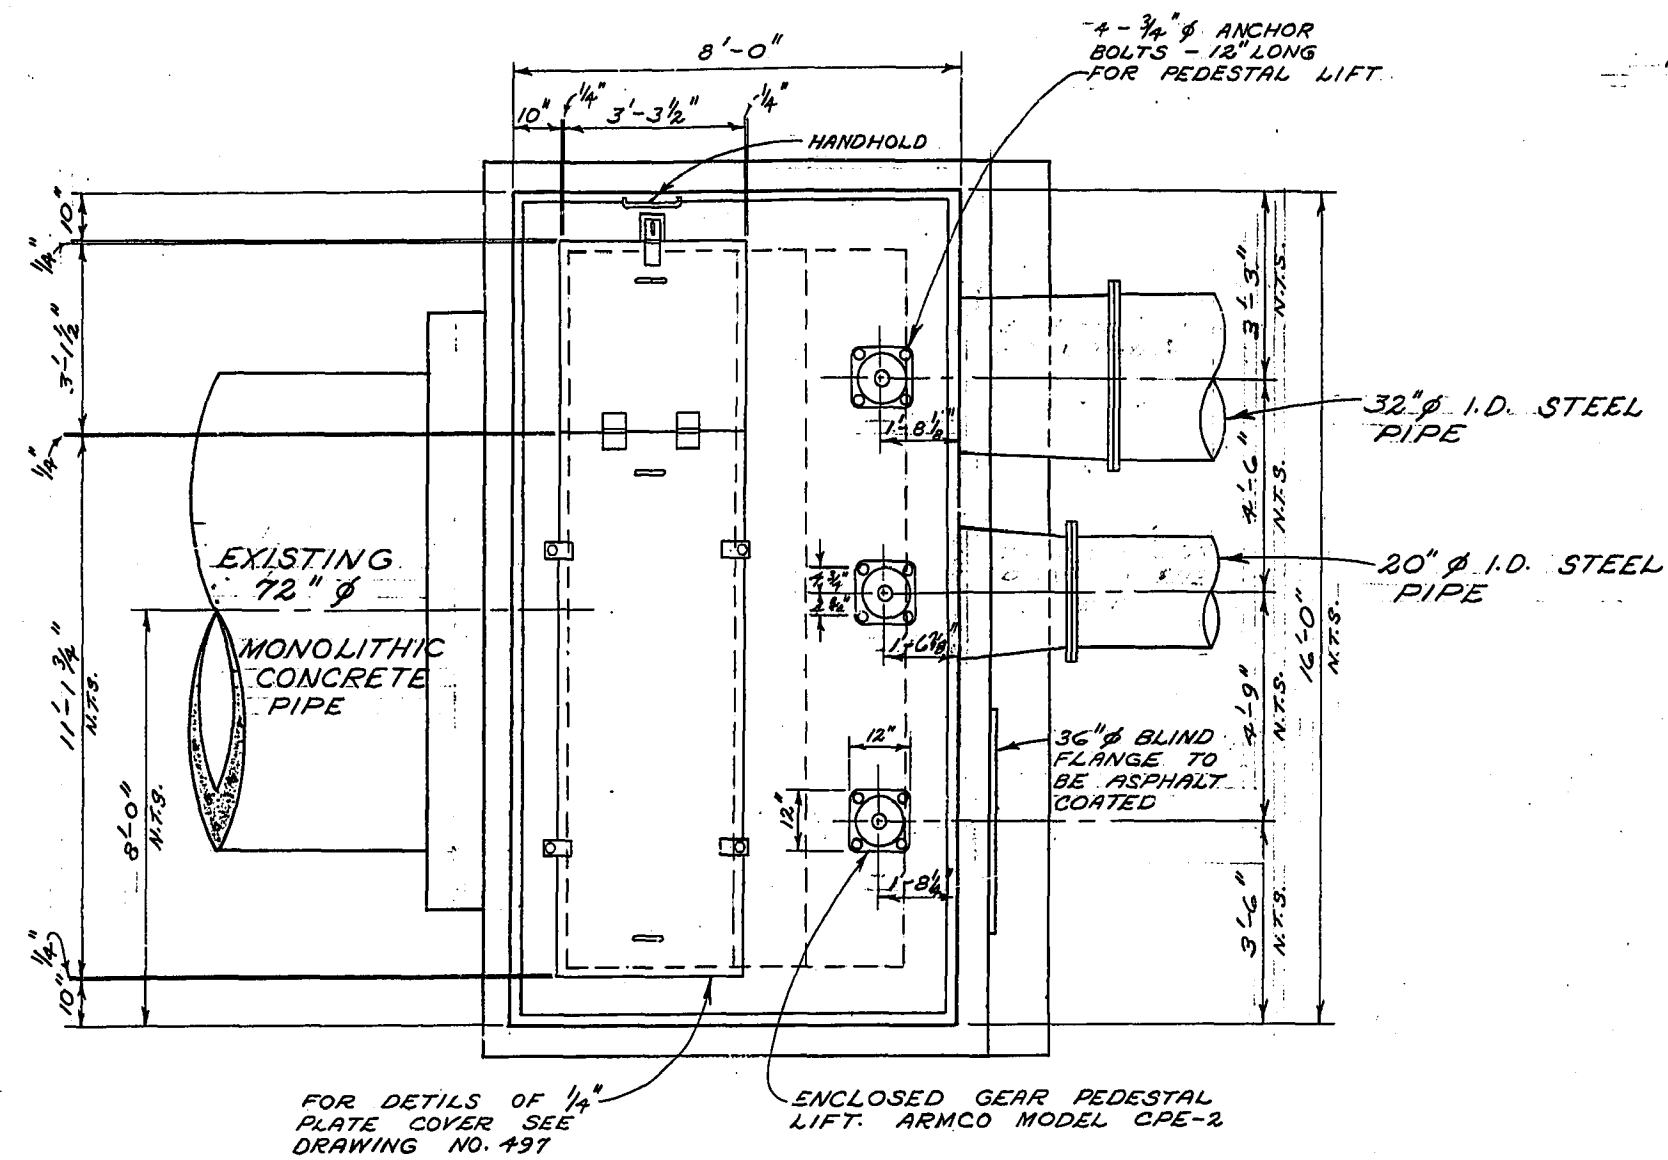


ROOF PLAN

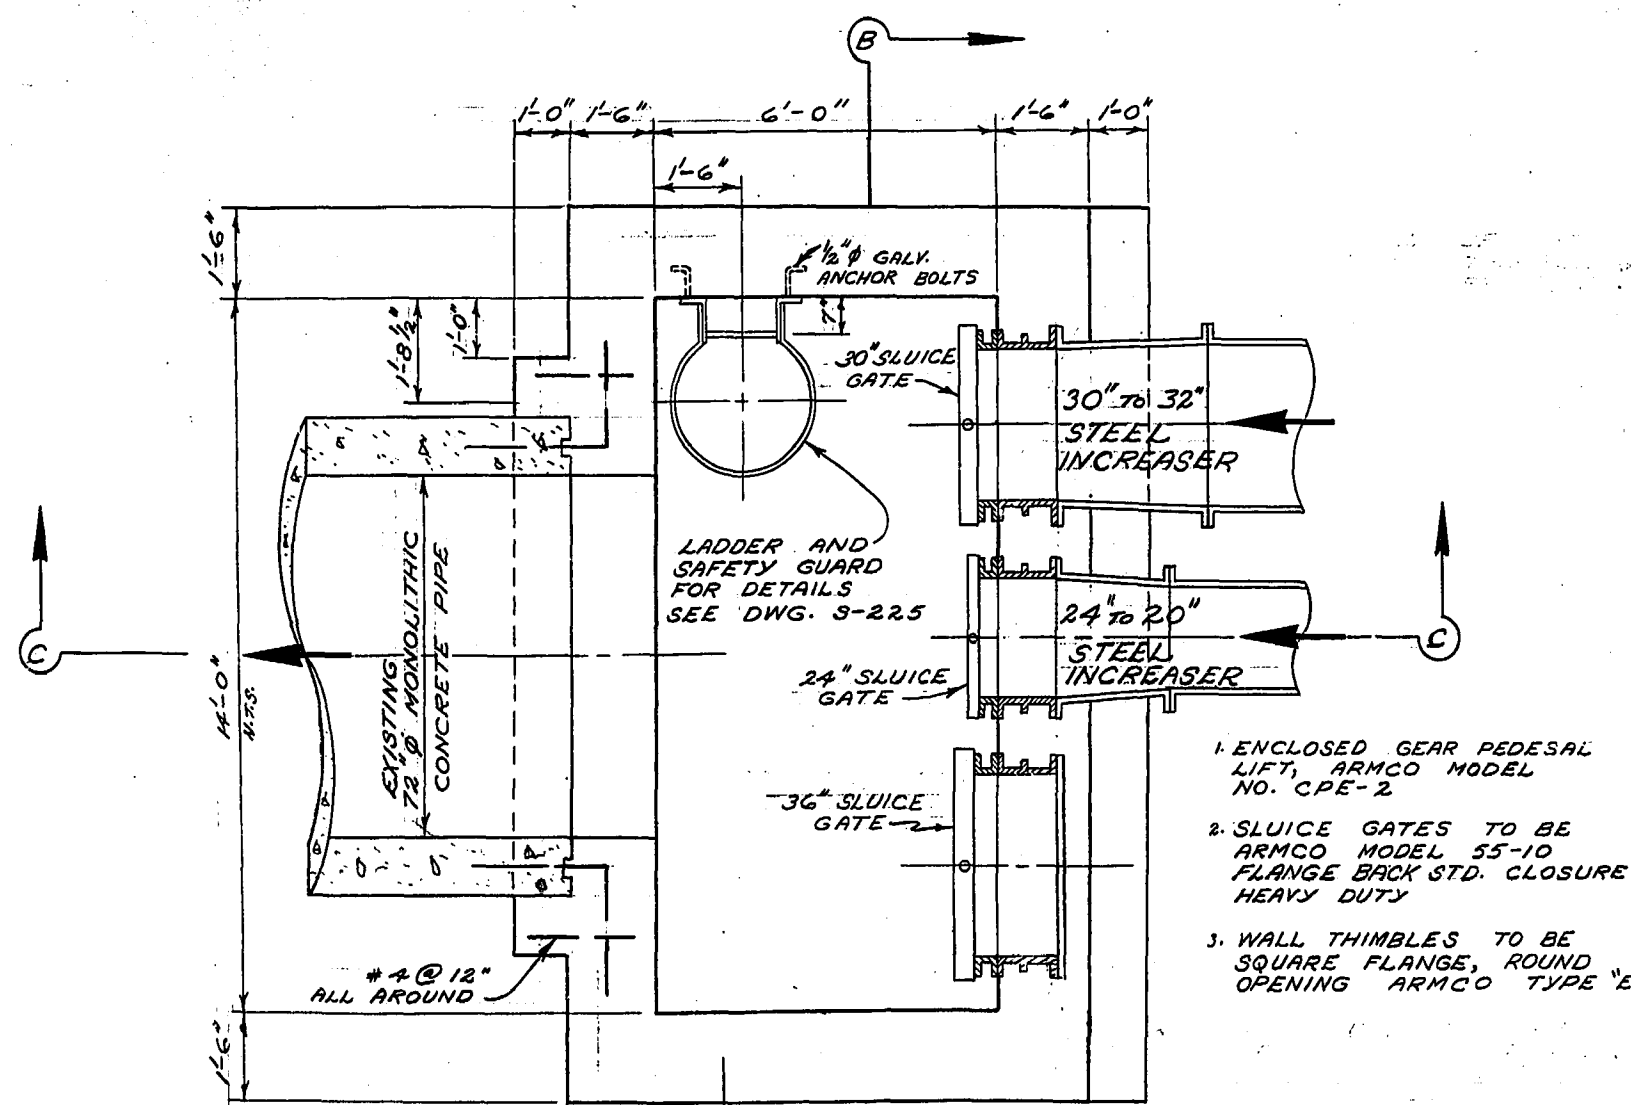

SECTION "A-A"

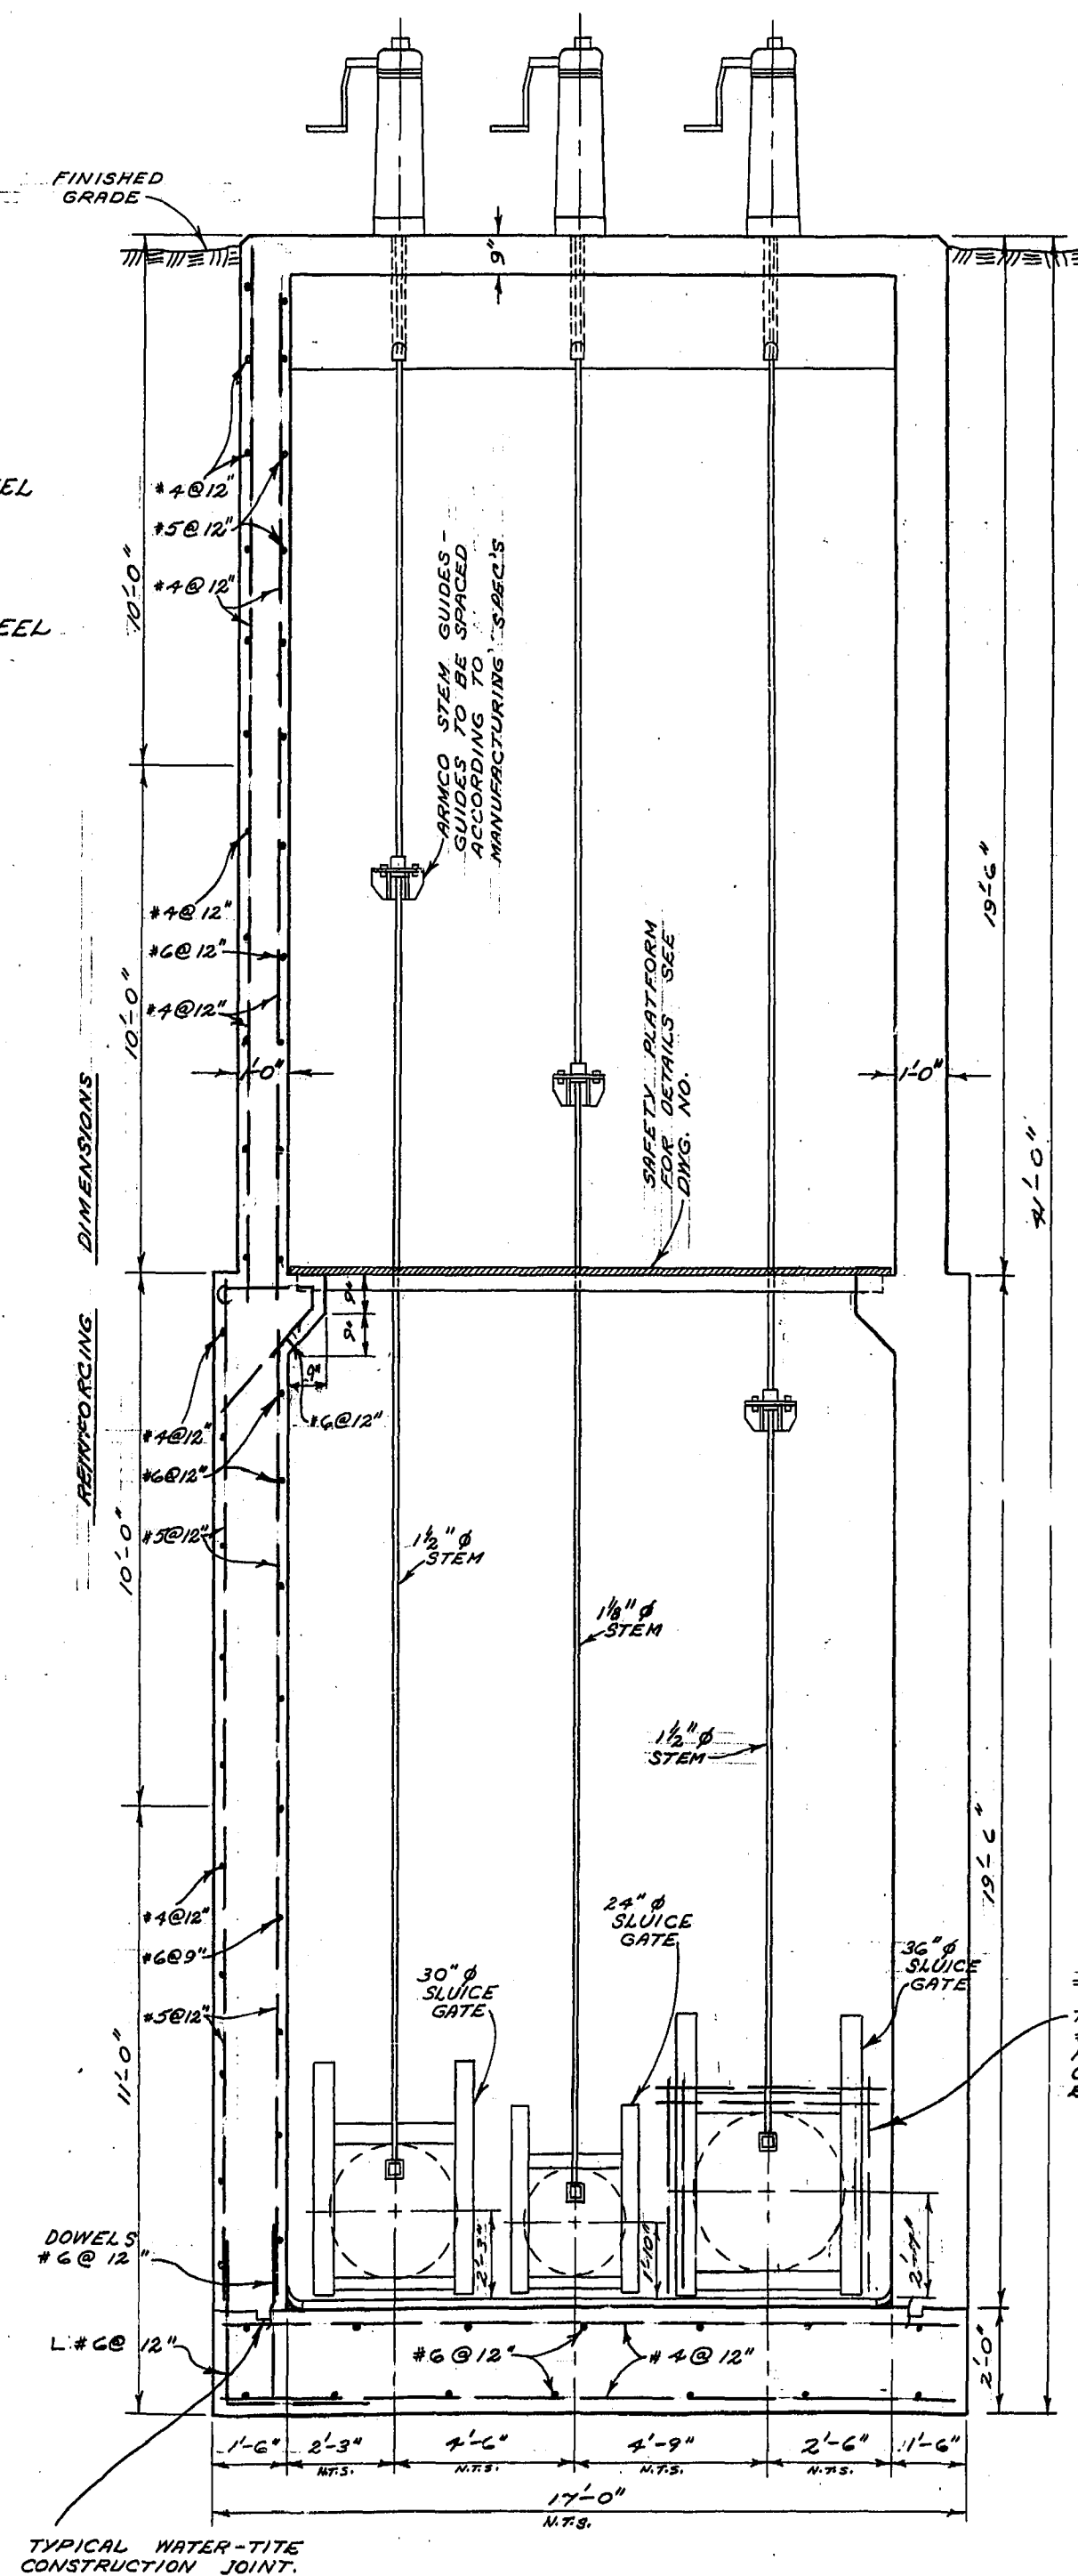

SECTION "B-B"

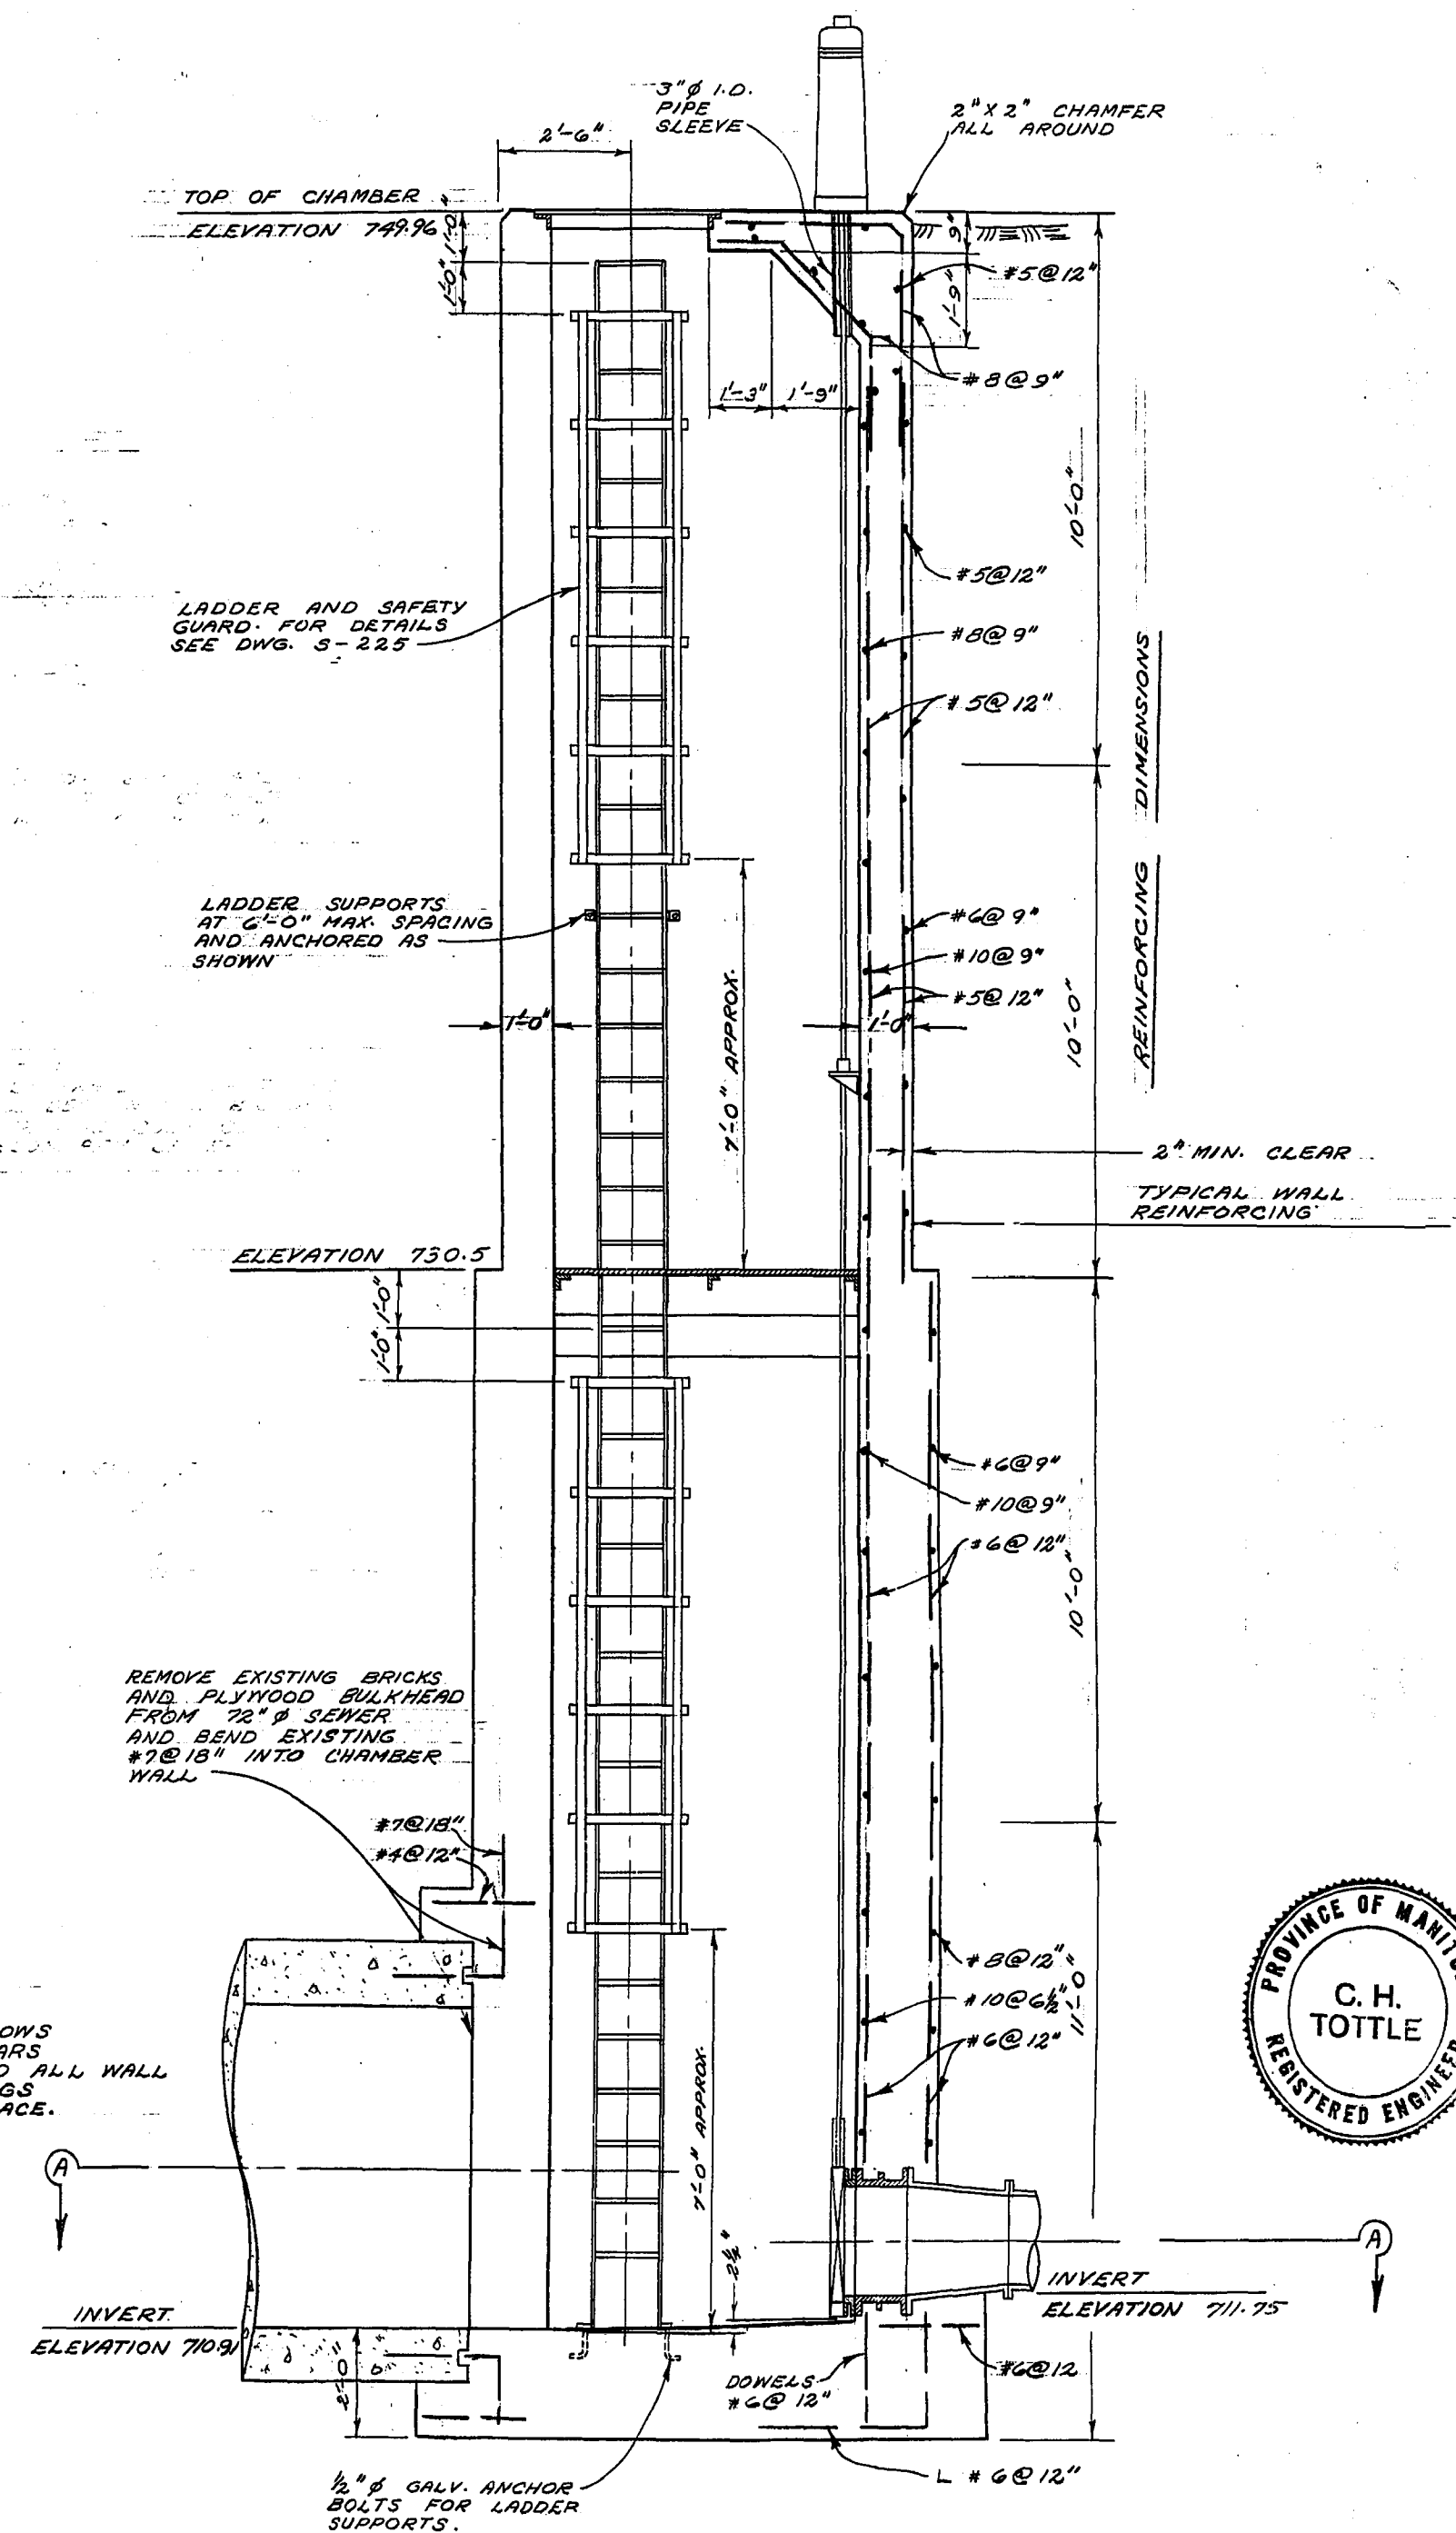


SECTION "C-C"

SURVEYED & PLAN CHECKED
BY: *[Signature]*
APPROVED AS BUILT
BY: *[Signature]*
DATE: MAR. 1972

THE METROPOLITAN CORPORATION
OF GREATER WINNIPEG
**WATERWORKS & WASTE
DISPOSAL DIVISION**
A. PENMAN - DIRECTOR

SEWAGE DISPOSAL DEPT. DES. *[Signature]* CH'KD. *[Signature]*
NORTH-EAST INTERCEPTOR
RIVER CROSSING
SIPHON OUTLET CHAMBER
DRN. V. DUMORE DATE JULY 170
ENG. DES. *[Signature]*
ENG. *[Signature]*
APPROVED *[Signature]*

SCALE: 3/8" = 1'-0"
DRAWING NO. 496

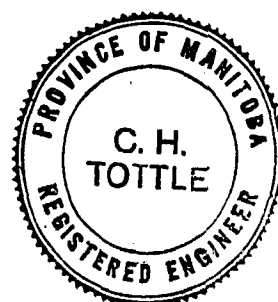

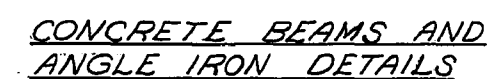


PLATE COVER FOR
INLET AND OUTLET CHAMBERS



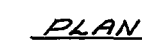


PLATE COVER FOR
OVERFLOW CHAMBER

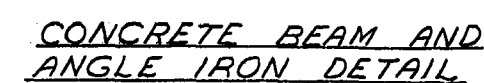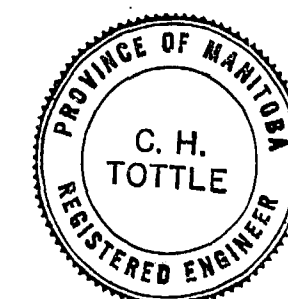

SURVEYED & PLAN CHECKED

BY _____

APPROVED AS BUILT.

BY M.D. D.S. *[Signature]*
Nov 1972

**THE METROPOLITAN CORPORATION
OF GREATER WINNIPEG**




**WATERWORKS & WASTE
DISPOSAL DIVISION**

PENMAN — DIRECTOR

SEWAGE DISPOSAL DEPT. DES. *2476* CH'K'D. *AN*
NORTH-EAST INTERCEPTOR DRN. *V. DUMORE* DATE *5/27/76*
RIVER CROSSING ENG. DES. *2476*
MISC. DETAILS ENG. *[Signature]*
APPROVED *[Signature]*

SCALES
 $\frac{1}{2}'' = 1'-0''$

DRAWING NO.
497

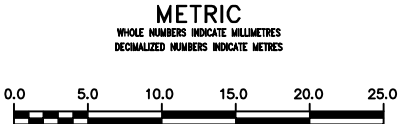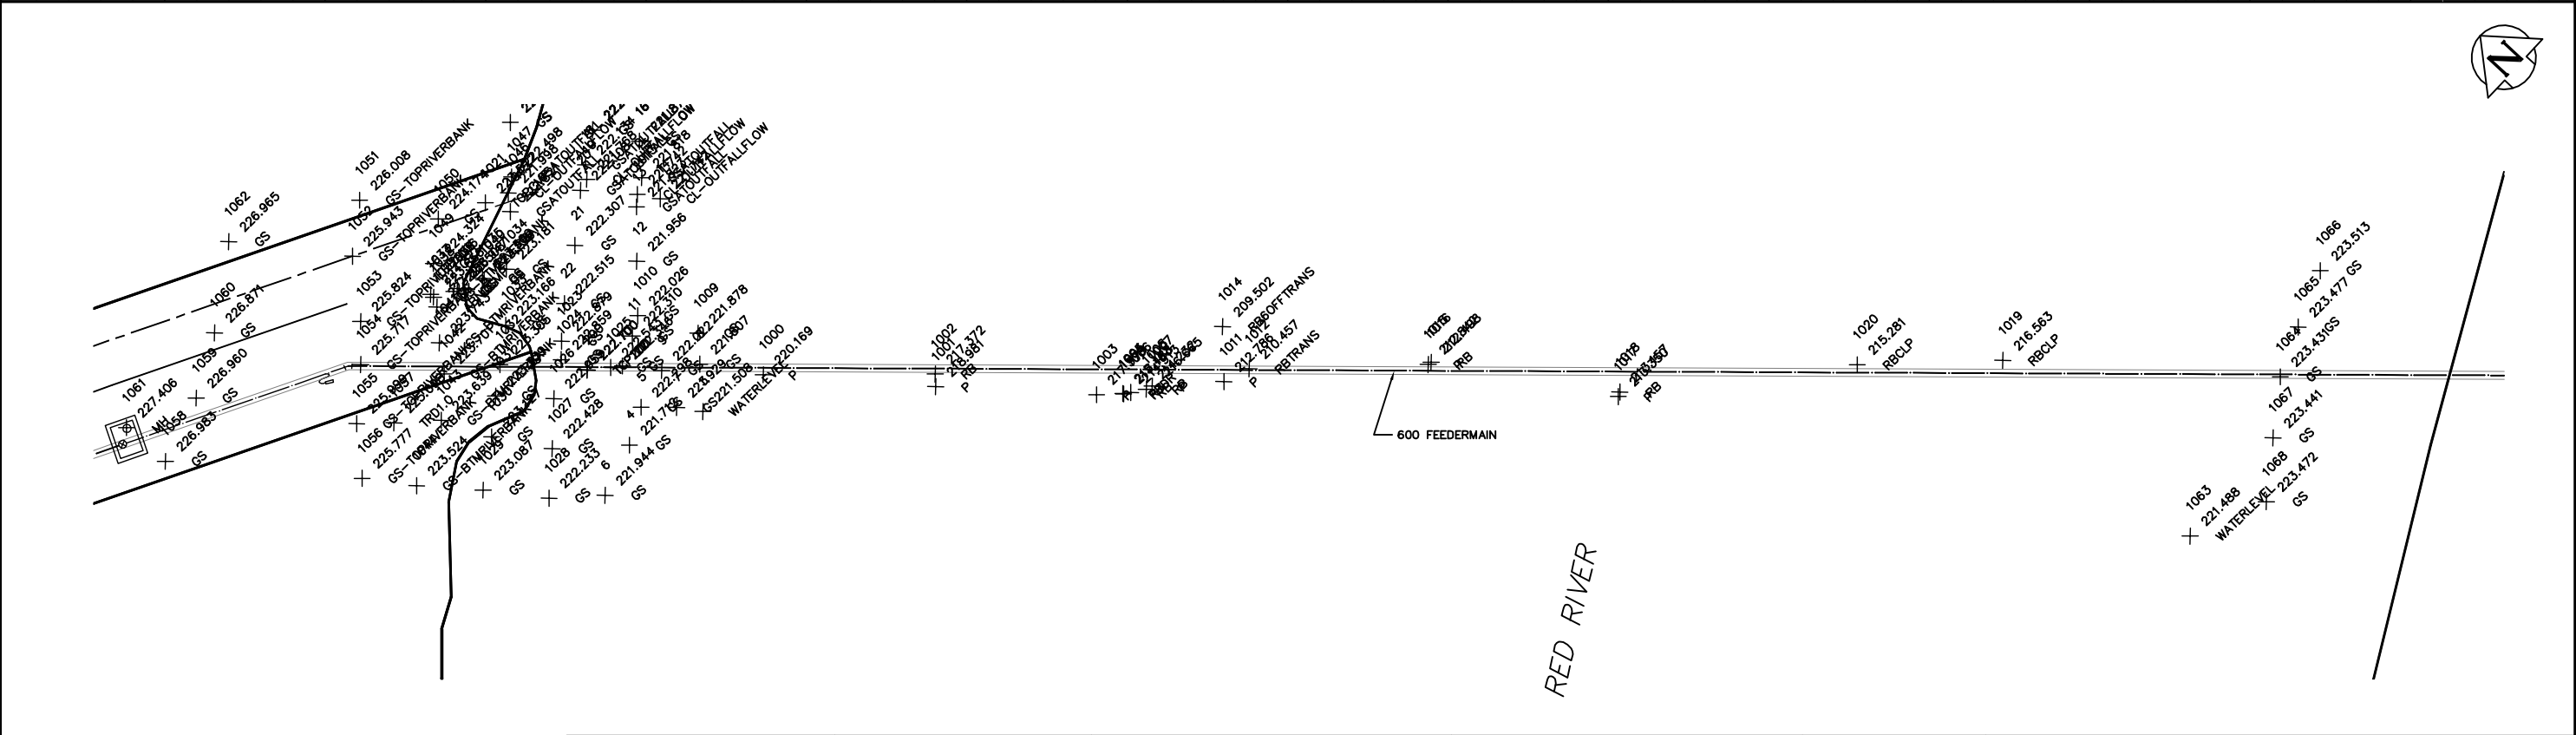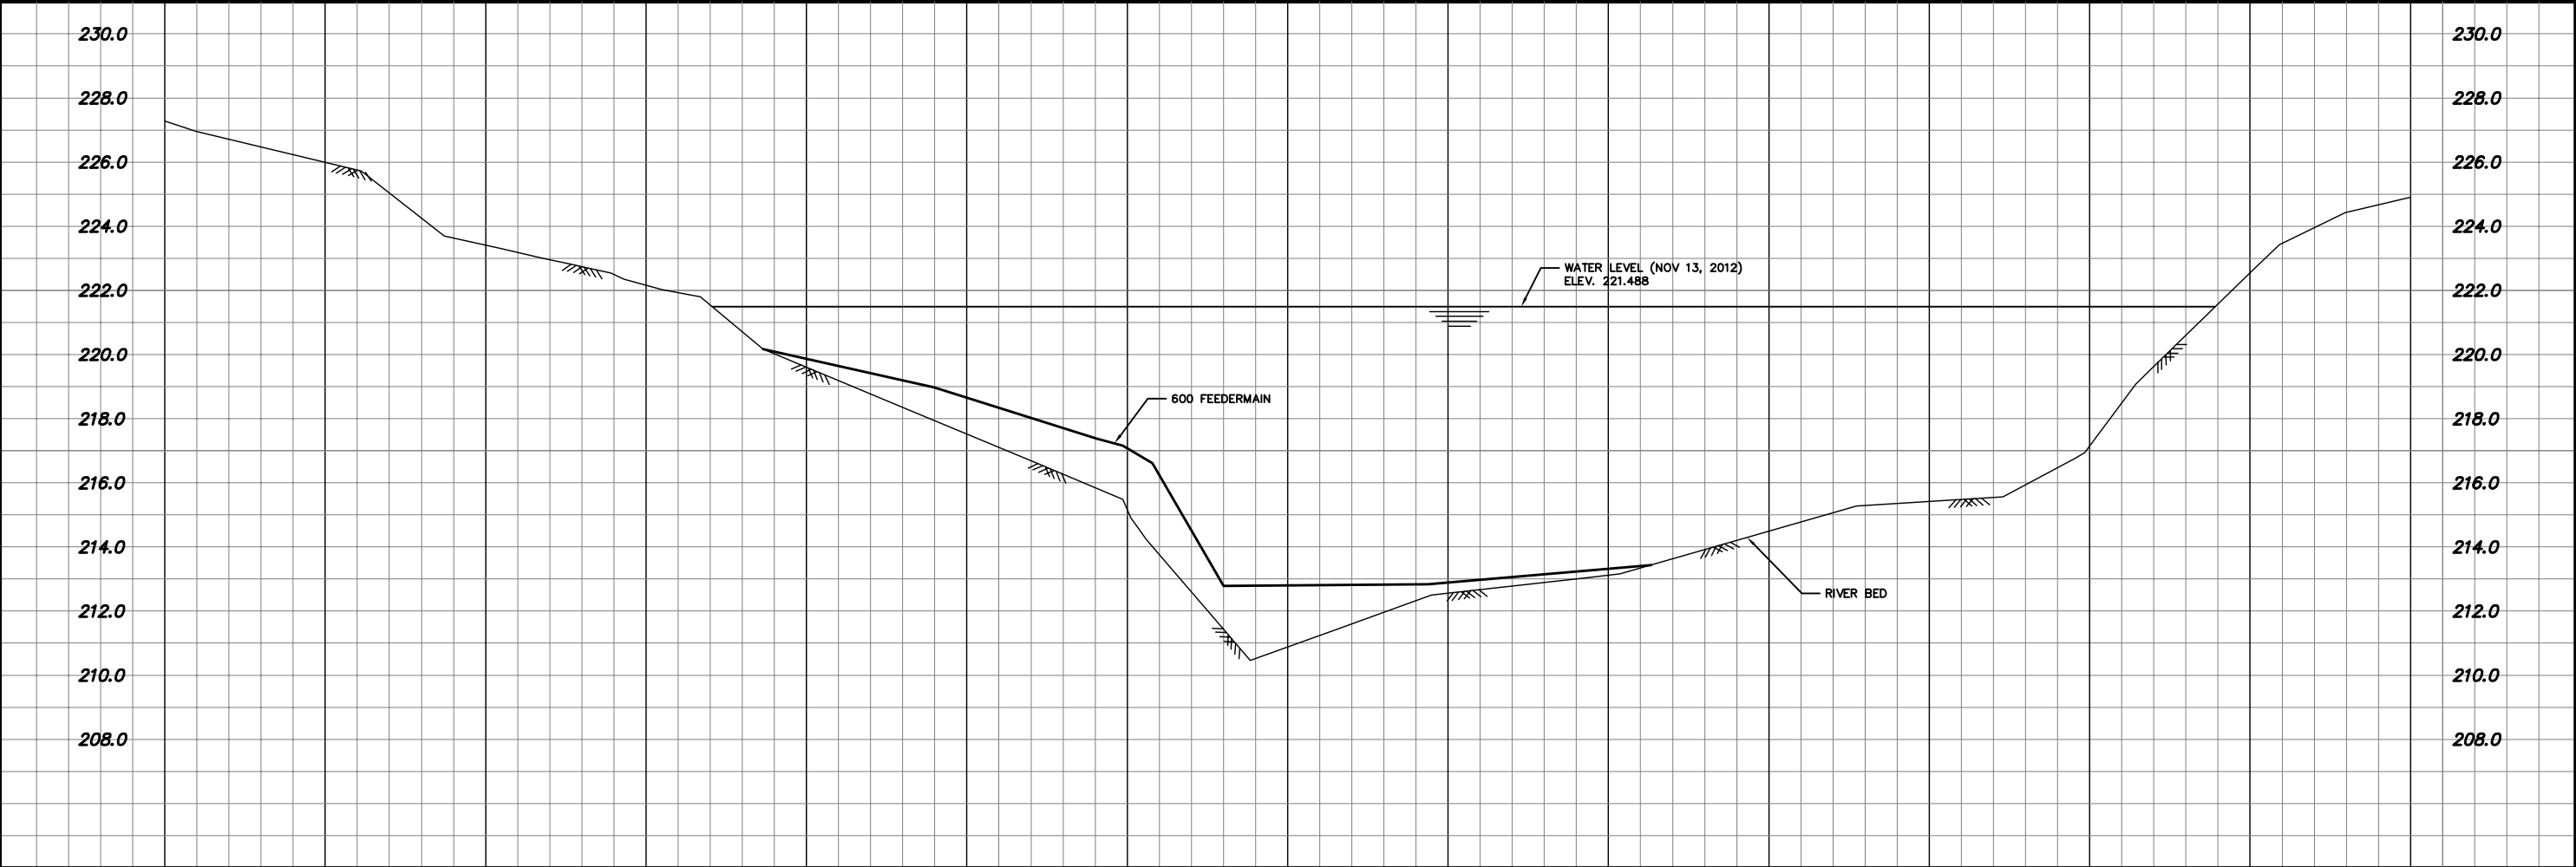

WARNING IF POWER EQUIPMENT OR EXPLOSIVES ARE TO BE USED FOR EXCAVATION ON THIS PROJECT THE CONTRACTOR MUST: 1) NOTIFY THE GAS COMPANY OF THE PROPOSED LOCATION OF EXCAVATION. 2) TAKE PRECAUTION TO AVOID DAMAGE TO GAS COMPANY INSTALLATIONS. SEE PROVINCIAL REGULATION 210/72 FOR DETAILS	LOCATION APPROVED UNDERGROUND STRUCTURES SUPV. U/G STRUCTURES COMMITTEE _____ DATE _____ NOTE: LOCATION OF UNDERGROUND STRUCTURES AS SHOWN ARE BASED ON THE BEST INFORMATION AVAILABLE BUT NO GUARANTEE IS GIVEN THAT ALL EXISTING UTILITIES ARE SHOWN OR THAT THE GIVEN LOCATIONS ARE EXACT. CONFIRMATION OF EXISTENCE AND EXACT LOCATION OF ALL SERVICES MUST BE OBTAINED FROM THE INDIVIDUAL UTILITIES BEFORE PROCEEDING WITH CONSTRUCTION.	B.M. ELEV. CONSTRUCTION COMPLETION DATE: YYYY MM DD		DESIGNED BY XX CHECKED BY XX	
		NO. _____ REVISIONS _____ DATE _____ BY _____		DRAWN BY XX APPROVED BY XX	
		SCALE: HORIZONTAL 1:250 VERTICAL 1:100		RELEASED FOR CONSTRUCTION DATE _____	
		PLOT DATE: 2012 11 14		DATE _____	
		BID OPPORTUNITY: XXX-20XX CONTRACT NUMBER: X		ENGINEER'S SEAL	
		FILE PATH: R:\DRAWINGS\WATER\RENEWAL\2013_RENEWALS\John Black Feedermain Crossing\ FILE NAME: SHOTS.dwg		CONSULTANT DRAWING NUMBER _____	
		THE CITY OF WINNIPEG WATER AND WASTE DEPARTMENT ENGINEERING DIVISION		SHEET X OF X CITY DRAWING NUMBER _____	
		JOHN BLACK RIVER CROSSING RIVER BED PROFILE			

DYREGROV & BURGESS

BOREHOLE LOG

PROJECT

Kildonan Corridor

LOGGED/DWN. SDG

CKD.

NCB

DATE OF INVEST. 6/08/87

JOB NO. 87422

HOLE NO. 1

WATER CONTENT

W_p - □ W - ○ W_L - △

PERCENT %

10 20 30 40 50 60

DEPTH

(M)

SOIL SYMBOL

SOIL DESCRIPTION

SOIL SAMPLE

DRILL TYPE

450 & 500 mm
Augers

DATUM Geodetic

SURFACE ELEVATION 230.63 m

CONDITION

TYPE

PENETRATION
RESISTANCE

OTHER TESTS

Fill
Clay -black
Clay -silty
-brown
-stiff
-alluvial

Silt -tan
-wet to saturated
-firm

Clay -mottled brown
-highly plastic
-stiff
-lacustrine

End hole at 7.6 m.
Seepage and caving from 2.4 to
2.7 m.

qu=109.7kpa
γ_w=16.48kn/m³
pp=146.0kpa
Tv=84.7kpa

BOREHOLE LOG

PROJECT

Kildonan Corridor

LOGGED/DWN.

SDG

CKD.

NCB

DATE OF INVEST. 6/08/87

JOB NO. 87422

HOLE NO. 2

WATER CONTENT

SOIL DESCRIPTION

SOIL SAMPLE

DRILL TYPE

W_P - □ W - ○ W_L - △

PERCENT %

DEPTH
(M)

SOIL SYMBOL

DATUM Geodetic
SURFACE ELEVATION 230.91 m

CONDITION

TYPE

**PENETRATION
RESISTANCE**

450 & 500 mm
Augers

OTHER TESTS

0

Fill -clay, silt, some gravel

-1

Clay -black

Clay -silty
-brown
-stiff

-2

-3

Silt -tan
-saturated

-4

Clay -mottled brown
-highly plastic
-firm to stiff
-lacustrine

5

-6

-7

8

-9

-10

-11

End hole at 10.7 m.
Seepage and caving from silt layer

$q_u = 47.2 \text{ kPa}$
 $\gamma_w = 16.51 \text{ kN/m}^3$
 $p_p = 93.4 \text{ kPa}$
 $T_v = 81.2 \text{ kPa}$

$$\begin{aligned} q_u &= 150.1 \text{ kpa} \\ Y_w &= 16.85 \text{ kn/m}^3 \\ p_p &= 125.4 \text{ kpa} \\ T_v &= 77.8 \text{ kpa} \end{aligned}$$

$q_u = 131.8 \text{ kPa}$
 $\gamma_w = 17.60 \text{ kN/m}^3$
 $p_p = 117.8 \text{ kPa}$
 $T_v = 60.3 \text{ kPa}$

Plate A-3

BOREHOLE LOG

PROJECT

Kildonan Corridor

LOGGED/DWN

SDG

CKD.

NCB

DATE OF INVEST. 6/08/87

JOB NO. 87422

HOLE NO. 3

WATER CONTENT

Wp-□ W-O W_L-△.

10 20 30 40 50 60

DEPTH

(M)

SOIL DESCRIPTION

DATUM Geodetic

SURFACE ELEVATION 230.58 m

[illegible]**CONDITION**


TYPE

**PENETRATION
RESISTANCE**

DRILL TYPE

500 mm
Auger

OTHER TESTS

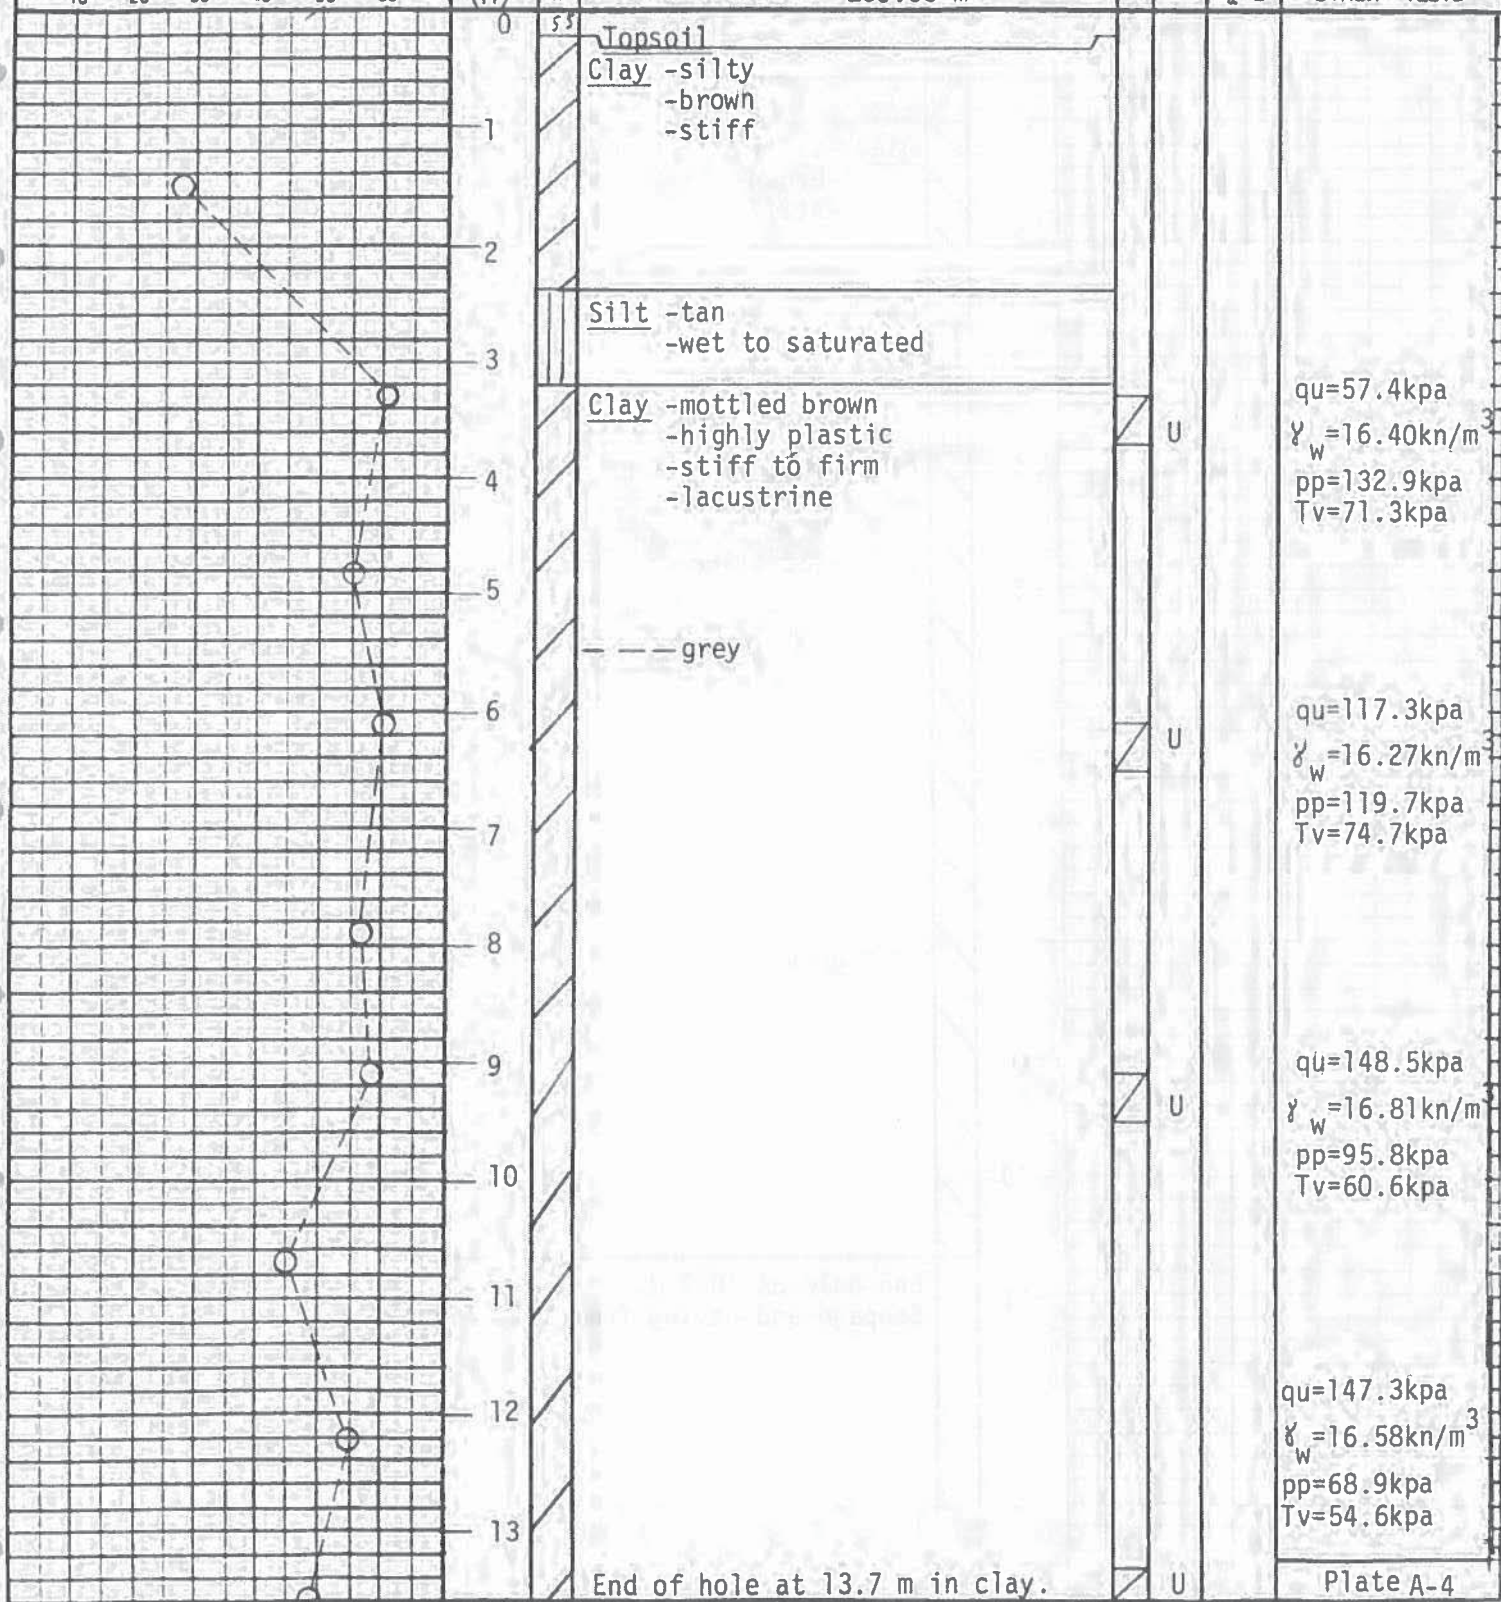

DYREGROV & BURGESS

BOREHOLE LOG

PROJECT

Kildonan Corridor

LOGGED/DWN. SDG CKD. NCB DATE OF INVEST. 6/08/87 JOB NO. 87422 HOLE NO. 4

WATER CONTENT			DEPTH (M)	SOIL SYMBOL	SOIL DESCRIPTION		SOIL SAMPLE			DRILL TYPE
$w_p - \square$	$w - \circ$	$w_L - \Delta$			DATUM	Geodetic	CONDITION	TYPE	PENETRATION RESISTANCE	450 & 500 mm Augers
PERCENT %					SURFACE ELEVATION 230.64 m					OTHER TESTS
10	20	30	40	50	60					
			0	X	Fill -clay -concrete rubble					
			1	X						
			2	X	Clay -silty -brown					
			3	X	Silt -tan -wet to saturated					
			4	X	Clay -mottled brown -highly plastic -stiff to firm -lacustrine					
			5	X						
			6	X						
			7	X	grey					
			8	X						
			9	X						
			10	X						
			11	X						
			12	X						
			13	X						

$\gamma_w = 16.30 \text{ kn/m}^3$
 $pp = 108.9 \text{ kpa}$
 $Tv = 57.4 \text{ kpa}$

$qu = 135.1 \text{ kpa}$
 $\gamma_w = 17.00 \text{ kn/m}^3$
 $pp = 147.5 \text{ kpa}$
 $Tv = 72.8 \text{ kpa}$

$qu = 106.7 \text{ kpa}$
 $\gamma_w = 16.72 \text{ kn/m}^3$
 $pp = 93.8 \text{ kpa}$
 $Tv = 56.0 \text{ kpa}$

Plate A-5

BOREHOLE LOG

PROJECT

Kildonan Corridor

LOGGED/DWN.		SDG	CKD.	NCB	DATE OF INVEST.		6/08/87	JOB NO.		87422	HOLE NO.		4
WATER CONTENT					DEPTH (M)	SOIL SYMBOL	SOIL DESCRIPTION		SOIL SAMPLE			DRILL TYPE	
W _p - □ W - ○ W _L - △ PERCENT % 10 20 30 40 50 60							DATUM	Geodetic	CONDITION	TYPE	PENETRATION RESISTANCE	OTHER TESTS	
							SURFACE ELEVATION 230.64 m						
					14		Clay -grey -highly plastic -lacustrine		U			qu=68.2kpa $\gamma_w = 16.04 \text{ kn/m}^3$ pp=94.2kpa Tv=47.4kpa	
					15								
					16								
					17							qu=128.4kpa $\gamma_w = 16.51 \text{ kn/m}^3$ pp=81.4kpa Tv=43.6kpa	
					18								
					19		Silt (Glacial Till) -sandy, gravelly -wet -loose to 19.5 m -medium dense below 19.5 m						
					20								
					21		End of hole at 20.4 m. -Smooth auger refusal -Possible bedrock at 20.4 m -Water inflow from 20.4 m -Water level stabilized at 9.4 m in about 15 minutes						

DYREGROV & BURGESS

BOREHOLE LOG

PROJECT

Kildonan Corridor

LOGGED/DWN.

SDG

CKD.

NCB

DATE OF INVEST.

6/08/87

JOB NO. 87422

HOLE NO. 5

WATER CONTENT

Wp - □ W - ○ WL - △

PERCENT %

10 20 30 40 50 60

DEPTH

(M)

SOIL SYMBOL

SOIL DESCRIPTION

DATUM Geodetic

SURFACE ELEVATION 228.72 m

SOIL SAMPLE

CONDITION

TYPE

PENETRATION
RESISTANCE

DRILL TYPE

450 & 500 mm
Augers

OTHER TESTS

Fill -silty
-clay

Clay -black
Clay -silty
-brown
-alluvial

Clay -mottled brown
-highly plastic
-stiff to firm
-lacustrine

---grey

See Dilatometer
Test Results
(DMT 2)

qu=53.7kpa
 $\gamma_w = 16.18 \text{ kn/m}^3$
pp=112.5kpa
Tv=59.4kpa

qu=114.2kpa
 $\gamma_w = 17.38 \text{ kn/m}^3$
pp=122.6kpa
Tv=62.7kpa

qu=95.3kpa
 $\gamma_w = 17.78 \text{ kn/m}^3$
pp=66.1kpa
Tv=39.7kpa

Plate A-7

DYREGROV & BURGESS				BOREHOLE LOG					
				PROJECT Kildonan Corridor					
LOGGED/DWN		SDG	CKD.	NCB	DATE OF INVEST.	JOB NO.	HOLE NO.		
					6/08/87	87422	5		
WATER CONTENT			DEPTH (M)	SOIL SYMBOL	SOIL DESCRIPTION	SOIL SAMPLE			DRILL TYPE 450 & 500 mm Augers
W _p - □	W - ○	W _L - △				CONDITION	TYPE	PENETRATION RESISTANCE	
PERCENT %									
10	20	30	40	50	60	DATUM Geodetic			OTHER TESTS
SURFACE ELEVATION 228.72 m									
			14	Clay (cont'd)	U			qu=118.4kpa γ _w =16.51kn/m ³ pp=103.4kpa Tv=49.3kpa	
			15						
			16						
			17	Silt (Glacial Till) -sandy -gravelly -clayey -loose					
			18						
			19	End of hole at 18.7 m -Possible bedrock -No seepage					

DYREGROV & BURGESS

BOREHOLE LOG

PROJECT

Kildonan Corridor

LOGGED/DWN.		SDG	CKD.	NCB	DATE OF INVEST.		JOB NO.	HOLE NO.	
					10/08/87		87422	6	
WATER CONTENT					SOIL DESCRIPTION		SOIL SAMPLE		
Wp - □ W - ○ W _L - △ PERCENT % 10 20 30 40 50 60					DATUM Geodetic		CONDITION	TYPE	PENETRATION RESISTANCE
					SURFACE ELEVATION 227.47 m				
DEPTH (M)					SOIL SYMBOL		OTHER TESTS		
0					Clay	-silty -some sand -alluvial -stiff to 1.2 m -soft from 1.2 to 3.3 m			See dilatometer test results to 15.2 m depth (DMT 1)
1									
2									
3									
4					Sand	-little to some silt -trace to some clay -fine to medium grained -very dense, 5.2 - 6.4 m			-MA
5									
6						-medium grained, grey, saturated	U		-MA pp=35.9kpa
7									
8					Silt	-some sand -some to little clay -firm to stiff	U		-MA γ _w =18.00 kg/m ³ pp=67.0kpa Tv=31.6kpa
9									
10							U		γ _w =17.71kg/m ³ pp=88.6kpa Tv=15.8kpa
11									
12					Clay	-silty, very stiff, alluvial	U		-MA γ _w = 14.97kg/m ³ pp=52.7kpa
13									
					End of hole at 12.5 m Standpipe piezometers SP 1 and SP 2 installed				
					Plate A-9				

DYREGROV & BURGESS

BOREHOLE LOG

PROJECT

Kildonan Corridor

LOGGED/DWN. SDG CKD NCB DATE OF INVEST. 10/08/87 JOB NO. 87422 HOLE NO. 6

WATER CONTENT

Wp - ☐ W - ☐ WL - ☐

PERCENT %

10 20 30 40 50 60

DEPTH

SOIL SYMBOL

SOIL DESCRIPTION

DATUM Geodetic

SURFACE ELEVATION 227.47 m

SOIL SAMPLE

CONDITION

TYPE

PENETRATION
RESISTANCE

DRILL TYPE

Hollowstem
550 & 600 mm

Augers

OTHER TESTS

SP 1

Tip at 12.2 m
Sand to 11.6 m
Bentonite to 10.4 m
230 mm $\emptyset$ augers

SP 2

Tip at 6.1 m
Sand at 5.6 m
Bentonite to 4.6 m
230 mm $\emptyset$ augers
Pipe ID - 19 mm

DYREGROV & BURGESS

BOREHOLE LOG

PROJECT

Kildonan Corridor

LOGGED/DWN. SDG CKD. NCB DATE OF INVEST. 7/08/87 JOB NO. 87422 HOLE NO. 7

WATER CONTENT						DEPTH (M)	SOIL SYMBOL	SOIL DESCRIPTION	SOIL SAMPLE			DRILL TYPE	
W _p - □	W - ○	W _L - △	PERCENT %						DATUM	CONDITION	TYPE	PENETRATION RESISTANCE	450 & 600 mm Augers
10	20	30	40	50	60				Geodetic				OTHER TESTS
						0	SS	Topsoil					
						1		Silt -sandy -some clay -brown -alluvial					
						2							
						3		Sand -some silt -trace clay -saturated				MA	
						4							
						5		Silt -some sand and clay -grey -wet -firm					
						6							
						7							
						8			U			MA γ _w =17.95kg/m ³ pp=61.3kpa Tv=32.6kpa	
						9		Sand -fine grained -grey, saturated					
						10		Silt -some sand and clay					
						11		Clay -grey -highly plastic -firm 100 mm gravel layer, shells	U			qu=67.7kpa γ _w =18.34kg/m ³ pp=151.2kpa Tv=69.9kpa	
						12							
						13							

Plate A-11

Plate A-11

DYREGROV & BURGESS

BOREHOLE LOG

PROJECT

Kildonan Corridor

LOGGED/DWN. SDG

CKD.

NCB

DATE OF INVEST. 7/08/87

JOB NO. 87422

HOLE NO. 7

WATER CONTENT

w_p - $\square$ w - $\circ$ w_L - Δ

PERCENT %

10 20 30 40 50 60

DEPTH

(M)

SOIL SYMBOL

SOIL DESCRIPTION

SOIL SAMPLE

DRILL TYPE

DATUM Geodetic

SURFACE ELEVATION 227.13 m

CONDITION

TYPE

PENETRATION
RESISTANCE

550 & 600 mm
Augers

OTHER TESTS

14

15

16

17

---Clay & Glacial Till

Silt (Glacial Till)
-wet, loose, clayey

End of hole at 16.2 m.
-Smooth auger refusal
-Water seepage 20 minutes after
completion of drilling
-600 mm casing to 10 m depth
-Possible bedrock at 16.2 m

DYREGROV & BURGESS

BOREHOLE LOG

PROJECT

Kildonan Corridor

LOGGED/OWN

SDG

CKD.

NCB

DATE OF INVEST.

7/08/87

JOB NO.

87422

HOLE NO.

8

WATER CONTENT

W_p - □ W - ○ W_L - △

PERCENT %

10 20 30 40 50 60

DEPTH

(M)

SOIL SYMBOL

SOIL DESCRIPTION

DATUM Geodetic

SURFACE ELEVATION 227.17 m

SOIL SAMPLE

CONDITION

TYPE

PENETRATION
RESISTANCE

DRILL TYPE

550 & 600 mm
Augers

OTHER TESTS

Fill -clay, concrete rubble

Silt -clayey, brown, stiff
-alluvial

Sand -fine grained
-some silt
-brown

---saturated

---grey

Silt -some sand and clay
-wet
-stiff to firm

---50 mm gravel layer

Clay -grey
-highly plastic
-stiff to firm

$\gamma_w = 18.01 \text{ kg/m}^3$
pp=56.2kpa
Tv=39.7kpa

qu=57.3kpa
 $\gamma_w = 16.97 \text{ kg/m}^3$
pp=183.8kpa
Tv=62.2kpa

qu=49.1kpa
 $\gamma_w = 15.97 \text{ kg/m}^3$
pp=101.5kpa
Tv=57.4kpa

Plate A-13

DYREGROV & BURGESS

BOREHOLE LOG

PROJECT

Kildonan Corridor

LOGGED/DWN		SDG	CKD.	NCB	DATE OF INVEST. 7/08/87		JOB NO. 87422		HOLE NO. 8		
WATER CONTENT					DEPTH (M)	SOIL SYMBOL	SOIL DESCRIPTION		SOIL SAMPLE		DRILL TYPE
W _p - □ W - ○ W _L - △ PERCENT % 10 20 30 40 50 60							DATUM Geodetic SURFACE ELEVATION 227.17 m		CONDITION	TYPE	PENETRATION RESISTANCE
					14	Clay (cont'd)					OTHER TESTS
					15						
					16	Silt (Glacial Till) -sandy, gravelly -some clay -tan -seepage from 16.5 m					
					17						
					18	End of hole at 17.7 m -Rough auger refusal at 17.7 m -Water level at 7.2 m on completion of drilling -600 mm casing to 4.6 below grade					

DYREGROV & BURGESS

BOREHOLE LOG

PROJECT

Kildonan Corridor

LOGGED/DWN		SDG	CKD	NCB	DATE OF INVEST.		JOB NO.		HOLE NO.		
					27/08/87		87422		12		
WATER CONTENT					DEPTH (M)	SOIL SYMBOL	SOIL DESCRIPTION		SOIL SAMPLE		DRILL TYPE
W _p - □	W - ○	W _L - △	PERCENT %				DATUM	Geodetic	CONDITION	TYPE	PENETRATION RESISTANCE
10	20	30	40	50	60						
						0	Fill -clay -some gravel				P1
						1	Clay -silty -brown -stiff -alluvial -medium to highly plastic				Pneumatic piezometer tip @ 7.8m sand to 7.1 m bent. to 6.1m
						2					
						3			U		qu=46.4kpa $\gamma_w = 18.00 \text{ kn/m}^3$ pp=97.0kpa Tv=27.8kpa
						4					
						5	---grey				
						6			U		$\gamma_w = 17.37 \text{ kn/m}^3$ pp=59.8kpa
						7					
						8					
						9					
						10	Clay -mottled brown to grey -highly plastic -lacustrine		U		qu=67.4kpa $\gamma_w = 19.95 \text{ kn/m}^3$ pp=143.6kpa
						11					
						12			U		qu=51.2kpa $\gamma_w = 17.60 \text{ kn/m}^3$ pp=87.8kpa Tv=58.4kpa
						13	End of hole at 12.8 m. Install pneumatic piezometer				Plate A-18

DYREGROV & BURGESS

BOREHOLE LOG

PROJECT

Kildonan Corridor

LOGGED/DWN. SDG

CKD.

NCB

DATE OF INVEST. 27/08/87

JOB NO. 87422

HOLE NO. 13

WATER CONTENT

Wp - □ W - ○ WL - Δ.

PERCENT %

10 20 30 40 50 60

DEPTH

(M)

SOIL SYMBOL

SOIL DESCRIPTION

SOIL SAMPLE

DRILL TYPE

DATUM Geodetic

SURFACE ELEVATION 227.60 m

CONDITION

TYPE

PENETRATION
RESISTANCE

Hollow Stem

OTHER TESTS

Fill -clay
-some gravel

Clay -silty
-brown
-alluvial

Clay -mottled brown
-highly plastic
-stiff to firm
-lacustrine

Station -
3+90.9

qu=56.5kpa
 $\gamma_w = 16.77 \text{ kn/m}^3$
pp=93.8kpa
Tv=48.8kpa

U

U

Plate A-19

DYREGROV & BURGESS

BOREHOLE LOG

PROJECT

Kildonan Corridor

LOGGED/DWN SDG CKD. NCB DATE OF INVEST. 27/08/87 JOB NO. 87422 HOLE NO. 13

WATER CONTENT

Wp - □ W - ○ WL - Δ.
PERCENT %

10 20 30 40 50 60

DEPTH

(M)

SOIL SYMBOL

SOIL DESCRIPTION

SOIL SAMPLE

DRILL TYPE

Hollow Stem

CONDITION

TYPE

PENETRATION
RESISTANCE

OTHER TESTS

DATUM Geodetic

SURFACE ELEVATION 227.60 m

Clay (cont'd)

Silt (Glacial Till)
-sandy and gravelly
-bouldery

End of hole at 18.6 in glacial till.
Backfill with sand to 14.9. Place
pneumatic piezometer @ 14.9 (P2)
Sand to 14.2 m
Bentonite to 13.1 m

Set pneumatic piezometer (P3) with
tip @ 9.1 m. Sand to 8.5 m.
Bentonite to 7.5 m.

DYREGROV & BURGESS

BOREHOLE LOG

PROJECT

Kildonan Corridor

LOGGED/DWN. SDG		CKD.	NCB	DATE OF INVEST. 18/09/87		JOB NO. 87422		HOLE NO. 14	
WATER CONTENT			DEPTH (M)	SOIL SYMBOL	SOIL DESCRIPTION		SOIL SAMPLE		DRILL TYPE
W _p - □	W - ○	W _L - △			DATUM	Geodetic	CONDITION	TYPE	PENETRATION RESISTANCE
PERCENT %					SURFACE ELEVATION 223.64				75 mm Bit
10	20	30	40	50	60				OTHER TESTS
			0		Water				For DMT results see DMT 5
			1						
			2						
			3						
			4						
			5						
			6						
			7						
			8		Overburden Soils				
			9		Glacial Till				
			10						
			11						
			12						
			13						
					Limestone Bedrock				Plate A-21

DYREGROV & BURGESS

BOREHOLE LOG

PROJECT

Kildonan Corridor

LOGGED/DWN.

NCB

CKD.

NCB

DATE OF INVEST.

18/09/87

JOB NO.

87422

HOLE NO.

14

WATER CONTENT

Wp - ☐ W - ☐ WL - ☐

PERCENT %

10 20 30 40 50 60

DEPTH

(M)

SOIL SYMBOL

SOIL DESCRIPTION

DATUM Geodetic

SURFACE ELEVATION 223.64 m

SOIL SAMPLE

CONDITION

TYPE

PENETRATION
RESISTANCE

DRILL TYPE

B-24

75 mm Bit

OTHER TESTS

14

Sound Rock

Rec. - 100%

15

Sound Rock
25 mm clay seam at 15.2 m

Rec. - 91%
RQD - 80%

16

Sound Rock
25 mm clay seam at 16.7 m

REC. - 94%
RQD - 75%

17

18

Sound Rock
No clay seams

Rec. - 100%
RQD - 95%

19

20

End hole at 19.1 m.
Rock surface estimated at Elev. -
210.38 m.
Top 150 mm unsound.

Plate A-22

DYREGROV & BURGESS

BOREHOLE LOG

PROJECT

KILDONAN CORRIDOR

LOGGED/DWN

CKD.

DATE OF INVEST. 24/09/87

JOB NO. 87422

HOLE NO. 15

WATER CONTENT

W_p - □ W - ○ W_L - △

PERCENT %

10 20 30 40 50 60

DEPTH

m

SOIL SYMBOL

SOIL DESCRIPTION

SOIL SAMPLE

DRILL TYPE

DATUM

SURFACE ELEVATION 223.67 m

CONDITION

TYPE

PENETRATION
RESISTANCE

OTHER TESTS

WATER

ALLUVIAL SOILS

GLACIAL TILL
(depth to till extrapolated
from DMT 6)

LIMESTONE BEDROCK

PLATE A-23

DYREGROV & BURGESS

BOREHOLE LOG

PROJECT

KILDONAN CORRIDOR

LOGGED/DWN

CKD.

DATE OF INVEST. 24/09/87

JOB NO. 87422

HOLE NO. 15

WATER CONTENT

Wp - □ W - ○ WL - Δ.

PERCENT %

10 20 30 40 50 60

DEPTH

m

SOIL SYMBOL

SOIL DESCRIPTION

SOIL SAMPLE

DRILL TYPE

DATUM

SURFACE ELEVATION

CONDITION

TYPE

PENETRATION
RESISTANCE

OTHER TESTS

14

BROKEN ROCK

SOUND ROCK

NO RECOVERY

15

SOUND ROCK

NO RECOVERY

16

SOUND ROCK

17

SOUND ROCK

18

NO RECOVERY

19

BROKEN ROCK

SOUND ROCK

20

SOUND ROCK

21

22

End hole at 21.7 m.
Rock surface estimated at elev.
210.53
Top 0.9 m unsound rock.

REC - 99%
RQD - 60%

REC - 99%
RQD - 60%

REC - 99%
RQD - 79%

REC - 100%
RQD - 70%

REC - 84%
RQD - 17%

REC - 100%
RQD - 45%

DYREGROV & BURGESS

BOREHOLE LOG

PROJECT

KILDONAN CORRIDOR

LOGGED/DWN

CKD

DATE OF INVEST. 25/09/87

JOB NO. 87422

HOLE NO. 16

WATER CONTENT

W_p - □ W - ○ W_L - △

PERCENT %

10 20 30 40 50 60

DEPTH

m

SOIL SYMBOL

SOIL DESCRIPTION

DATUM

SURFACE ELEVATION 223.61 m

SOIL SAMPLE

CONDITION

TYPE

PENETRATION
RESISTANCE

DRILL TYPE

OTHER TESTS

WATER

ALLUVIAL SOILS

GLACIAL TILL

-SOFT/LOOSE
-PUSHED DRILL RODS TO
BEDROCK SURFACE

LIMESTONE BEDROCK

FOR TESTS IN
ALLUVIUM SEE
DMT 7

PLATE A-25

DYREGROV & BURGESS

BOREHOLE LOG

PROJECT

KILDONAN CORRIDOR

LOGGED/DWN.

CKD.

DATE OF INVEST. 25/09/87

JOB NO. 87422

HOLE NO. 16

WATER CONTENT

$w_p - \square$ $w - \bigcirc$ $w_L - \Delta$

PERCENT %

10 20 30 40 50 60

DEPTH

m

SOIL SYMBOL

SOIL DESCRIPTION

SOIL SAMPLE

DRILL TYPE

DATUM

SURFACE ELEVATION

CONDITION

TYPE

PENETRATION
RESISTANCE

OTHER TESTS

14

BROKEN ROCK TO 13.7 m

3 - 6mm clay seams at 14.0 m

REC - 75%

15

SOUND ROCK

REC - 95%

RQD - 68%

16

225 mm seam or soft rock

REC - 98%

17

18

SOUND ROCK

REC - 93%

19

NO RECOVERY

20

Abandon hole at 20.1 m
Drill rods jamming

DYREGROV & BURGESS

BOREHOLE LOG

PROJECT

KILDONAN CORRIDOR

LOGGED/DWN.

CKD.

DATE OF INVEST. 06/10/87

JOB NO. 87422

HOLE NO. 16A

WATER CONTENT

W_p - □ W - ○ W_L - △

PERCENT %

10 20 30 40 50 60

DEPTH

m

SOIL SYMBOL

SOIL DESCRIPTION

DATUM

SURFACE ELEVATION

SOIL SAMPLE

CONDITION

TYPE

PENETRATION
RESISTANCE

DRILL TYPE

OTHER TESTS

WATER

ALLUVIAL SOILS

GLACIAL TILL
(depth extrapolated from DMT 7)

BOREHOLE LOG

PROJECT

KILDONAN CORRIDOR

LOGGED/DWN.

CKD.

DATE OF INVEST. 06/10/87

JOB NO. 87422

HOLE NO. 16A

WATER CONTENT

SOIL DESCRIPTION

SOIL SAMPLE

DRILL TYPE

$w_p \cdot \square$ $w \cdot \bigcirc$ $w_L \cdot \Delta$.

PERCENT %

DEPTH

DATUM

SURFACE ELEVATION

CONDITION

TYPE

PENETRATION
RESISTANCE

OTHER TESTS

14

1	2	3	100
---	---	---	---	---	---	---	---	---	----	----	-----

15

16

17

18

19

20

21

22

23

24

GLACIAL TILL

LIMESTONE BEDROCK

UN SOUND ROCK

NO CORE RECOVERY

UN SOUND ROCK

NO CORE RECOVERY

UN SOUND ROCK

End hole at 23.6 m.

REC - 100%
ROD - 67%

ROD - 67%

REC - 30%

PLATE A-28

DYREGROV & BURGESS

BOREHOLE LOG

PROJECT

KILDONAN CORRIDOR

LOGGED/DWN.

CKD.

DATE OF INVEST. 07/10/87

JOB NO. 87422

HOLE NO. 16B

WATER CONTENT

$w_p - \square$ $w - \circ$ $w_L - \Delta$

PERCENT %

10 20 30 40 50 60

DEPTH

m

SOIL SYMBOL

SOIL DESCRIPTION

SOIL SAMPLE

DRILL TYPE

DATUM

SURFACE ELEVATION 223.69 m

CONDITION

TYPE

PENETRATION
RESISTANCE

OTHER TESTS

WATER

ALLUVIUM

GLACIAL TILL

(depth to till extrapolated
from DMT 7)

PLATE A-29

DYREGROV & BURGESS

BOREHOLE LOG

PROJECT

KILDONAN CORRIDOR

LOGGED/DWN

CKD

DATE OF INVEST. 07/10/87

JOB NO. 87422

HOLE NO. 16B

WATER CONTENT

W_p - □ W - ○ W_L - △
PERCENT %

10 20 30 40 50 60

DEPTH

m

SOIL SYMBOL

SOIL DESCRIPTION

DATUM

SURFACE ELEVATION 223.69 m

SOIL SAMPLE

CONDITION

TYPE

PENETRATION
RESISTANCE

DRILL TYPE

OTHER TESTS

14

LIMESTONE BEDROCK
SOUND ROCK

REC - 100%
ROD - 56%

15

SOUND ROCK

REC - 98%
ROD - 83%

16

17

SOUND ROCK

REC - 96%
ROD - 90%

18

SOUND ROCK

REC - 94%
ROD - 73%

19

20

NO RECOVERY

End hole at 20.0 m
Drill rods jamming in broken
rock and clay.

PLATE A-30

DYREGROV & BURGESS

BOREHOLE LOG

PROJECT

KILDONAN CORRIDOR

LOGGED/DWN.

CKD.

DATE OF INVEST. 14/10/87

JOB NO. 87422

HOLE NO. 16C

WATER CONTENT

Wp - ☐ W - ☐ WL - ☐

PERCENT %

10 20 30 40 50 60

DEPTH

m

SOIL SYMBOL

SOIL DESCRIPTION

DATUM

SURFACE ELEVATION

SOIL SAMPLE

CONDITION

TYPE

PENETRATION
RESISTANCE

DRILL TYPE

OTHER TESTS

WATER

ALLUVIUM

GLACIAL TILL
(depth to till extrapolated
from DMT 7)

PLATE A-31

DYREGROV & BURGESS

BOREHOLE LOG

PROJECT

KILDONAN CORRIDOR

LOGGED/DWN

CKD.

DATE OF INVEST. 14/10/87

JOB NO. 87422

HOLE NO. 16C

WATER CONTENT

W_p - □ W - ○ W_L - △

PERCENT %

10 20 30 40 50 60

DEPTH

m

SOIL SYMBOL

SOIL DESCRIPTION

DATUM

SURFACE ELEVATION

SOIL SAMPLE

CONDITION

TYPE

PENETRATION
RESISTANCE

DRILL TYPE

OTHER TESTS

14

LIMESTONE BEDROCK
SOUND ROCK

REC - 100%
RQD - 85%

15

SOUND ROCK

REC - 92%
RQD - 91%

16

SOUND ROCK

REC - 98%
RQD - 96%

17

SOUND ROCK

REC - 100%
RQD - 100%

18

NO RECOVERY

19

BROKEN ROCK, NO RECOVERY
NO RECOVERY

20

SOUND ROCK

REC - 93%
RQD - 73%

21

End hole at 22.3 m.

22

23

DYREGROV & BURGESS

BOREHOLE LOG

PROJECT

KILDONAN CORRIDOR

LOGGED/DWN.

CKD.

DATE OF INVEST. 15/10/87

JOB NO. 87422

HOLE NO. 16D

WATER CONTENT						DEPTH m	SOIL SYMBOL	SOIL DESCRIPTION	SOIL SAMPLE			DRILL TYPE
w_p - □	w - ○	w_L - △	PERCENT %						DATUM	CONDITION	TYPE	PENETRATION RESISTANCE
10	20	30	40	50	60			SURFACE ELEVATION				
						1		WATER				
						2						
						3						
						4						
						5						
						6						
						7						
						8						
						9						
						10		ALLUVIUM				
						11	▲	GLACIAL TILL (depth to glacial till extrapolated from DMT 7)				
						12	▲					
						13	▲					
								LIMESTONE BEDROCK				

PLATE A-33

DYREGROV & BURGESS

BOREHOLE LOG

PROJECT

KILDONAN CORRIDOR

LOGGED/DWN.

CKD.

DATE OF INVEST. 15/10/87

JOB NO. 87422

HOLE NO. 16D

WATER CONTENT

SOIL DESCRIPTION

SOIL SAMPLE

DRILL TYPE

Wp - □ W - ○ WL - △.
PERCENT %

DEPTH

SOIL SYMBOL

DATUM

SURFACE ELEVATION

CONDITION

TYPE

PENETRATION
RESISTANCE

OTHER TESTS

10 20 30 40 50 60

m

14

150 mm clay or soft rock

REC - 69%

RQD - 67%

15

NO RECOVERY

16

SOUND ROCK

REC - 88%

17

SOUND ROCK

REC - 100%

RQD - 93%

18

SOUND ROCK

NO RECOVERY

19

SOUND ROCK

20

UN SOUND ROCK

REC - 30%

RQD - 10%

21

SOUND ROCK

REC - 80%

22

BROKEN ROCK

RQD - 63%

End hole at 22.5 m.

PLATE A-34

DYREGROV & BURGESS

BOREHOLE LOG

PROJECT

KILDONAN CORRIDOR

LOGGED/DWN

CKD.

DATE OF INVEST. 06/10/87

JOB NO. 87422

HOLE NO. 17

WATER CONTENT

W_p - □ W - ○ W_L - △

PERCENT %

10 20 30 40 50 60

DEPTH

m

SOIL SYMBOL

SOIL DESCRIPTION

DATUM

SURFACE ELEVATION 223.65 m

SOIL SAMPLE

CONDITION

TYPE

PENETRATION
RESISTANCE

DRILL TYPE

OTHER TESTS

WATER

ALLUVIAL SOILS

GLACIAL TILL

VERY DENSE? HARD BELOW 11.2 m

For tests in
alluvium see
DMT 7

PLATE A-35

DYREGROV & BURGESS

BOREHOLE LOG

PROJECT

KILDONAN CORRIDOR

LOGGED/DWN.

CKD.

DATE OF INVEST. 06/10/87

JOB NO. 87422

HOLE NO. 17

WATER CONTENT

W_p - □ W - ○ W_L - △

PERCENT %

10 20 30 40 50 60

DEPTH

m

SOIL SYMBOL

SOIL DESCRIPTION

DATUM

SURFACE ELEVATION

SOIL SAMPLE

CONDITION

TYPE

PENETRATION
RESISTANCE

DRILL TYPE

OTHER TESTS

14

GLACIAL TILL

15

LIMESTONE BEDROCK

NO RECOVERY 14.3 to 15.5 m

16

SOUND ROCK

REC - 99%

RQD - 99%

17

SOUND ROCK

REC - 97%

RQD - 75%

18

SOUND ROCK

REC - 97%

RQD - 79%

19

20

SOUND ROCK
BROKEN ROCK

REC 100%

REC 0%

21

SOUND ROCK

REC - 100%

RQD - 70%

22

SOUND ROCK

REC - 93%

RQD - 30%

23

End hole at 22.6 m.

PLATE A-36

DYREGROV & BURGESS

BOREHOLE LOG

PROJECT

KILDONAN CORRIDOR

LOGGED/DWN

CKD

DATE OF INVEST. 21/09/87

JOB NO. 87422

HOLE NO. 18

WATER CONTENT

$w_p - \square$ $w - \circ$ $w_L - \Delta$

PERCENT %

10 20 30 40 50 60

DEPTH

m

SOIL SYMBOL

SOIL DESCRIPTION

DATUM

SURFACE ELEVATION 223.68

SOIL SAMPLE

CONDITION

TYPE

PENETRATION
RESISTANCE

DRILL TYPE

OTHER TESTS

WATER

GLACIAL TILL

LIMESTONE BEDROCK, BROKEN TO 13.1m

SOUND ROCK, 13.1 - 13.8 m

PLATE A-37

DYREGROV & BURGESS

BOREHOLE LOG

PROJECT

KILDONAN CORRIDOR

LOGGED/DWN.

CKD.

DATE OF INVEST. 21/09/87

JOB NO. 87422

HOLE NO. 18

WATER CONTENT

W_p - □ W - ○ W_L - △

PERCENT %

10 20 30 40 50 60

DEPTH

m

SOIL SYMBOL

SOIL DESCRIPTION

SOIL SAMPLE

DRILL TYPE

DATUM

SURFACE ELEVATION 223.68 m

CONDITION

TYPE

PENETRATION
RESISTANCE

OTHER TESTS

14

NO RECOVERY 13.8 - 13.9 m

SOUND ROCK

25 mm clay seam at 14.6 m

REC - 87%

RQD - 82%

15

SOUND ROCK

REC - 95%

RQD - 87%

16

17

SOUND ROCK

REC - 95%

RQD - 65%

18

SOUND ROCK

REC - 95%

RQD - 87%

19

20

SOUND ROCK

REC - 95%

21

SOUND ROCK

REC - 93%

22

23

End hole at 22.3 m.

PLATE A-38

DYREGROV & BURGESS

BOREHOLE LOG

PROJECT

KILDONAN CORRIDOR

LOGGED/DWN.

CKD.

DATE OF INVEST. 19/09/87

JOB NO. 87422

HOLE NO. 19

WATER CONTENT

$w_p - \square$ $w - \circ$ $w_L - \triangle$

PERCENT %

10 20 30 40 50 60

DEPTH

m

SOIL SYMBOL

SOIL DESCRIPTION

DATUM

SURFACE ELEVATION 223.62

SOIL SAMPLE

CONDITION

TYPE

PENETRATION
RESISTANCE

DRILL TYPE

OTHER TESTS

WATER

GLACIAL TILL
(depth to glacial till
extrapolated from DMT 5)

PLATE A-39

DYREGROV & BURGESS

BOREHOLE LOG

PROJECT

KILDONAN CORRIDOR

LOGGED/DWN

CKD.

DATE OF INVEST. 19/09/87

JOB NO. 87422

HOLE NO. 19

WATER CONTENT

$w_p - \square$ $w - \circ$ $w_L - \Delta$

PERCENT %

10 20 30 40 50 60

DEPTH

m

SOIL SYMBOL

SOIL DESCRIPTION

SOIL SAMPLE

DRILL TYPE

DATUM

SURFACE ELEVATION

CONDITION

TYPE

PENETRATION
RESISTANCE

OTHER TESTS

GLACIAL TILL

LIMESTONE BEDROCK

BROKEN ROCK TO 14.6 m

REC - 30%

SOUND ROCK

REC - 100%

SOUND ROCK

REC - 96%

RQD - 94%

SOUND ROCK

REC - 96%

RQD - 74%

SOUND ROCK

REC - 97%

End hole at 20.7 m.

DYREGROV & BURGESS

BOREHOLE LOG

PROJECT

KILDONAN CORRIDOR

LOGGED/DWN.

CKD.

DATE OF INVEST. 03/10/87

JOB NO. 87422

HOLE NO. 20

WATER CONTENT

$w_p - \square$ $w - \circ$ $w_L - \Delta$

PERCENT %

10 20 30 40 50 60

DEPTH

m

SOIL SYMBOL

SOIL DESCRIPTION

DATUM

SURFACE ELEVATION 223.61 m

SOIL SAMPLE

CONDITION

TYPE

PENETRATION
RESISTANCE

DRILL TYPE

OTHER TESTS

WATER

ALLUVIAL SOILS
(for test results see DMT 4)

GLACIAL TILL
(depth to till extrapolated
from DMT 4)

LIMESTONE BEDROCK

PLATE A-41

DYREGROV & BURGESS

BOREHOLE LOG

PROJECT

KILDONAN CORRIDOR

LOGGED/DWN

CKD.

DATE OF INVEST. 03/10/87

JOB NO. 87422

HOLE NO. 20

WATER CONTENT

$W_p - \square$ $W - \bigcirc$ $W_L - \triangle$
 PERCENT %

10 20 30 40 50 60

DEPTH

m

SOIL SYMBOL

SOIL DESCRIPTION

SOIL SAMPLE

DRILL TYPE

DATUM

CONDITION

TYPE

PENETRATION
RESISTANCE

OTHER TESTS

SURFACE ELEVATION 223.61 m

14

BROKEN ROCK 13.4 - 14.0 m

REC - 64%

SOUND ROCK BELOW 14.0 m

RQD - 53%

15

SOUND ROCK

REC - 97%

RQD - 81%

16

17

SOUND ROCK

REC - 95%

RQD - 93%

18

19

SOUND ROCK

REC - 92%

RQD - 69%

100 mm clay seam

20

SOUND ROCK

REC - 97%

RQD - 73%

21

22

SOUND ROCK

REC - 92%

RQD - 79%

23

End hole at 22.6 m.

PLATE A-42

DYREGROV & BURGESS

BOREHOLE LOG

PROJECT

KILDÓNAN CORRIDOR

LOGGED/DWN.

CKD.

DATE OF INVEST. 28/09/87

JOB NO. 87422

HOLE NO. 21

WATER CONTENT

W_p - □ W - ○ W_L - △

PERCENT %

10 20 30 40 50 60

DEPTH

m

SOIL SYMBOL

SOIL DESCRIPTION

DATUM

SURFACE ELEVATION 223.63 m

SOIL SAMPLE

CONDITION

TYPE

PENETRATION
RESISTANCE

DRILL TYPE

OTHER TESTS

WATER

ALLUVIAL SOILS
(for test results see DMT 4)

GLACIAL TILL
(depth to till extrapolated
from DMT 4)

LIMESTONE BEDROCK

PLATE A-43

DYREGROV & BURGESS

BOREHOLE LOG

PROJECT

KILDONAN CORRIDOR

LOGGED/DWN

CKD

DATE OF INVEST. 28/09/87

JOB NO. 87422

HOLE NO. 21

WATER CONTENT

W_p - □ W - ○ W_L - △

PERCENT %

10 20 30 40 50 60

DEPTH

m

SOIL SYMBOL

SOIL DESCRIPTION

DATUM

SURFACE ELEVATION

SOIL SAMPLE

CONDITION

TYPE

PENETRATION
RESISTANCE

DRILL TYPE

OTHER TESTS

14

NO RECOVERY TO 14.2 m

15

SOUND ROCK, 14.2 - 14.8 m

16

--- 25 mm clay seam

SOUND ROCK

17

SOUND ROCK

18

--- 6 mm clay seams (2)

--- 12 mm clay seam

19

SOUND ROCK

20

SOUND ROCK

21

SOUND ROCK

22

End hole at 22.4 m.

23

REC - 99%

RQD - 44%

REC - 97%

RQD - 81%

REC - 95%

RQD - 45%

REC - 98%

RQD - 67%

REC - 100%

RQD - 36%

PLATE A-44

DYREGROV & BURGESS

BOREHOLE LOG

PROJECT

KILDONAN CORRIDOR

LOGGED/DWN

CKD

DATE OF INVEST. 23/09/87

JOB NO. 87422

HOLE NO. 22

WATER CONTENT

W_p - □ W - ○ W_L - △

PERCENT %

10 20 30 40 50 60

DEPTH

m

SOIL SYMBOL

SOIL DESCRIPTION

SOIL SAMPLE

DRILL TYPE

DATUM

SURFACE ELEVATION 223.68 m

CONDITION

TYPE

PENETRATION
RESISTANCE

OTHER TESTS

WATER

ALLUVIAL SOILS
(for testing see DMT 3)

GLACIAL TILL
(depth to glacial till
extrapolated from DMT 3)

LIMESTONE BEDROCK

PLATE A-45

DYREGROV & BURGESS

BOREHOLE LOG

PROJECT

KILDONAN CORRIDOR

LOGGED/DWN

CKD.

DATE OF INVEST. 23/09/87

JOB NO. 87422

HOLE NO. 22

WATER CONTENT

W_p - □ W - ○ W_L - △

PERCENT %

10 20 30 40 50 60

DEPTH

m

SOIL SYMBOL

SOIL DESCRIPTION

SOIL SAMPLE

DRILL TYPE

DATUM

SURFACE ELEVATION 223.68 m

CONDITION

TYPE

PENETRATION
RESISTANCE

OTHER TESTS

14

BROKEN ROCK, 13.0-13.8 m

SOUND ROCK

no REC

REC - 99%

RQD - 45%

15

SOUND ROCK

REC - 99%

RQD - 83%

16

SOUND ROCK

REC - 96%

RQD - 73%

17

18

SOUND ROCK

REC - 93%

RQD - 66%

19

End hole at 19.0 m.

PLATE A-46

DYREGROV & BURGESS

BOREHOLE LOG

PROJECT

KILDONAN CORRIDOR

LOGGED/DWN.

CKD.

DATE OF INVEST. 22/09/87

JOB NO. 87422

HOLE NO. 23

WATER CONTENT

$w_p - \square$ $w - \circ$ $w_L - \Delta$

PERCENT %

10 20 30 40 50 60

DEPTH

M

SOIL SYMBOL

SOIL DESCRIPTION

DATUM

SURFACE ELEVATION 223.70 m

SOIL SAMPLE

CONDITION

TYPE

PENETRATION
RESISTANCE

DRILL TYPE

OTHER TESTS

WATER

ALLUVIAL SOILS

(For testing see DMT 3)

GLACIAL TILL

(Depth to till extrapolated
from DMT 3)

LIMESTONE BEDROCK

PLATE A-47

DYREGROV & BURGESS

BOREHOLE LOG

PROJECT

KILDONAN CORRIDOR

LOGGED/DWN.

CKD.

DATE OF INVEST. 22/09/87

JOB NO. 87422

HOLE NO. 23

WATER CONTENT

$w_p - \square$ $w - \circ$ $w_L - \Delta$

PERCENT %

10 20 30 40 50 60

DEPTH

SOIL SYMBOL

SOIL DESCRIPTION

SOIL SAMPLE

DRILL TYPE

DATUM

CONDITION

TYPE

PENETRATION
RESISTANCE

SURFACE ELEVATION 223.70 m

OTHER TESTS

14

SOUND ROCK

REC. - 87%

RQD. - 83%

15

SOUND ROCK

REC. - 97%

RQD - 70%

16

SOUND ROCK

REC. - 100%

RQD - 88%

17

18

SOUND ROCK

REC. - 95%

RQD - 47%

19

20

SOUND ROCK

REC. - 97%

RQD - 61%

21

End hole at 20.9 m.

PLATE A-48

DYREGROV & BURGESS

BOREHOLE LOG

PROJECT

KILDONAN CORRIDOR

LOGGED/DWN

CKD

DATE OF INVEST.

22/09/87

JOB NO. 8/422

HOLE NO. DMT 3

WATER CONTENT

W_p - □ W - ○ W_L - △
PERCENT %

10 20 30 40 50 60

DEPTH

m

SOIL SYMBOL

SOIL DESCRIPTION

DATUM

SURFACE ELEVATION 223.70 m

SOIL SAMPLE

CONDITION

TYPE

PENETRATION
RESISTANCE

DRILL TYPE

OTHER TESTS

WATER

SILT - clayey

CLAY - silty

STRATIFIED SILTY CLAY AND
CLAYEY SILT

End Dilatometer testing at 7.9 m.
Refusal on glacial till or
boulder at 7.9 m.

UNDRAINED
SHEAR
STRENGTH
(kPa)
10.3
11.3
12.1
13.1
13.9
14.8
15.8
16.6
15.8
26.9
20.7
19.8
31.2
27.9
34.5
38.6

DYREGROV & BURGESS

BOREHOLE LOG

PROJECT

KILDONAN CORRIDOR

LOGGED/DOWN

CKD

DATE OF INVEST. 30/09/87

JOB NO. 87422

HOLE NO. DMT 4

WATER CONTENT

$w_p - \square$ $w - \circ$ $w_L - \Delta$

PERCENT %

10 20 30 40 50 60

DEPTH

m

SOIL SYMBOL

SOIL DESCRIPTION

DATUM

SURFACE ELEVATION 223.61

SOIL SAMPLE

CONDITION

TYPE

PENETRATION
RESISTANCE

DRILL TYPE

OTHER TESTS

WATER

1

CLAYEY SILT

2

STRATIFIED SILT, SAND, AND
CLAY

3

4

5

SILTY SAND

6

7

SILTY CLAY

8

End dilatometer test at 7.5 m.
Refusal on boulder or glacial
till.

UNDRAINED
SHEAR
STRENGTH
(kPa)

28

27

27

36

45

39

$\phi = 34^{\circ}$

$\phi = 36^{\circ}$

51

59

58

PLATE A-50

DYREGROV & BURGESS

BOREHOLE LOG

PROJECT

KILDONAN CORRIDOR

LOGGED/DWN.

CKD.

DATE OF INVEST. 30/09/87

JOB NO. 87422

HOLE NO. DMT 5

WATER CONTENT

W_p - □ W - ○ W_L - △

PERCENT %

10 20 30 40 50 60

DEPTH

m

SOIL SYMBOL

SOIL DESCRIPTION

DATUM

SURFACE ELEVATION 223.61

SOIL SAMPLE

CONDITION

TYPE

PENETRATION
RESISTANCE

DRILL TYPE

OTHER TESTS

WATER

1

2

3

4

5

6

7

8

9

CLAYEY SILT, SILTY CLAY AND
SAND

End dilatometer testing at 8.5 m
Refusal on glacial till

UNDRAINED
SHEAR
STRENGTH
(kPa)
— 24
— 34
— $\phi = 39^{\circ}$

PLATE A-51

BOREHOLE LOG

KILDONAN CORRIDOR

HOLE NO. DMT 6

DRILL TYPE

CONDITION

TYPE

**PERMEATION
RESISTANCE**

OTHER TESTS

10 20 30 40 50 60

B

SURFACE ELEVATION 223.61

WATER

1

2

3

4

5

6

7

8

9

-10

ALLUVIAL SOILS

11

Drill rod pushed from 10.0 to 10.6 m. Refusal on glacial till or boulder at 10.6 m.

12

PLATE A-52

DYREGROV & BURGESS

BOREHOLE LOG

PROJECT

KILDONAN CORRIDOR

LOGGED/DWN

CKD.

DATE OF INVEST. 30/09/87

JOB NO. 87422

HOLE NO. DMT 7

WATER CONTENT

 $w_p - \square$ $w - \bigcirc$ $w_L - \Delta$

PERCENT %

10 20 30 40 50 60

DEPTH

m

SOIL SYMBOL

SOIL DESCRIPTION

SOIL SAMPLE

DRILL TYPE

DATUM

SURFACE ELEVATION

CONDITION

TYPE

PENETRATION
RESISTANCE

OTHER TESTS

WATER

1

2

3

4

5

6

7

8

9

10

11

12

13

GLACIAL TILL - soft/loose

- Drill rods pushed with
no rotation from 10.4
to 13.1 m. Refusal on
probable bedrock at 13.1 m.

PLATE A-53

CLIENT	CITY OF WINNIPEG - WATER AND WASTE DEPARTMENT
PROJECT	Chief Peguis Bridge Sewer Replacement
SITE	East of Red River and South of Chief Peguis Trail
LOCATION	South of Existing Sewermain on the Upper Bank
DRILLING METHOD	Acker Track Drill Rig, 125 mm Ø Solid Stem and HQ Core Barrel

JOB NO. 12-0107-018
GROUND ELEV. 228.37
TOP OF PVC ELEV.
WATER ELEV.
DATE DRILLED 11/8/2012
UTM (m) N 5,534,757
E 636,604

ELEVATION (m)	DEPTH	GRAPHICS	DESCRIPTION AND CLASSIFICATION	PIEZ LOG	DEPTH (m)	SAMPLE TYPE NUMBER RECOVERY %	SPT (N) blows/0.15 m ▲ DYNAMIC CONE (N) blows/ft Δ	Cu POCKET PEN (kPa) ★ Cu TORVANE (kPa) ◆
(m)	(ft)						20 40 60 80 PL MC LL %	20 40 60 80
		[Cross-hatched]	SILTY CLAY FILL - Brown, moist, stiff, intermediate to high plasticity some medium to coarse grained sand, some fine grained gravel trace coarse grained gravel, trace rootlets.			S1		
	1	[Diagonal lines /]	SILTY CLAY - Brown, moist, stiff, high plasticity, trace fine to medium grained sand.					
	5		- Increased sand content below 1.83 m.					
	2	[Stippled]	SAND - Brown, moist; compact, fine to medium grained, trace coarse grained sand, trace silt, trace clay.			S3		
	3	[Vertical dashed lines]	SILTY SAND - Brown, moist, loose, fine to medium grained, with silt, trace clay.			S3		
	4	[Stippled]	SAND - Brown, moist, compact, fine to medium grained, trace silt.					
	15		- Water noticed on sample at ~ 5.49 m.					
	5					S4		
	6	[Cross-hatched]	SANDY SILT - Brown, moist, firm, Intermediate to high plasticity, trace oxidation.					
	20	[Vertical dashed lines]	SILTY SAND - Brown, moist, soft, fine to medium grained, trace oxidation.			S5		
	7		- Grey, no oxidation below 6.71 m.					
	25	[Diagonal lines /]	SAND - Grey, moist, compact, medium grained, some fine and coarse grained sand. SILTY CLAY - Grey, moist, firm, high plasticity. - Medium grained sand layer between 7.39 and 7.47 m.					
	8	[Vertical dashed lines]	SILTY SAND - Grey, moist, soft, fine to medium grained sand, with silt.			S6		
			- Organic layer between 8.53 and 8.64 m.					
	9	[Diagonal lines /]	SILTY CLAY - Grey, moist, firm, high plasticity, trace fine grained sand.					
	30		- Increased sand between 9.75 and 9.96 m.			S7		

SAMPLE TYPE ☒ Auger Grab ☒ Split Spoon ☐ Core Barrel

CONTRACTOR
Paddock Drilling Ltd.

INSPECTOR
C. FRIESEN

APPROVED
DRAFT

DATE
11/26/12

GEOTECHNICAL SOIL LOG P:\PROJECTS\2012\12-07-11\DESIGN\GEOLOGICAL\GSGS\CHIEF PEGUIS TRAIL SEWERMAIN.GPJ

ELEVATION (m)	DEPTH (m)	GRAPHICS	DESCRIPTION AND CLASSIFICATION	PIEZ LOG	DEPTH (m)	SAMPLE TYPE	NUMBER	RECOVERY %	SPT (N) blows/0.15 m ▲	DYNAMIC CONE (N) blows/ft ▲	Cu POCKET PEN (kPa) ★	Cu TORVANE (kPa) ◆
	(m) (ft)								20 40 60		20 40 60 80	PL MC LL
			- Increased sand between 10.36 and 10.52 m.									
	11		SILTY SAND - Grey, moist, compact, medium grained, trace fine grained sand, trace clay.				S8					
			- Test hole squeezing at 10.67 m.									
	12											
	40		- 25 mm thick organic layer at 12.50 m.									
	13		- Decreased sand between 12.95 and 13.26 m.									
	45						S9					
	14		SILTY CLAY - Gray, moist, firm, high plasticity, trace coarse grained sand, trace fine grained gravel, trace silt nodules.									
			- Grain Size Distribution: Gravel (1.0%), Sand (8.8%), Silt (21.9%), Clay (57.0%) at 14.63 m.				S10					
	15											
	50											
	16		SILT TILL - Tan, moist, compact, with medium to coarse grained sand, some fine grained gravel, trace coarse grained gravel.				S11					
			- Loose, decreased gravel below 16.46 m.									
	17						S12	100				
	55											
	18						S13					
	60		- Auger refusal at 18.34 m on bedrock. Switched over to core below 18.34 m.									
	19		LIMESTONE BEDROCK - White, competent, vertical and horizontal fractures.									
	65						R1	98				
	20											
	70						R2	98				
	21											

SAMPLE TYPE ☒ Auger Grab ☒ Split Spoon ☒ Core Barrel

CONTRACTOR
Paddock Drilling Ltd.

INSPECTOR
C. FRIESEN

APPROVED
DRAFT

DATE
11/26/12

ELEVATION (m)	DEPTH (m) (ft)	GRAPHICS	DESCRIPTION AND CLASSIFICATION	PIEZ. LOG	DEPTH (m)	SAMPLE TYPE	NUMBER	RECOVERY %	SPT (N) blows/0.15 m ▲	DYNAMIC CONE (N) blows/ft △	Cu POCKET PEN (kPa) ★	Cu TORVANE (kPa) ◆	
									20 40 60	20 40 60 80	PL MC LL	20 40 60 80	
22			- Increased fractuors below 22.94 m. - Vertical fracture between 23.01 and 23.67 m.		22.2	R3	98						
23													
24													
25													
26													
26			END OF TEST HOLE AT 26.06 m		25.8								
26					26.1								
27			Notes: 1. Installed casagrande standpipe at a depth of 26.06 m with a stick-up of 0.84 m. 2. Backfilled test hole with silica sand between 26.06 and 22.17 m and bentonite chips from 22.17 m to grade.										
28													
29													
30													
31													
32													
33													

GEOTECHNICAL SOIL LOG P:\PROJECTS\2012\12-0107-7119\DESIGN\GEOLOGS\CHIEF PEGUIS TRAIL SEWERMAIN.GPJ

SAMPLE TYPE ☒ Auger Grab ☒ Split Spoon ☐ Core Barrel

CONTRACTOR
Paddock Drilling Ltd.

INSPECTOR
C. FRIESEN

APPROVED
DRAFT

DATE
11/26/12

CLIENT CITY OF WINNIPEG - WATER AND WASTE DEPARTMENT
PROJECT Chief Peguis Bridge Sewer Replacement
SITE East of Red River and South of Chief Peguis Trail
LOCATION North of Existing Sewermain on the Lower Bank
DRILLING METHOD Acker Track Drill Rig, 125 mm Ø Solid Stem and HQ Core Barrel

JOB NO. 12-0107-018
GROUND ELEV. 226.37
TOP OF PVC ELEV.
WATER ELEV.
DATE DRILLED 11/7/2012
UTM (m) N 5,534,788
E 636,543

ELEVATION (m)	DEPTH (m) (ft)	GRAPHICS	DESCRIPTION AND CLASSIFICATION	SAMPLE TYPE NUMBER	RECOVERY %	SPT (N) blows/0.15 m ▲	DYNAMIC CONE (N) blows/ft ▲	Cu POCKET PEN (kPa) ★	Cu TORVANE (kPa) ◆
						20 40 60		20 40 60 80	PL MC LL %
	1		SILTY CLAY - Brown, damp, firm, intermediate plasticity, trace rootlets, trace fine grained sand, trace fine grained gravel.	S1					
	5								
	2		SAND & GRAVEL - Light grey, moist, dense, medium to coarse grained sand, fine to coarse grained gravel, some clay. - Hole squeezing at 1.83 m.	S2					
	3								
	10								
	4			S3					
	15		SAND - Brown, moist to wet, loose, fine to medium grained, trace oxidation. - Water noticed on sample below 4.57 m.						
	5		- Grey, no oxidation below 5.33 m.	S4					
	6								
	20								
	7		SILTY CLAY - Grey, moist, firm, high plasticity.	S5					
	25		SAND - Grey, moist, loose, medium grained, trace coarse grained sand.						
	8		- Some to with silt, reduced sand below 7.92 m.	S6					
	9								
	30		SILTY CLAY - Grey, moist, firm, high plasticity, trace silt nodules, trace medium grained sand, trace fine grained gravel.						

SAMPLE TYPE Auger Grab Core Barrel

CONTRACTOR
Paddock Drilling Ltd.

INSPECTOR
C. FRIESEN

APPROVED
DRAFT

DATE
11/26/12

GEOTECHNICAL SOIL LOG P:\PROJECTS\2012\12-0107-01\DESIGN\GEOLOG\CHIEF PEGUIS TRAIL SEWERMAIN.GPJ

ELEVATION (m)	DEPTH (m) (ft)	GRAPHICS	DESCRIPTION AND CLASSIFICATION	SAMPLE TYPE NUMBER	RECOVERY %	SPT (N) blows/0.15 m ▲	DYNAMIC CONE (N) blows/ft ▲	Cu POCKET PEN (kPa) ★	Cu TORVANE (kPa) ◆
						20 40 60	20 40 60 80	PL MC LL	
			- Stiff below 10.06 m.	S7					
	35		- Reduced fine grained gravel below 10.67 m.						
11			- Grain Size Distribution: Gravel (1.2%), Sand (11.7%), Silt (30.5%), Clay (56.6%) at 11.58 m.	S8					
12	40		- Reduced silt nodules below 12.50 m.						
13			- Firm below 12.95 m.	S9					
14	45		- Grain Size Distribution: Gravel (0.8%), Sand (10.2%), Silt (23.7%), Clay (65.3%) at 13.11 m.						
			SILTY TILL - Tan, moist, compact, with medium to coarse grained sand, some fine grained gravel, trace coarse grained gravel.						
			- Loose, reduced coarse grained sand, reduced fine to coarse grained gravel below 14.63 m.	S10					
15	50								
16				S11					
17	55		- Auger refusal at 18.76 m on bedrock. Switched over to core below 16.76 m.	R1	85				
			LIMESTONE BEDROCK - White, fractured with vertical and horizontal fractures.						
18	60			R2	98				
19									
20	65		- Clay seam at 19.69 m.	R3	100				
			- Clay between 20.12 and 20.19 m.						
21	70			R4	100				
			- Yellow fractured limestone between 21.41 and 22.25 m.						

SAMPLE TYPE  Auger Grab  Core Barrel

CONTRACTOR
Paddock Drilling Ltd.

INSPECTOR
C. FRIESEN

APPROVED
DRAFT

DATE
11/26/12

ELEVATION (m)	DEPTH (m) (ft)	GRAPHICS	DESCRIPTION AND CLASSIFICATION	SAMPLE TYPE	NUMBER	RECOVERY %	SPT (N) blows/0.15 m ▲	DYNAMIC CONE (N) blows/ft △	Cu POCKET PEN (kPa) ★	Cu TORVANE (kPa) ◆
22			Reduced fractures below 22.25 m.	R5	100					
23	75									
24				R6	100					
25	80		Increased fractures below 24.69 m.							
26	85		END OF TEST HOLE AT 25.91 m	R7	100					
27			Notes: 1. Water level measured at 15.70 m below grade after drilling. 2. Backfilled test hole with a thick bentonite grout mixture and bentonite chips.							
28	90									
29	95									
30	100									
31										
32	105									
33										
	110									

SAMPLE TYPE  Auger Grab  Core Barrel

CONTRACTOR
Paddock Drilling Ltd.

INSPECTOR
C. FRIESEN

APPROVED
DRAFT

DATE
11/26/12

CLIENT CITY OF WINNIPEG - WATER AND WASTE DEPARTMENT
PROJECT Chief Peguis Bridge Sewer Replacement

SITE East of Red River and South of Chief Peguis Trail

LOCATION -3 m West of TH12-02

DRILLING METHOD Acker Track Drill Rig, 125 mm Ø Solid Stem

JOB NO. 12-0107-018

GROUND ELEV.
TOP OF PVC ELEV.

WATER ELEV.
DATE DRILLED 11/9/2012

UTM (m) N
E

ELEVATION (m)	DEPTH (m)	GRAPHICS	DESCRIPTION AND CLASSIFICATION	PIEZ. LOG	DEPTH (m)	SAMPLE TYPE	NUMBER	RECOVERY %	SPT (N) blows/0.15 m ▲	DYNAMIC CONE (N) blows/ft ▲	Cu POCKET PEN (kPa) ★	Cu TORVANE (kPa) ◆
	(m) (ft)								20 40 60	20 40 60	20 40 60 80	20 40 60 80
			SILTY CLAY FILL - Brown, moist, stiff, intermediate to high plasticity, some medium to coarse grained sand, some fine grained gravel, trace coarse grained gravel, trace rootlets.									
	1		SILTY CLAY - Brown, moist, stiff, high plasticity, trace fine to medium grained sand.									
	5											
	2		- Increased sand content below 1.83 m.									
			SAND - Brown, moist, compact, fine to medium grained, trace coarse grained sand, trace silt, trace clay.									
	3											
	10		SILTY SAND - Brown, moist, loose, fine to medium grained, with silt, trace clay.									
	4											
			SAND - Brown, moist, compact, fine to medium grained, trace silt.									
	15											
	5											
			- Water noticed on sample at ~ 5.49 m.									
	6		SANDY SILT - Brown, moist, firm, intermediate to high plasticity, trace oxidation.									
	20											
			SILTY SAND - Brown, moist, soft, fine to medium grained, trace oxidation.									
	7		- Grey, no oxidation below 6.71 m.									
			SAND - Grey, moist, compact, medium grained, some fine and coarse grained sand.									
	25		SILTY CLAY - Grey, moist, firm, high plasticity.									
			- Medium grained sand layer between 7.39 and 7.47 m.									
	8		SILTY SAND - Grey, moist, soft, fine to medium grained sand, with silt.									
			- Organic layer between 8.53 and 8.64 m.									
	9		SILTY CLAY - Grey, moist, firm, high plasticity, trace fine grained sand.									
	30											
			- Increased sand between 9.75 and 9.96 m.									

SAMPLE TYPE

CONTRACTOR
Paddock Drilling Ltd.

INSPECTOR
C. FRIESEN

APPROVED
DRAFT

DATE
11/26/12

ELEVATION (m)	DEPTH (m) (ft)	GRAPHICS	DESCRIPTION AND CLASSIFICATION	PIEZ LOG	DEPTH (m)	SAMPLE TYPE	NUMBER	RECOVERY %	SPT (N) blows/0.15 m ▲ DYNAMIC CONE (N) blows/ft △	Cu POCKET PEN (kPa) ★ Cu TORVANE (kPa) ◆
									20 40 60	20 40 60 80 PL MC LL %
	35		- Increased sand between 10.36 and 10.52 m.							
	11		SILTY SAND - Grey, moist, compact, medium grained, trace fine grained sand, trace clay. - Test hole squeezing at 10.67 m.		11.4 11.6					
	40		- 25 mm thick organic layer at 12.50 m.							
	13		- Decreased sand between 12.95 and 13.26 m.							
	45									
	14		SILTY CLAY - Grey, moist, firm, high plasticity, trace coarse grained sand, trace fine grained gravel, trace silt nodules.							
	15									
	50									
	16		SILT TILL - Tan, moist, compact, with medium to coarse grained sand, some fine grained gravel, trace coarse grained gravel. - Loose, decreased gravel below 16.46 m.		16.8					
	55				17.4					
	17				17.7					
	18				18.3					
	60		AUGER REFUSAL AT 18.34 m							
	19		Notes: 1. Stratigraphy assumed from TH12-02 drilled ~3 m away. 2. Installed casagrande standpipe at a depth of 17.68 m with a slick-up of 0.91 m. 3. Installed PN 034983 at a depth of 11.58 m. below grade. 4. Backfilled test hole with silica sand between 17.68 and 16.76 m and bentonite chips from 16.76 m to grade.							
	20									
	65									
	21									
	70									

SAMPLE TYPE

CONTRACTOR
Paddock Drilling Ltd.

INSPECTOR
C. FRIESEN

APPROVED
DRAFT

DATE
11/26/12

CLIENT CITY OF WINNIPEG - WATER AND WASTE DEPARTMENT
PROJECT Chief Peguis Bridge Sewer Replacement
SITE West of Red River and South of Chief Peguis Trail
LOCATION North of Existing Sewermain on the Upper Bank
DRILLING METHOD CME Track Drill Rig, 125 mm ϕ Solid Stem and HQ Core Barrel

JOB NO. 12-0107-018
GROUND ELEV. 230.84
TOP OF PVC ELEV.
WATER ELEV.
DATE DRILLED 11/13/2012
UTM (m) N 5,534,926
E 636,265

ELEVATION (m)	DEPTH (m) (ft)	GRAPHICS	DESCRIPTION AND CLASSIFICATION	PIEZ. LOG	DEPTH (m)	SAMPLE TYPE NUMBER	RECOVERY %	SPT (N) blows/0.15 m ▲	DYNAMIC CONE (N) blows/ft △	Cu POCKET PEN (kPa) ★	Cu TORVANE (kPa) ◆
										20 40 60 80	PL MC LL
										20 40 60	20 40 60 80
			SILTY CLAY FILL - Black, moist, stiff, high plasticity, trace rootlets. - Trace medium to coarse grained sand, trace fine to coarse grained gravel below 0.23 m.								
	1		SILTY CLAY - Brown, moist, stiff, high plasticity, trace coarse grained sand.			S1					
	5		- No sand below 1.22 m.								
	2		SILTY SAND TO SANDY SILT - Light brown, moist, soft/loose, fine grained sand.			S2					
	3										
	10		SILTY CLAY - Brown, moist, stiff, high plasticity, trace silt nodules (~1-3 mm diameter). - 10 mm diameter gravel piece at 3.73 m.			S3					
	4										
	15										
	5		- Grey below 5.49 m.			S4					
	6		- Firm below 6.10 m.								
	20										
	7					S5					
	25										
	8										
	9		- Slightly increased silt nodules (up to 5 mm diameter) below 9.14 m.			S6					
	30										


SAMPLE TYPE ☒ Auger Grab ☒ Split Spoon ☒ Core Barrel

CONTRACTOR
Paddock Drilling Ltd.

INSPECTOR
C. FRIESEN

APPROVED
DRAFT

DATE
11/26/12

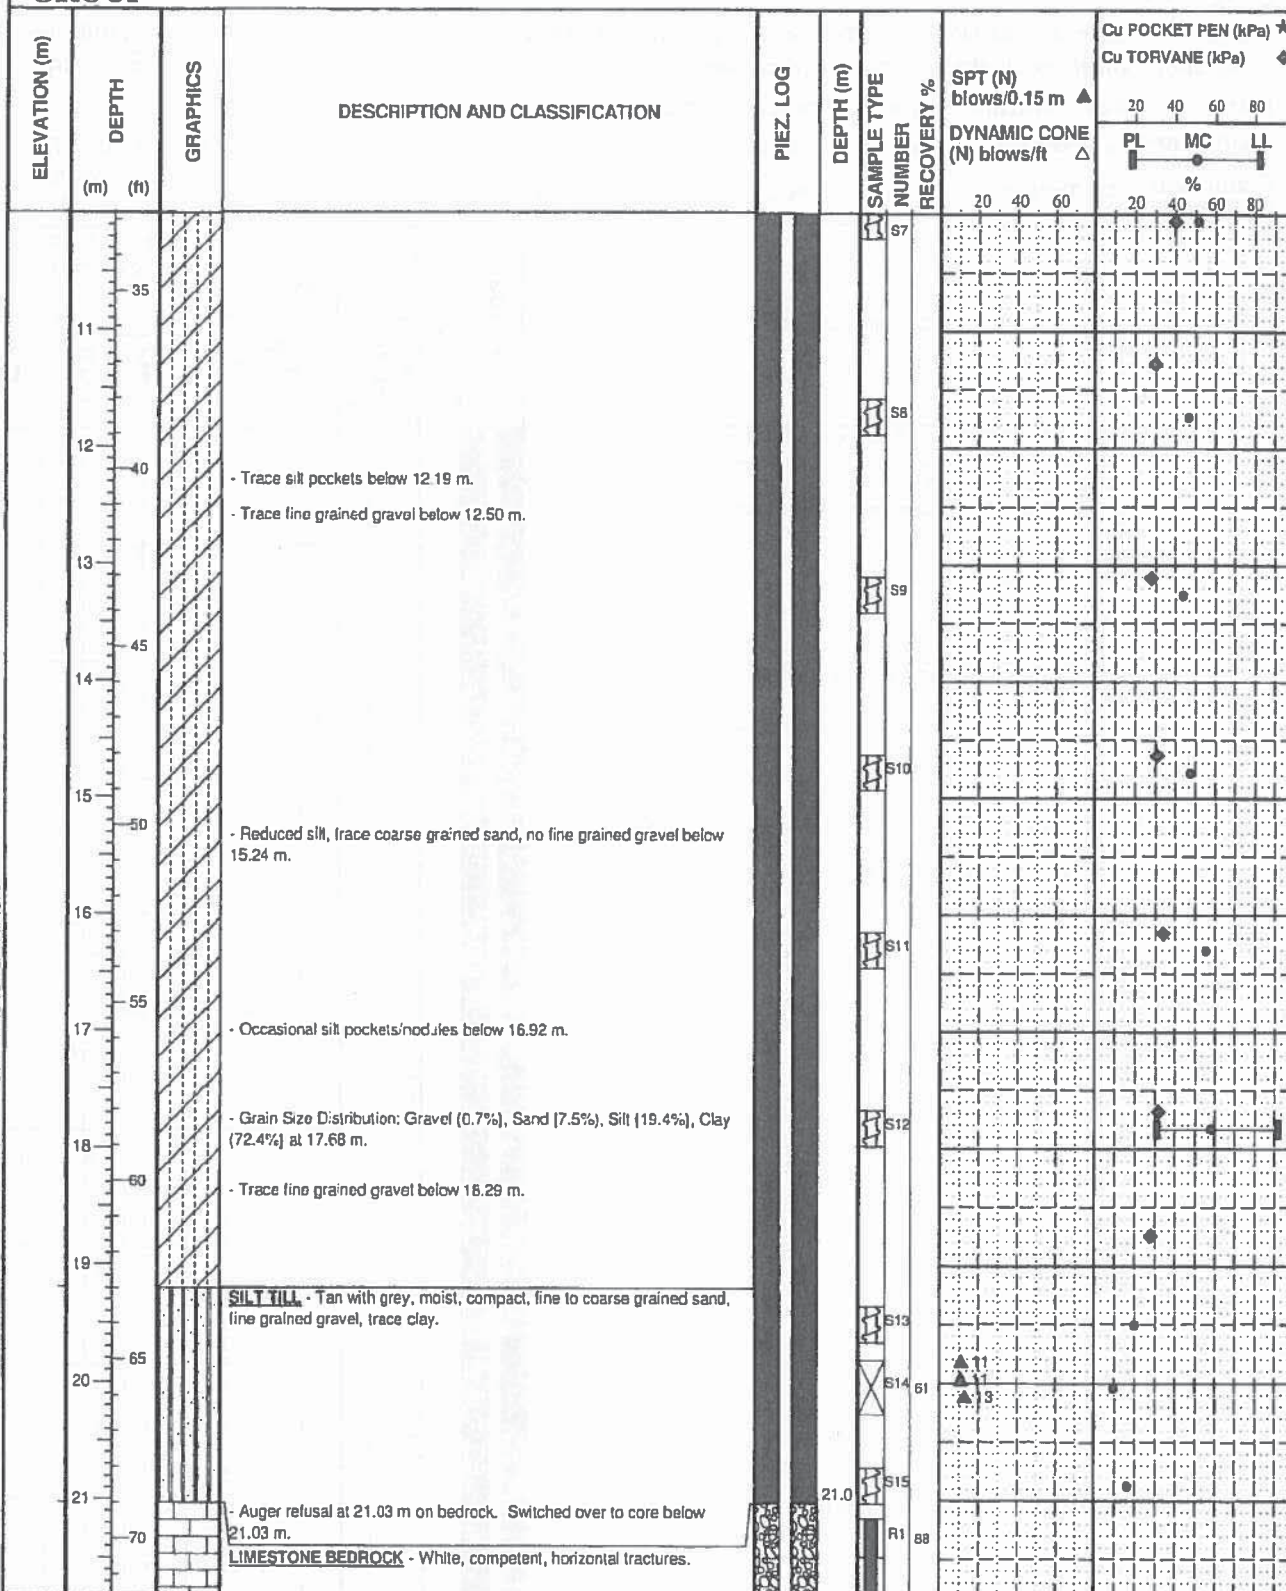

SAMPLE TYPE Auger Grab Split Spoon Core Barrel

CONTRACTOR
Paddock Drilling Ltd.

INSPECTOR
C. FRIESEN

APPROVED
DRAFT

DATE
11/26/12

GEOTECHNICAL-SOIL LOG P:\PROJECTS\2012\12-0107-01\DESIGN\GEOL\GSSCHIEF PEGUIS TRAIL SEWERMAIN GP.J

ELEVATION (m)	DEPTH (m) (ft)	GRAPHICS	DESCRIPTION AND CLASSIFICATION	PIEZ. LOG	DEPTH (m)	SAMPLE TYPE NUMBER	RECOVERY %	SPT (N) blows/0.15 m ▲	DYNAMIC CONE (N) blows/ft △	Cu POCKET PEN (kPa) ★	Cu TORVANE (kPa) ◆
										20 40 60 80	PL MC LL % 20 40 60 80
	22		• Thin clay seam at 21.77 m. • Vertical fracture between 21.84 and 22.05 m.			R2	100				
	23				23.0	R3	97				
	24					R4	100				
	25					R5	97				
	26				27.6	R6	100				
	27					R7	100				
	28		• Rubble zone between 28.46 and 28.52 m. • Vertical fracture between 28.52 and 28.70 m.		29.7						
	29				30.0						
	30		END OF TEST HOLE AT 30.02 m								
	31		Notes: 1. Installed casagrande standpipe at a depth of 30.02 m with a stick-up of 0.91 m. 2. Backfilled test hole with silica sand between 30.02 and 27.58 m, bentonite chips from 27.58 to 23.93 m, slough from 23.93 to 21.03 m and bentonite chips from 21.03 m to grade.								
	32										
	33										

SAMPLE TYPE ☒ Auger Grab ☒ Split Spoon ☐ Core Barrel

CONTRACTOR
Paddock Drilling Ltd.

INSPECTOR
C. FRIESEN

APPROVED
DRAFT

DATE
11/26/12

CLIENT CITY OF WINNIPEG - WATER AND WASTE DEPARTMENT
PROJECT Chief Peguis Bridge Sewer Replacement
SITE West of Red River and South of Chief Peguis Trail
LOCATION ~2 m West of TH12-03
DRILLING METHOD CME Track Drill Rig, 125 mm Ø Solid Stem

JOB NO. 12-0107-018
GROUND ELEV.
TOP OF PVC ELEV.
WATER ELEV.
DATE DRILLED 11/14/2012
UTM (m) N
 E

ELEVATION (m)	DEPTH (m)	DEPTH (ft)	GRAPHICS	DESCRIPTION AND CLASSIFICATION	PIEZ. LOG	DEPTH (m)	SAMPLE TYPE	NUMBER	RECOVERY %	SPT (N) blows/0.15 m ▲	DYNAMIC CONE (N) blows/ft Δ	Cu POCKET PEN (kPa) ★	Cu TORVANE (kPa) ◆
				SILTY CLAY FILL - Black, moist, stiff, high plasticity, trace rootlets. - Trace medium to coarse grained sand, trace fine to coarse grained gravel below 0.23 m.									
				SILTY CLAY - Brown, moist, stiff, high plasticity, trace coarse grained sand. - No sand below 1.22 m.									
				SILTY SAND TO SANDY SILT - Light brown, moist, soft/loose, fine grained sand.									
				SILTY CLAY - Brown, moist, stiff, high plasticity, trace silt nodules (~1-3 mm diameter). - 10 mm diameter gravel piece at 3.73 m.									
				- Grey below 5.49 m.									
				- Firm below 6.10 m.									
				- Slightly increased silt nodules (up to 5 mm diameter) below 9.14 m.									

SAMPLE TYPE

CONTRACTOR
Paddock Drilling Ltd.

INSPECTOR
C. FRIESEN

APPROVED
DRAFT

DATE
11/26/12

ELEVATION (m)	DEPTH (m) (ft)	GRAPHICS	DESCRIPTION AND CLASSIFICATION	PIEZ LOG	DEPTH (m)	SAMPLE TYPE	NUMBER	RECOVERY %	SPT (N) blows/0.15 m ▲	DYNAMIC CONE (N) blows/ft △	Cu POCKET PEN (kPa) ★	Cu TORVANE (kPa) ◆
											20 40 60 80	PL MC LL
											20 40 60	20 40 60 80
	22		2. Installed casagrande standpipe at a depth of 20.98 m with a stick-up of 0.66 m.									
			3. Installed PN 034985 at a depth of 11.64 m. below grade.									
			4. Backfilled test hole with silica sand between 20.98 and 20.12 m and bentonite chips from 20.12 m to grade.									
			5. Test hole squeezing at 8.53 m shortly after drilling.									
	23											
	24											
	25											
	26											
	27											
	28											
	29											
	30											
	31											
	32											
	33											
	110											

SAMPLE TYPE

CONTRACTOR
Paddock Drilling Ltd.

INSPECTOR
C. FRIESEN

APPROVED
DRAFT


DATE
11/26/12

Tabloid (279mm x 432mm)

PLOT: 7/30/2015 10:24:15 AM

FILE NAME: FIG 001 2015-07-30 Site Plan 0_L_HA 0115 009 00.dwg

CROSS-SECTION A

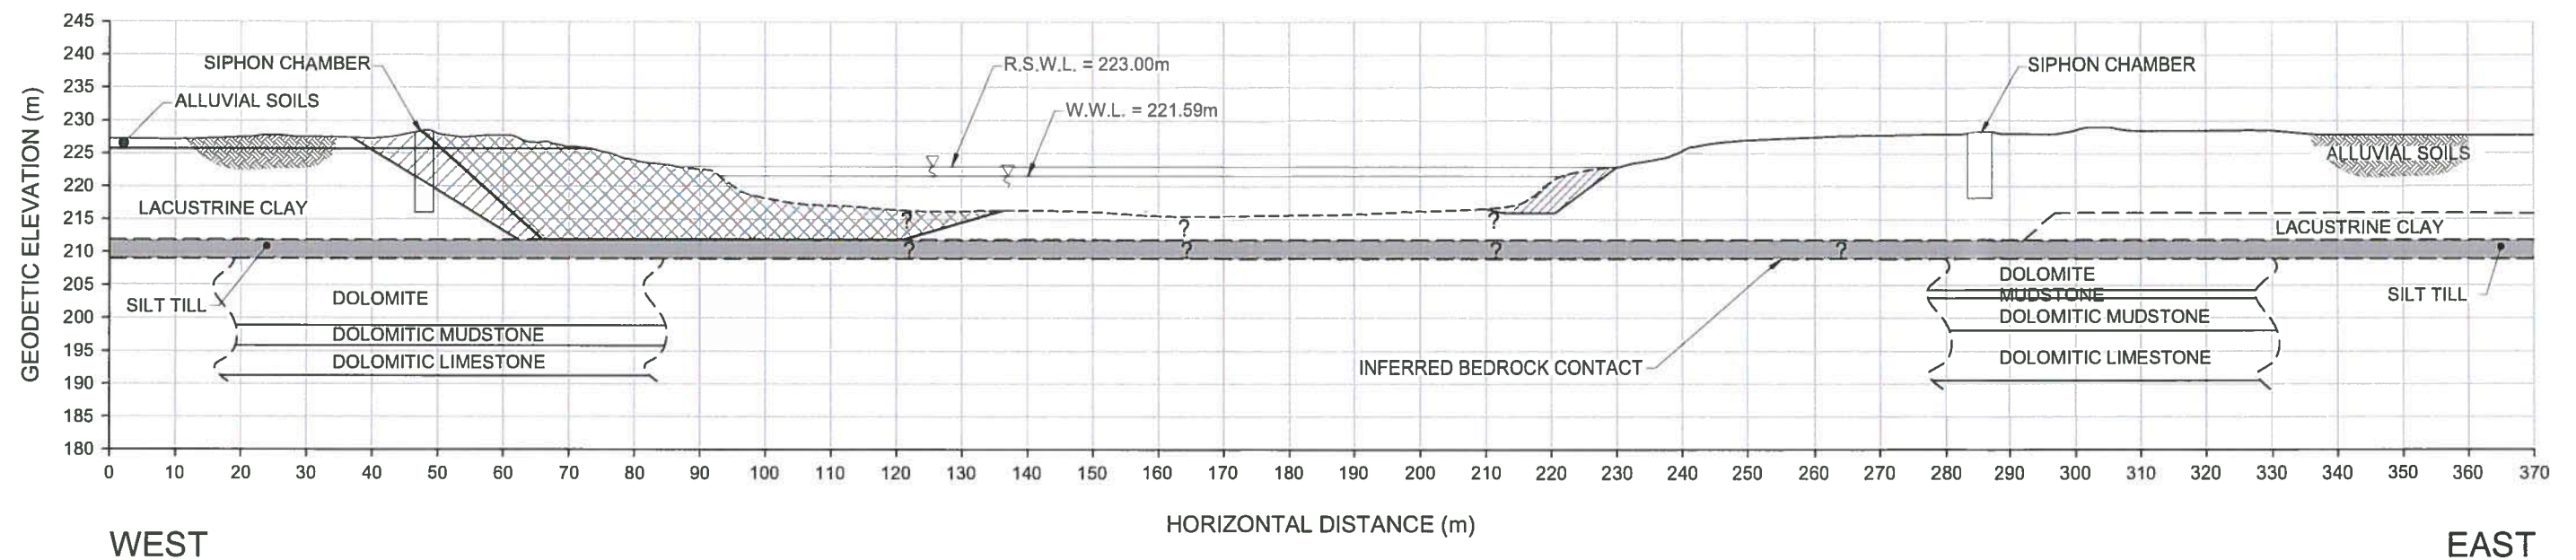

NOTES :

1. RIVER BOTTOM PROFILE ASSUMED FROM 1970 C.O.W. DRAWING 494.
2. RIVER BOTTOM SOIL STRATIGRAPHY WITHIN RIVER CHANNEL IS UNKNOWN.
3. SOIL AND BEDROCK STRATIGRAPHY BASED ON EXISTING INFORMATION FROM PREVIOUS ENGINEERING REPORTS.

LEGEND :


- ZONE OF FACTOR OF SAFETY BETWEEN 1.3 AND 1.5
- ZONE OF FACTOR OF SAFETY < 1.3

0 10 20 30 40m
SCALE : 1:1000 (279mm x 432mm)

Tabloid (279mm x 432mm)

PLOT: 7/30/2015 10:23:24 AM

FILE NAME: FIG 001 2015-07-30 Site Plan 0_L_HA 0115 009 00.dwg

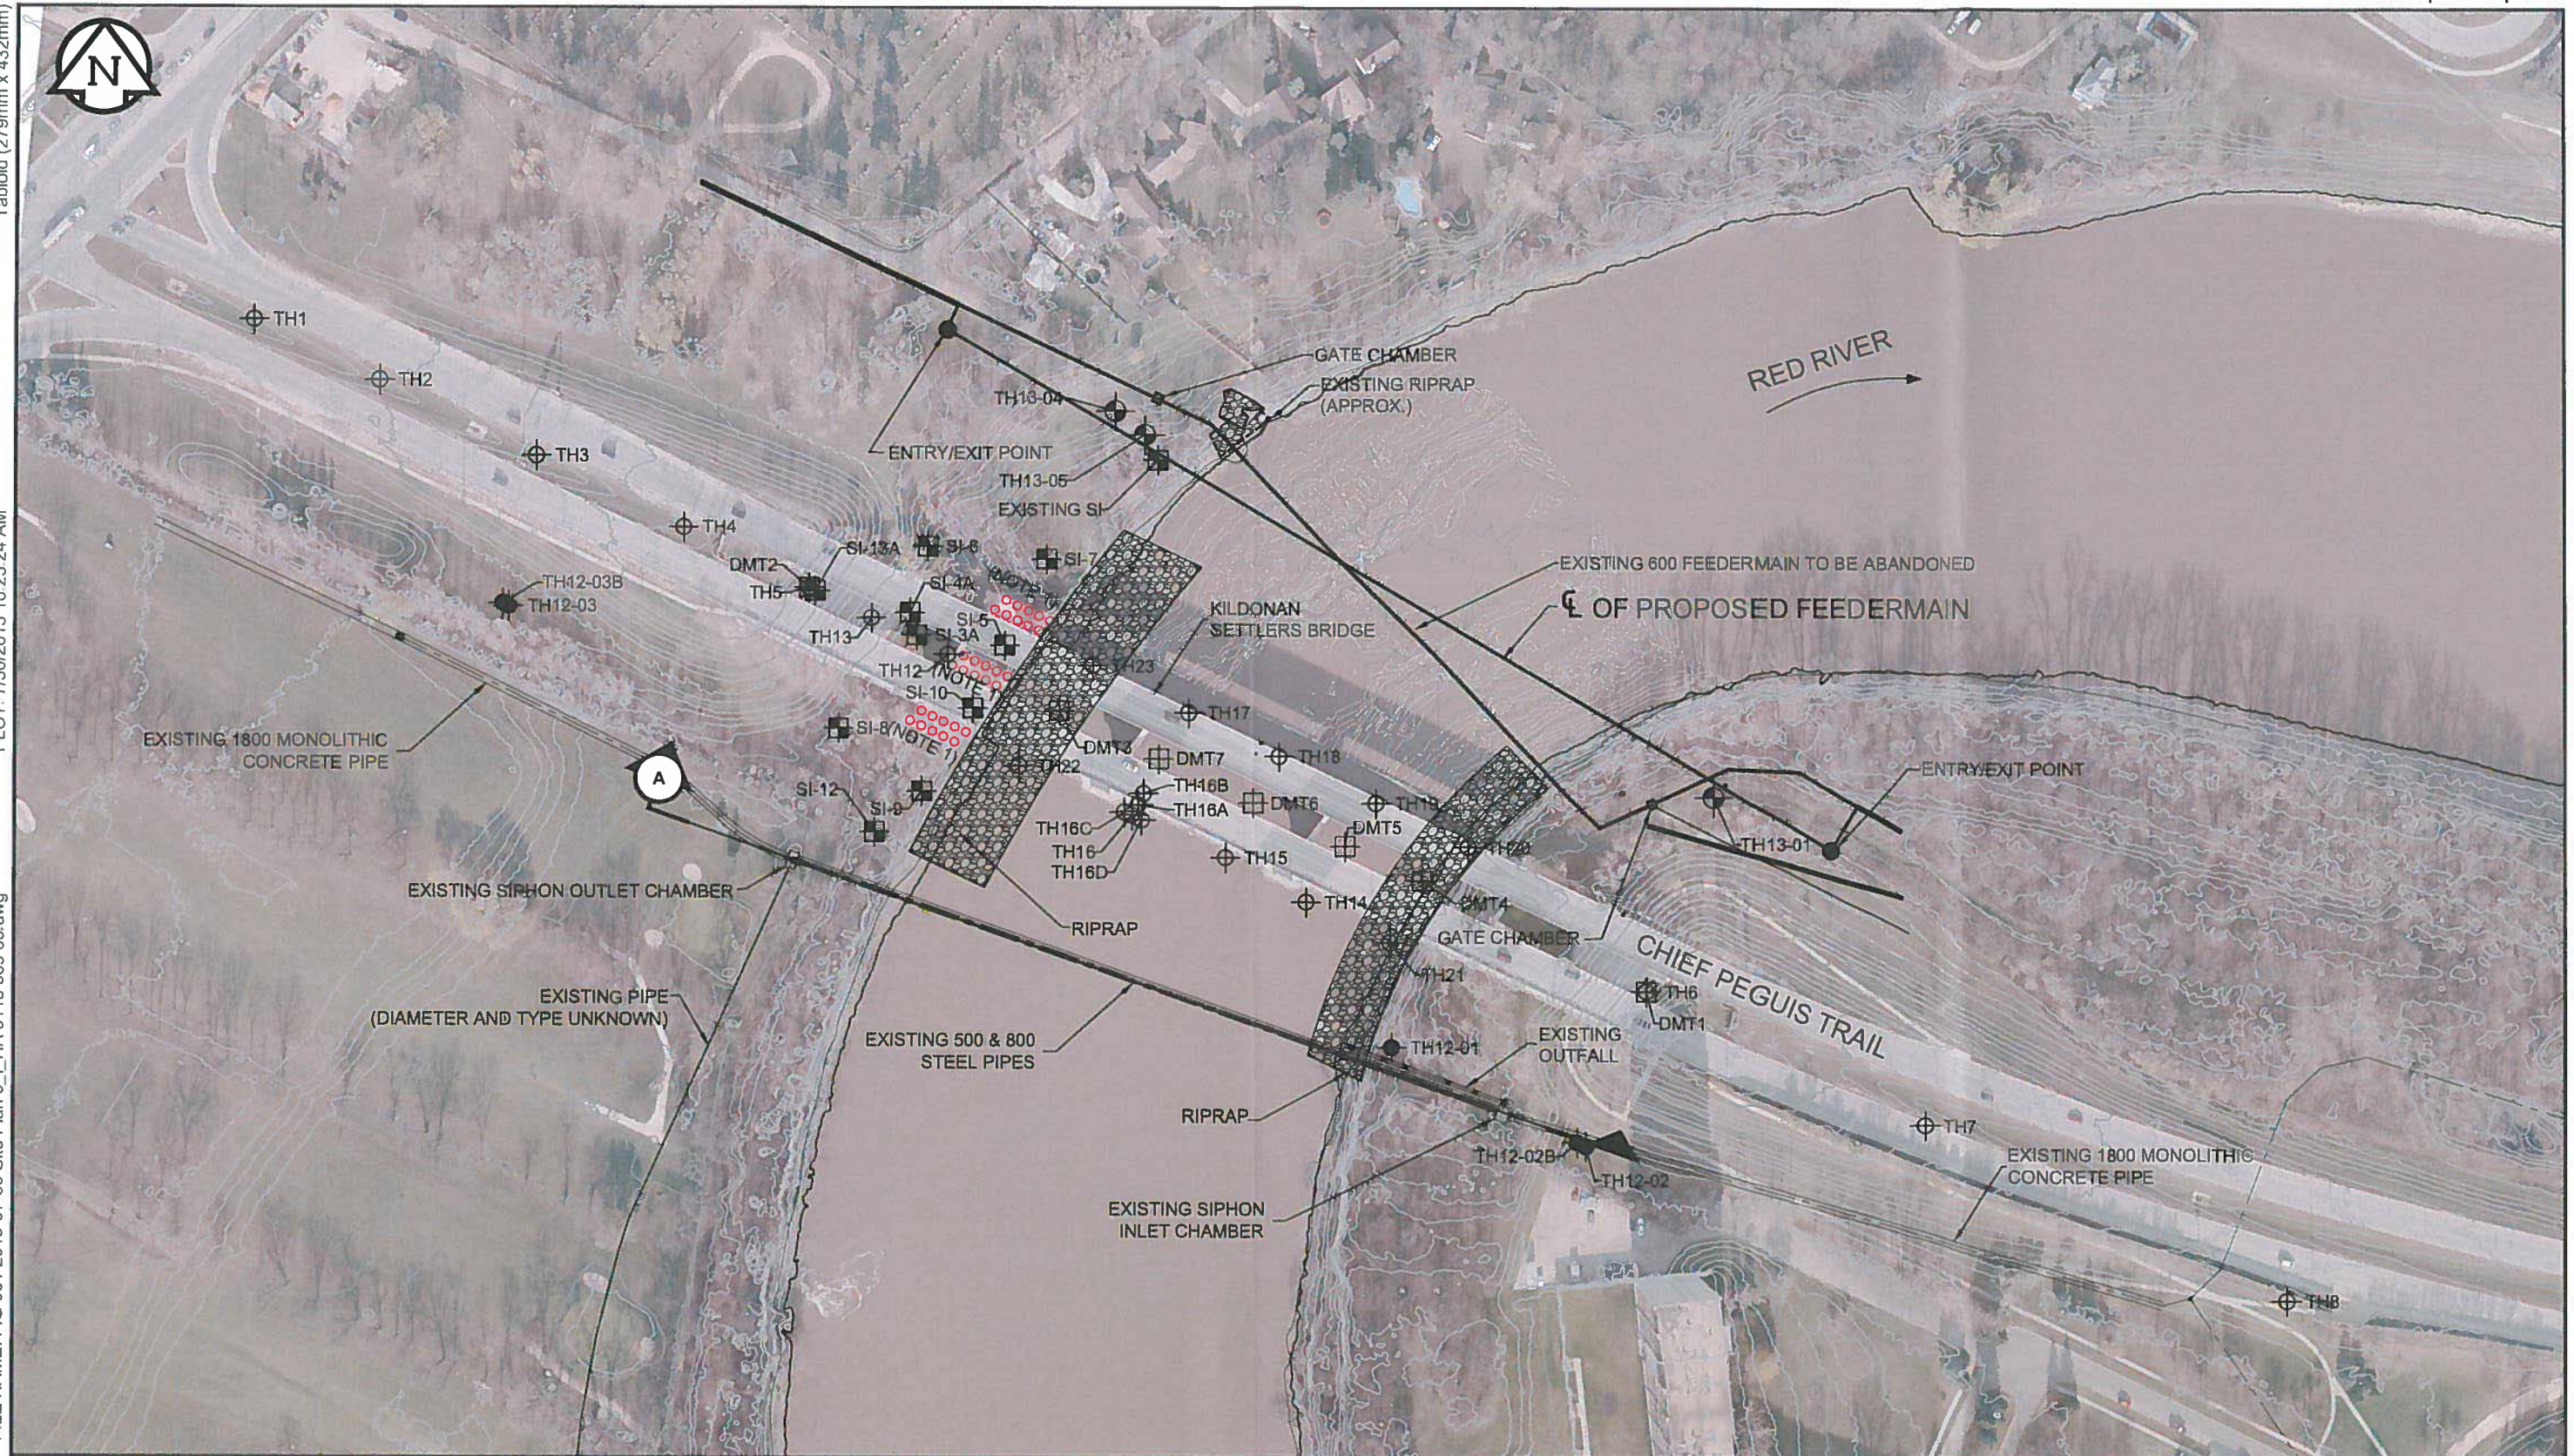

0 20 40 60 80m
SCALE: 1:2000 (279mm x 432mm)

LEGEND:

- TEST HOLE (TREK, 2013)
- ⊕ TEST HOLE (DYREGROV, 1988)

- ◆ TEST HOLE (KGS, 2012)
- ⊞ SLOPE INDICATORS
- ⊞ DILATOMETER TESTING (DYREGROV, 1998)
- ROCK COLUMNS

NOTES:

1. ROCK COLUMNS SHOWN ARE NOT TO SCALE
2. 2008 AERIAL IMAGE IN PROVIDED BY CITY OF WINNIPEG
3. SURVEY INFORMATION PROVIDED BY BARNES AND DUNCAN LAND SURVEYERS AND CITY OF WINNIPEG.

GENERAL NOTES

1. Classifications are based on the United Soil Classification System and include consistency, moisture, and color. Field descriptions have been modified to reflect results of laboratory tests where deemed appropriate.
2. Descriptions on these test hole logs apply only at the specific test hole locations and at the time the test holes were drilled. Variability of soil and groundwater conditions may exist between test hole locations.
3. When the following classification terms are used in this report or test hole logs, the primary and secondary soil fractions may be visually estimated.

Major Divisions			USCS Classification	Symbols	Typical Names	Laboratory Classification Criteria			Particle Size						
Coarse-Grained soils (More than half the material is larger than No. 200 sieve size) Gravels (More than half of coarse fraction is larger than 4.75 mm) Clean gravel (Little or no fines) Gravel with fines (Appreciable amount of fines) GC Clayey gravels, gravel-sand-silt mixtures Sands (More than half of coarse fraction is smaller than 4.75 mm) Clean sands (Little or no fines) SP Poorly-graded sands, gravelly sands, little or no fines Sands with fines (Appreciable amount of fines) SM Silty sands, sand-silt mixtures SC Clayey sands, sand-clay mixtures						$C_u = \frac{D_{60}}{D_{10}}$ greater than 4; $C_c = \frac{(D_{30})^2}{D_{10} \times D_{60}}$ between 1 and 3			ASTM Sieve sizes		#10 to #4 #40 to #10 #200 to #40 < #200				
						Not meeting all gradation requirements for GW									
						Atterberg limits below "A" line or P.I. less than 4		Above "A" line with P.I. between 4 and 7 are borderline cases requiring use of dual symbols							
						Atterberg limits above "A" line or P.I. greater than 7									
						$C_u = \frac{D_{60}}{D_{10}}$ greater than 6; $C_c = \frac{(D_{30})^2}{D_{10} \times D_{60}}$ between 1 and 3									
						Not meeting all gradation requirements for SW									
						Atterberg limits below "A" line or P.I. less than 4		Above "A" line with P.I. between 4 and 7 are borderline cases requiring use of dual symbols							
						Atterberg limits above "A" line or P.I. greater than 7									
Determine percentages of sand and gravel from grain size curve, depending on percentage of fines (fraction smaller than No. 200 sieve) coarse-grained soils are classified as follows: Less than 5 percent..... GW, GP, SW, SP More than 12 percent..... GM, GC, SM, SC 6 to 12 percent..... Borderline cases requiring dual symbols*									mm		2.00 to 4.75	0.425 to 2.00	0.075 to 0.425	< 0.075	
									Material		Sand	Coarse	Medium	Fine	Silt or Clay
Fine-Grained soils (More than half the material is smaller than No. 200 sieve size) Silts and Clays (Liquid limit less than 50) ML Inorganic silts and very fine sands, rock flour, silty or clayey fine sands or clayey silts with slight plasticity CL Inorganic clays of low to medium plasticity, gravelly clays, sandy clays, silty clays, lean clays OL Organic silts and organic silty clays of low plasticity Silts and Clays (Liquid limit greater than 50) MH Inorganic silts, micaceous or distomaceous fine sandy or silty soils, organic silts CH Inorganic clays of high plasticity, fat clays OH Organic clays of medium to high plasticity, organic silts Highly Organic Soils Pt Peat and other highly organic soils									ASTM Sieve Sizes		> 12 in.	3 in. to 12 in.	3/4 in. to 3 in.	#4 to 3/4 in.	
									mm		> 300	75 to 300	19 to 75	4.75 to 19	
									Material		Boulders	Cobbles	Gravel	Coarse	Fine
Von Post Classification Limit Strong colour or odour, and often fibrous texture															

* Borderline classifications used for soils possessing characteristics of two groups are designated by combinations of groups symbols. For example; GW-GC, well-graded gravel-sand mixture with clay binder.

Other Symbol Types

	Asphalt		Bedrock (undifferentiated)		Cobbles
	Concrete		Limestone Bedrock		Boulders and Cobbles
	Fill		Cemented Shale		Silt Till
			Non-Cemented Shale		Clay Till



EXPLANATION OF FIELD AND
LABORATORY TESTING

LEGEND OF ABBREVIATIONS AND SYMBOLS

LL	- Liquid Limit (%)	▽	Water Level at Time of Drilling
PL	- Plastic Limit (%)	▼	Water Level at End of Drilling
PI	- Plasticity Index (%)	▽	Water Level After Drilling as Indicated on Test Hole Logs
MC	- Moisture Content (%)		
SPT	- Standard Penetration Test		
RQD	- Rock Quality Designation		
Qu	- Unconfined Compression		
Su	- Undrained Shear Strength		
VW	- Vibrating Wire Piezometer		
SI	- Slope Inclinator		

FRACTION OF SECONDARY SOIL CONSTITUENTS ARE BASED ON THE FOLLOWING TERMINOLOGY

TERM	EXAMPLES	PERCENTAGE
and	and CLAY	35 to 50 percent
"y" or "ey"	clayey, silty	20 to 35 percent
some	some silt	10 to 20 percent
trace	trace gravel	1 to 10 percent

TERMS DESCRIBING CONSISTENCY OR COMPACTION CONDITION

The Standard Penetration Test blow count (N) of a non-cohesive soil can be related to compactness condition as follows:

Descriptive Terms	SPT (N) (Blows/300 mm)
Very loose	< 4
Loose	4 to 10
Compact	10 to 30
Dense	30 to 50
Very dense	> 50

The Standard Penetration Test blow count (N) of a cohesive soil can be related to its consistency as follows:

Descriptive Terms	SPT (N) (Blows/300 mm)
Very soft	< 2
Soft	2 to 4
Firm	4 to 8
Stiff	8 to 15
Very stiff	15 to 30
Hard	> 30

The undrained shear strength (Su) of a cohesive soil can be related to its consistency as follows:

Descriptive Terms	Undrained Shear Strength (kPa)
Very soft	< 12
Soft	12 to 25
Firm	25 to 50
Stiff	50 to 100
Very stiff	100 to 200
Hard	> 200



Sub-Surface Log

Test Hole TH13-01
1 of 3

Client:Associated Engineering

Project Name:Detailed Design North Kildonan Feedermain

Contractor:Paddock Drilling Ltd.

Method:Acker SS3 Track Mount (see notes for drilling method)

Project Number:0115 004 00

Location:UTM N-5534866.43, E-636644.43

Ground Elevation:227.36 m

Date Drilled:7 November 2013

Sample Type:

Grab (G)

Shelby Tube (T)

Split Spoon (SS)

Split Barrel (SB)

Core (C)

Particle Size Legend:

Fines

Clay

Silt

Sand

Gravel

Cobbles

Boulders

Backfill Legend:

Bentonite


Cement

Drill Cuttings

Filter Pack Sand

Grout

Slough

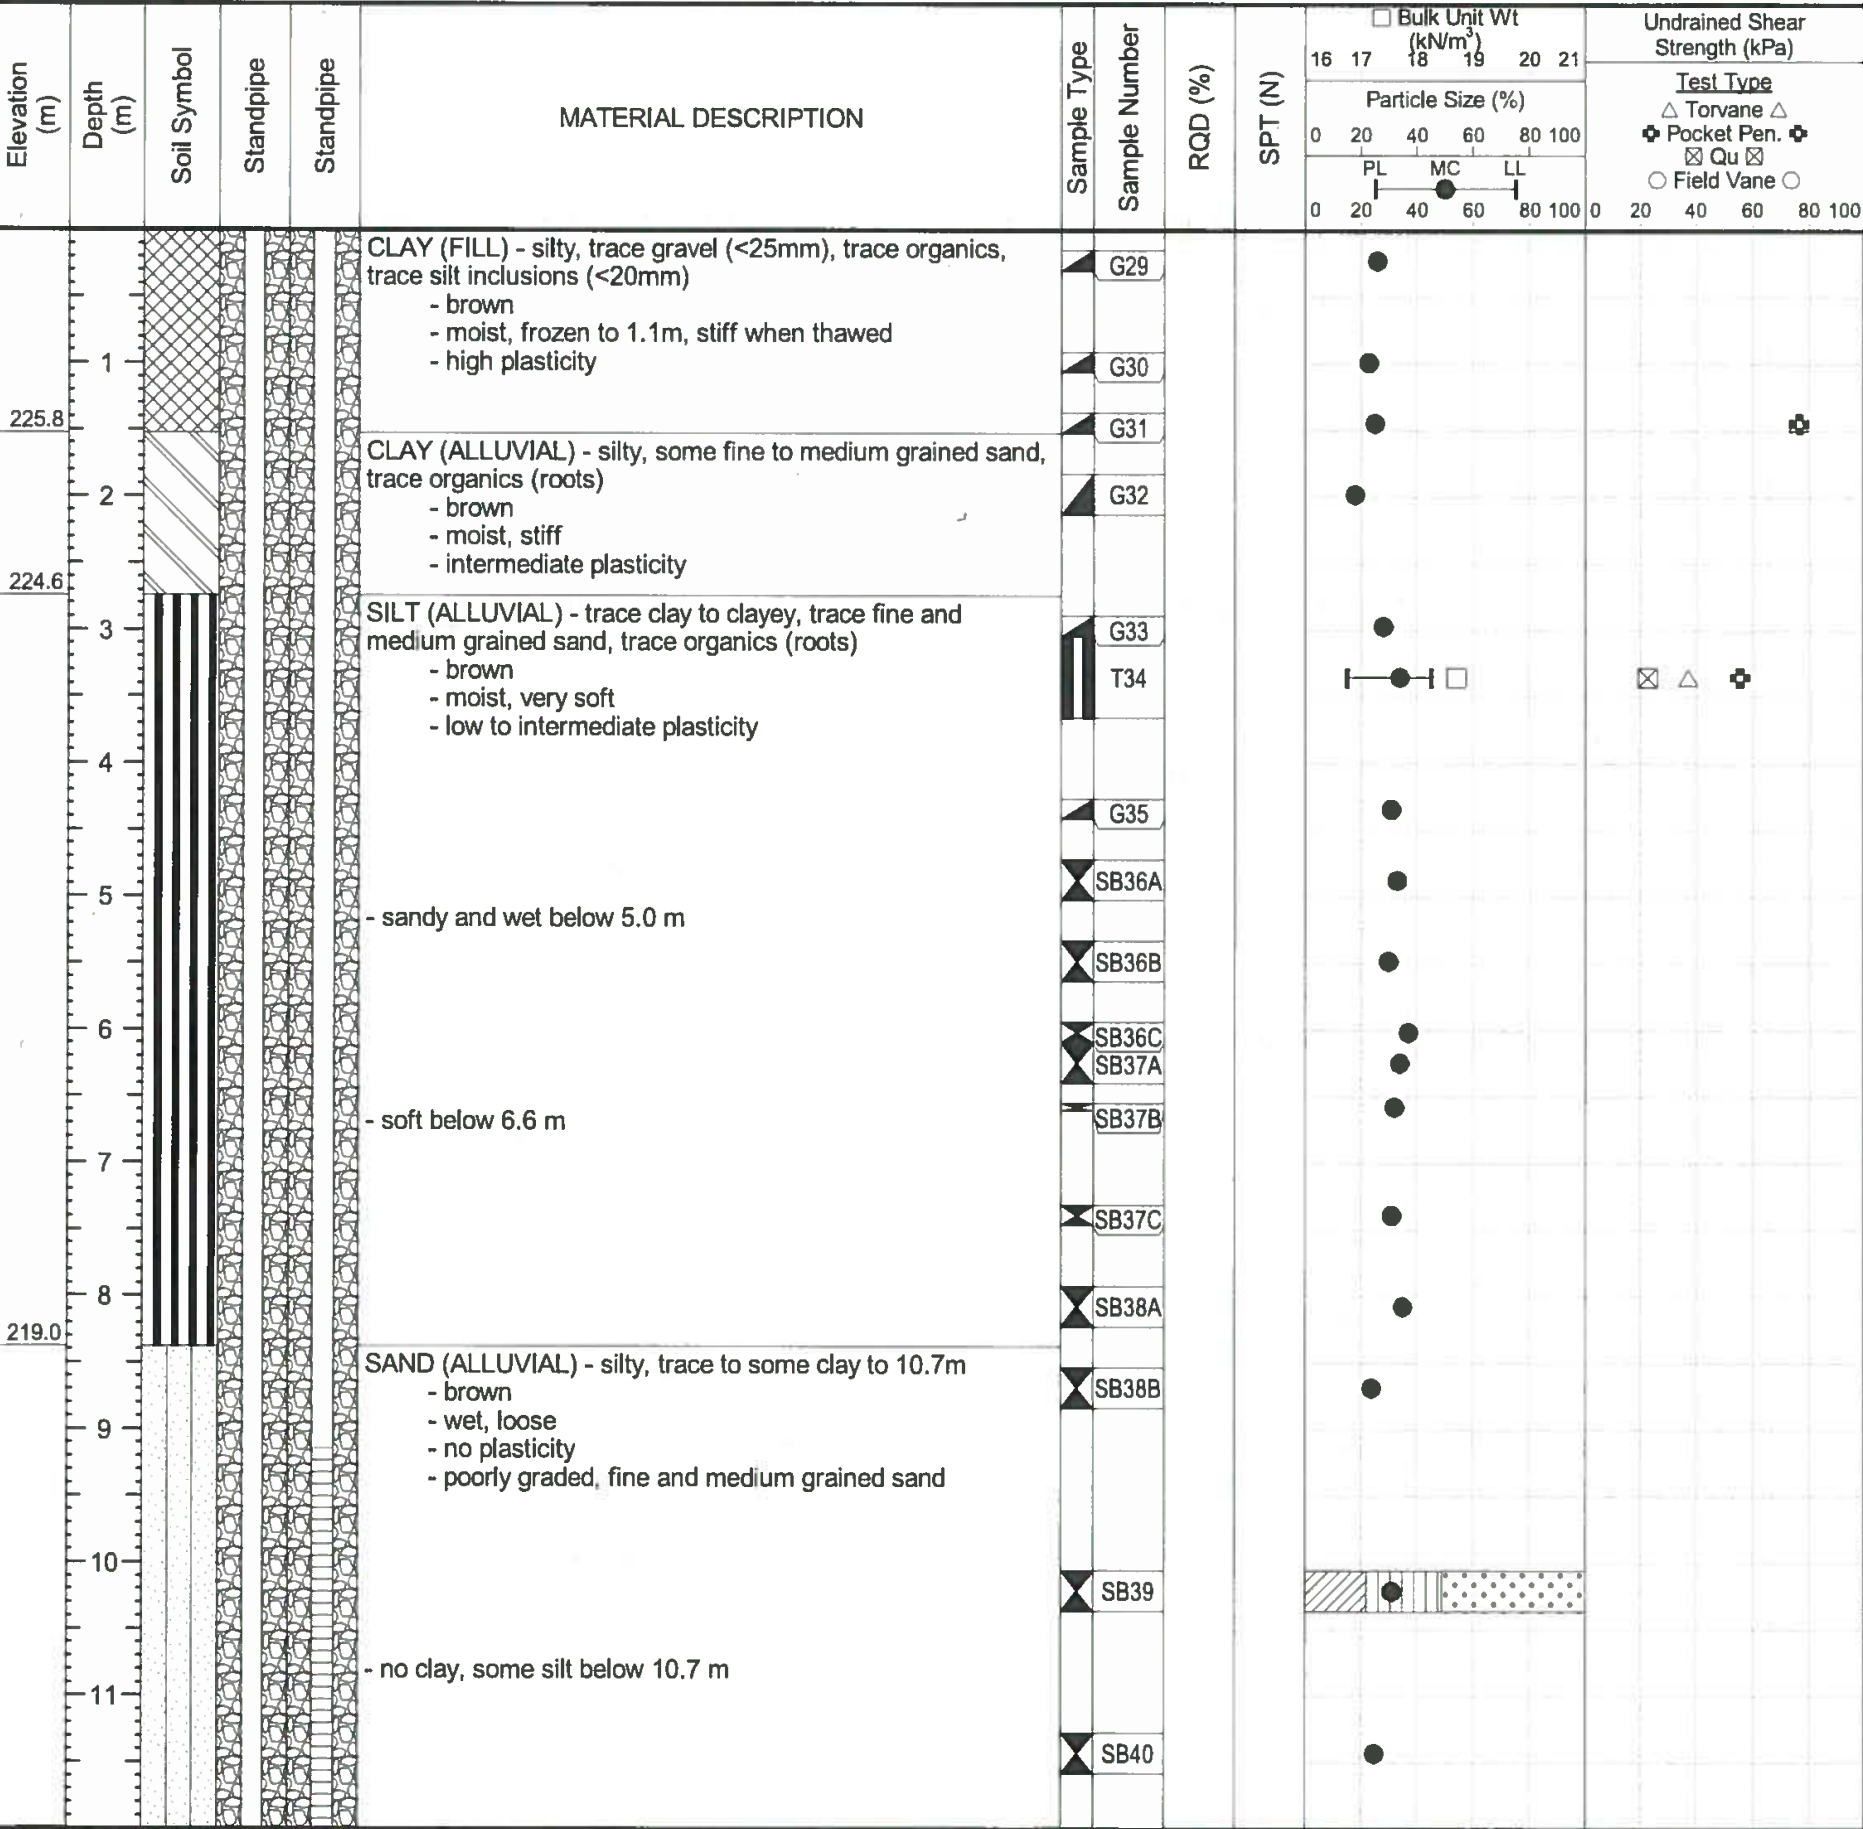

SUB-SURFACE LOG 0115 004 00 DETAILED DESIGN NORTH KILDONAN FEEDERMAIN - LOGS.GPJ TREK GEOTECHNICAL.GDT 15/1/14

Logged By:Stephen Renner

Reviewed By:Nelson Ferreira

Project Engineer:Nelson Ferreira

Project Engineer: Nelson Ferreira

SUB-SURFACE LOG 0115 004 00 DETAILED DESIGN NORTH KILDONAN FEEDERMAIN - LOGS.GPJ TREK GEOTECHNICAL.GDT 15/1/14

TREK GEOTECHNICAL Sub-Surface Log					Test Hole TH13-01					3 of 3																																																																																																																																																																																																																																																																																																																																																																																																																																																																																																																																																																																																																																																																																																																																																																																																																																																																																																																																																																																																																																																																																																																																																																																																																																																																							
Elevation (m)	Depth (m)	Soil Symbol	Standpipe	Standpipe	MATERIAL DESCRIPTION	Sample Type	Sample Number	RQD (%)	SPT (N)	Bulk Unit Wt (kN/m³)					Particle Size (%)					Undrained Shear Strength (kPa)																																																																																																																																																																																																																																																																																																																																																																																																																																																																																																																																																																																																																																																																																																																																																																																																																																																																																																																																																																																																																																																																																																																																																																																																																																																													
																				Test Type																																																																																																																																																																																																																																																																																																																																																																																																																																																																																																																																																																																																																																																																																																																																																																																																																																																																																																																																																																																																																																																																																																																																																																																																																																																													
																				△ Torvane △																																																																																																																																																																																																																																																																																																																																																																																																																																																																																																																																																																																																																																																																																																																																																																																																																																																																																																																																																																																																																																																																																																																																																																																																																																																													
																				✦ Pocket Pen. ✦																																																																																																																																																																																																																																																																																																																																																																																																																																																																																																																																																																																																																																																																																																																																																																																																																																																																																																																																																																																																																																																																																																																																																																																																																																																													
										PL MC LL					⊠ Qu ⊠					○ Field Vane ○																																																																																																																																																																																																																																																																																																																																																																																																																																																																																																																																																																																																																																																																																																																																																																																																																																																																																																																																																																																																																																																																																																																																																																																																																																																													
										0 20 40 60 80 100					0 20 40 60 80 100					0 20 40 60 80 100																																																																																																																																																																																																																																																																																																																																																																																																																																																																																																																																																																																																																																																																																																																																																																																																																																																																																																																																																																																																																																																																																																																																																																																																																																																													
	27				- chalk nodules at 26.8 m		CB62	96																																																																																																																																																																																																																																																																																																																																																																																																																																																																																																																																																																																																																																																																																																																																																																																																																																																																																																																																																																																																																																																																																																																																																																																																																																																																									</



Sub-Surface Log

Test Hole TH13-04
1 of 2

Client:Associated Engineering

Project Name:Detailed Design North Kildonan Feedermain

Contractor:Paddock Drilling Ltd.

Method:Acker SS3 Track Mount (see notes for drilling method)

Project Number:0115 004 00

Location:UTM N-5534987.21, E-636455.82

Ground Elevation:227.19 m

Date Drilled:6 November 2013

Sample Type:

Grab (G)

Shelby Tube (T)

Split Spoon (SS)

Split Barrel (SB)

Core (C)

Particle Size Legend:

Fines

Clay

Silt

Sand

Gravel

Cobbles

Boulders

Backfill Legend:

Bentonite

Cement

Drill Cuttings

Filter Pack Sand

Grout

Slough

Elevation (m)	Depth (m)	Soil Symbol	Standpipe	MATERIAL DESCRIPTION	Sample Type	Sample Number	RQD (%)	SPT (N)	Bulk Unit Wt (kN/m³)					Undrained Shear Strength (kPa)						
									Particle Size (%)					Test Type						
									16	17	18	19	20	21	0	20	40	60	80	100
				CLAY (ALLUVIAL) - silty, some gravel, trace fine sand, trace to some organics (roots and rootlets)																
				- dark brown		G46														
				- moist, very stiff		G47														
				- high plasticity																
				CLAY (LACUSTRINE) - silty to 2.4m, some gravel, trace fine sand, trace organics (roots and rootlets), trace oxidation		G48														
				- dark brown, moist, soft to firm, high plasticity		SB01														
				- grey below 2.4 m		SB02														
				- trace silt inclusions (<15mm) and soft below 2.7 m		G49														
						T03														
				- firm to stiff, trace to some oxidation below 3.7 m		SB04														
						SB05														
						SB06														
				- trace coarse sand below 5.8 m		SB07														
						T08														
						SB09														
				- trace gravel (<25mm) below 7.3 m		SB10														
				- trace to some silt inclusions (<15mm) below 7.9 m		SB11														
						SB12														
						T13														
				- trace till inclusions (<75mm) below 10.4 m		SB14														
						SB15														
						SB16														
						SB17														

Logged By:Stephen Renner

Reviewed By:Nelson Ferreira

Project Engineer:Nelson Ferreira

SUB-SURFACE LOG 0115 004 00 DETAILED DESIGN NORTH KILDONAN FEEDMAIN - LOGS.GPJ TREK GEOTECHNICAL.GDT 15/1/14



Sub-Surface Log

Test Hole TH13-04
2 of 2

Elevation (m)	Depth (m)	Soil Symbol	Standpipe	MATERIAL DESCRIPTION	Sample Type	Sample Number	RQD (%)	SPT (N)	Bulk Unit Wt (kN/m ³)	Undrained Shear Strength (kPa)
									16 17 18 19 20 21	
									Particle Size (%) 0 20 40 60 80 100 PL MC LL	
						SB18				✚ △
	13					SB19			●	✚ △
	14			- trace to some till inclusions below 14.0 m		SB20			●	✚ △
						SB21			●	✚ △
212.2	15			SILT (TILL) - trace clay, trace gravel (<25mm), trace sand - light brown, moist, loose, low plasticity		SB22		●		
211.8				CLAY - silty, trace gravel - grey, moist, soft to firm, high plasticity		SS23			●	
211.3	16			SILT (TILL) - trace clay, trace gravel (<25mm), trace sand (poorly graded) - light brown, moist, loose, low plasticity		SB24		●		
				- dense below 16.4 m		SB25		●		
210.1	17			DOLOMITE (BEDROCK) - beige, vertical and horizontal, rough undulating fractures, slightly altered, clay infilling		CB26	86			
	18									
	19					CB27	100			
	20									
	21					CB28	100			
205.5										

END OF TEST HOLE at 21.6 m in DOLOMITE (BEDROCK)
Notes:
1) Power auger refusal at 16.7 m.
2) No seepage or sloughing observed.
3) Water level at 4.2 m depth immediately after drilling prior to coring.
4) Test hole drilled using solid stem augers to 16.7 m then drill method switched to HQ coring.

SUB-SURFACE LOG 0115 004 00 DETAILED DESIGN NORTH KILDONAN FEEDERMAIN - LOGS.GPJ TREK GEOTECHNICAL.GDT 15/1/14



Sub-Surface Log

Test Hole TH13-05
1 of 3

Client:	Associated Engineering	Project Number:	0115 004 00
Project Name:	Detailed Design North Kildonan Feedermain	Location:	UTM N-5534979.78, E-636465.14
Contractor:	Paddock Drilling Ltd.	Ground Elevation:	226.26 m
Method:	CME-850 Track Mount (see notes for drilling method)	Date Drilled:	15 November 2013

Sample Type:	☐ Grab (G)	☐ Shelby Tube (T)	☐ Split Spoon (SS)	☐ Split Barrel (SB)	☐ Core (C)		
Particle Size Legend:	☐ Fines	☐ Clay	☐ Silt	☐ Sand	☐ Gravel	☐ Cobbles	☐ Boulders
Backfill Legend:	☐ Bentonite	☐ Cement	☐ Drill Cuttings	☐ Filter Pack Sand	☐ Grout	☐ Slough	

Elevation (m)	Depth (m)	Soil Symbol	Standpipe	MATERIAL DESCRIPTION	Sample Type	Sample Number	RQD (%)	SPT (N)	Bulk Unit Wt (kN/m ³)		Undrained Shear Strength (kPa)				
									16	17		18	19	20	21
									Particle Size (%)						
									0	20		40	60	80	100

Logged By:	Martial Lemoine	Reviewed By:	Nelson Ferreira	Project Engineer:	Nelson Ferreira
------------	-----------------	--------------	-----------------	-------------------	-----------------

Logged By: Martial Lemoine **Reviewed By:** Nelson Ferreira **Project Engineer:** Nelson Ferreira



Sub-Surface Log

Test Hole TH13-05
3 of 3

Elevation (m)	Depth (m)	Soil Symbol	Standpipe	MATERIAL DESCRIPTION	Sample Type	Sample Number	RQD (%)	SPT (N)	Bulk Unit Wt (kN/m ³)		Particle Size (%)		Undrained Shear Strength (kPa)			
									16	17	18	19	20	21	Test Type	
															Torvane Δ	
															Pocket Pen. $\oplus$	
						Qu $\boxtimes$										
						Field Vane $\circ$										
						0 20 40 60 80 100										
						0 20 40 60 80 100										
END OF TEST HOLE At 35.1 m in DOLOMITIC LIMESTONE (BEDROCK)
Notes:
1) Power auger refusal at 16.2 m.
2) No seepage or sloughing observed.
3) Water level at 3.7 m depth immediately after dilling prior to coring.
4) Test hole drilled using solid stem augers to 16.2 m then drilling method switched to HQ coring.

SUB-SURFACE LOG 0115 004 00 DETAILED DESIGN NORTH KILDONAN FEEDERMAIN - LOGS.GPJ TREK GEOTECHNICAL.GDT 15/1/14