


APPENDIX D – EXISTING RECORDS FOR THE EMPRESS ST STRUCTURE – VARIOUS DRAWINGS


The included documents are supplied for review and use of the Proponent during the bidding period only. The information remains the property of the City of Winnipeg.

This information is not meant to be exhaustive and is not meant to take the place of the investigations and due diligence required of the Proponent.

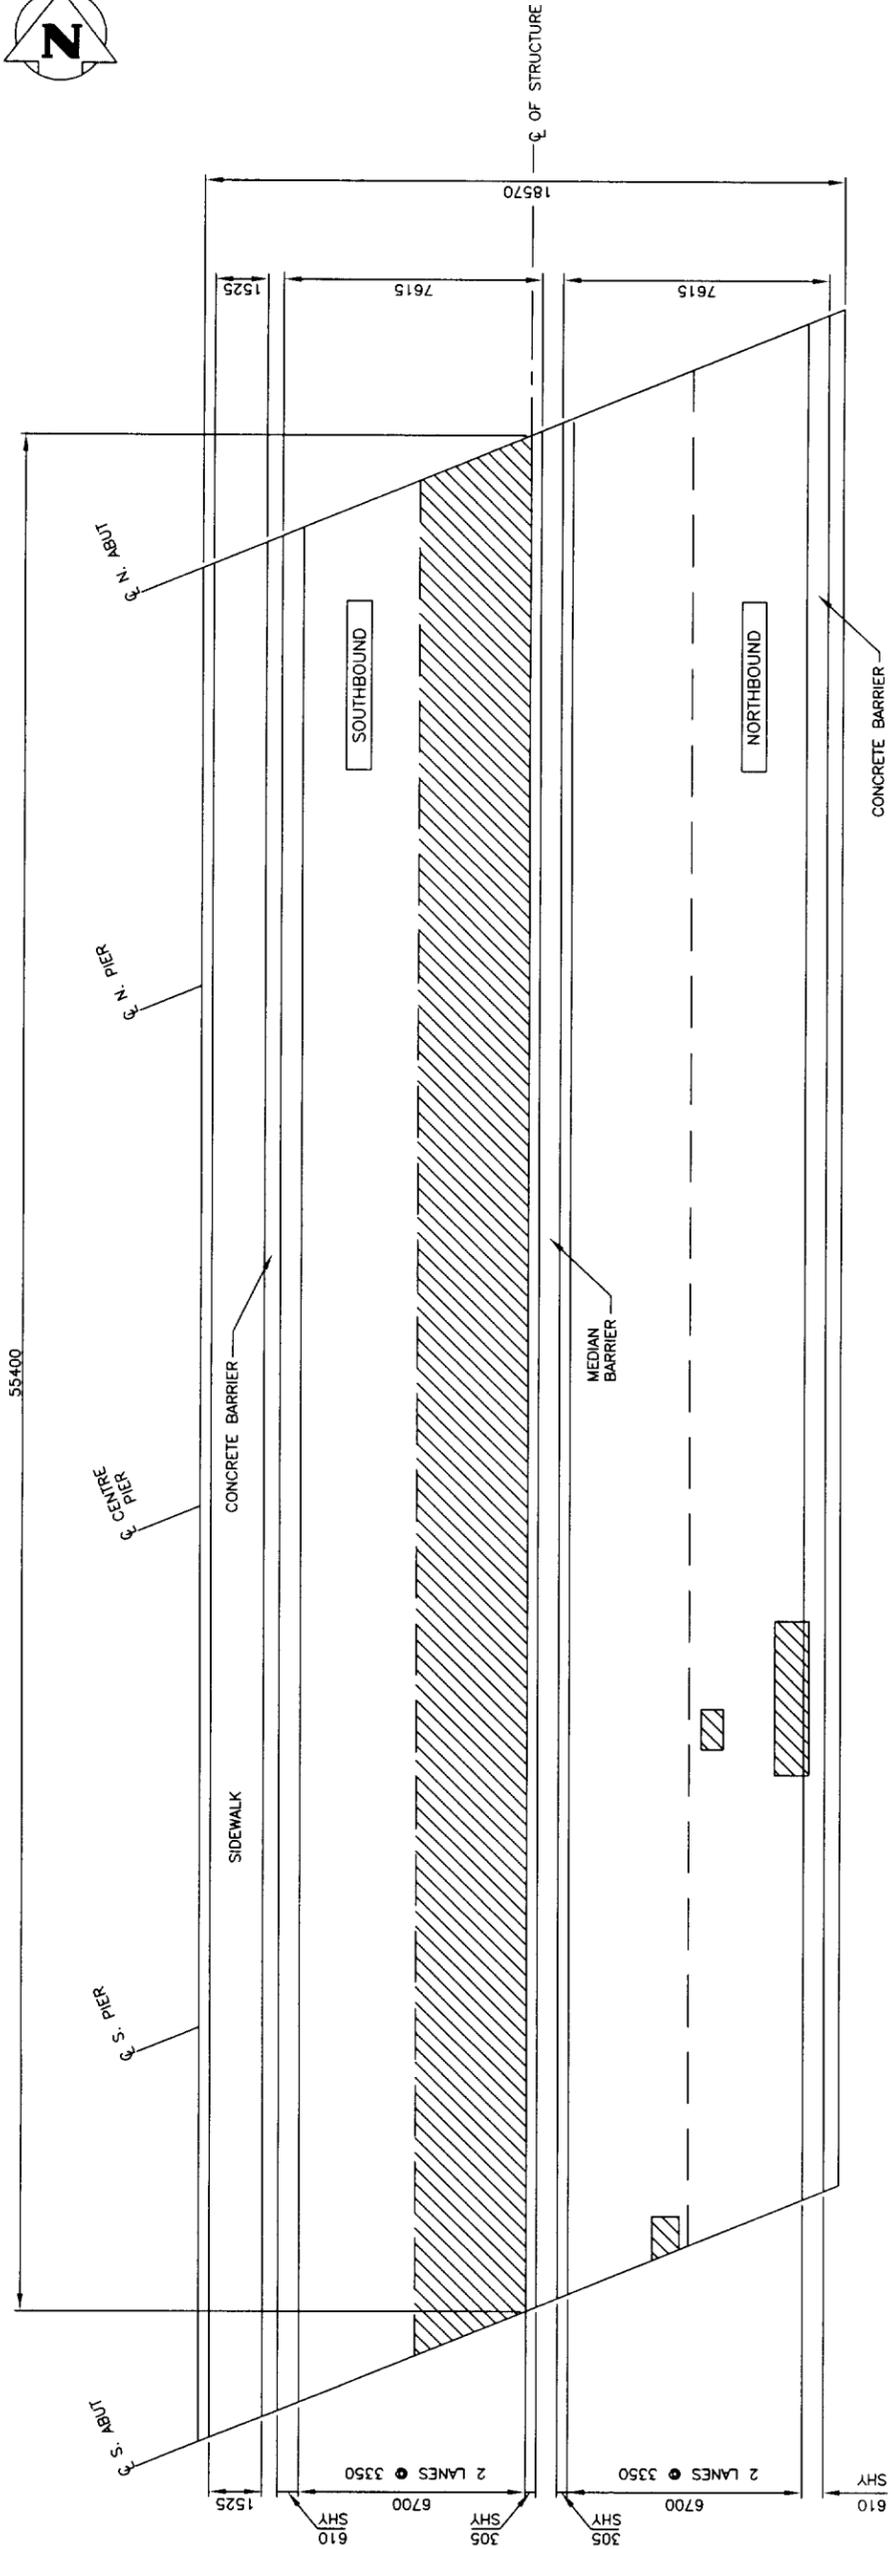


AREA TO APPLY NON-SKID POLYMER WEARING SURFACE ON BRIDGE DECK

DECK LAYOUT
N.T.S.

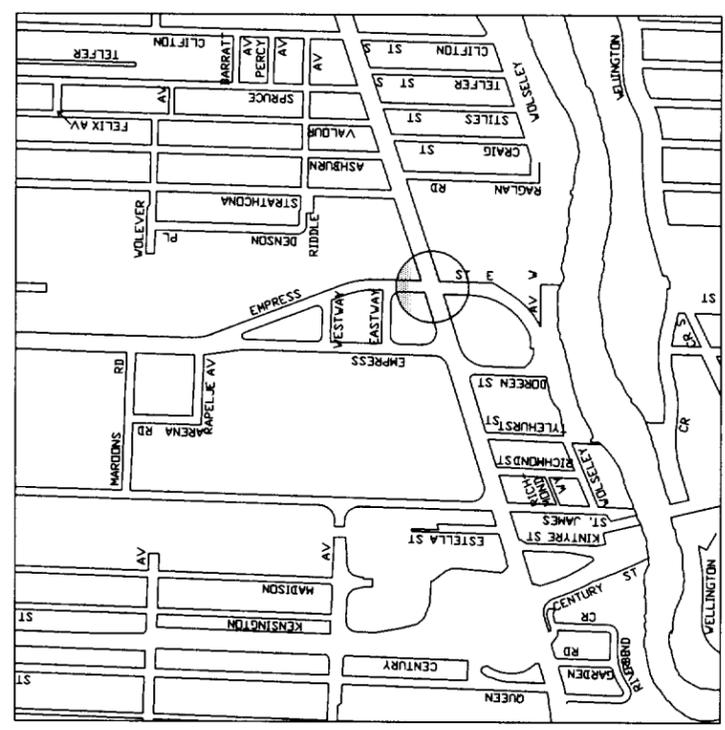

LOCATION PLAN

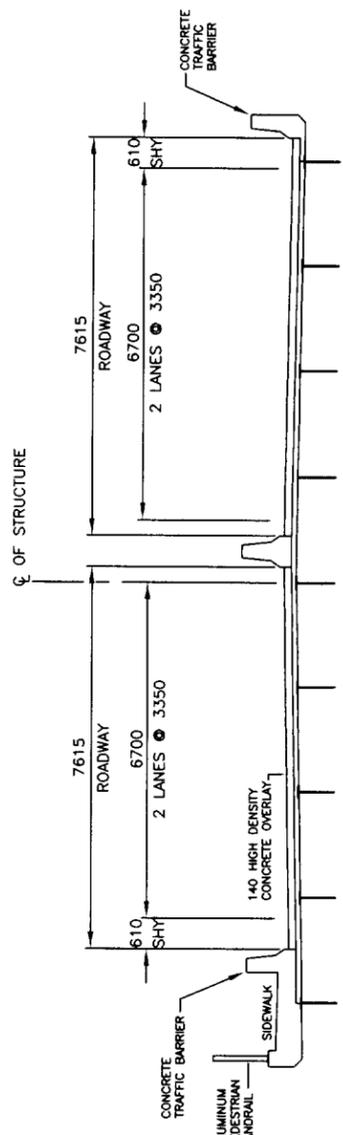


TYPICAL CROSS SECTION
N.T.S.


NOTES:

1. APPROXIMATE QUANTITY TO REPLACE = 220 SQM


NO. REVISIONS	DATE	BY	DESIGNED BY	M.A.T.	DRAWN BY	M.A.T.	CHECKED BY	B.A.N.	APPROVED BY	B.A.N.	AUTOMATICALLY BY	DATE	90 OPPORTUNITY NO. 458 - 2005	ENGINEER'S SEAL		THE CITY OF WINNIPEG PUBLIC WORKS DEPARTMENT ENGINEERING DIVISION	SHEET 1 OF 2 HOR. SCALE: N.T.S. VERTICAL: N.T.S. CITY DRAWING NUMBER 8100-08-01

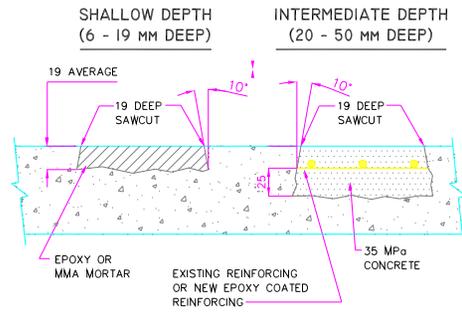


DECK REPAIR DETAILS
N.T.S.

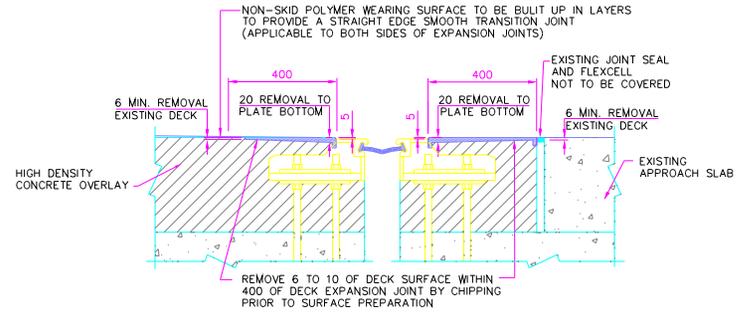

EXPANSION JOINT (TYPICAL)
N.T.S.

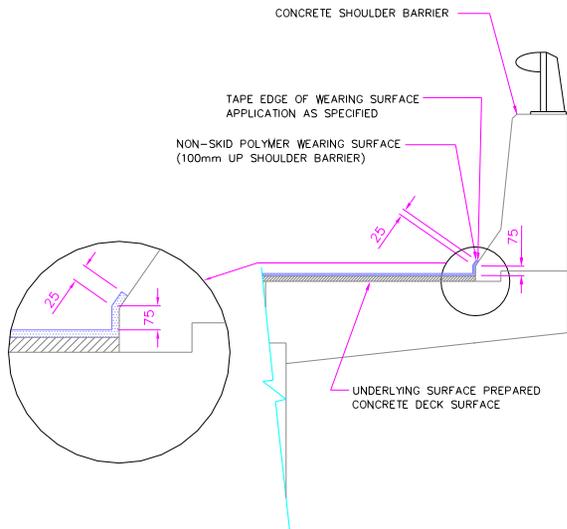


TRAFFIC BARRIER DETAIL (TYPICAL)
N.T.S.

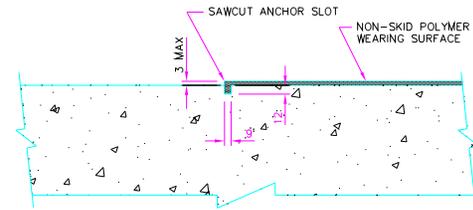

TYPICAL ANCHOR DETAIL
N.T.S.


B.M. ELEV.	DESIGNED BY M.R.T.	ENGINEER'S SEAL		<p>THE CITY OF WINNIPEG PUBLIC WORKS DEPARTMENT ENGINEERING DIVISION</p>	SHEET 2 OF 2		
	DRAWN BY M.R.T.				EMPRESS STREET OVERPASS OVER PORTAGE AVENUE CONCRETE BRIDGE DECK SURFACE SEALING	HOR. SCALE: N.T.S.	
	CHECKED BY B.A.N.					WEARING SURFACE DETAILS	CITY DRAWING NUMBER B100-05-02
	APPROVED BY B.A.N.						
	AUTHORIZED BY	DATE					
NO. REVISIONS	DATE	BY	B.A. NEIRINCK BRIDGE PLANNING & OPERATIONS ENGINEER	BID OPPORTUNITY NO.: 458 - 2005			

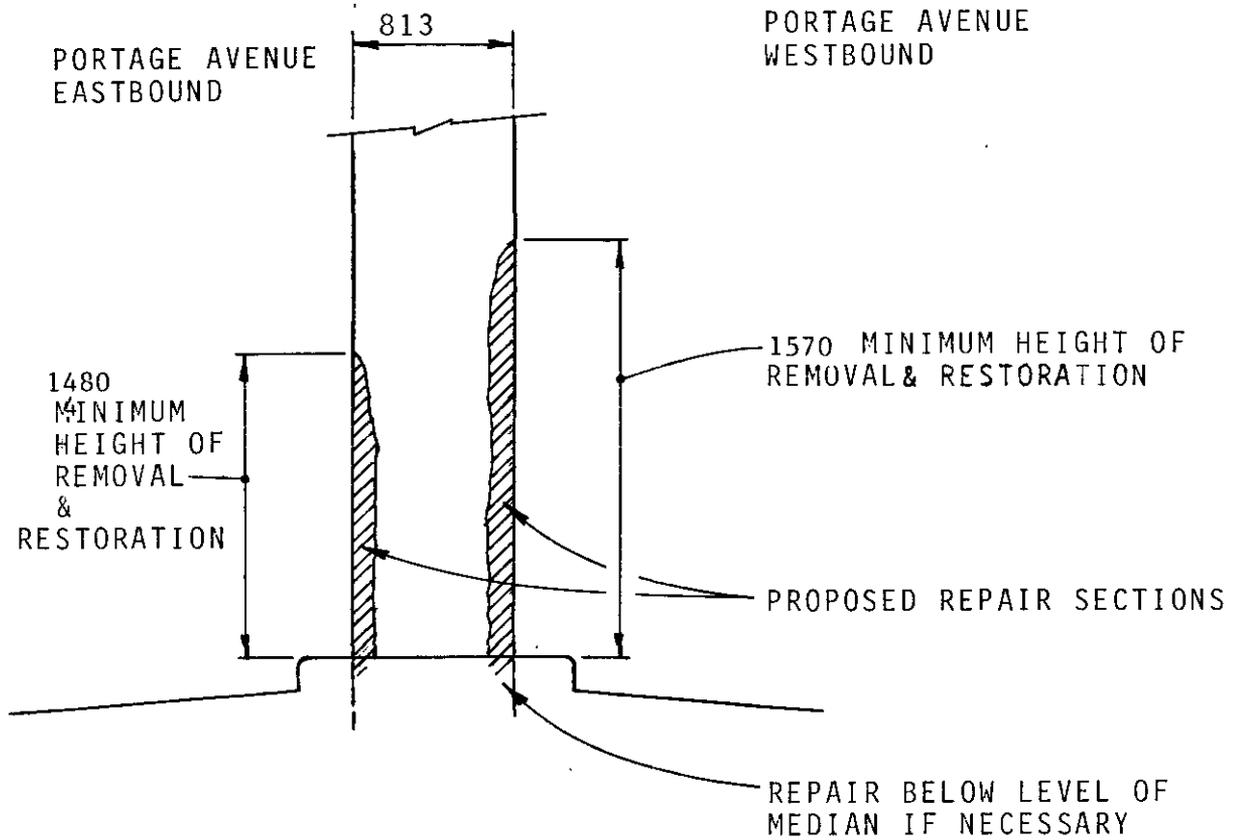

EAST ELEVATION


CENTRE COLUMN
 CENTRE BENT
 N.T.S.

AS BUILT
 APPROVED BY: *R. A. Wiebe*

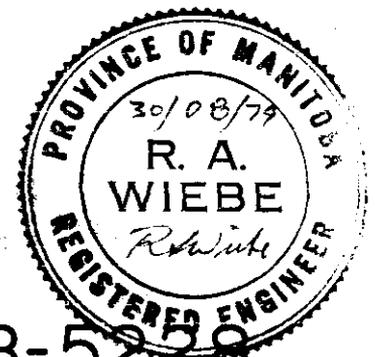

B-5228


 Consulting Engineers & Planners	TITLE <i>EMPRESS ST. OVERPASS AT PORTAGE AVE.</i>	PROJECT NO. MMD: 8584-05
	PROJECT <i>BRIDGE MAINTENANCE-PHASE 7907</i>	DRAWING NO. B100-79-01
DATE AUGUST , 1979		

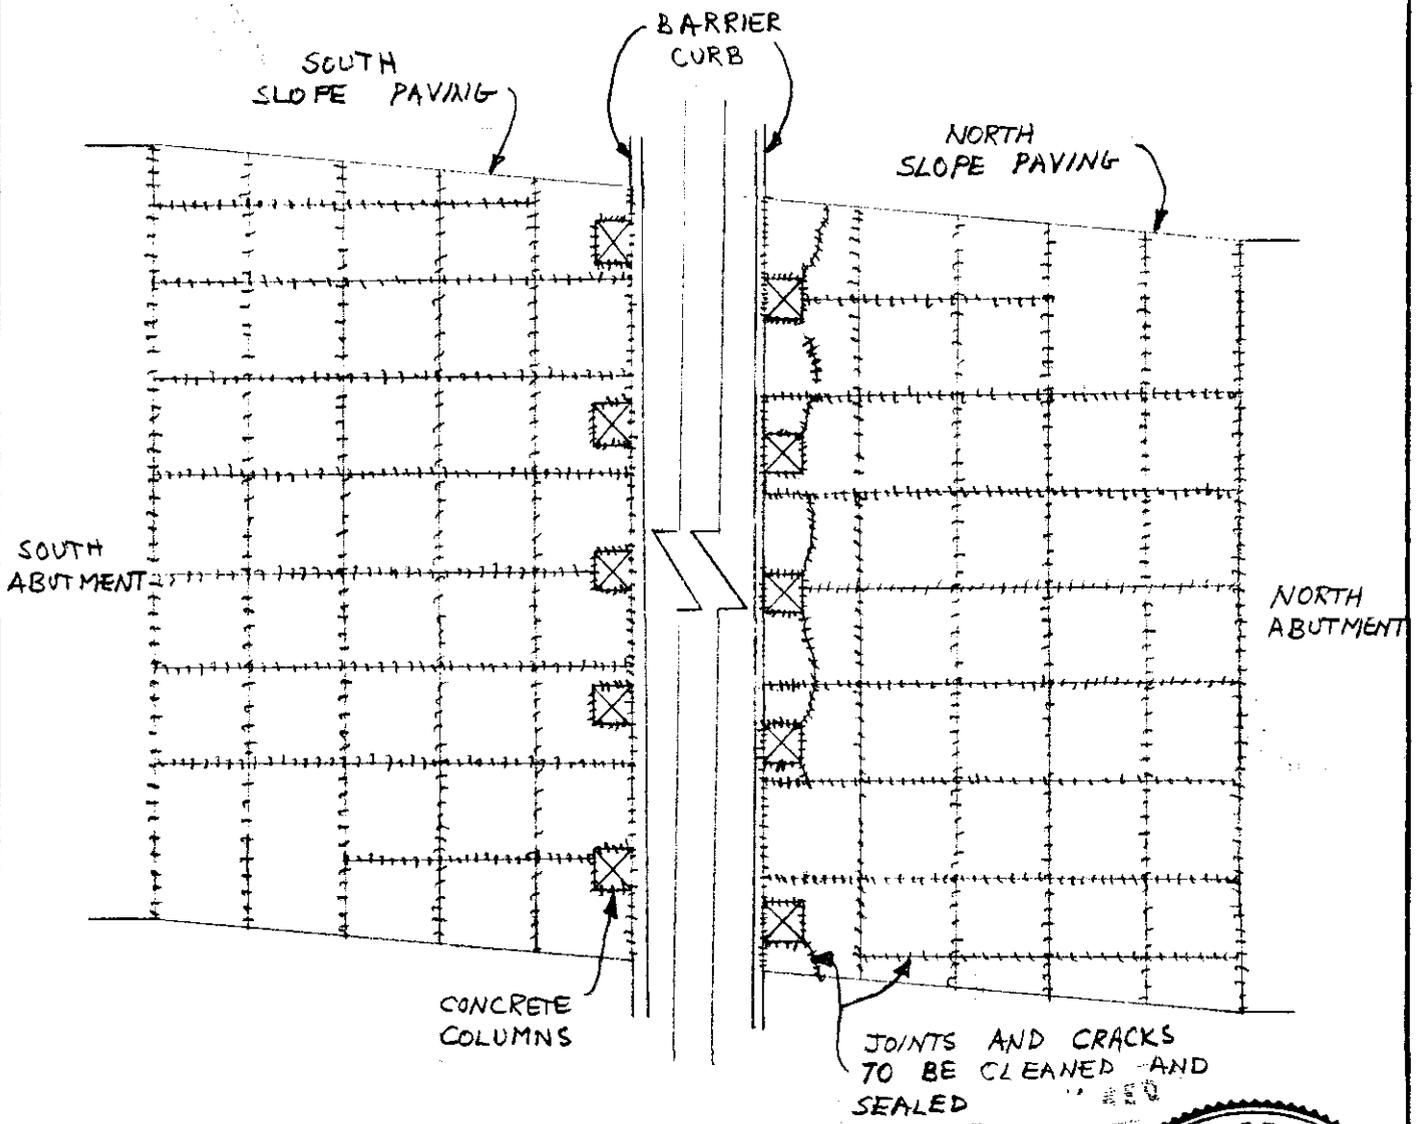

PLAN
N.T.S.

AS BUILT

APPROVED BY: *J. J. [Signature]*

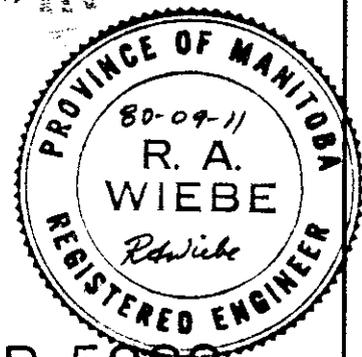


B-5282


CITY OF WINNIPEG ACCEPTED FOR CONST. BY *[Signature]* DATE 81-04-02 M.M. DILLON APPROVED BY *[Signature]* DATE 9 SEP. 80

 <p>Consulting Engineers & Planners</p>	<p>TITLE EMPRESS STREET OVERPASS SLOPE PAVING REPAIRS</p>	<p>PROJECT NO. 8792-04</p>
	<p>PROJECT BRIDGE MAINTENANCE - PHASE 8008</p>	<p>DRAWING NO. B100-81-01</p>


DATE JULY, 1980

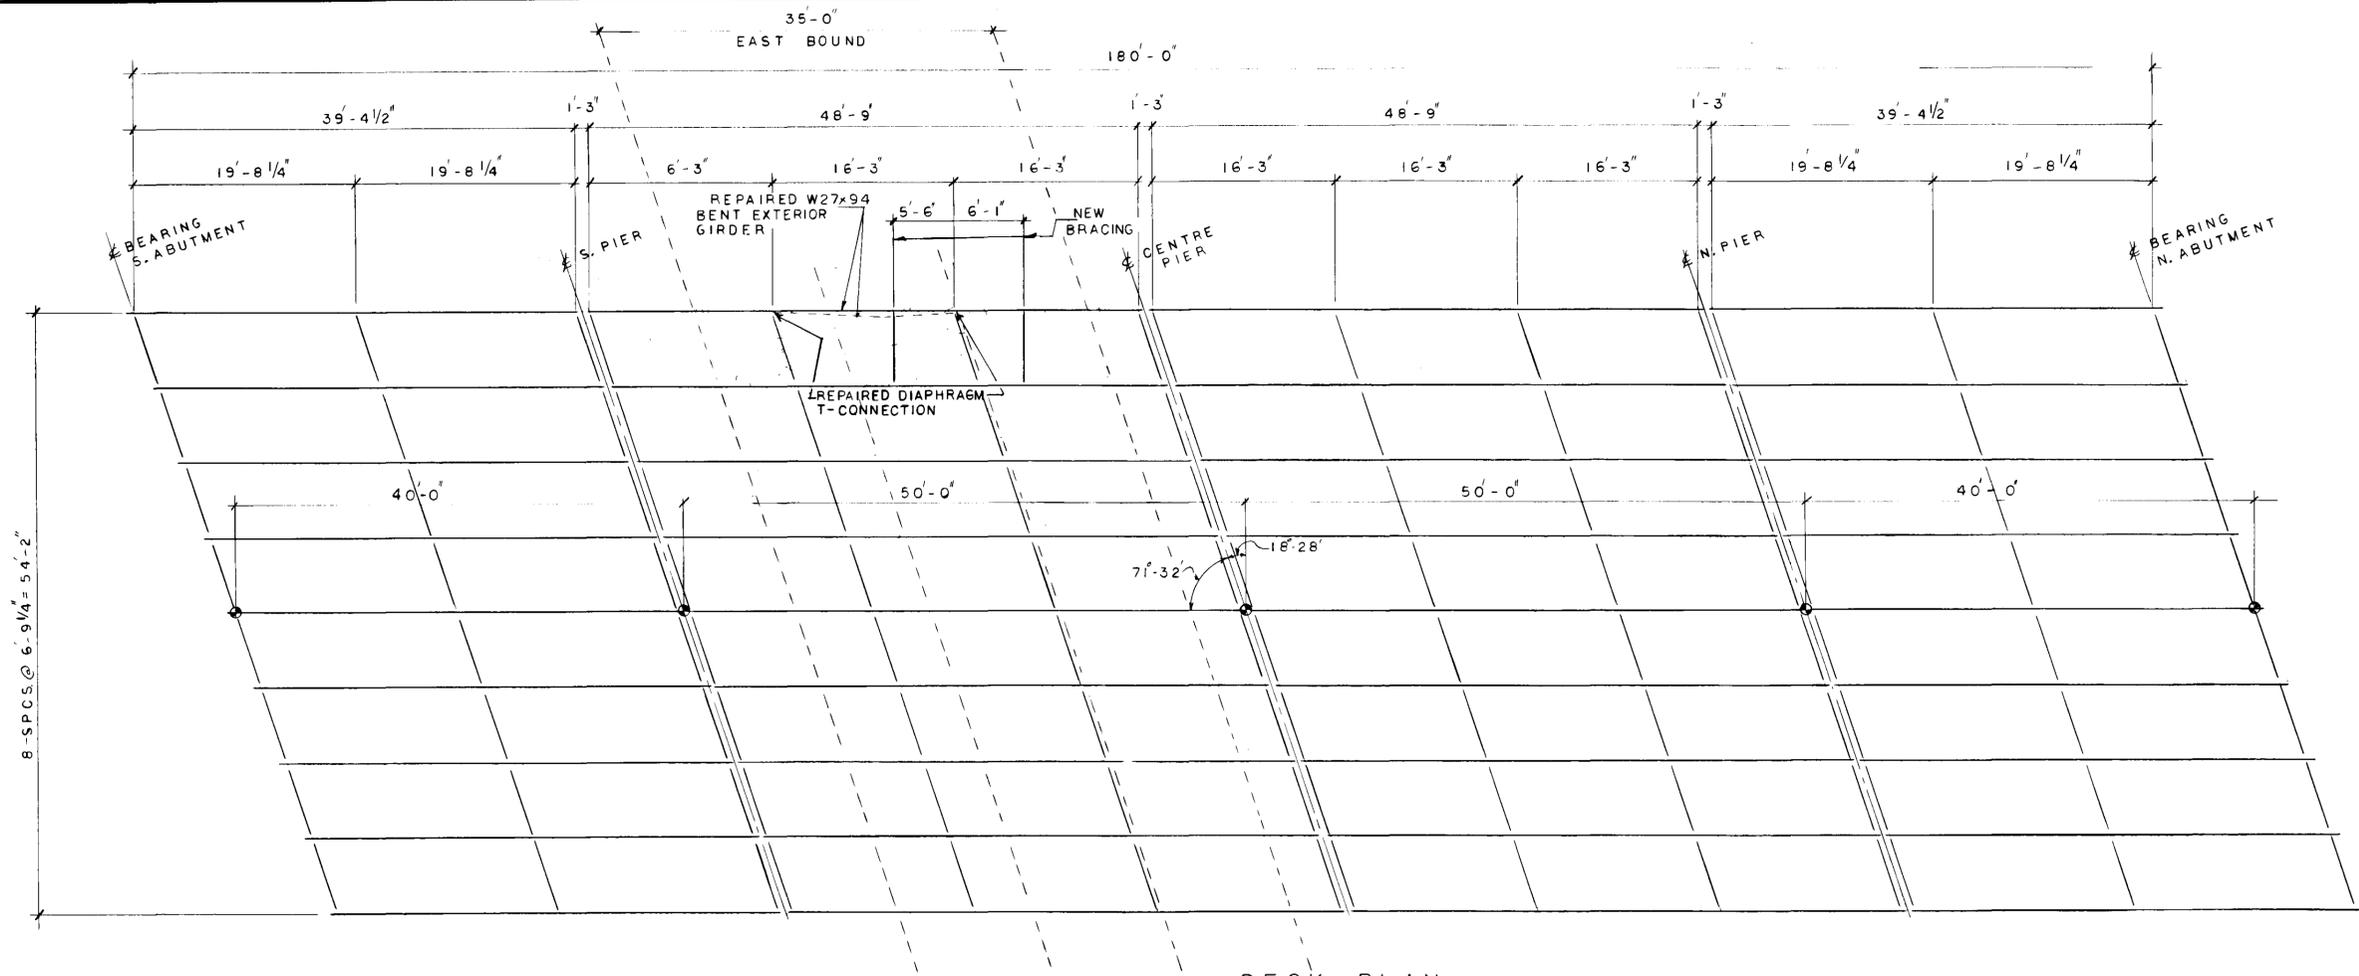

DECK PLAN
S.C. 1/8" = 1'-0"

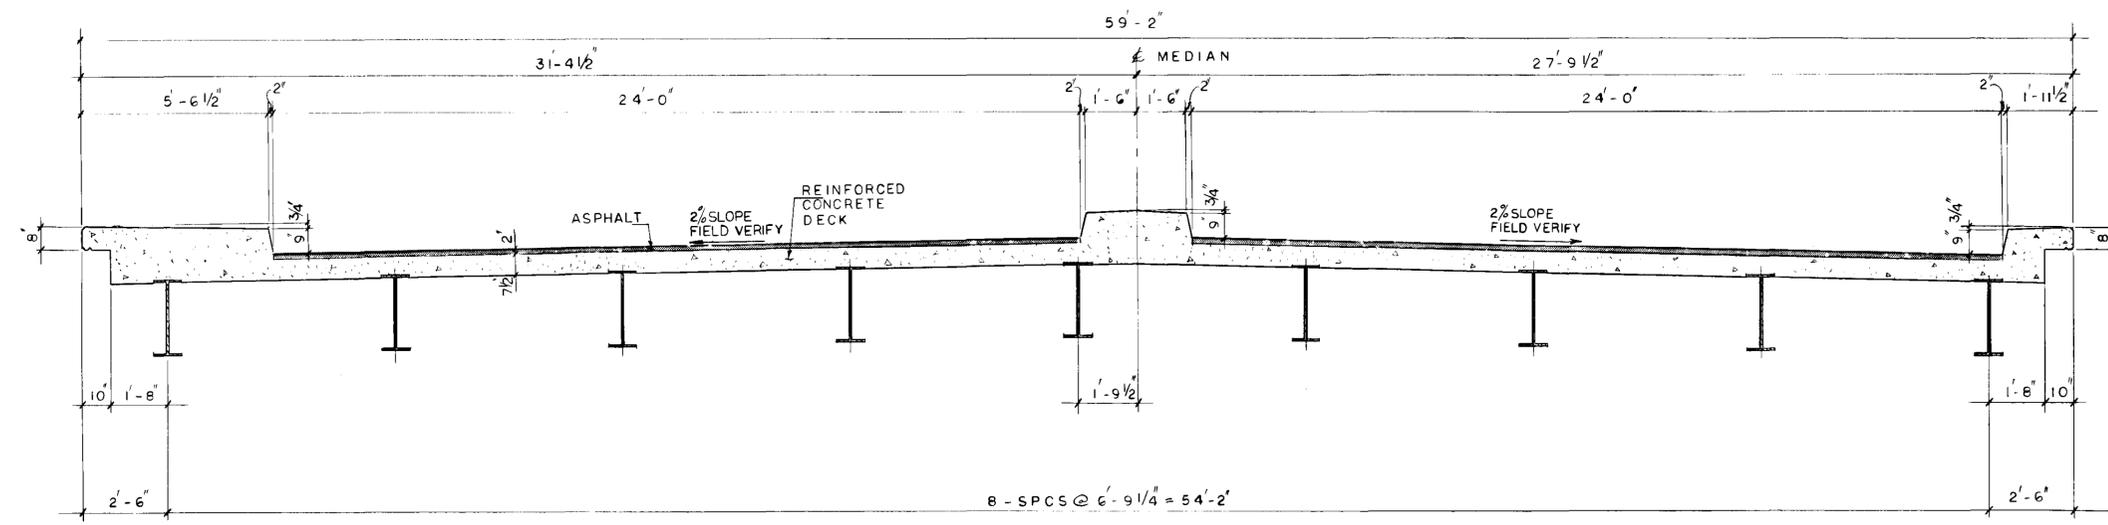

TYPICAL DECK SECTION
S.C. 3/8" = 1'-0"

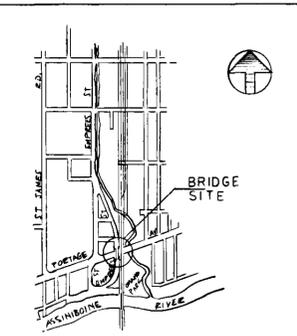

LOCATION PLAN
B-5295-1

NO.	REVISIONS	DATE	APP.
2	DWG. NO.	B20208	
1	AS BUILT	81-12-11	

Nov 6/81
W. J. M.
ENGINEER'S SEAL

Reid, Crowther & Partners Limited
CONSULTING ENGINEERS AND PLANNERS
VANCOUVER · CALGARY · EDMONTON · REGINA · WINNIPEG · TORONTO · OTTAWA
WHITEHORSE · VELL · WINDYFELLS · RED DEER · BRANSON

DESIGNED BY: B.E.
CHECKED BY: W.J.M.
APPROVED BY: *Dr. Charlson*

DRAWN BY: G.A.S.
DATE: 81-10-21
DATE: Nov 6/81

THE CITY OF WINNIPEG
WORKS & OPERATIONS DIVISION
STREETS & TRANSPORTATION DEPARTMENT

EMPRESS ST. AND PORTAGE AV. OVERPASS
1981 COLLISION REPAIRS

AUTHORIZED BY: *John P. Day* 1981-11-06
BRIDGE ENGINEER DATE:

ACCEPTED BY: *RA*
BRIDGE INSPECTOR DATE:

SCALE: AS SHOWN
DRAWING NO. B100-81-02


PLANS OF PROPOSED POLO PARK OVERPASS OVER PORTAGE AVENUE ON EMPRESS STREET (EAST)

LENGTH: 179'-11 1/4" o.c. ABUTMENTS
 SUPERSTRUCTURE: FOUR SPAN SIMPLY SUPPORTED STEEL BEAMS
 COMPOSITE WITH REINFORCED CONCRETE DECK
 SUBSTRUCTURE: REINFORCED CONCRETE ABUTMENTS & PIERS
 ON PILES
 ROADWAY WIDTH: 24'-0" CL BETWEEN CURB & MEDIAN
 NORTH & SOUTHBOUND LANES 3'-0" MEDIAN
 LOCATION: LOT 44 PARISH OF ST. JAMES

SUMMARY OF QUANTITIES FOR CONTRACT

1 BANK SILT EXCAVATION	NORTH ----- 2900 CU.YDS. SOUTH ----- 1974 CU.YDS. TOTAL = 4874 CU.YDS.
2 EMBANKMENT FILLS	NORTH APPROACH ----- 5380 CU.YDS. SOUTH APPROACH ----- 4975 CU.YDS. TOTAL = 10355 CU.YDS.
3 EXCAVATION	3 PIERS (UP TO EXISTING GRADE)
4 SUPPLY & DRIVING PRECAST CONCRETE PILES	30-28'-0" 12" HEXAGONAL PILES ----- 840 LIN.FT. 30-30'-0" 12" HEXAGONAL PILES ----- 900 LIN.FT. 30-28'-0" 12" HEXAGONAL PILES ----- 840 LIN.FT. 11-48'-0" 12" HEXAGONAL PILES ----- 528 LIN.FT. 7-50'-0" 12" HEXAGONAL PILES ----- 350 LIN.FT. 11-48'-0" 12" HEXAGONAL PILES ----- 528 LIN.FT. 7-50'-0" 12" HEXAGONAL PILES ----- 350 LIN.FT. TOTAL = 4336 LIN.FT.
5 STRUCTURAL CONCRETE	ABUTMENTS ----- 142.4 CU.YDS. PIER FOOTINGS ----- 225.3 CU.YDS. PIER SHAFTS ----- 120.0 CU.YDS. DECK INCLUDING ----- 320.8 CU.YDS. TOTAL = 808.5 CU.YDS.
6 REINFORCING STEEL	ABUTMENTS ----- 7804.0 LBS. PIER INCLUDING FOOTINGS, COLUMNS & BEAMS ----- 54274.4 LBS. DECK ----- 60348.2 LBS. TOTAL = 122426.6 LBS.
7 ELECTRICAL	3" RIGID GALVANIZED STEEL CONDUIT ----- 124 LIN.FT. 2" RIGID GALVANIZED STEEL CONDUIT ----- 181 LIN.FT. EXPANSION SLEEVES ----- 5 UNITS
8 STRUCTURAL STEEL	GIRDERS & MISC. FRAMING ----- 105 TONS BEARING PLATES & ANCHOR BOLTS ----- 12000 LBS.
9 MISCELLANEOUS	STAIR UNITS INCLUDING LANDING ----- 2 UNITS SILICONE WATERPROOFING ----- 9550 SQ.FT. RUB. FINISHING CONCRETE ----- 8650 SQ.FT. GUARDRAIL SUPPLY & INSTALL ----- 370 LIN.FT. PAINT (STEEL & METAL WORK 2 COATS) ----- LUMP SUM PRICE HANDRAIL SUPPLY & INSTALL ----- 360 LIN.FT.

IN THE
CITY OF WINNIPEG

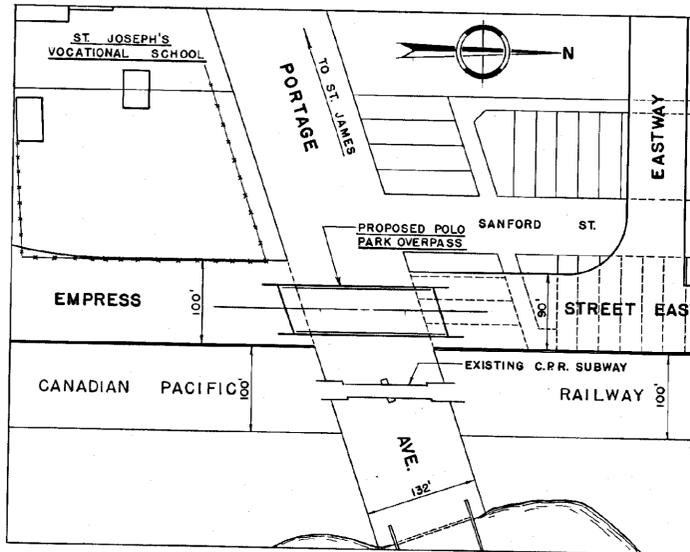

LOCATION PLAN

CITY OF WINNIPEG
ENGINEERING DEPARTMENT

W. L. WARDROP & ASSOCIATES
MANAGEMENT (LTD.)
ENGINEERING CONSULTANTS
WINNIPEG CANADA PORT ARTHUR

SHEET LEGEND

- 0 COVER SHEET
- 1 LOCATION OF EXISTING SERVICES & CENTRELINE PROFILE
- 2 DECK PLAN & ELEVATION OF STRUCTURE
- 3 FOUNDATION & PILE DETAILS
- 4 ABUTMENT DETAILS
- 5 PIER DETAILS
- 6 SUBSTRUCTURE DETAILS
- 7 BEARING PLATE LAYOUT & DETAILS
- 8 STRUCTURAL STEEL LAYOUT & DETAILS
- 9 EXPANSION ELECTRICAL & DECK DETAILS
- 10 DECK REINFORCING LAYOUT
- 11 GUARDRAIL & STAIR DETAILS

BAR BENDING DETAILS
SHEETS 1 TO 4 (INCLUSIVE)

DESIGN DATA

UNIT STRESSES

f_s 20,000 P.S.I. f'_c 3000 P.S.I.
 f_c 1,200 P.S.I. $n = 10$

LIVE LOADING

H-20 S-16 44 TRUCK & LANE LOADING

SPECIFICATIONS

C.S.A. S-6 1952
A.A.S.H.O. SIXTH EDITION


SOIL INFORMATION FOR PILE FOUNDATION

BOTTOM OF PIERS & ABUTS. TO ELEVATION AS SHOWN ON PLANS
 SOIL INFORMATION INDICATES THAT REFUSAL IS AT APPROXIMATE
 ELEV. 694.00 TO 696.50

REVISIONS			
No.	DESC.	DATE	BY
1	OVERALL LENGTH	7/31/58	T.O.


B-5072-1

JULY 31, 1958 PLAN NO. 5868 (0)

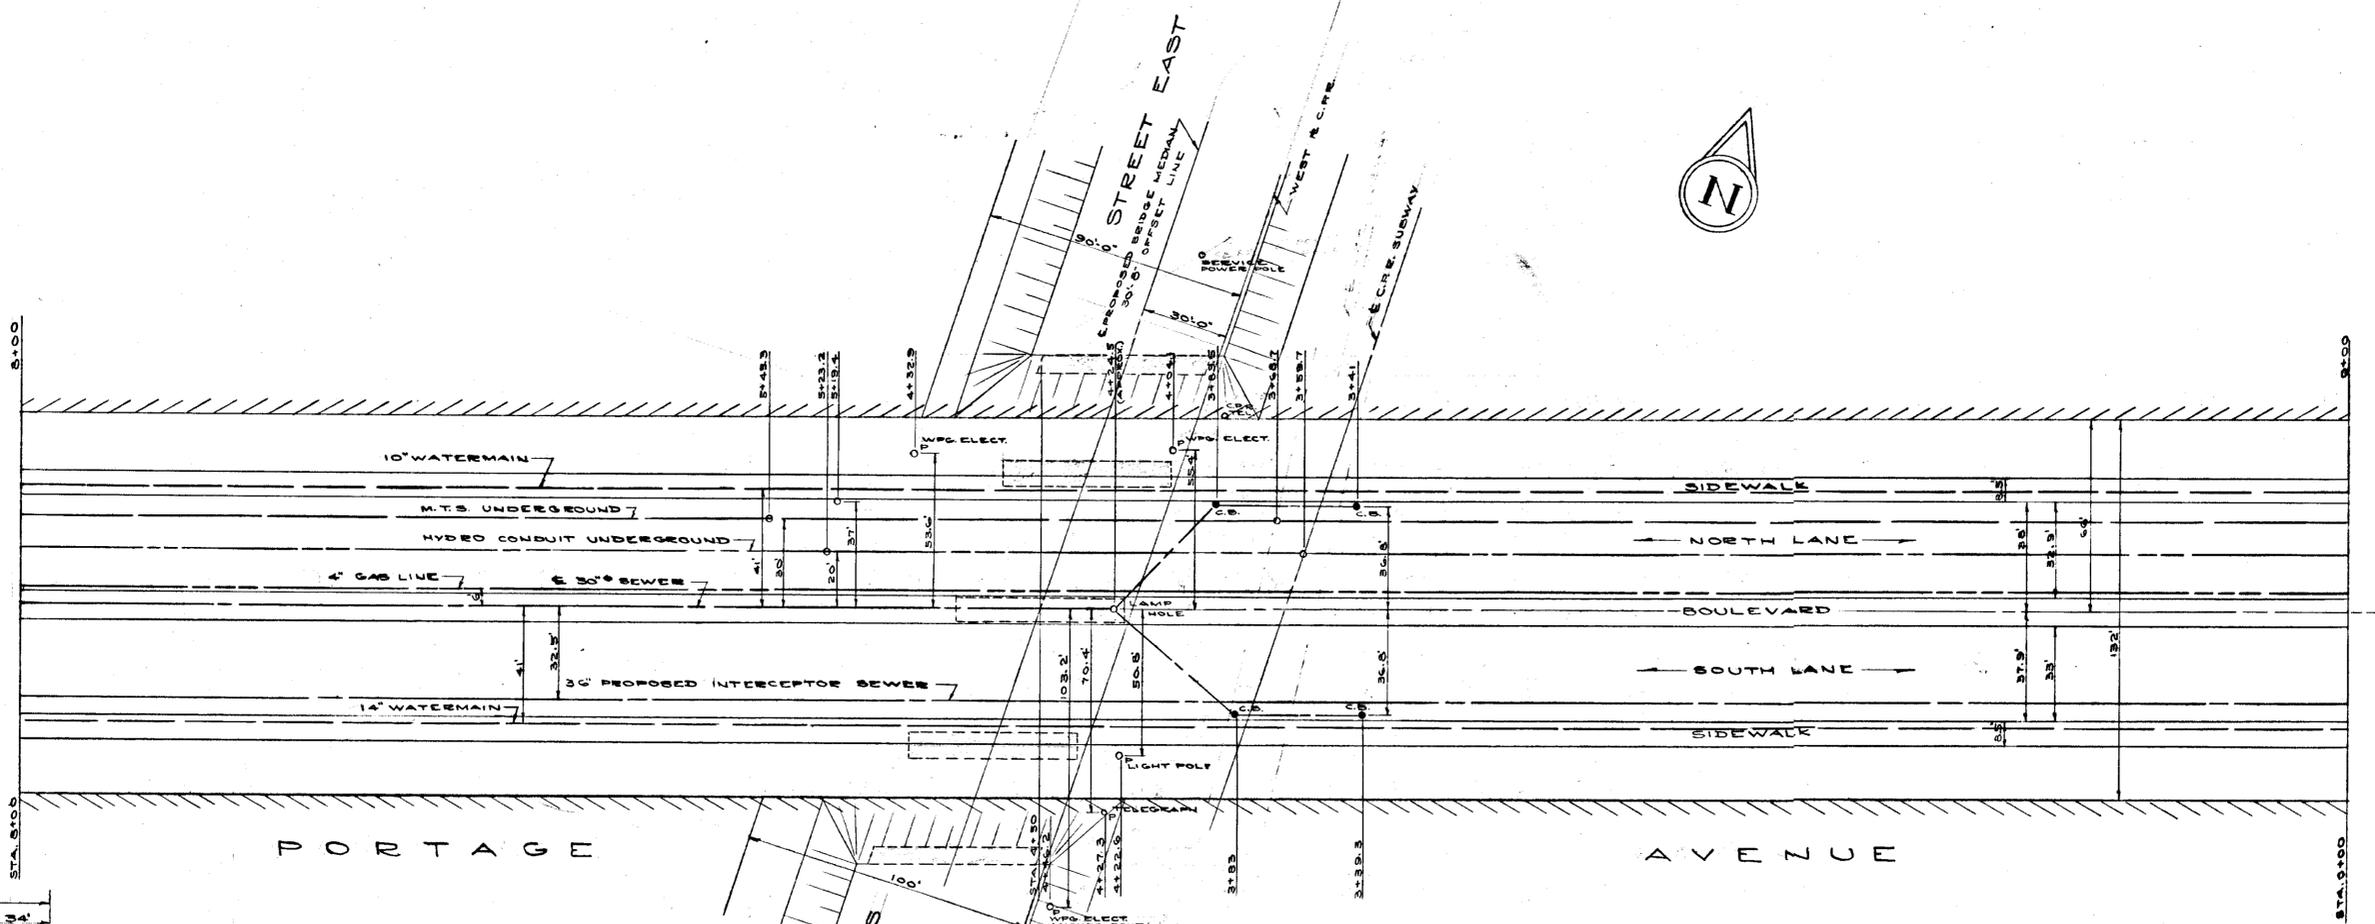


PLAN OF EXISTING SERVICES
SCALE: 1" = 30'-0"


BENCH MARK DESCRIPTION
A BRASS PLUG SET IN CONCRETE 0.85 FEET NORTH OF SOUTH HANDRAIL AND 23.8 FEET WEST OF EAST END OF SOUTH HANDRAIL. ELEVATION 733.147 CITY DATUM.

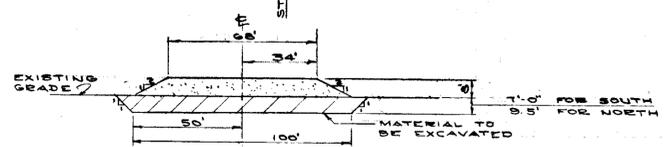

SECTION A-A
ALL DIMENSIONS APPROX.
SCALE: 1" = 40'

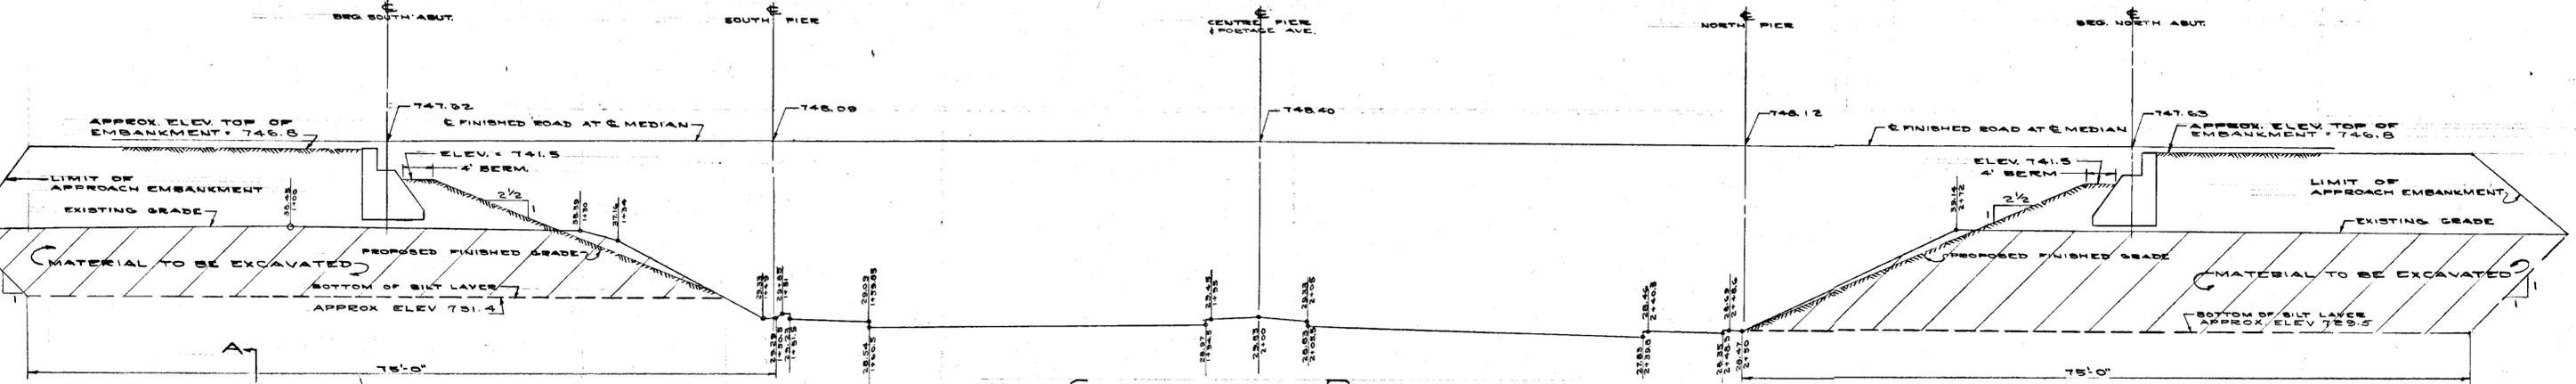

CENTRELINE PROFILE
SCALE: 1/2" = 1'-0"

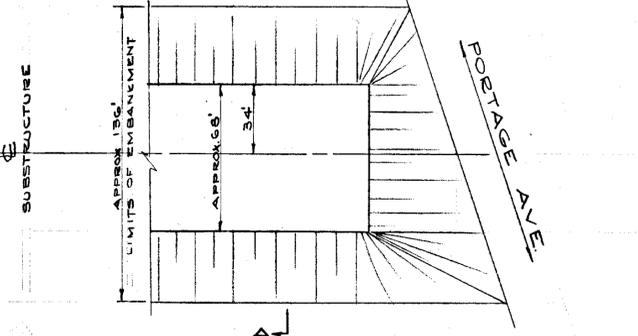

PLAN OF SOUTH EMBANKMENT
NORTH EMBANKMENT SIMILAR
SCALE: 1" = 40'-0"

- GENERAL NOTES**
- OVERPASS CONTRACTOR TO EXCAVATE LAYER OF UNDESIRABLE MATERIAL AT EACH END OF STRUCTURE. THIS LAYER IS APPROXIMATELY 3'-0" DEEP AT NORTH APPROACH AND 7'-0" DEEP AT SOUTH APPROACH.
 - AREA OF UNDESIRABLE MATERIAL TO BE EXCAVATED AS PER SKETCH SHOWN ON THIS SHEET. BACKFILL WITH APPROVED STRIPPING MATERIAL FROM BIRDS HILL COMPACTED AS SPECIFIED UNDER EXCAVATION SPECIFICATIONS.
 - APPROACH EMBANKMENT CONSTRUCTION TO BE COMPLETED UP TO UNDERSIDE OF ABUTMENTS BEFORE ABUTMENT CONSTRUCTION COMMENCES. REMAINDER OF APPROACH EMBANKMENT TO BE COMPLETED AFTER ABUTMENTS ARE CONSTRUCTED.
 - OVERPASS CONTRACTOR TO FILL TO FINISHED GRADES OF STRUCTURE AND TRIM ALL SLOPES TO THE LINES AND GRADES SHOWN.
 - STEEL SHEET PILING SHALL BE USED ON THE SIDES OF ALL PIER FOOTING EXCAVATIONS TO PREVENT SETTLEMENT OF PAVING AND ON PORTAGE AVENUE. REMOVE SHEET PILING AFTER CONCRETE IS PLACED IN PIERS.
 - ALL OVERHEAD LINES AND POLES TO BE RELOCATED WHERE NECESSARY BY OTHERS.
 - EMBANKMENT TOPSOIL & SODDING TO BE PLACED BY THE CITY OF WINNIPEG.

REVISIONS			
NO.	DESC.	DATE	BY
1	SECTION A-A CHANGED	1958	T.O.




B-5072-2

W. L. WARDROP & ASSOCIATES
(MANAGEMENT) LTD.
ENGINEERING CONSULTANTS
WINNIPEG CANADA


LOCATION OF EXISTING SERVICES AND CENTRELINE PROFILE

PORTAGE AVENUE OVERPASS DEVELOPMENT
POLO PARK

Scale: AS SHOWN Date: JULY 31, 1958
Designed By: W.W.M. & H.A.K. Project No. 5568
Drawn By: T.O. Drawing No. 1
Checked By: R.W.M., H.A.K., W.W.M.

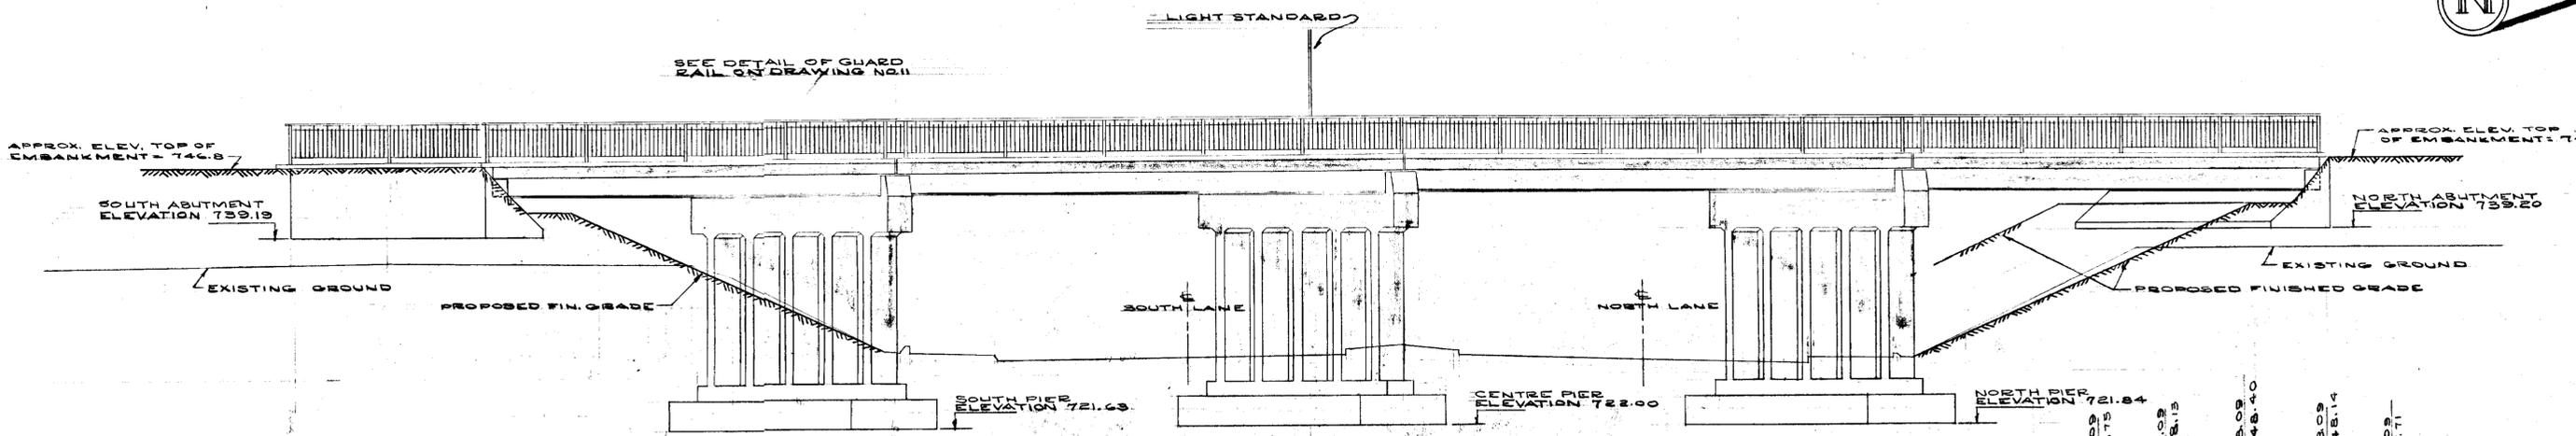


EAST ELEVATION
SCALE 1/8" = 1'-0"

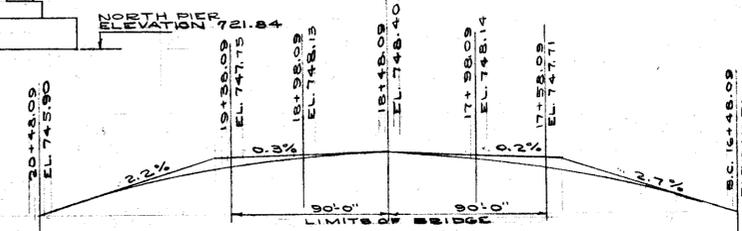

VERTICAL CURVE DATA
SCALE 1" = 50'

NOTE:
FOR PEDESTRIAN WALKWAY
DETAILS SEE DWG. NO. 11
WALKWAYS REQ'D ON BOTH
EMBANKMENTS ON WEST SIDE.

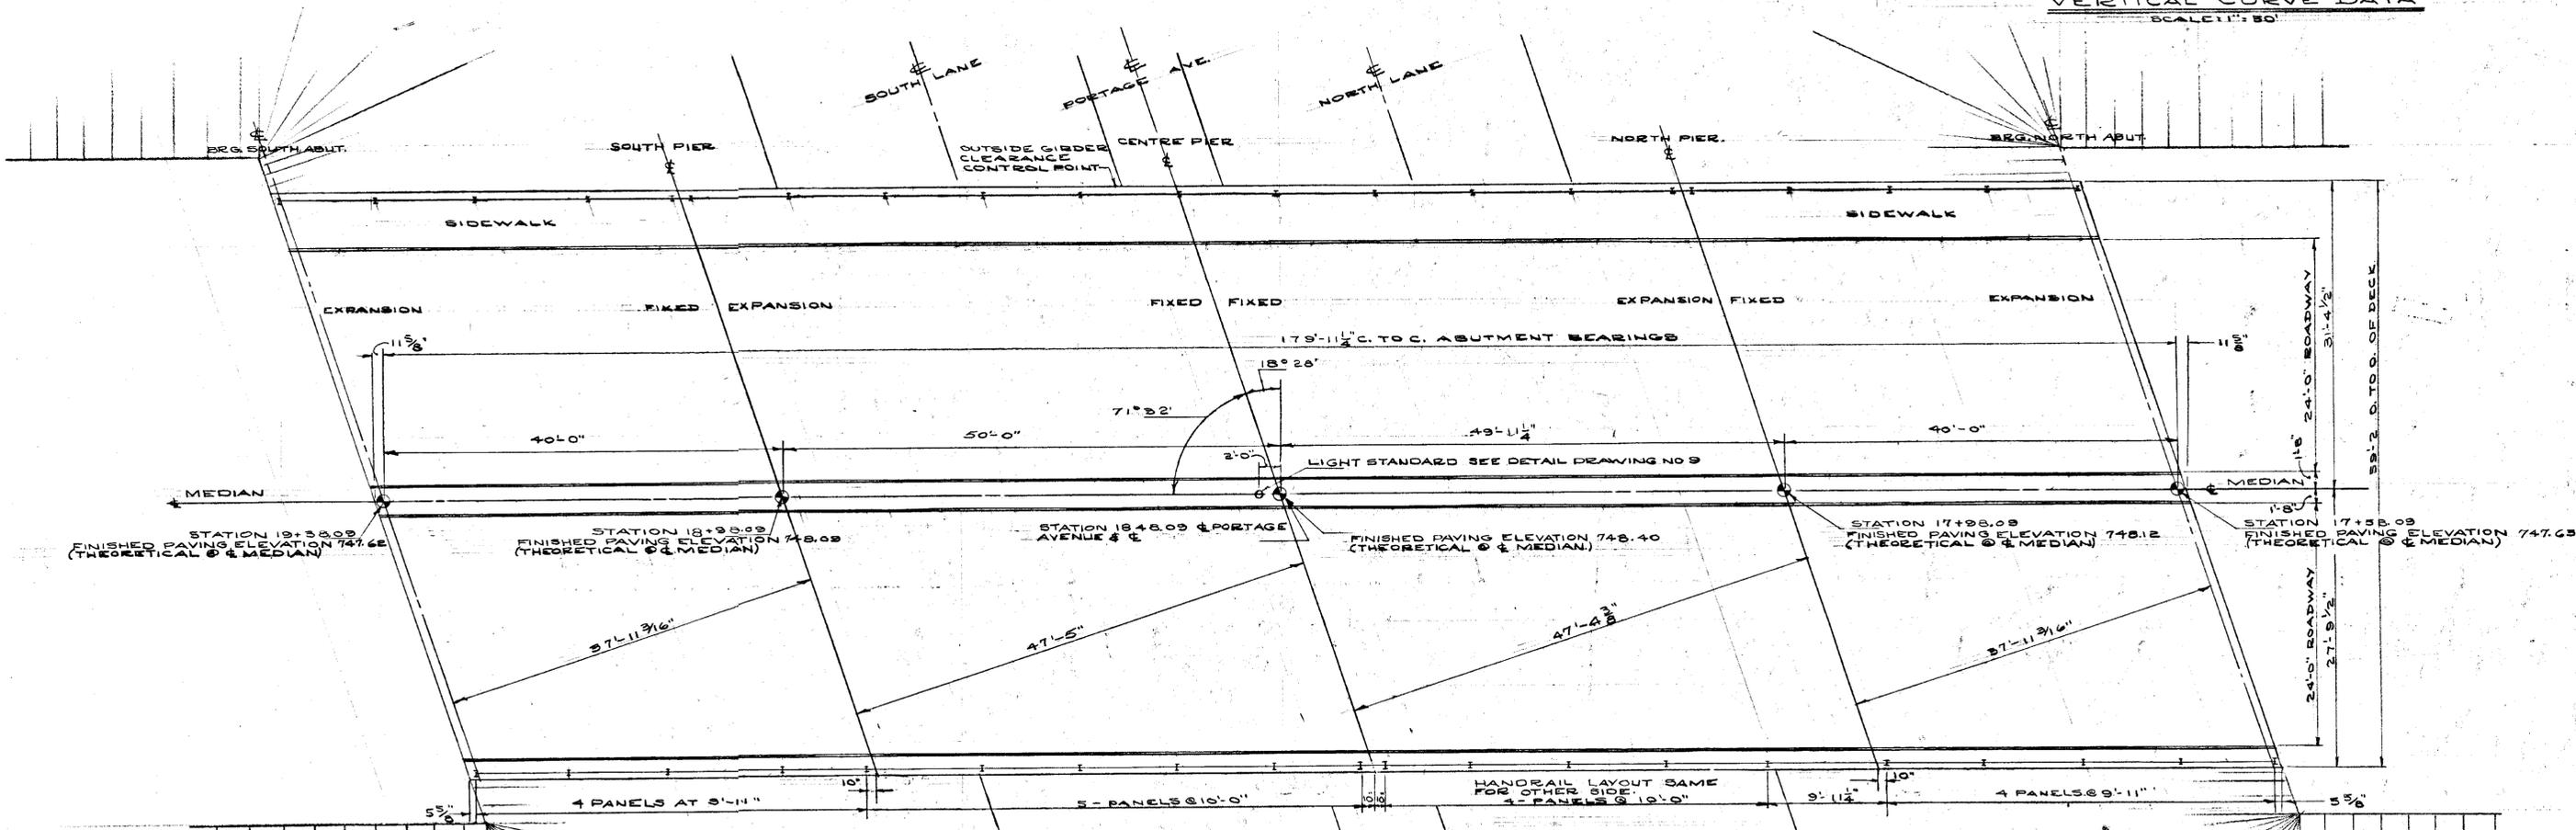

DECK PLAN
SCALE 1/8" = 1'-0"

B-5072-3


REVISIONS			
No.	DESC.	DATE	BY
1.	CHANGED VERTICAL CURVE DATA	AUG 20 1958	T.O.
2.	CHANGED POSITION OF LIGHT ST'D	" "	T.O.
3.	HANDRAIL SPACING CHANGED OVERALL LENGTH	JUNE 1959	T.O.
4.		" "	T.O.




W. L. WARDROP & ASSOCIATES
(MANAGEMENT) LTD.
ENGINEERING CONSULTANTS
WINNIPEG CANADA

DECK PLAN AND ELEVATION OF STRUCTURE
PORTAGE AVENUE OVERPASS
POLO PARK DEVELOPMENT


Scale: AS SHOWN Date: JULY 31 1958
Designed By: R.W.M.K. Project No. 5868
Drawn By: T.O. & A.R. Drawing No. 2
Checked By: R.W.M., N.A.Z., W.C.W.

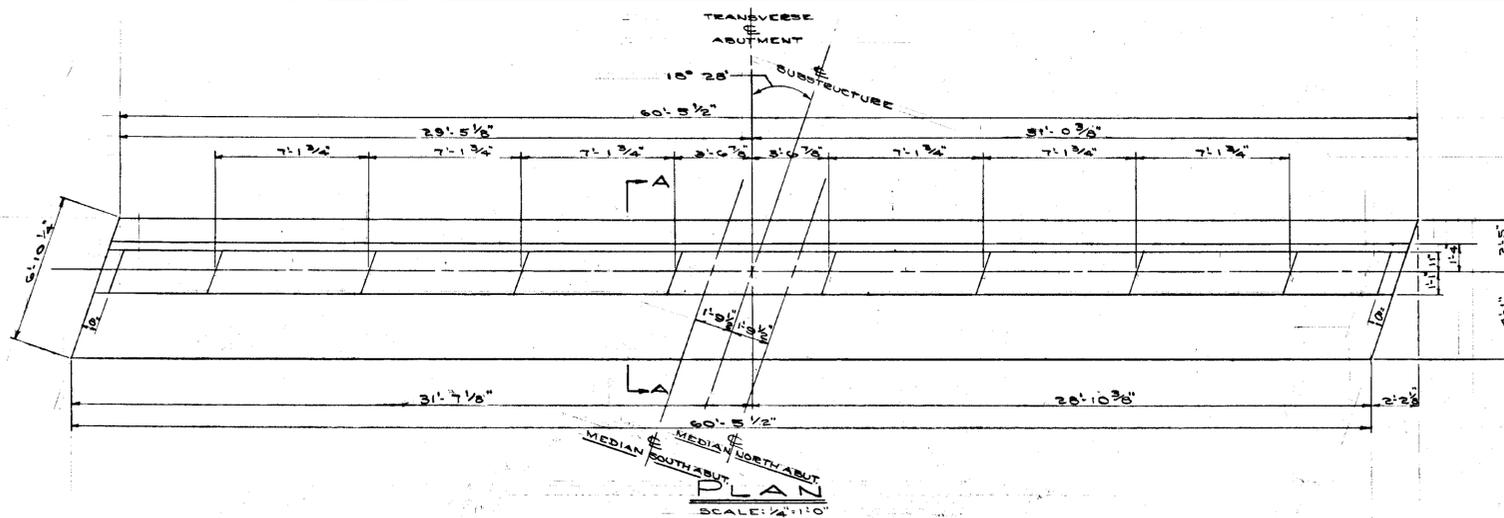


SCALE: 1/4" = 1'-0"

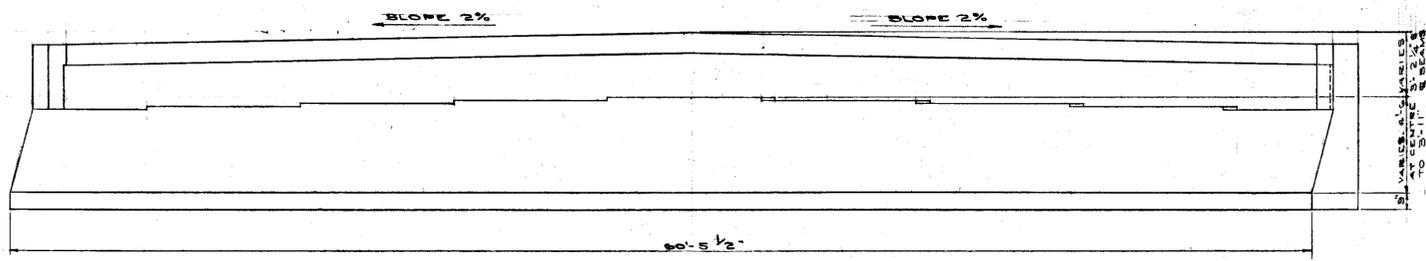

FRONT ELEVATION
SCALE: 1/2" = 1'-0"

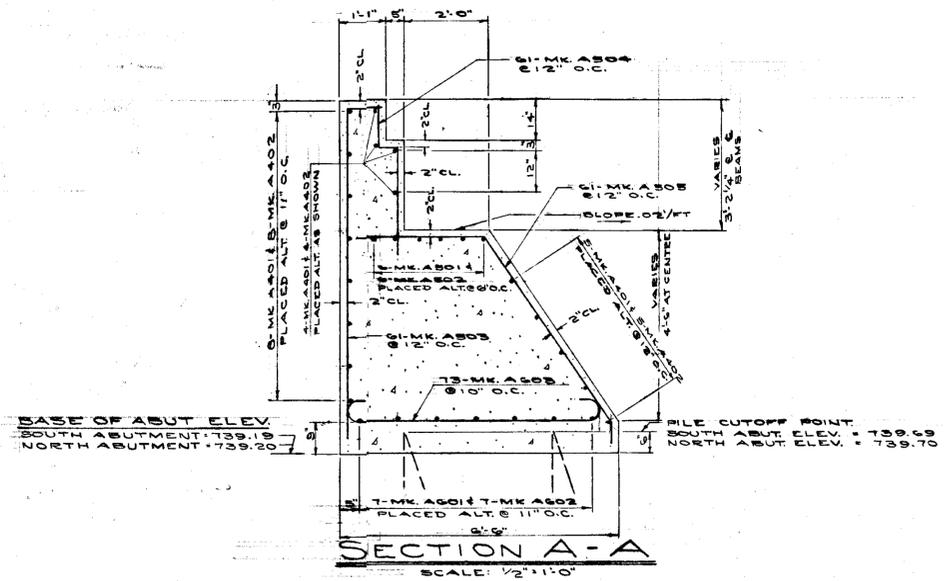


SECTION A-A
SCALE: 1/2" = 1'-0"

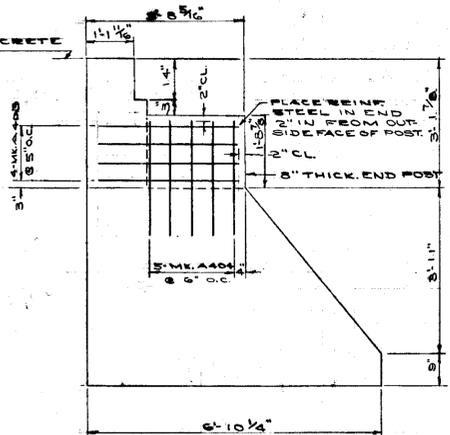

END ELEVATION
SHOWING END POST REINFORCING.
SCALE: 1/2" = 1'-0"

NOTE:
END POSTS TO BE POURED
MONOLITHICALLY WITH
ABUTMENT.

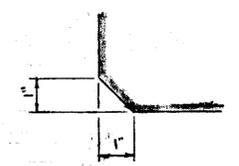

DETAIL OF CHAMFER
ALL EXPOSED EDGES TO BE
CHAMFERED 1"

NOTES:
1. SEE DWG N-3 FOR PILE LAYOUT.
2. ALL EXPOSED CONCRETE SURFACES
ABOVE GROUND SHALL BE RUB FINISHED









B-5072-5

W. L. WARDROP & ASSOCIATES
(MANAGEMENT) LTD.
ENGINEERING CONSULTANTS
WINNIPEG CANADA

ABUTMENT DETAILS
PORTAGE AVENUE OVERPASS
POLO PARK DEVELOPMENT



Scale: AS SHOWN	Date: JULY 31, 1958
Designed By: H. A. K.	Project No. 5868
Drawn By: T. O.	Drawing No. 4
Checked By: R. W. MCKNIGHT, H.E.M.	



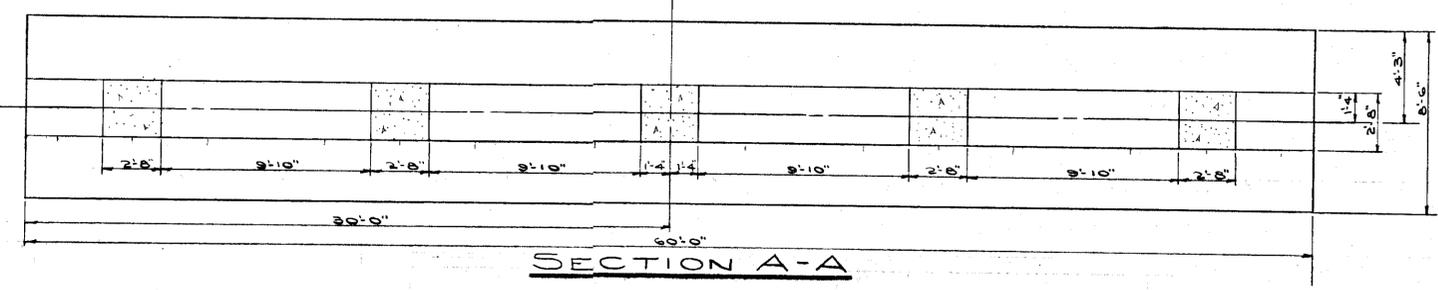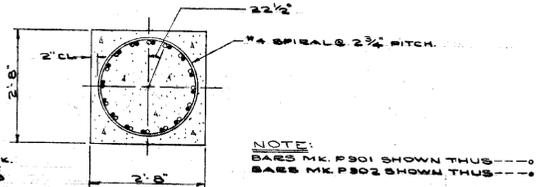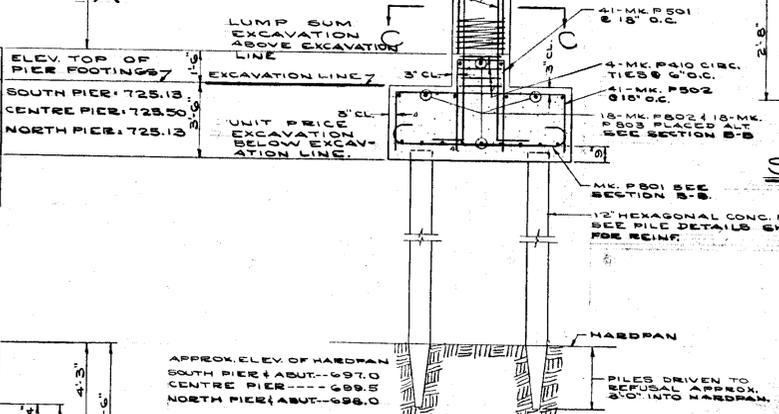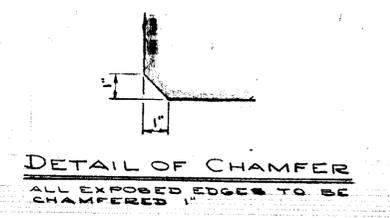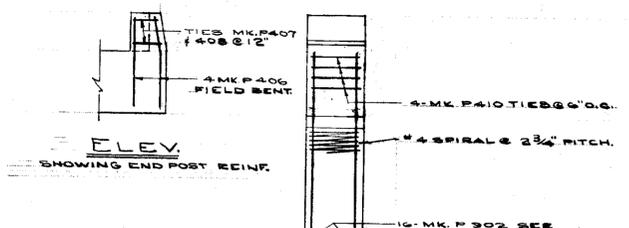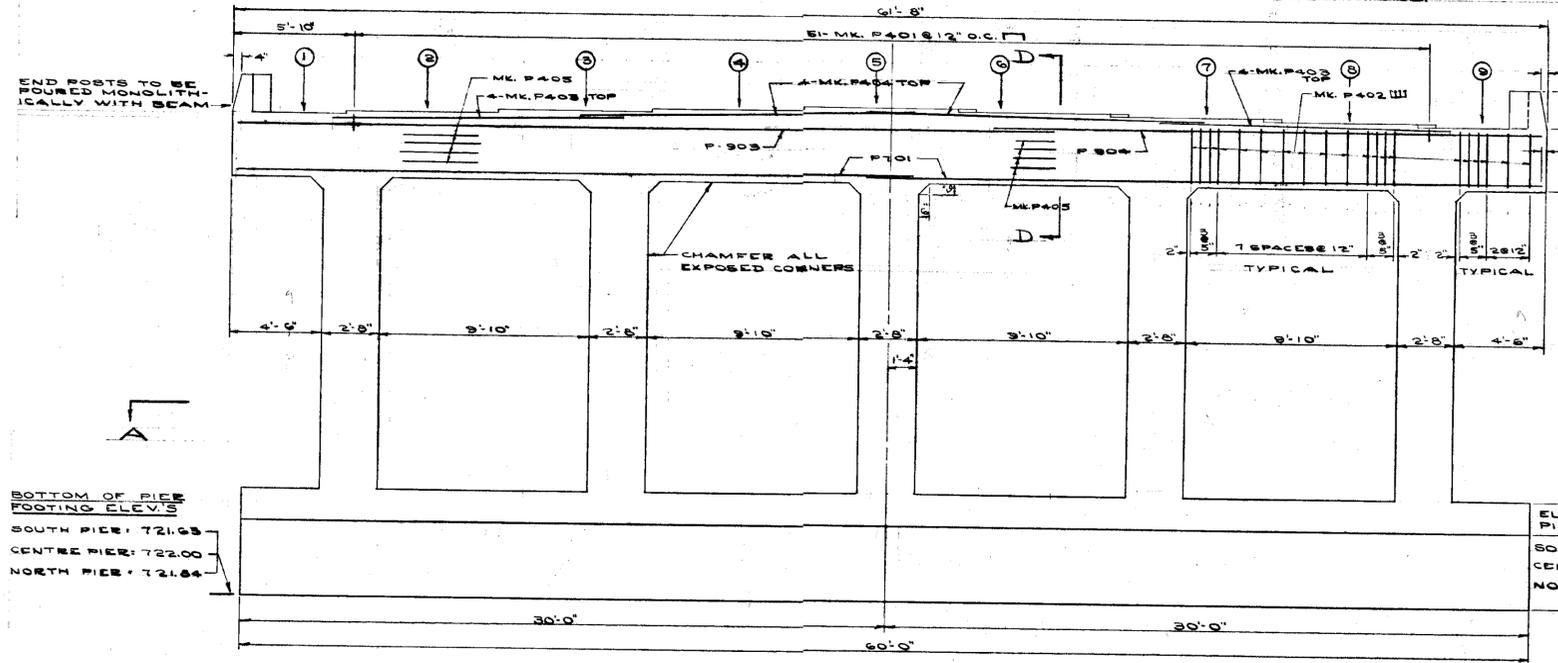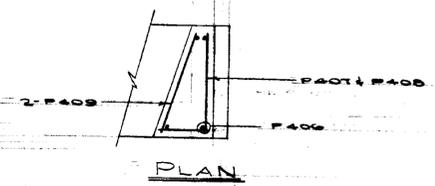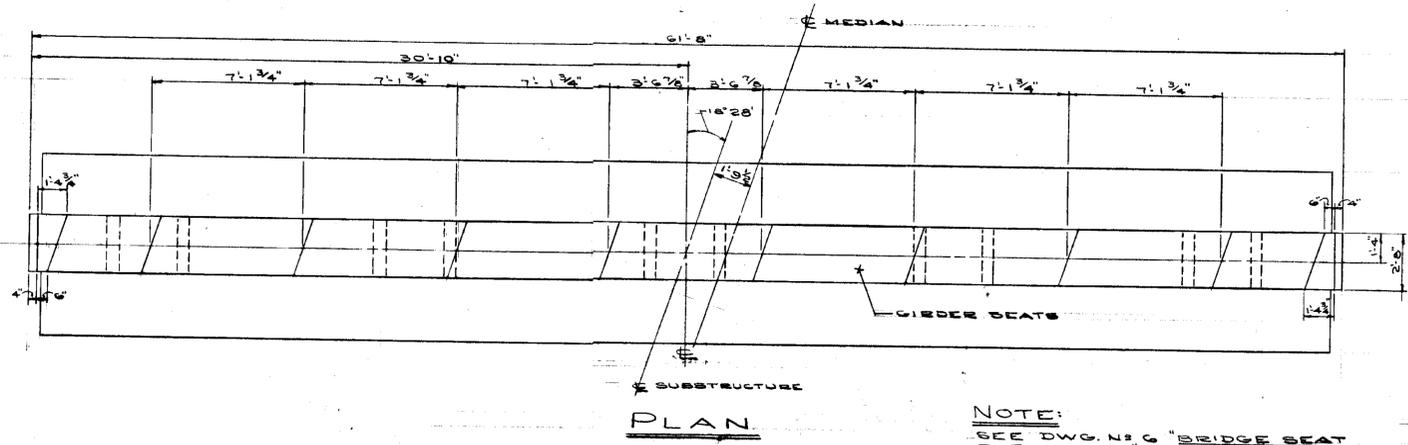

SECTION THRU PIER



DIMENSIONS & REINFORCING STEEL SIMILAR FOR EACH OF THREE PIERS.

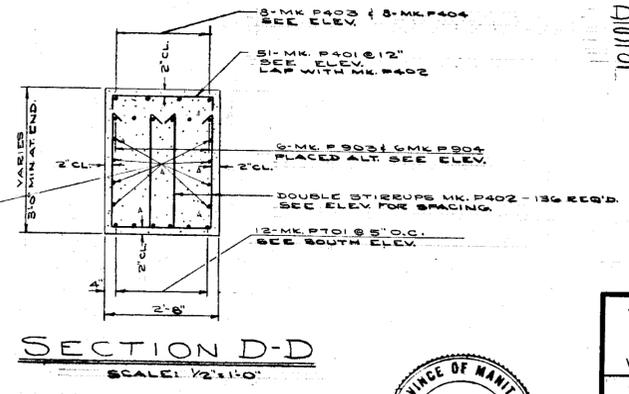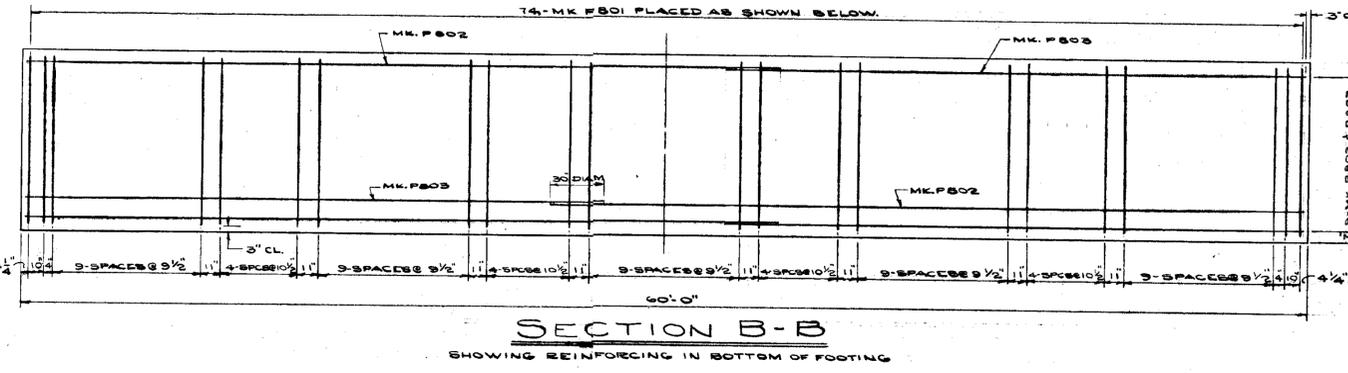


B-5072-6

W. L. WARDROP & ASSOCIATES (MANAGEMENT) LTD. ENGINEERING CONSULTANTS WINNIPEG CANADA	
PIER DETAILS PORTAGE AVENUE OVERPASS POLO PARK DEVELOPMENT	
Scale: 1/4" = 1'-0" UNLESS OTHERWISE NOTED	Date: JULY 31, 1958
Designed By: R.W.M.	Project No. 5868
Drawn By: T.O.	Drawing No. 5
Checked By: R.W.M., N.A., N.S.M.	




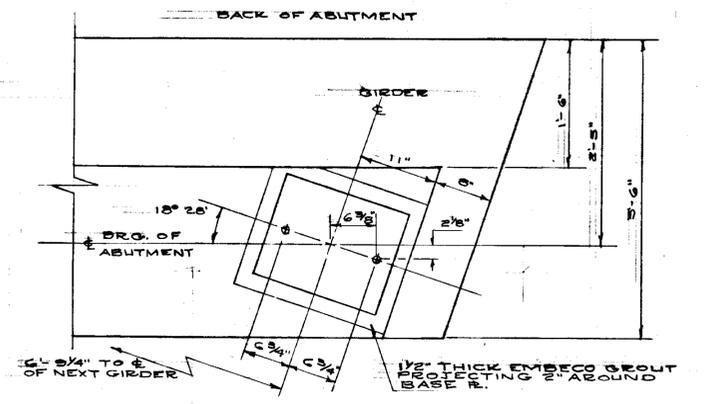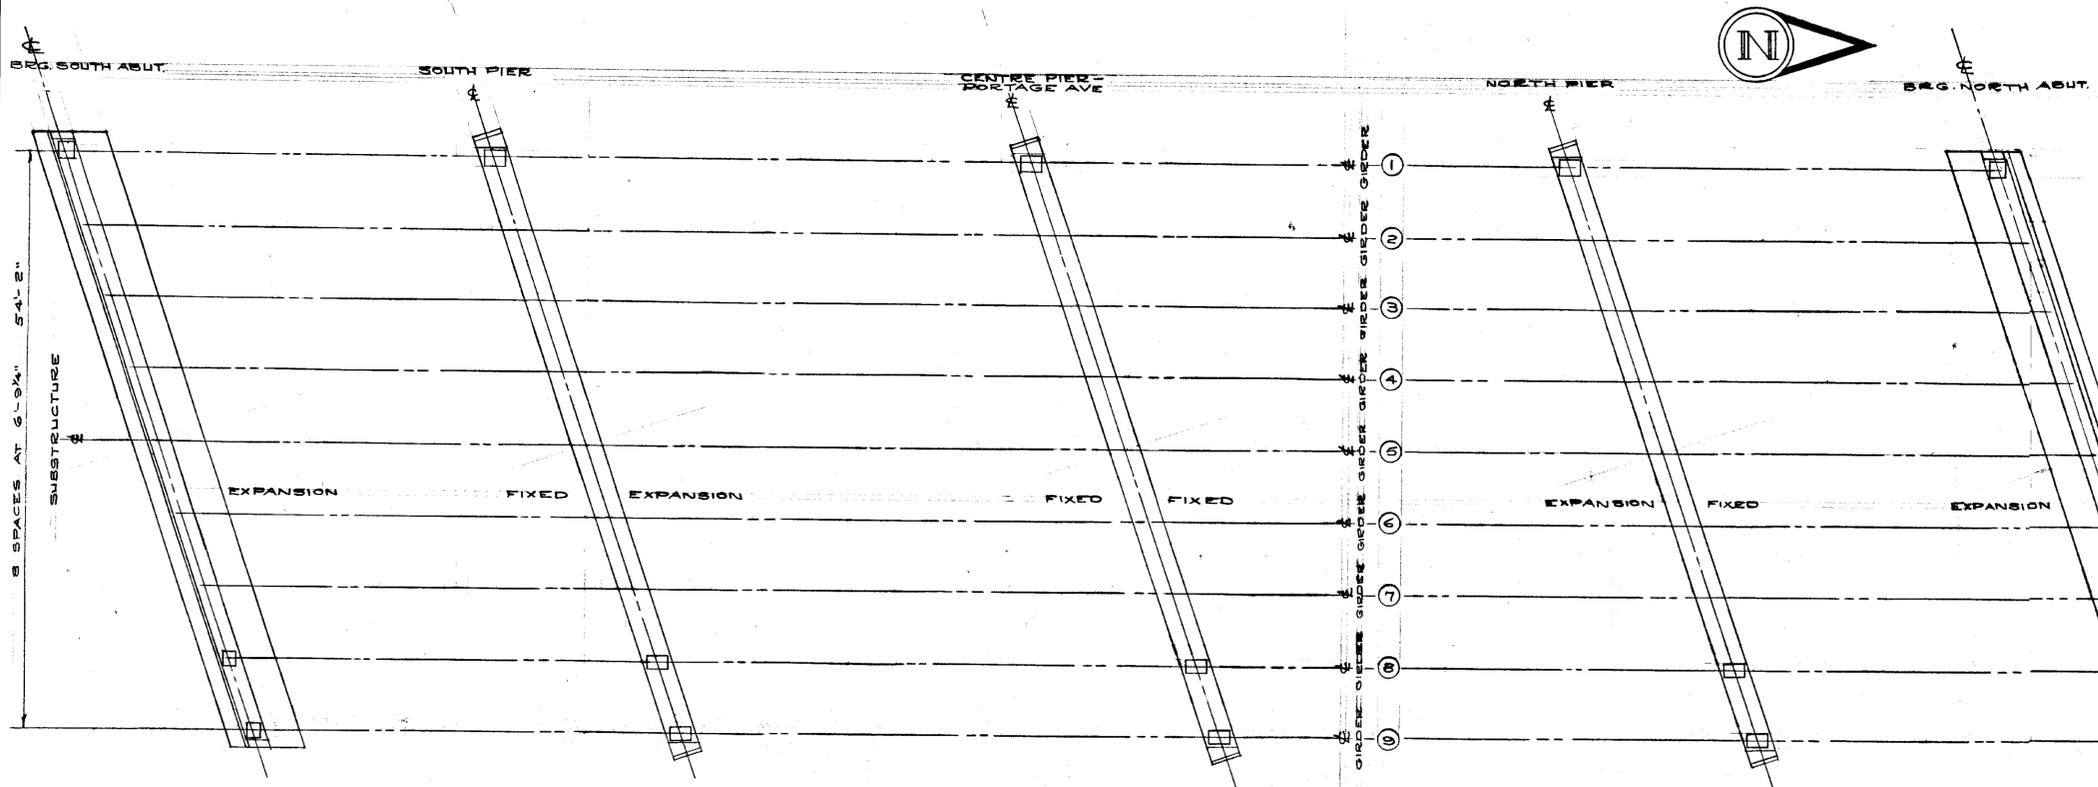


TYPICAL ANCHOR BOLT DETAIL FOR ABUTMENT
SCALE 1"=1'0"

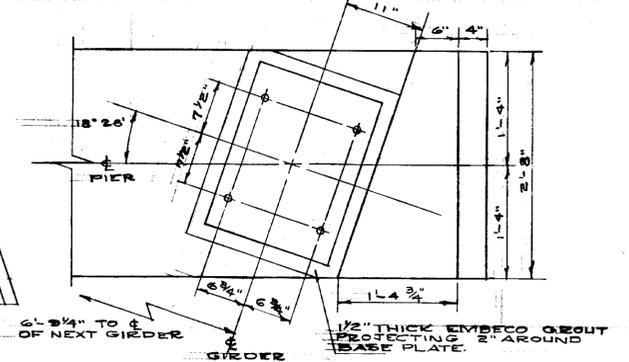

TYPICAL ANCHOR BOLT DETAIL FOR PIER
SCALE 1"=1'0"

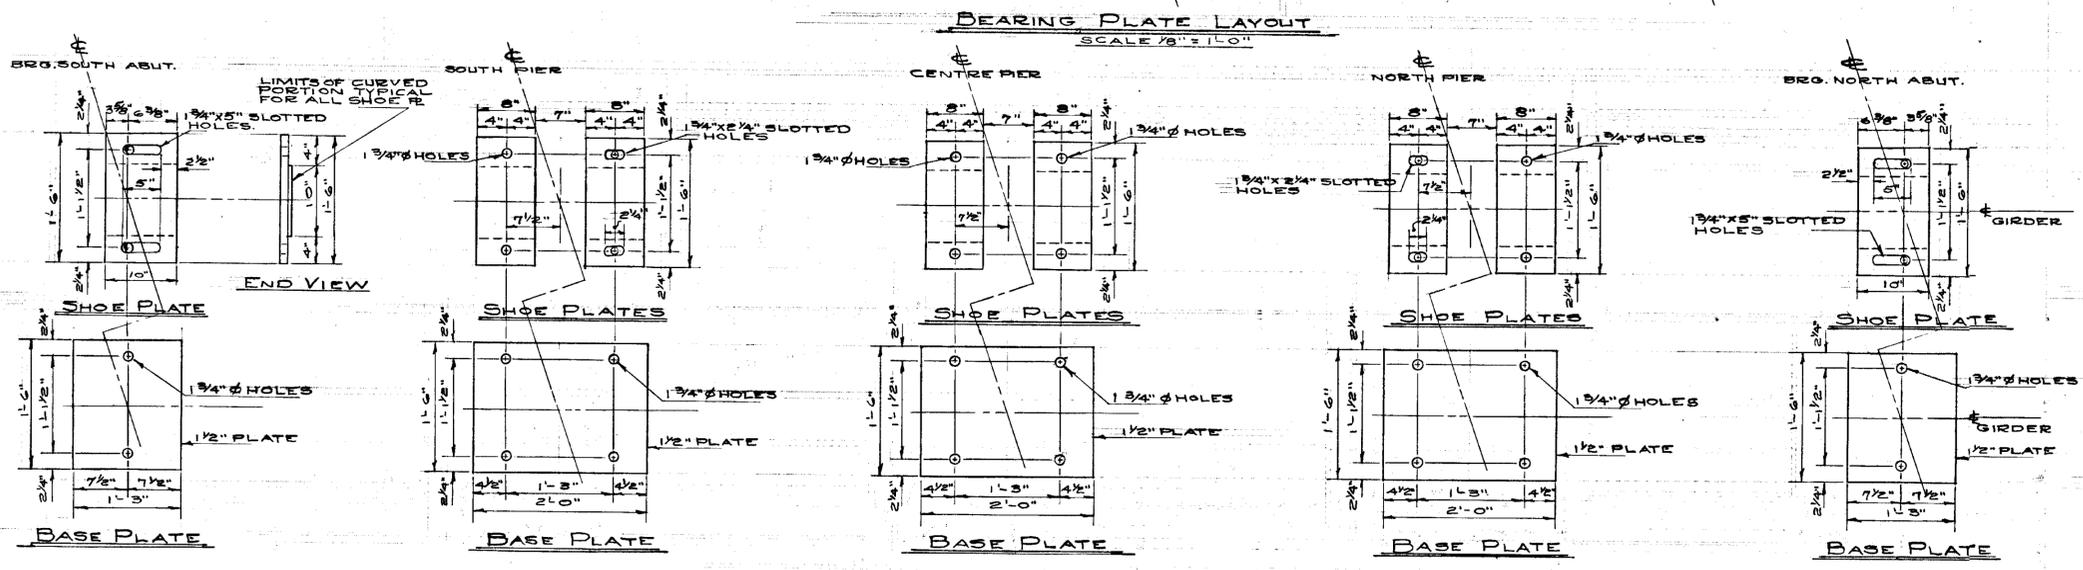


BEARING PLATE DETAILS
SCALE 1"=1'0"

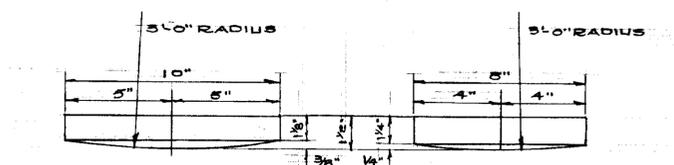


SHOE R AT ABUTMENT SHOE R AT PIER
SCALE 3"=1'0"

GENERAL NOTES.

1. GIRDER SEATS SET AT REQUIRED ELEVATION BY GENERAL CONTRACTOR
2. GENERAL CONTRACTOR TO SET ANCHOR BOLTS WHEN CONCRETE IS PLACED
3. GENERAL CONTRACTOR TO PROVIDE LABOR AND GROUT FOR SETTING BASE PLATES UNDER SUPERVISION OF STEEL CONTRACTOR
4. NUTS AT EXPANSION END TO BE SNUGGLED UP ONLY AND A JAM NUT USED
5. ALL BEARING PLATES SHALL BE WELDED TO GIRDER FLANGES WITH A 3/8" FILLET WELD FULL LENGTH ON BOTH SIDES OF FLANGE
6. ALL CONTACT SURFACES OF BEARING TO BE MACHINED
7. FABREEKA SUPPLIED AND PLACED BY STEEL CONTRACTOR
8. GENERAL CONTRACTOR TO USE A TEMPLATE TO ENSURE ACCURATE PLACING OF ANCHOR BOLTS. TYPE OF TEMPLATE USED & METHOD OF HOLDING BOLTS IN PLACE DURING CONC. POURING WILL BE SUBJECT TO APPROVAL OF THE ENGINEER.
9. POSITIONS OF ANCHOR BOLTS IN SLOTTED HOLES OF SHOE PLATES SHOWN ARE CALCULATED FOR A TEMPERATURE OF 60°F
10. ANCHOR BOLTS TO BE SUPPLIED BY STEEL CONTRACTOR TO MEET GENERAL CONTRACTORS SCHEDULE FOR PLACING.

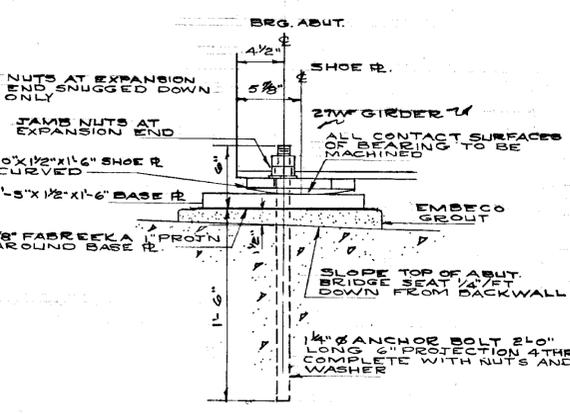

BEARING AT ABUTMENTS
SCALE 1/2"=1'0"

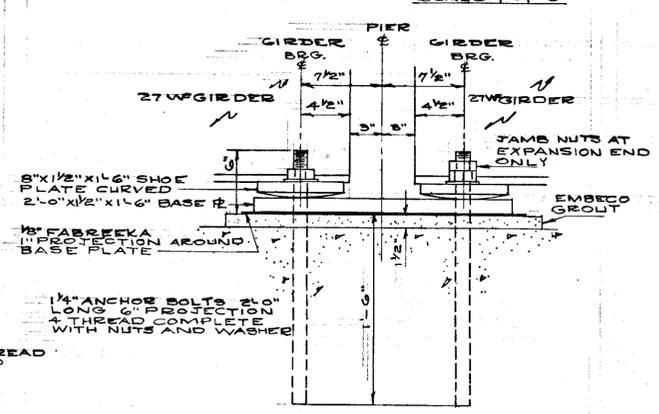

BEARING AT PIERS
SCALE 1/2"=1'0"

GIRDER SEAT ELEVATIONS (UNDERSIDE OF FABREEKA)					
GIRDER	SOUTH ABUTMENT	SOUTH PIER	CENTER PIER	NORTH PIER	NORTH ABUTMENT
①	743.67	744.19	744.56	744.40	743.97
②	743.85	744.36	744.70	744.51	744.06
③	744.02	744.51	744.85	744.63	744.17
④	744.18	744.67	744.89	744.75	744.28
⑤	744.34	744.82	745.13	744.86	744.38
⑥	744.52	744.98	745.07	744.77	744.27
⑦	744.22	744.67	744.93	744.62	744.11
⑧	744.11	744.85	744.79	744.46	743.94
⑨	744.00	744.43	744.64	744.31	743.77



B-5072-8

W. L. WARDROP & ASSOCIATES
(MANAGEMENT) LTD.
ENGINEERING CONSULTANTS
WINNIPEG CANADA

BEARING PLATE LAYOUT & DETAILS
PORTAGE AVENUE OVERPASS
POLO PARK DEVELOPMENT


Scale: AS SHOWN Date: JULY 31, 1958
Designed By: H.A.K. Project No. 5868
Drawn By: A.R. Drawing No. 7
Checked By: R.W.M., R.A.X., H.C.M.



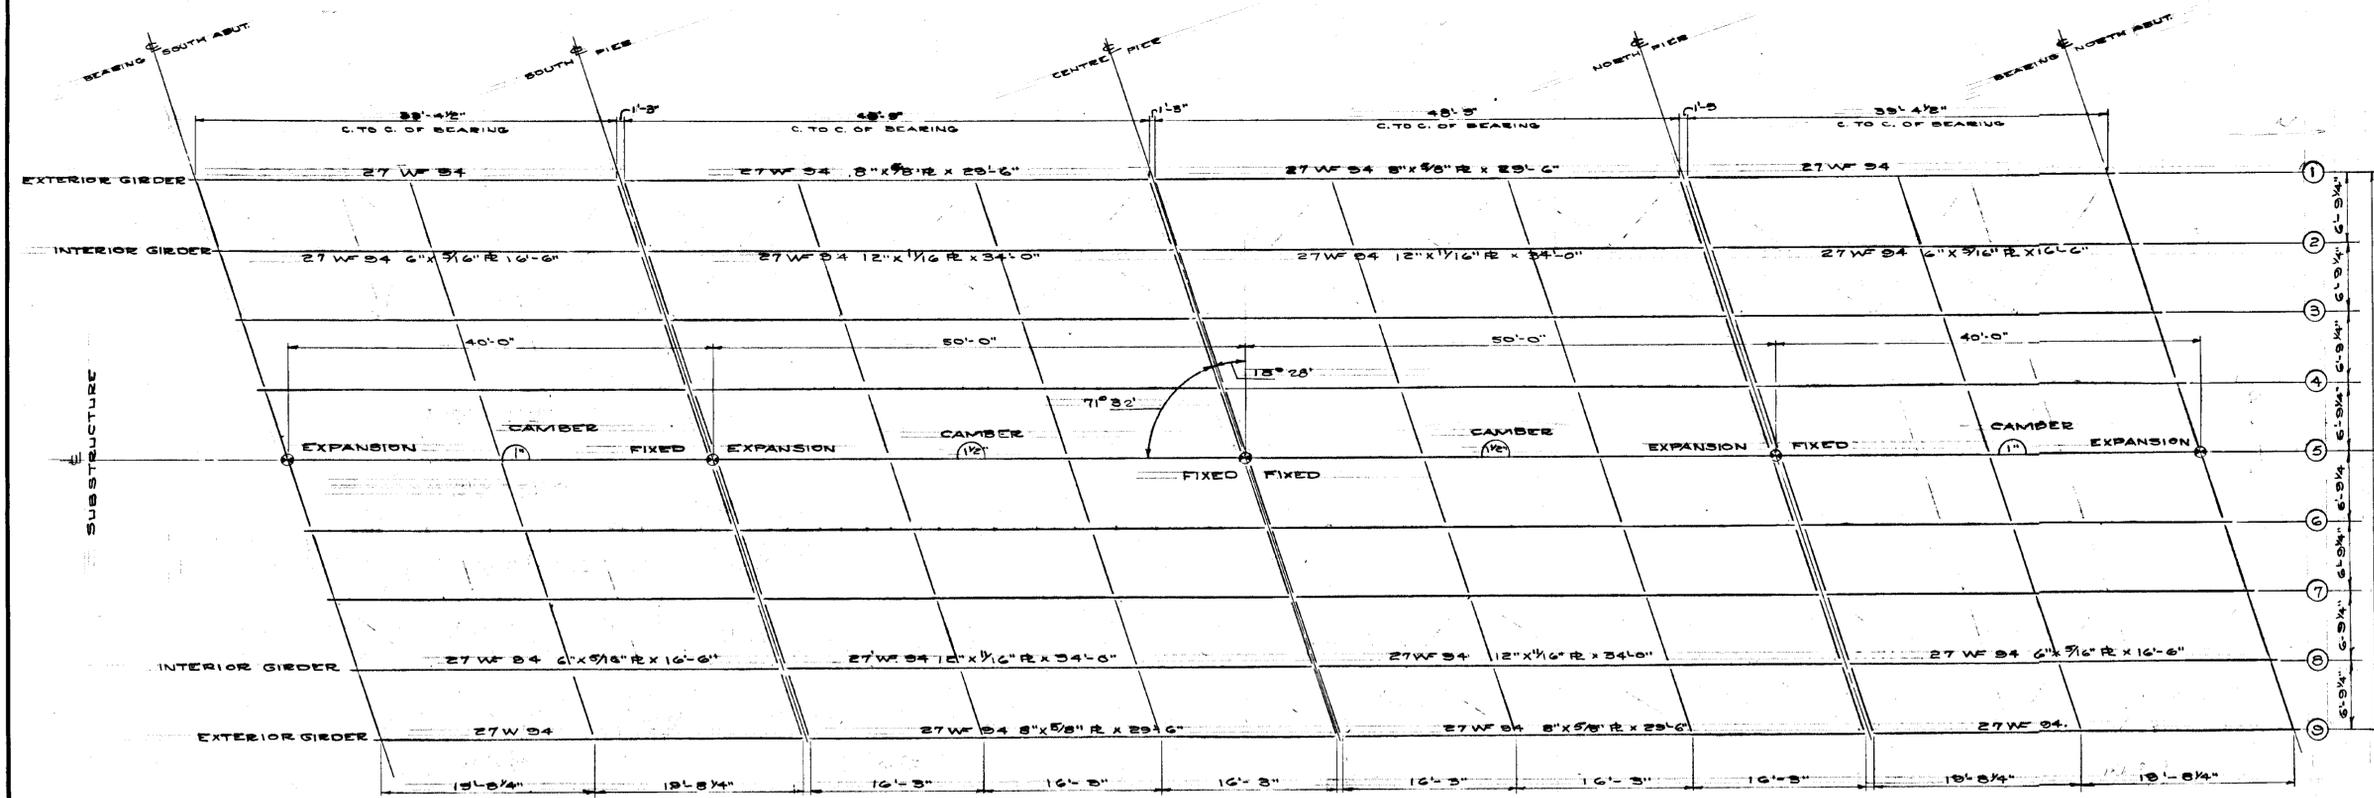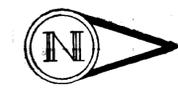


NOTE:
ALL DIAPHRAGMS TO BE 15C 33.9
BACK OF CHANNELS TO CORRESPOND
WITH ϕ OF BRG. AT END OF GIRDERS


STEEL FRAMING PLAN
SCALE 1/8" = 1'-0"

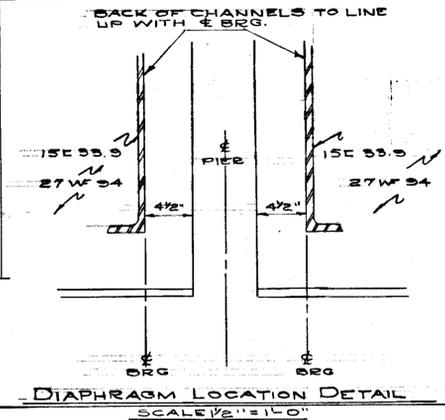

DIAPHRAGM LOCATION DETAIL
SCALE 1/2" = 1'-0"

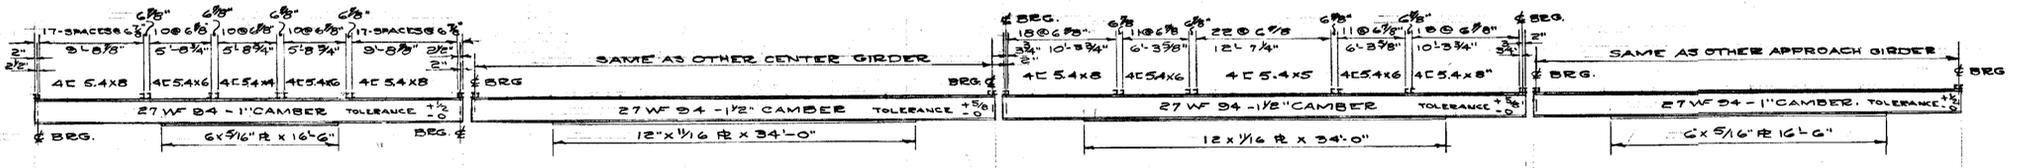


TYPICAL ELEVATION OF INTERIOR GIRDERS
SCALE 1/8" = 1'-0"

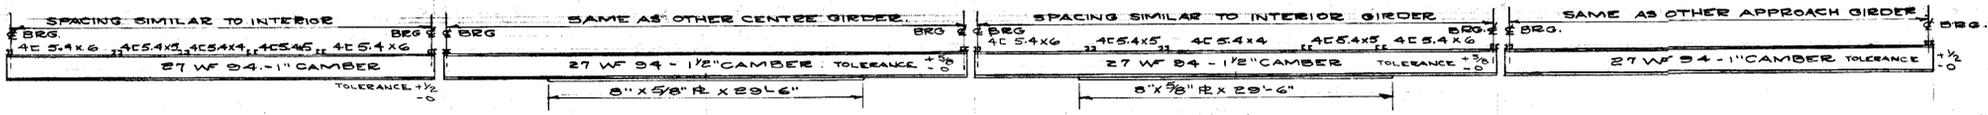


TYPICAL ELEVATION OF EXTERIOR GIRDERS
SCALE 1/8" = 1'-0"

- GENERAL NOTES**
1. MATERIAL SHALL COMPLY WITH CSA SPECIFICATIONS 36-1952
 2. ALL WELDING SHALL CONFORM WITH THE FOLLOWING CODES
CSA W47-1947 WELDING QUALIFICATION CODE FOR APPLICATION TO FABRICATING AND CONTRACTING FIRMS.
CSA W48-1-1952 MILD STEEL ARC WELDING ELECTRODES (3rd EDITION)
CSA W59-1946 WELDING OF STEEL STRUCTURES
AWS D2.2-56 STANDARD SPECIFICATIONS FOR WELDED HIGHWAY AND RAILWAY BRIDGES
 3. DO NOT PAINT STEEL THAT COMES IN CONTACT WITH CONCRETE
 4. SHOP CONNECTIONS SHALL BE WELDED FIELD CONNECTIONS SHALL BE RIVETTED - ALL RIVETS 7/8" DIA.
 5. PLACE MILL CAMBER IN GIRDERS AS SHOWN.
 6. FS FOR STRUCTURAL STEEL 20,000 PSI.

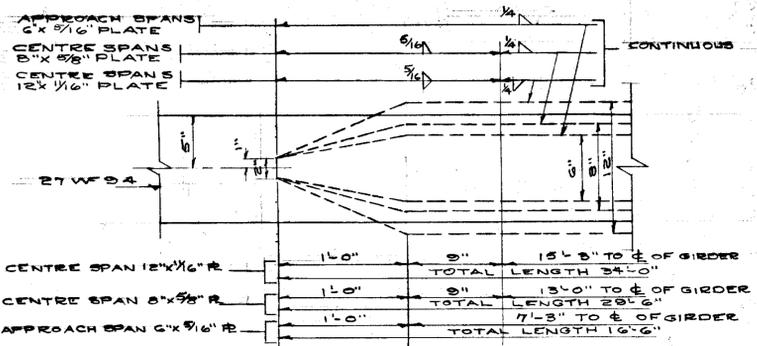


COVER PLATE DETAILS
SCALE 1/2" = 1'-0"

NOTE:
BOTH ENDS OF COVER PLATE SIMILAR

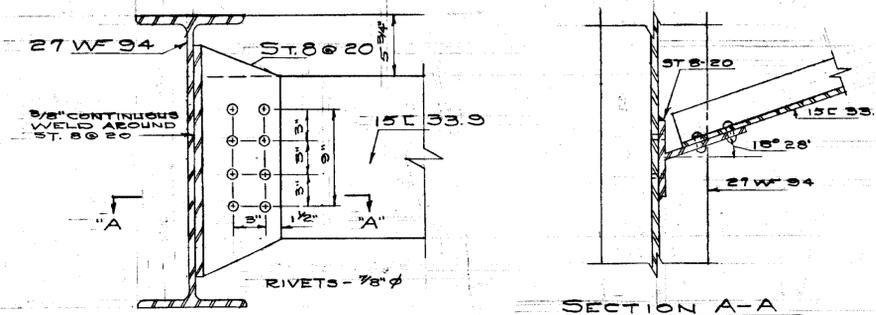

DIAPHRAGM DETAIL
SCALE 1/2" = 1'-0"

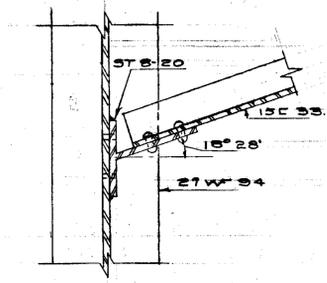

SECTION A-A
SCALE 1/2" = 1'-0"


B-5072-9

W. L. WARDROP & ASSOCIATES
(MANAGEMENT) LTD.
ENGINEERING CONSULTANTS
WINNIPEG CANADA


STRUCTURAL STEEL LAYOUT & DETAILS
PORTAGE AVENUE OVERPASS
POLO PARK DEVELOPMENT

Scale: AS SHOWN	Date: JULY 31 1958
Designed By: HAK, R.W.M.K.	Project No. 5868
Drawn By: A.E.	Drawing No. 8
Checked By: R.W.M.K., H.C.M.	




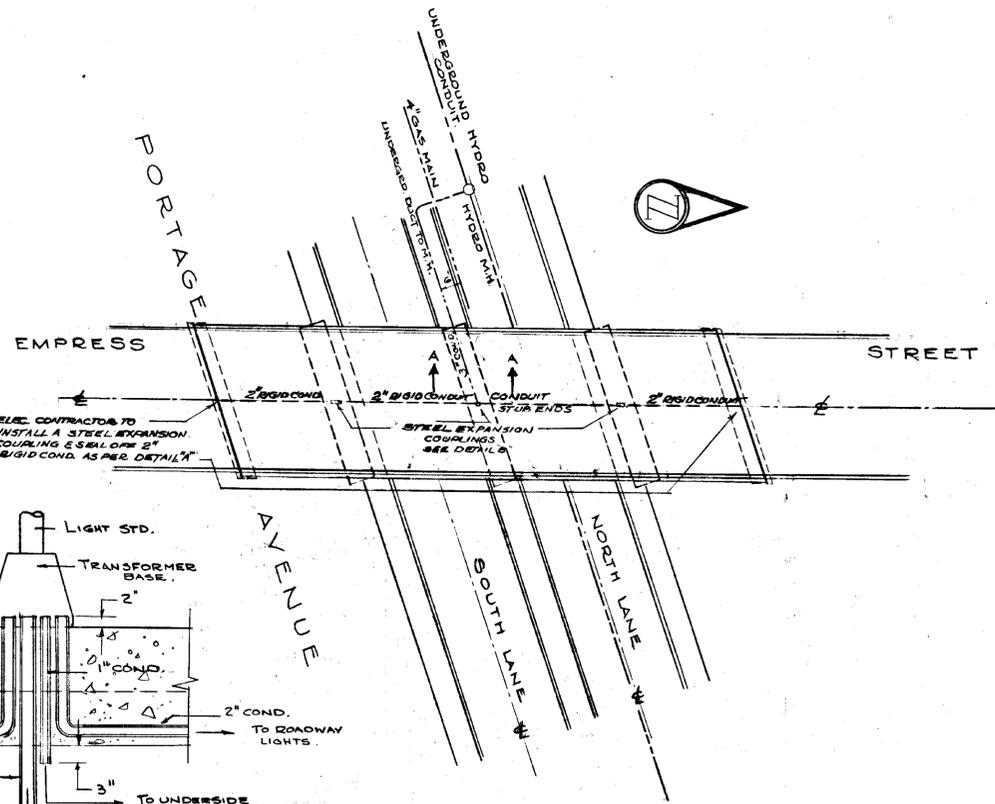


**SITE PLAN
CONDUIT LAYOUT**
1" = 30'-0"

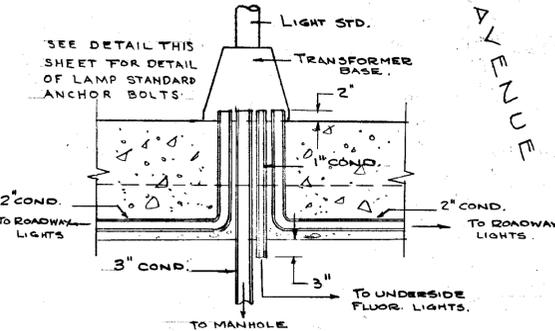

DETAIL-SECT. A-A
1" = 1'-0"

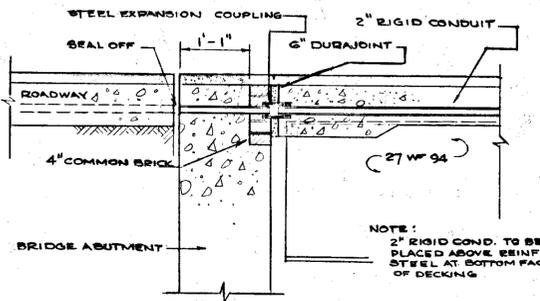

**DETAIL "A"
EXPANSION COUPLING**
3/4" = 1'-0"

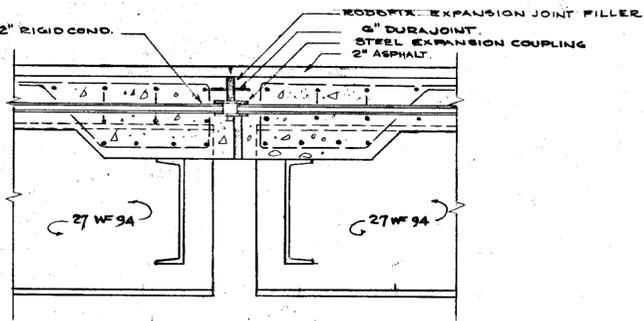


**DETAIL "B"
EXPANSION COUPLING**
1" = 1'-0"

NOTE:
2" RIGID COND. TO BE PLACED ABOVE REINF. STEEL AT BOTTOM FACE OF DECKING


NOTE:
LUBRICATE ONE END ONLY OF STEEL EXPANSION COUPLING AT EACH EXPANSION JOINT TO PREVENT BONDING TO CONCRETE

NOTE:
1. 3" RIGID COND. TO BE LAID IN CONCRETE DUCT 3" x 9" WITH MIN. COVER OF 3" CONC. FROM PIER TO UTILITY M.H.
2. DUCT TO BE INSTALLED APPROX. 4'-6" BELOW GRADE. EXACT LOCATION OF M.H. ENTRANCE TO BE DETERMINED BY POWER UTILITY DURING CONSTRUCTION.

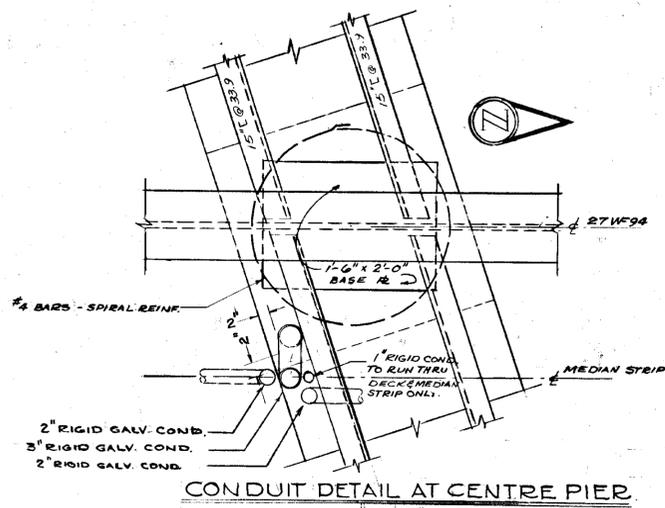


CONDUIT DETAIL AT CENTRE PIER
1" = 1'-0"

**ELECTRICAL
DETAILS**

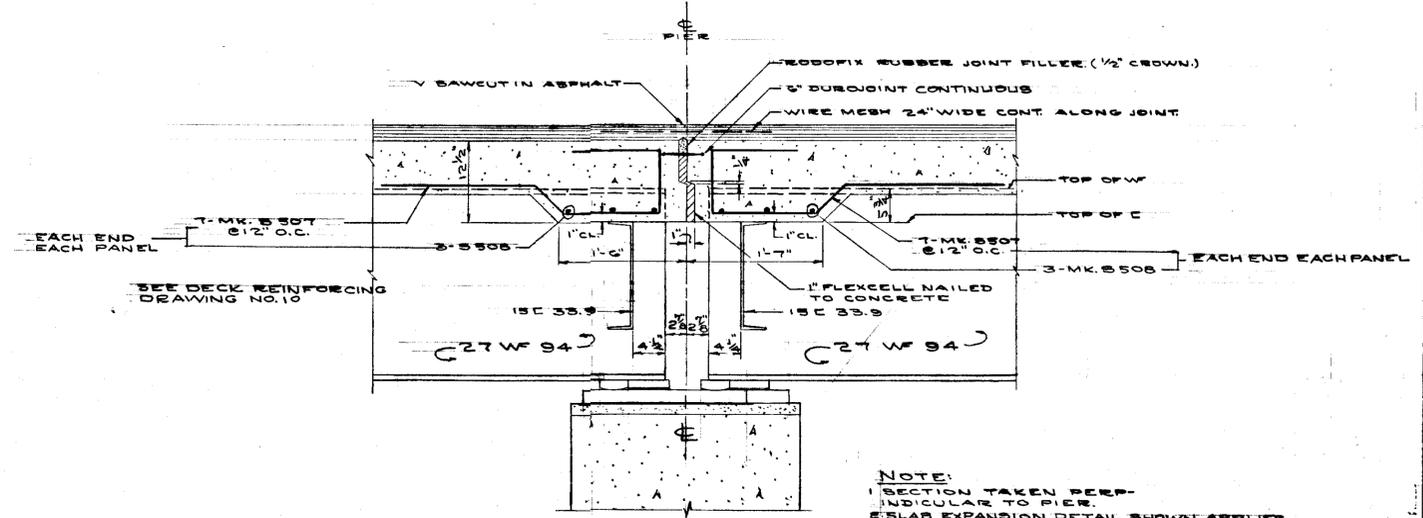


**DECK BEAM & EXPANSION
DETAILS AT PIER**
SLAB REINF. NOT SHOWN
SCALE: 1" = 1'-0"

NOTE:
1. SECTION TAKEN PERP. INDICULAR TO PIER.
2. SLAB EXPANSION DETAIL SHOWN APPLIES TO SIDEWALK, MEDIAN STRIP AND BARRIER CURB.

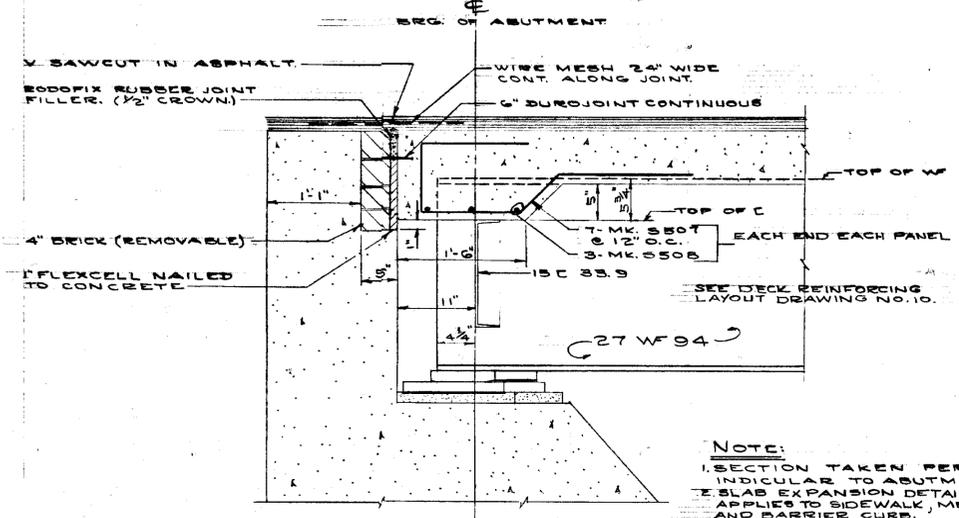


**DECK BEAM & EXPANSION
DETAILS AT ABUTMENT**
SLAB REINF. NOT SHOWN.
SCALE: 1" = 1'-0"

NOTE:
1. SECTION TAKEN PERP. INDICULAR TO ABUTMENT
2. SLAB EXPANSION DETAIL SHOWN APPLIES TO SIDEWALK, MEDIAN STRIP AND BARRIER CURB.

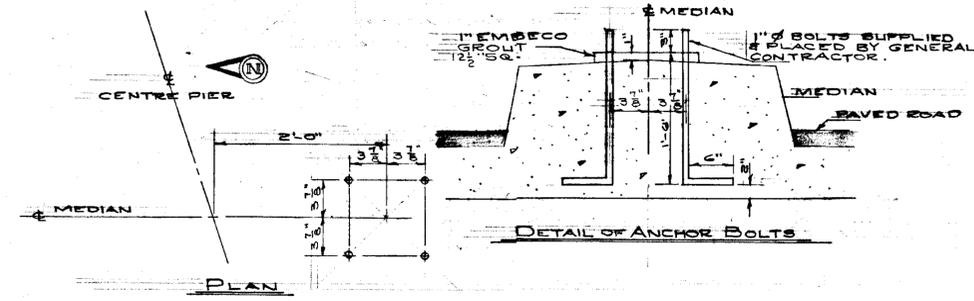

LOCATION OF ANCHOR BOLT FOR LIGHT STANDARD
SCALE 1" = 1'-0"

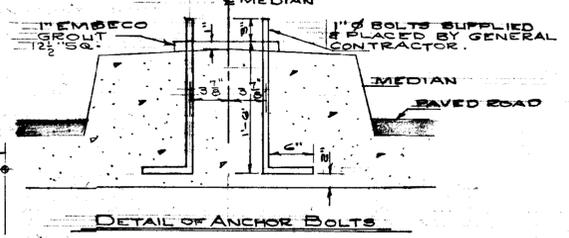

DETAIL OF ANCHOR BOLTS

REVISIONS				
No.	DESC.	DATE	BY	TO
1	ANCHOR BOLT BRACING CHANGES	2/9/58		
2	DIMENSIONS	JUNE 1958		


B-5072-10



W. L. WARDROP & ASSOCIATES
(MANAGEMENT) LTD.
ENGINEERING CONSULTANTS
WINNIPEG CANADA

**EXPANSION, ELECTRICAL
& DECK DETAILS**
PORTAGE AVENUE OVERPASS
POLO PARK DEVELOPMENT


Scale: AS SHOWN. Date: JULY 31, 1958
Designed By: R.W.M.K. & K.A.H. Project No. 5868
Drawn By: R.B. & T.O. Drawing No. 9
Checked By: R.W.M., K.A.H., H.P.M.

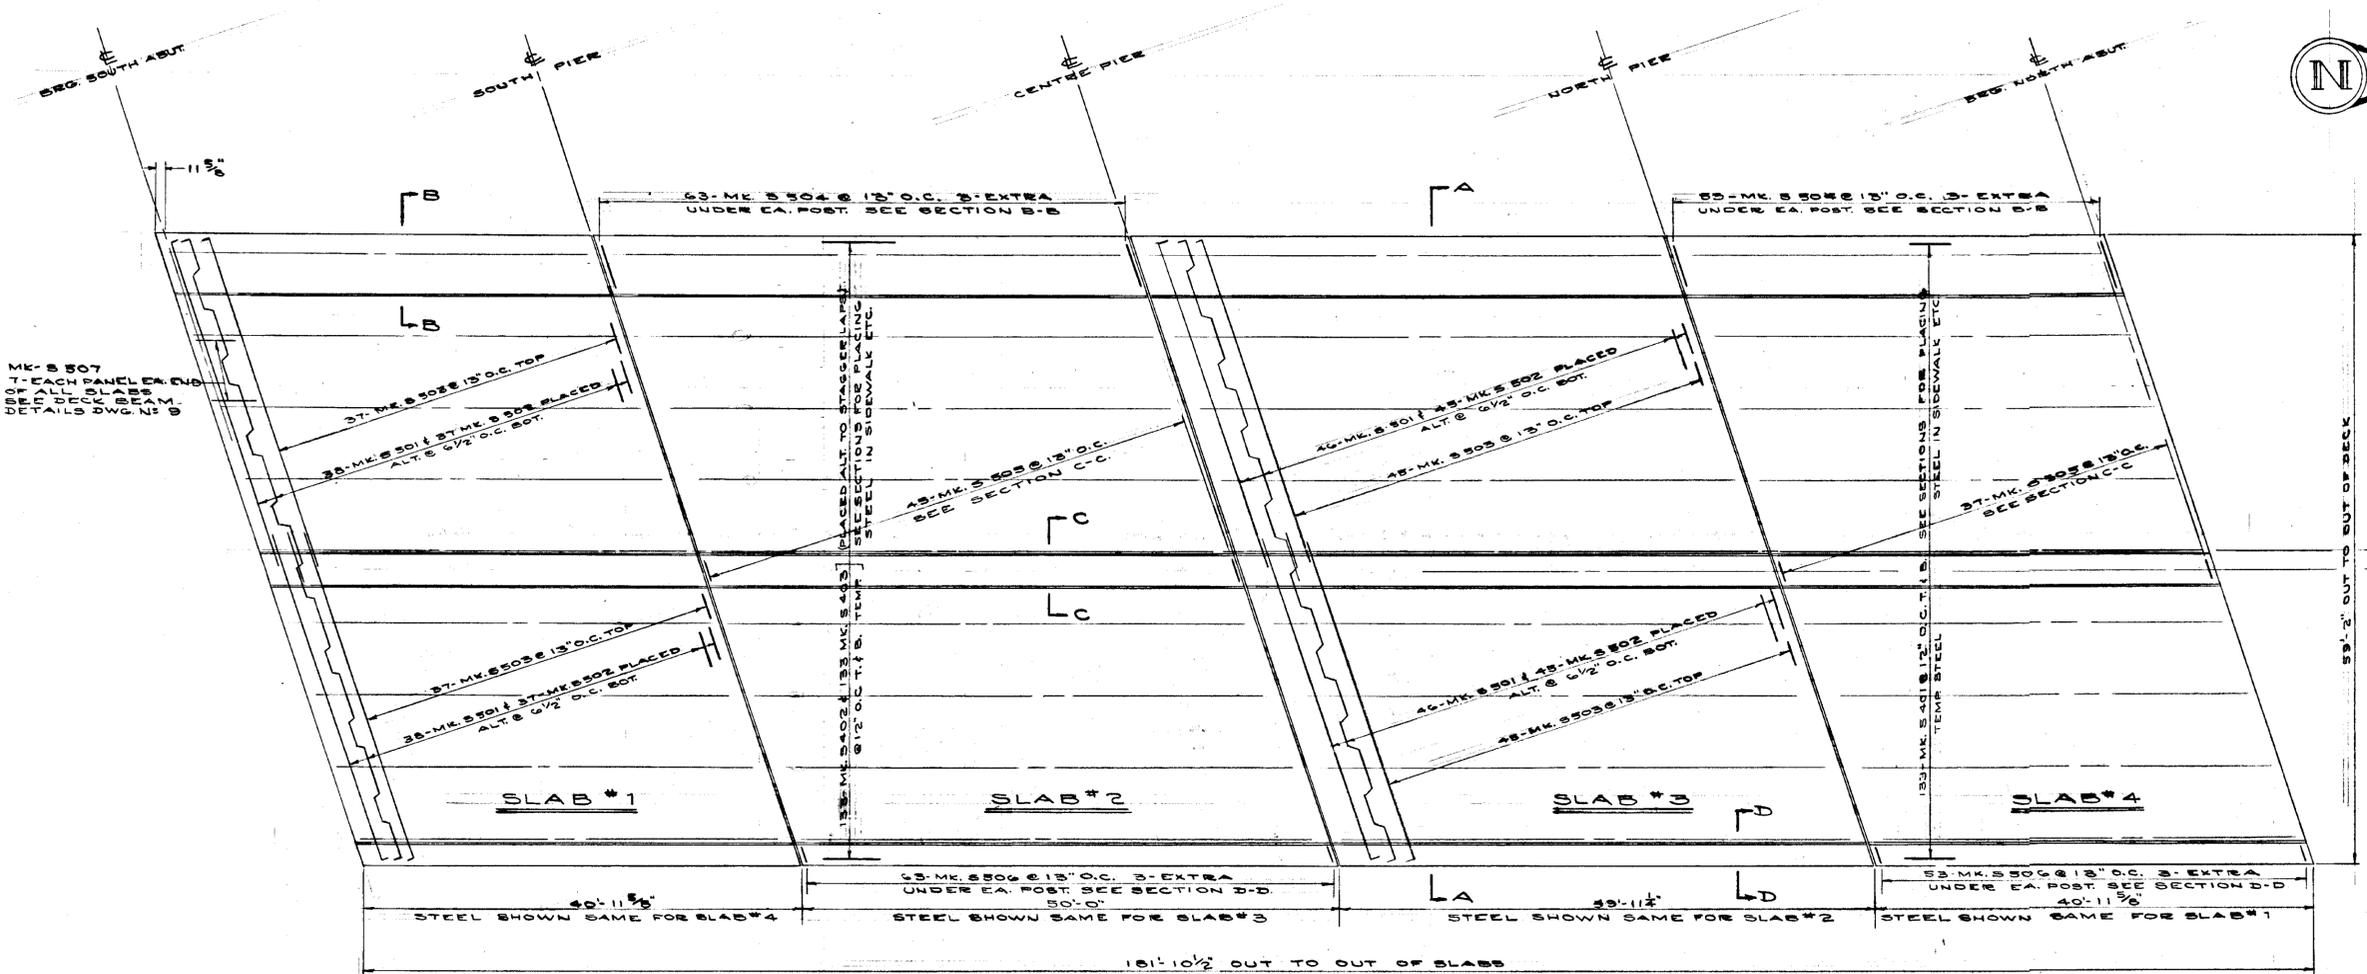

- NOTES:**
1. ASPHALT WEARING SURFACE SHALL BE SUPPLIED AND PLACED BY THE CITY OF WINNIPEG.
 2. ALL EXPOSED CONCRETE SURFACES EXCEPT ROADWAY SURFACE/SIDEWALK SURFACE TO BE RUBFINISHED UNDER-SIDE OF DECK BETWEEN EXTERIOR SIDERS. NEED NOT BE RUBFINISHED IF PLYWOOD LINED FORMS ARE USED, EXCEPT AS A CORRECTIVE MEASURE.
 3. MINIMUM 3750 P.S.I. AT 28 DAYS FOR DECK CONCRETE.


DECK PLAN REINFORCING

SCALE: 1/8" = 1'-0"

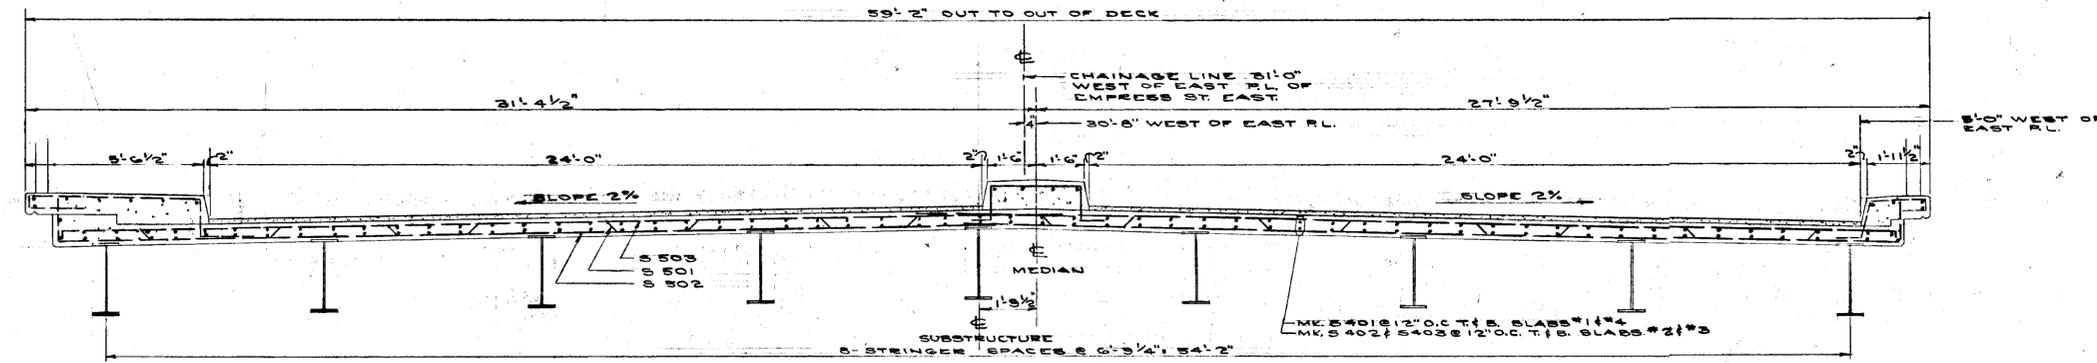

SECTION A-A

SCALE: 3/8" = 1'-0"

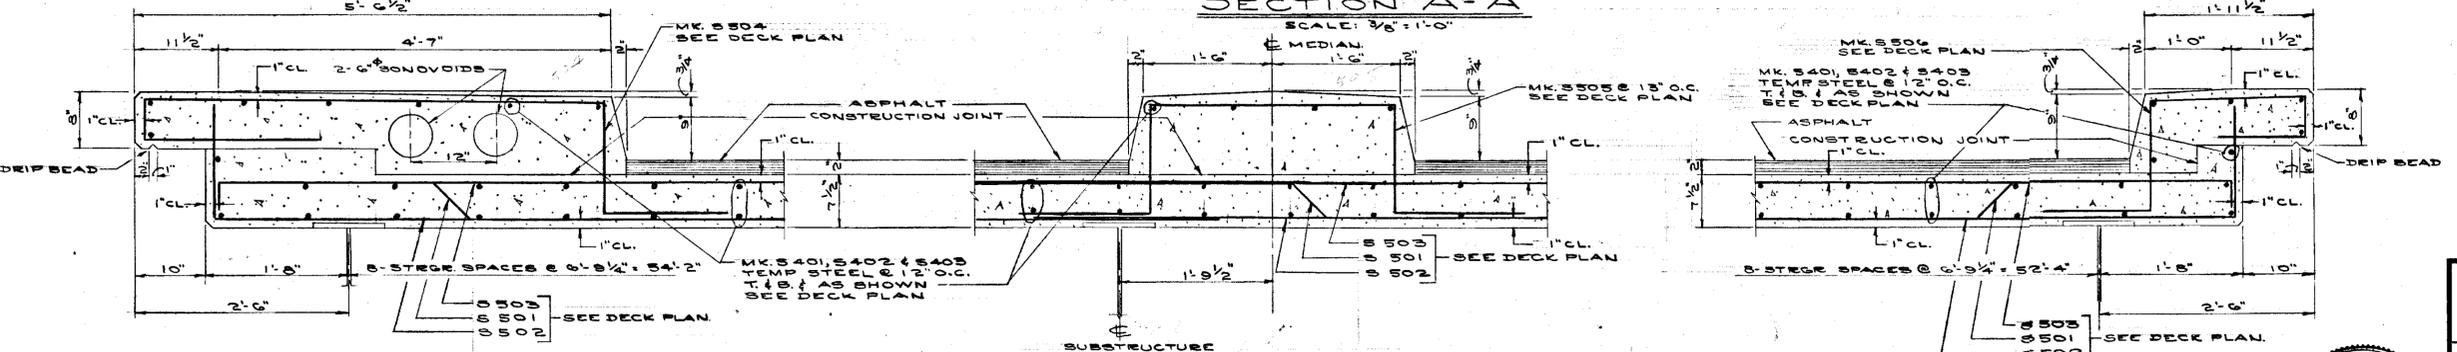

SECTION B-B

SHOWING SIDEWALK DETAIL
SCALE: 1" = 1'-0"

SECTION C-C

SHOWING SECTION THRU MEDIAN
SCALE: 1" = 1'-0"

SECTION D-D

SHOWING SECTION THRU BARRIER CURB
SCALE: 1" = 1'-0"

REVISIONS			
No.	DESC.	DATE	BY
1	Length Bed Centre of North Pier Overall Length	June 1959	T.O.

B-5072-11

W. L. WARDROP & ASSOCIATES
(MANAGEMENT) LTD.
ENGINEERING CONSULTANTS
WINNIPEG CANADA

DECK REINFORCING LAYOUT
PORTAGE AVENUE OVERPASS
POLO PARK DEVELOPMENT X

Scale: AS SHOWN	Date: JULY 31, 1958
Designed By: E.W.M.K.	Project No. 5865
Drawn By: T.O.	Drawing No. 10
Checked By: R.W.M., J.Z.X., H.B.M.	



B-5072-31

W. L. WARDROP & ASSOCIATES
 (MANAGEMENT) LTD.
ENGINEERING CONSULTANTS
WINNIPEG PORT ARTHUR

DATE: JULY 31/58 LISTED BY: R.W. M^oK CHECKED BY: H.B. M^oL. JOB NO. 5868 SHEET NO. 1 OF 4



PLAN NO

CLIENT: CITY OF WINNIPEG








MATERIAL FOR: TWO ABUTMENTS

REFER TO DWGS. NO. 4

REVISED:

JOB: PORTAGE AVENUE OVERPASS
 POLO PARK DEVELOPMENT

BENDING DIAGRAMS
 ALL DIMENSIONS OUT TO OUT

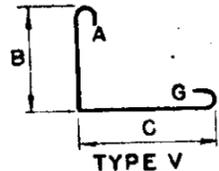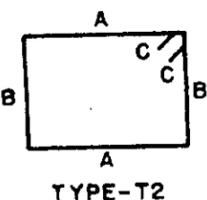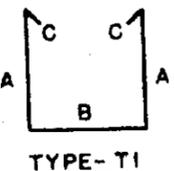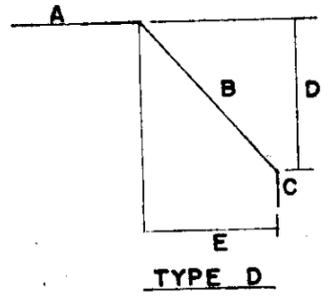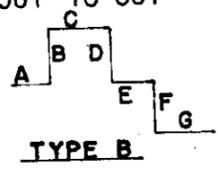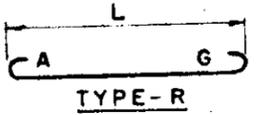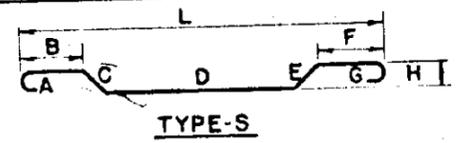

MARK	SIZE	NO. BARS	LENGTH	TYPE	A	B	C	D	E	F	G	H	L	REMARKS OR SHAPE	WEIGHT
A-401	#4	34	26'-4"	ST.											598.0
A-402	#4	34	35'-0"	ST.											794.9
A-403	#4	16	3'-4"	ST.											35.6
A-404	#4	20	2'-10"	ST.											37.8
A-501	#5	12	26'-8"	ST.											333.8
A-502	#5	12	35'-0"	ST.											438.1
A-503	#5	122	8'-2"	V		9"	7'-5"								1039.6
A-504	#5	122	4'-3 1/2"	B	14"	5"	2'-8 1/2"								545.9
A-505	#5	122	8'-5"	D	3'-2"	4'-9"	6"	3'-9"	3'-0"						1072.7
A-601	#6	14	35'-0"	ST.											736.0
A-602	#6	14	26'-10"	ST.											564.2
A-603	#6	146	7'-4"	R	8"						6"		6'-0"		1607.4
														SHEET TOTAL	= 7804.0


B-5072-52

W. L. WARDROP & ASSOCIATES
 (MANAGEMENT) LTD.
ENGINEERING CONSULTANTS
WINNIPEG PORT ARTHUR


CLIENT: CITY OF WINNIPEG

JOB: PORTAGE AVENUE OVERPASS
 POLO PARK DEVELOPMENT

DATE JULY 31	LISTED BY R.W.M.K.	CHECKED BY H.B.M.L.	JOB NO. 5868	SHEET NO. 2 OF 4
MATERIAL FOR:		PIER BEAMS		
REFER TO DWGS.		THREE PIERS NO. 5		
REVISED:				

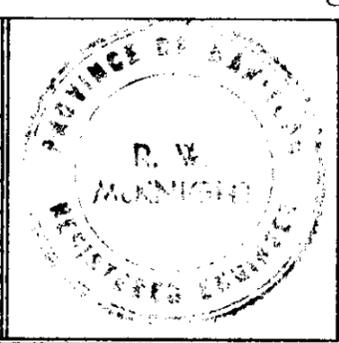

PLAN
No

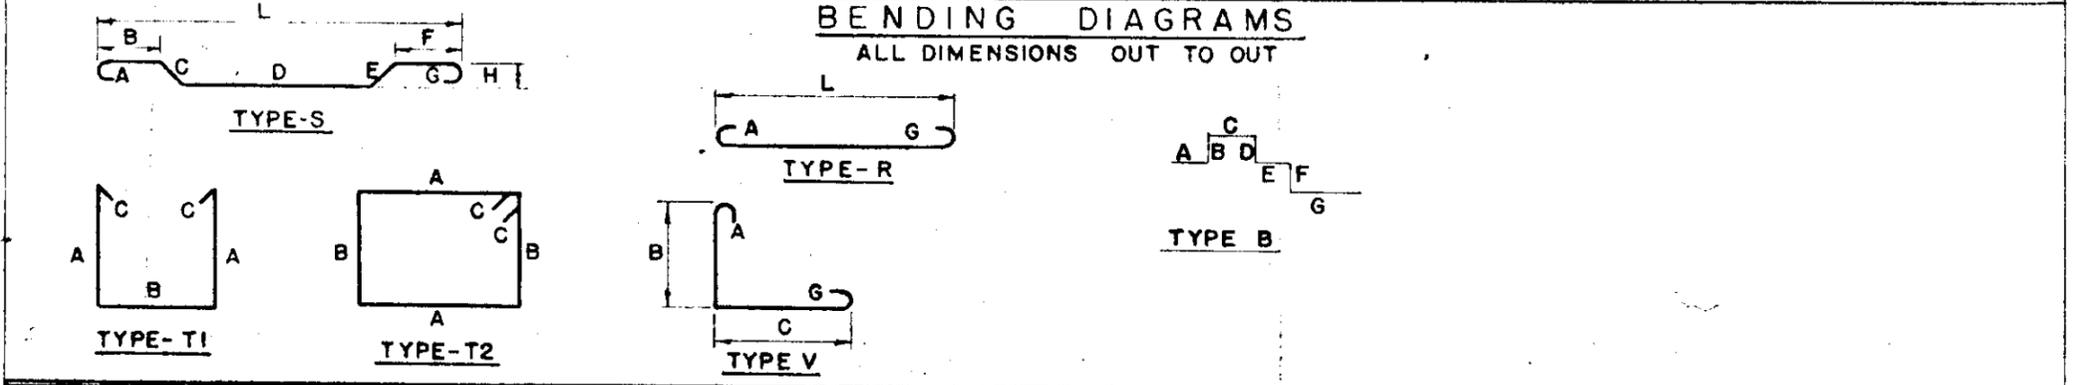


MARK	SIZE	NO. BARS	LENGTH	TYPE	A	B	C	D	E	F	G	H	L	REMARKS OR SHAPE	WEIGHT
PIER BEAMS															
P-401	#4	153	5'-10"	B		1'-9"	2'-4"	1'-9"							595.8
P-402	#4	408	7'-10"	T-1	2'-8"	1'-6"	6"								2134.0
P-403	#4	24	15'-1"	ST.											241.8
P-404	#4	24	15'-6"	ST.											248.5
P-405	#4	48	31'-11"	ST.											1023.5
P-406	#4	24	4'-5"	ST.											70.9
P-407	#4	6	3'-4"	V.		1'-0"	2'-4"								13.3
P-408	#4	6	3'-8"	V.		1'-4"	2'-4"								14.7
P-409	#4	12	2'-5"	ST.											19.4
P-701	#7	36	31'-4"	ST.											2305.4
P-903	#9	18	38'-4"	ST.											2345.8
P-904	#9	18	25'-10"	ST.											1580.7
														SHEET TOTAL	= 10593.8

B-5072-53

W. L. WARDROP & ASSOCIATES
 (MANAGEMENT) LTD.
ENGINEERING CONSULTANTS
WINNIPEG PORT ARTHUR


DATE: JULY 31/58 LISTED BY: R.W. M^cK. CHECKED BY: JOB NO. 5868 SHEET NO. 3 OF 4
 MATERIAL FOR: DECK, CURBS & SIDEWALK
 REFER TO DWGS. NO. 10
 REVISED:

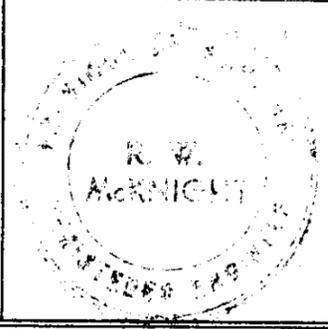

PLAN NO

CLIENT: CITY OF WINNIPEG
 JOB: PORTAGE AVENUE OVERPASS
 POLO PARK DEVELOPMENT

BENDING DIAGRAMS
 ALL DIMENSIONS OUT TO OUT

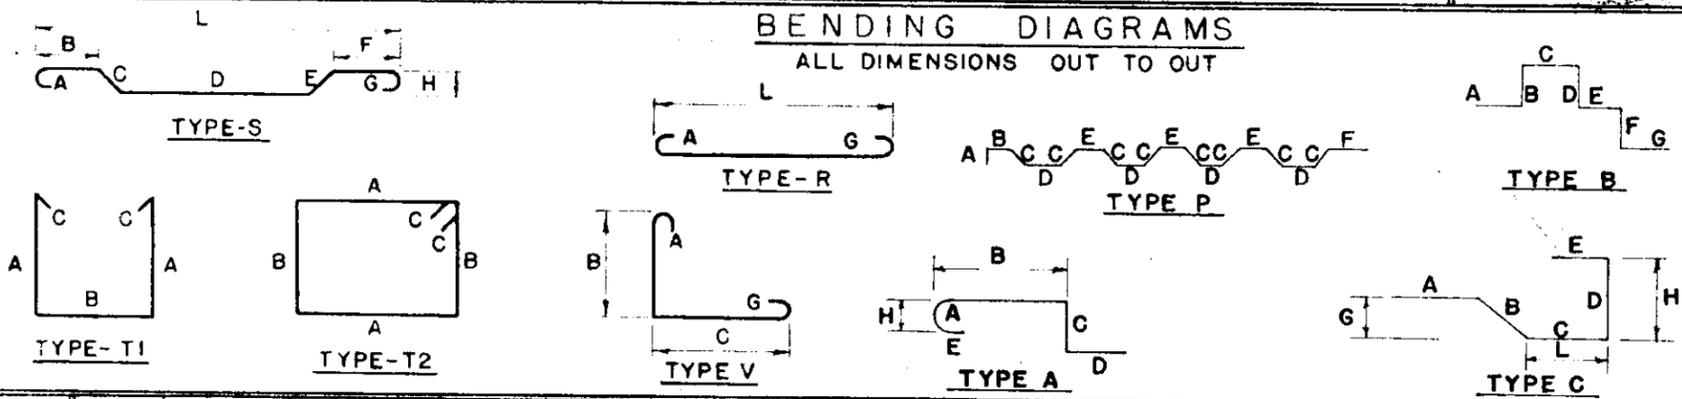

MARK	SIZE	NO. BARS	LENGTH	TYPE	A	B	C	D	E	F	G	H	L	REMARKS OR SHAPE	WEIGHT
DECK															
S-501	# 5	336	36'-3 1/2"	P	5 1/2"	2'-11"	8'	3'-7"	2'-8"	4'-11"					12717.8
S-502	# 5	328	32'-6"	V		1'-5"	31'-1"								1111.84
S-503	# 5	328	31'-6"	V		5"	31'-1"								10776.3
S-504	# 5	232	10'-1"	A	7"	5'-4 1/2"	1'-4 1/2"	1'-6"	1'-3"			6"			2439.2
S-505	# 5	164	8'-7"	B	1'-6"	1'-4 1/2"	2'-10"	1'-4 1/2"	1'-6"						1467.6
S-506	# 5	232	6'-6"	A	7"	1'-9 1/2"	1'-4 1/2"	1'-6"	1'-3"						1572.8
S-507	# 5	448	5'-4 1/2"	C	1'-7"	7 1/2"	1'-4"	10"	1'-0"		5"	10 1/2"	1'-4"		2537.2
S-508	# 5	192	7'-0"	ST.											1401.8
S-401	# 4	266	40'-9"	ST.											7240.8
S-402	# 4	266	20'-0"	ST.											3553.8
S-403	# 4	266	31'-1"	ST.											5522.5
SHEET TOTAL															60348.2


B-5072-54

W. L. WARDROP & ASSOCIATES
 (MANAGEMENT) LTD.
ENGINEERING CONSULTANTS
WINNIPEG PORT ARTHUR

CLIENT: CITY OF WINNIPEG


JOB: PORTAGE AVENUE OVERPASS
 POLO PARK DEVELOPMENT

DATE	LISTED BY	CHECKED BY	JOB NO.	SHEET NO.
JULY 31/58	R.W.MPK	H.B.MCL.	5868	4 OF 4
MATERIAL FOR:		PIER COLUMNS & FOOTINGS		
		3 PIERS		
REFER TO DWGS.		NO. 5		
REVISED:				

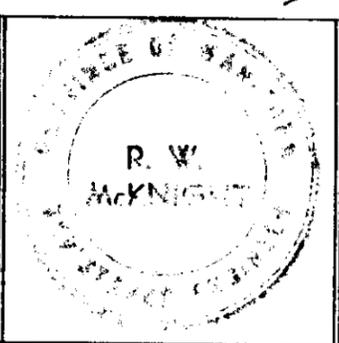


PLAN NO

BENDING DIAGRAMS
 ALL DIMENSIONS OUT TO OUT

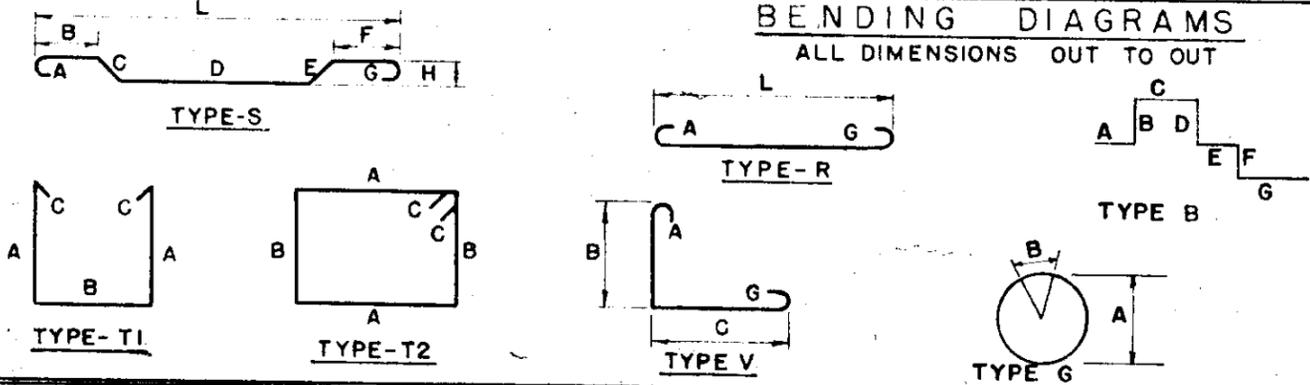

MARK	SIZE	NO. BARS	LENGTH	TYPE	A	B	C	D	E	F	G	H	L	REMARKS OR SHAPE	WEIGHT
PIER COLUMNS															
P-902	#9	240	17'-3"	ST.										—	14076.0
SPIRAL REINF.															
P-410	#4	120	8'-7"	G	*4 AT 2 3/4" PITCH DIAMETER		2'-4"	1'-3"	2'-4"	14'-6"				○	4005.0
P-901	#9	240	8'-9"	V		1'-3"	7'-6"							└─	687.8
PIER FOOTINGS															
P-501	#5	123	10'-8"	B		4'-3"	2'-2"	4'-3"						┌─	7140.0
P-801	#8	222	9'-8"	R	10"	8'-0"					10"			┌─	1368.8
P-802	#8	54	26'-0"	ST.										┌─	5731.8
P-803	#8	54	36'-0"	ST.										┌─	3748.8
P-502	#5	123	13'-6"	B		2'-9"	8'-0"	2'-9"						┌─	5190.5
															1731.9
															SHEET TOTAL = 43680.6

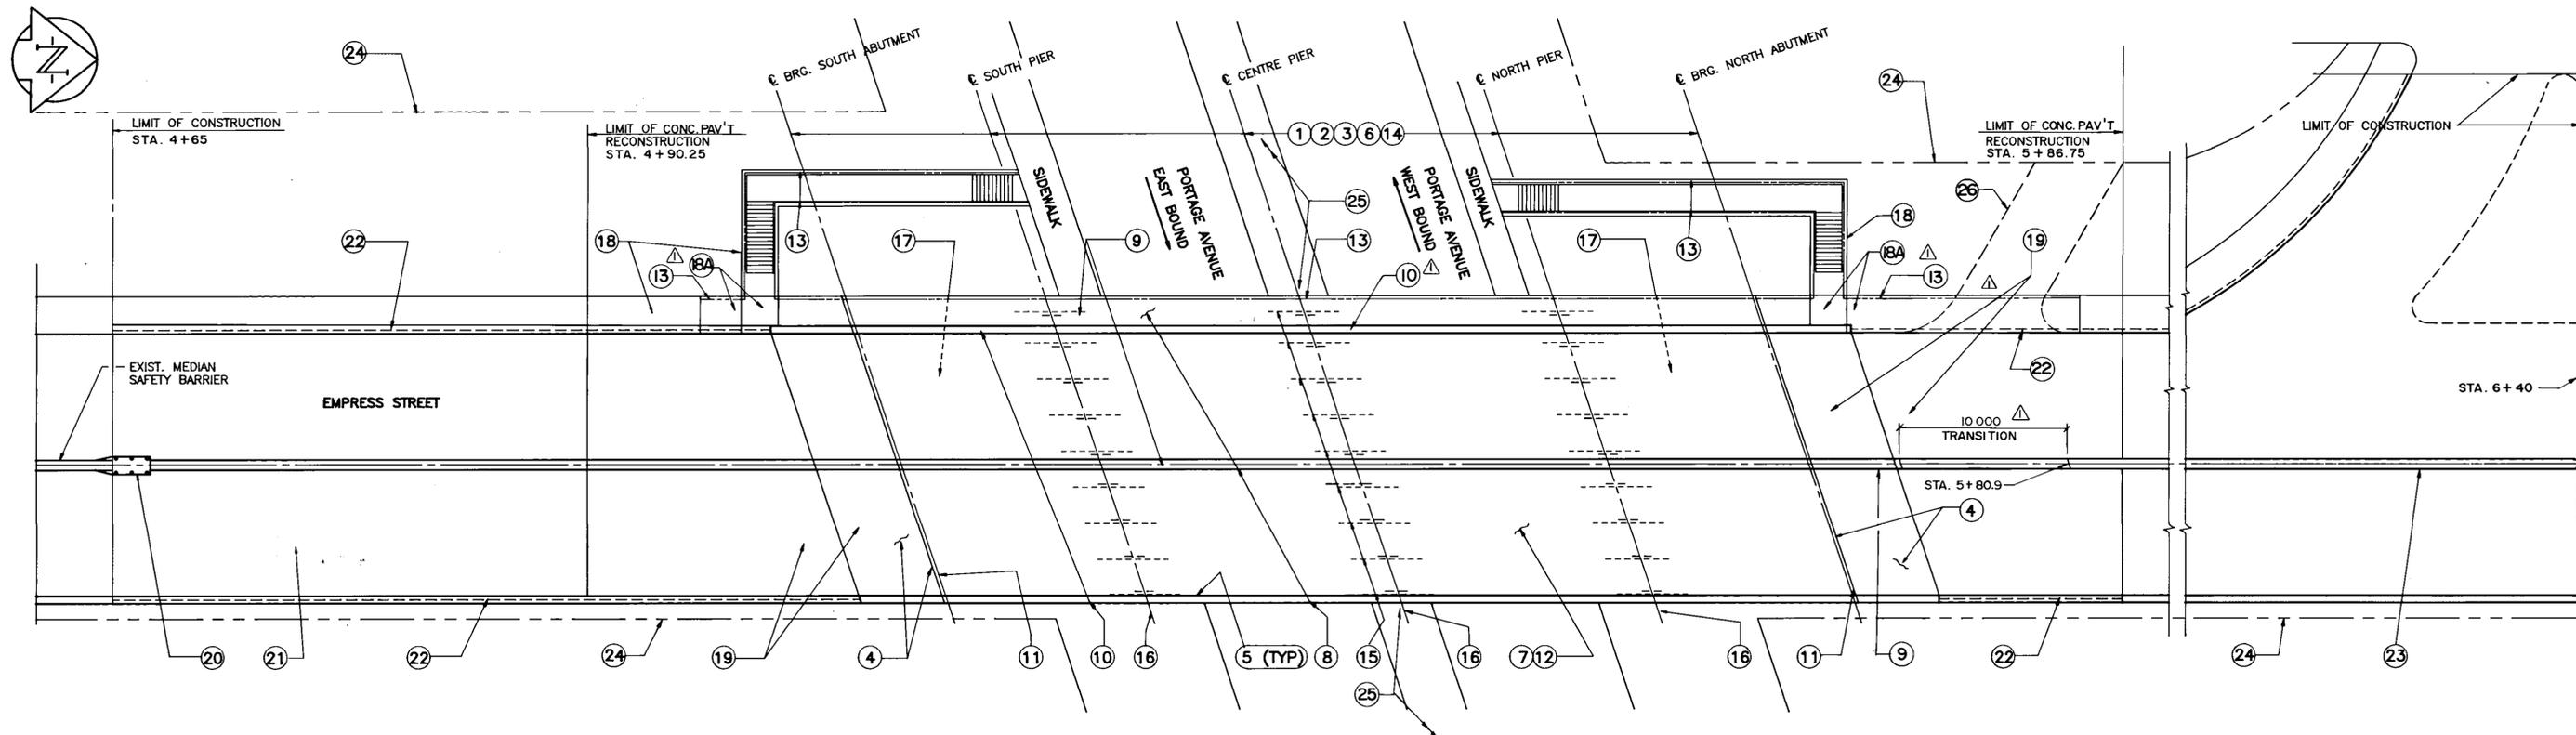

1 GENERAL ARRANGEMENT
1 : 200

SCOPE OF WORK	REFERENCE DRAWING NUMBERS
① JACK UP BRIDGE SUPERSTRUCTURE AFTER MODIFYING ELECTRICAL CABLE CONDUITS TO EXISTING FLUORESCENT LAMPS U/S DECK.	B100 - 90 - 06A
② REMOVE EXISTING BEARINGS AND INSTALL NEW BEARINGS AT ALL ABUTMENTS AND PIERS.	B100 - 90 - 07, 09
③ LOWER BRIDGE SUPERSTRUCTURE AFTER INSTALLATION OF NEW BEARINGS.	
④ DEMOLISH EXISTING APPROACH SLABS AND MODIFY ABUTMENT BACKWALLS TO ACCOMMODATE CONSTRUCTION OF THE NEW EXPANSION JOINT ASSEMBLY AND THE SEAT FOR APPROACH SLAB.	B100 - 90 - 06A, 12A, 15A
⑤ STRENGTHEN EXTERIOR GIRDERS AND MAKE ALL GIRDERS CONTINUOUS OVER PIERS.	B100 - 90 - 08
⑥ CAST CONCRETE DIAPHRAGMS OVER PIERS AND ABUTMENTS.	B100 - 90 - 10A, 21A
⑦ REMOVE EXISTING CONCRETE DECK SLAB. CONSTRUCT NEW 100 mm THICK CONCRETE DECK SLAB.	B100 - 90 - 06A, 07
⑧ REMOVE EXISTING SIDEWALK ON WEST SIDE, CENTRE MEDIAN AND CURB SECTION ON EAST SIDE.	B100 - 90 - 06A, 07
⑨ CONSTRUCT NEW SIDEWALK AND CONCRETE BRIDGE MEDIAN TRAFFIC BARRIER.	B100 - 90 - 13A, 14A, 22A
⑩ CONSTRUCT CONCRETE BRIDGE SHOULDER TRAFFIC BARRIERS COMPLETE WITH RAILINGS AND POSTS.	B100 - 90 - 13A, 14A, 18, 22A
⑪ INSTALL EXPANSION JOINTS AT ABUTMENTS	B100 - 90 - 10A, 11

SCOPE OF WORK	REFERENCE DRAWING NUMBERS
⑫ INSTALL EPOXY COATED REINFORCING STEEL AND MINIMUM 140mm HIGH DENSITY CONCRETE TOPPING OVER TRAFFIC SURFACE OF THE OVERPASS.	B100 - 90 - 13A, 21A
⑬ INSTALL NEW ALUMINUM PEDESTRIAN HANDRAIL.	B100 - 90 - 16, 17
⑭ CONCRETE REPAIR TO PIERS AND ABUTMENTS.	B100 - 90 - 10A, 10B, 10C, 10D, 15A, 21A, 22A
⑮ SURFACE PREPARATION AND PAINTING OF SUPERSTRUCTURE STEEL.	B100 - 90 - 07, 08
⑯ REINFORCE PIER CAP CANTILEVERS.	B100 - 90 - 10A, 21A
⑰ RECONSTRUCT EXISTING SLOPE PAVINGS AND SURFACE RUN-OFF CHANNEL UNDERNEATH THE OVERPASS.	B100 - 90 - 20, 22A
⑱ REPAIR AND MODIFY EXISTING STAIRWAY.	B100 - 90 - 19
⑲ CONSTRUCT NEW 150mm STRUCTURAL CONCRETE SIDEWALK.	B100 - 90 - 19, 23, 24
⑲ RECONSTRUCT APPROACH SLABS AND IMMEDIATE ROADWAY SLABS TO SUIT NEW ROAD GRADES, COMPLETE WITH REINFORCED GRANULAR BACKFILL AND MEDIAN SAFETY BARRIER.	B100 - 90 - 12A, 21A, 23, 24
⑳ REMOVE AND DELIVER EXISTING G.R.E.A.T. BARRIER ON EMPRESS ST. TO CITY YARD.	B100 - 90 - 23
㉑ RESURFACE ASPHALT OVERLAY BEYOND RECONSTRUCTED ROADWAY SLABS.	B100 - 90 - 23
㉒ INSTALL BALANCED ALUMINUM SHOULDER BARRIERS.	B100 - 90 - 25, 26
㉓ CONSTRUCT CONCRETE SAFETY MEDIAN BARRIER AT NORTH ROADWAY.	B100 - 90 - 23
㉔ LIMITS OF RIGHT OF WAY	B100 - 90 - 23
㉕ RECONSTRUCT CENTRE MEDIAN, RELOCATE ALUMINUM BALANCE BARRIERS, INSTALL REMOVABLE CONCRETE BARRIERS & REMOVE, MODIFY AND RELOCATE G.R.E.A.T. UNITS ON PORTAGE AVENUE.	B100 - 90 - 3A, 26, 27, 28, 29, 30
㉖ REMOVE EXISTING VEHICLE RAMP TO MTS BUILDING.	B100 - 90 - 16, 23

B-5903-2

AS-BUILT
DATE 91.02.26 BY [Signature]
CHECKED BY [Signature]

B.M. ELEV.	DATE	BY

WARDROP ENGINEERING INC.	
DESIGNED BY J.C. & F.P.C.	CHECKED BY [Signature]
DRAWN BY G.R.A.	APPROVED BY [Signature]
HOR. SCALE: AS NOTED	VERTICAL: AS NOTED
DATE JAN. 15, 1990	DATE 91.02.26


ENGINEER'S SEAL
PROVINCE OF MANITOBA
C. D. STEWART
REGISTERED ENGINEER
CONSULTANT DRAWING NO. 890007-02-00

THE CITY OF WINNIPEG
WORKS AND OPERATIONS DIVISION
STREETS AND TRANSPORTATION DEPARTMENT

EMPRESS STREET OVERPASS
STRUCTURE REHABILITATION, STRENGTHENING AND RELATED WORKS

GENERAL ARRANGEMENT AND SCOPE OF WORK

CITY DRAWING NUMBER
B100-90-02A(R1)

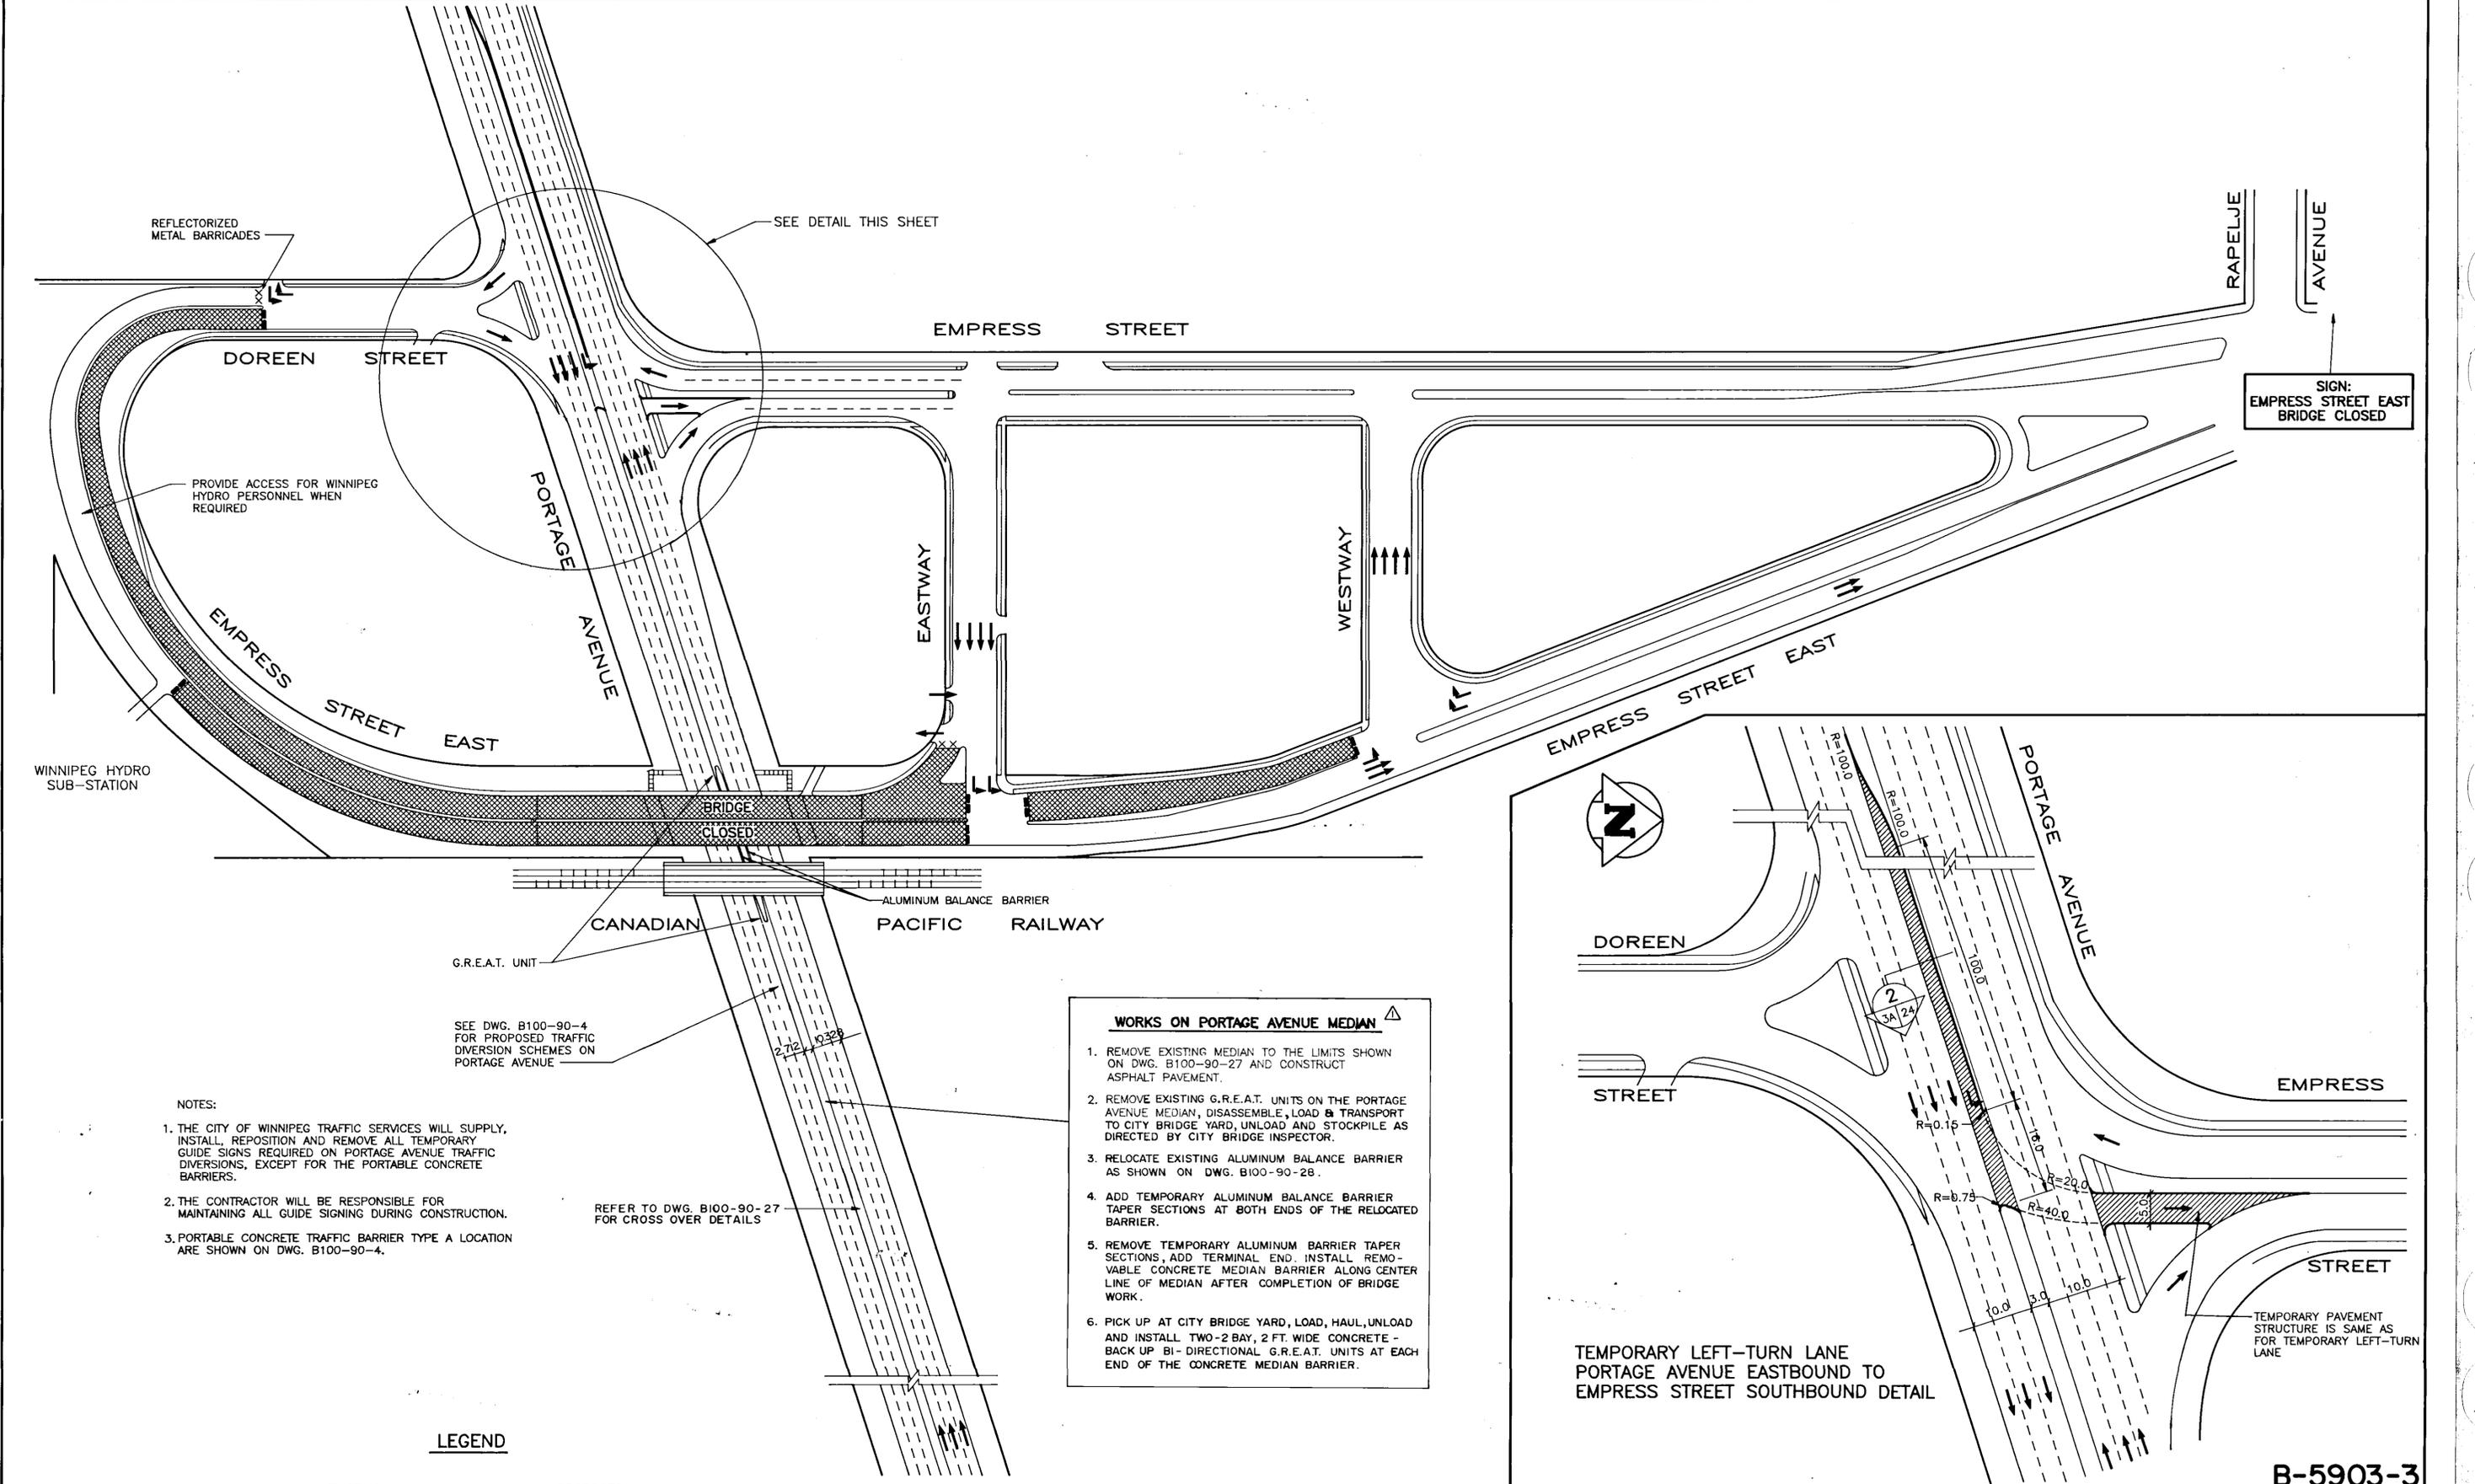

REFLECTORIZED METAL BARRICADES

SEE DETAIL THIS SHEET

SIGN: EMPRESS STREET EAST BRIDGE CLOSED

DOREEN STREET

EMPRESS STREET

RAPELJE AVENUE

PROVIDE ACCESS FOR WINNIPEG HYDRO PERSONNEL WHEN REQUIRED

PORTAGE AVENUE

EASTWAY

WESTWAY

EMPRESS STREET EAST

WINNIPEG HYDRO SUB-STATION

BRIDGE CLOSED

CANADIAN PACIFIC RAILWAY

G.R.E.A.T. UNIT

SEE DWG. B100-90-4 FOR PROPOSED TRAFFIC DIVERSION SCHEMES ON PORTAGE AVENUE

REFER TO DWG. B100-90-27 FOR CROSS OVER DETAILS


- WORKS ON PORTAGE AVENUE MEDIAN**
1. REMOVE EXISTING MEDIAN TO THE LIMITS SHOWN ON DWG. B100-90-27 AND CONSTRUCT ASPHALT PAVEMENT.
 2. REMOVE EXISTING G.R.E.A.T. UNITS ON THE PORTAGE AVENUE MEDIAN, DISASSEMBLE, LOAD & TRANSPORT TO CITY BRIDGE YARD, UNLOAD AND STOCKPILE AS DIRECTED BY CITY BRIDGE INSPECTOR.
 3. RELOCATE EXISTING ALUMINUM BALANCE BARRIER AS SHOWN ON DWG. B100-90-28.
 4. ADD TEMPORARY ALUMINUM BALANCE BARRIER TAPER SECTIONS AT BOTH ENDS OF THE RELOCATED BARRIER.
 5. REMOVE TEMPORARY ALUMINUM BARRIER TAPER SECTIONS, ADD TERMINAL END, INSTALL REMOVABLE CONCRETE MEDIAN BARRIER ALONG CENTER LINE OF MEDIAN AFTER COMPLETION OF BRIDGE WORK.
 6. PICK UP AT CITY BRIDGE YARD, LOAD, HAUL, UNLOAD AND INSTALL TWO-2 BAY, 2 FT. WIDE CONCRETE BACK UP BI-DIRECTIONAL G.R.E.A.T. UNITS AT EACH END OF THE CONCRETE MEDIAN BARRIER.

- NOTES:**
1. THE CITY OF WINNIPEG TRAFFIC SERVICES WILL SUPPLY, INSTALL, REPOSITION AND REMOVE ALL TEMPORARY GUIDE SIGNS REQUIRED ON PORTAGE AVENUE TRAFFIC DIVERSIONS, EXCEPT FOR THE PORTABLE CONCRETE BARRIERS.
 2. THE CONTRACTOR WILL BE RESPONSIBLE FOR MAINTAINING ALL GUIDE SIGNING DURING CONSTRUCTION.
 3. PORTABLE CONCRETE TRAFFIC BARRIER TYPE A LOCATION ARE SHOWN ON DWG. B100-90-4.

LEGEND

- | | |
|---|----------|
| EXISTING | PROPOSED |
| METAL BARRICADE | x |
| PORTABLE CONCRETE TRAFFIC BARRIER TYPE B | - |
| CLOSED TO TRAFFIC LIGHT STANDARD HYDRO POLE | ⊞ |

AS-BUILT
DATE 9/02/26 BY *ES*
CHECKED BY *fw*

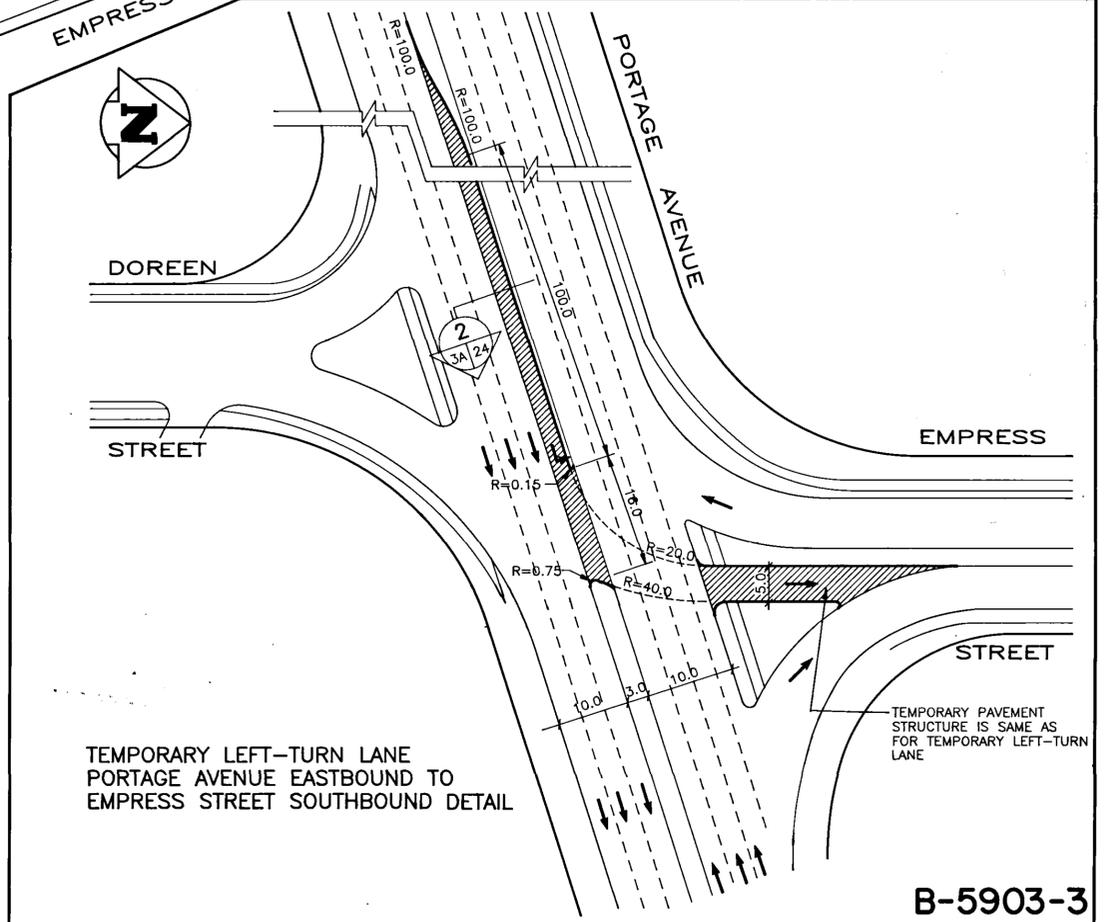


TEMPORARY LEFT-TURN LANE PORTAGE AVENUE EASTBOUND TO EMPRESS STREET SOUTHBOUND DETAIL


TEMPORARY PAVEMENT STRUCTURE IS SAME AS FOR TEMPORARY LEFT-TURN LANE

B-5903-3


B.M. ELEV.	WARDROP ENGINEERING INC.		ENGINEER'S SEAL PROVINCE OF MANITOBA G. O. OUELLETTE REGISTERED PROFESSIONAL ENGINEER	THE CITY OF WINNIPEG WORKS AND OPERATIONS DIVISION STREETS AND TRANSPORTATION DEPARTMENT
DESIGNED BY G.O.	CHECKED BY M.S.	DRAWN BY G.M.D.	APPROVED BY <i>Jos Labe</i>	EMPRESS STREET OVERPASS STRUCTURE REHABILITATION, STRENGTHENING AND RELATED WORKS
2 REVISED AS CONSTRUCTED 90-12-14 FPC	HOR. SCALE: 1:1000	AUTHORIZED BY <i>Jos Labe</i> DATE 90-12-23	CONSULTANT DRAWING NO. 890007-03-00	CITY DRAWING NUMBER B100-90-3A(RI)
ADDENDUM 90-3-12 G.O.	VERTICAL:	ACCEPTED BY <i>Jos Labe</i> DATE 90-02-23		ROADWAY RECONSTRUCTION DETOUR - ALTERNATIVE A COMPLETE CLOSURE ON BRIDGE
NO. REVISIONS	DATE	BY	DATE	

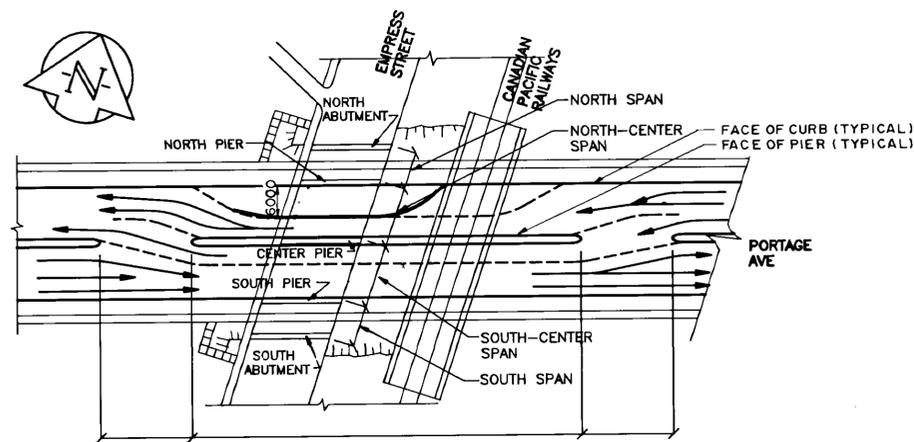


TYPE I

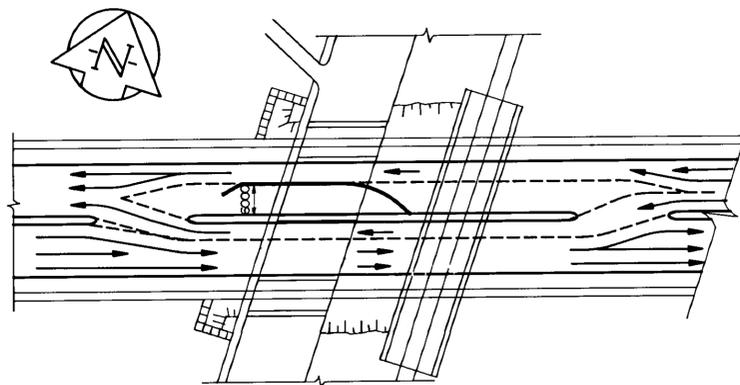


TYPE II

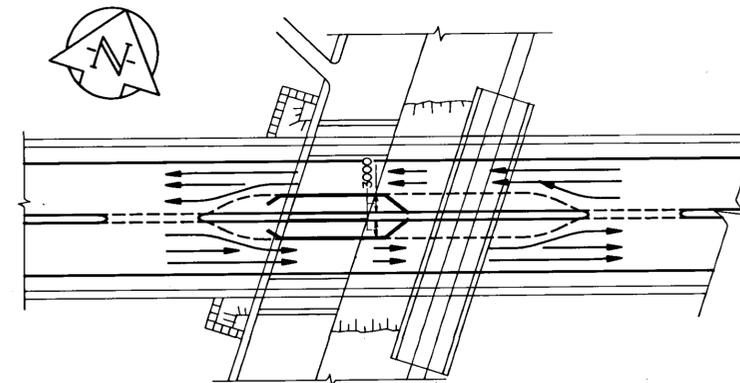


TYPE III

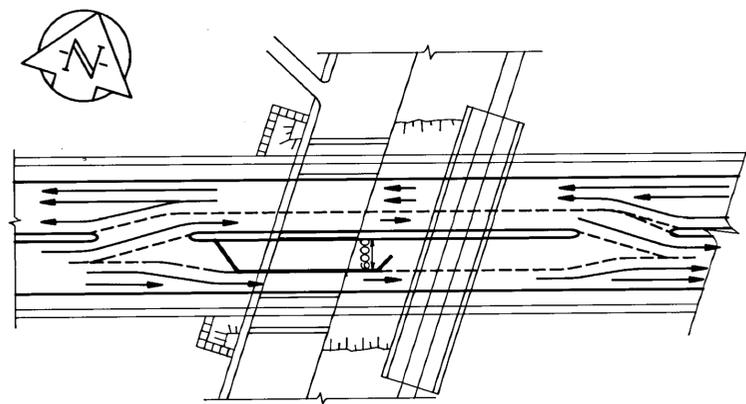


TYPE IV

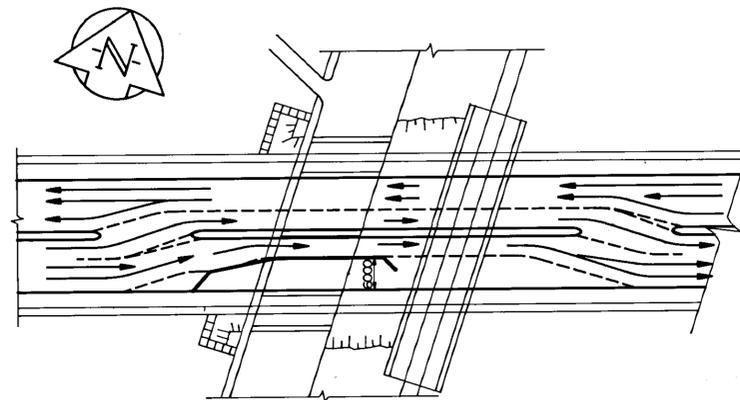


TYPE V

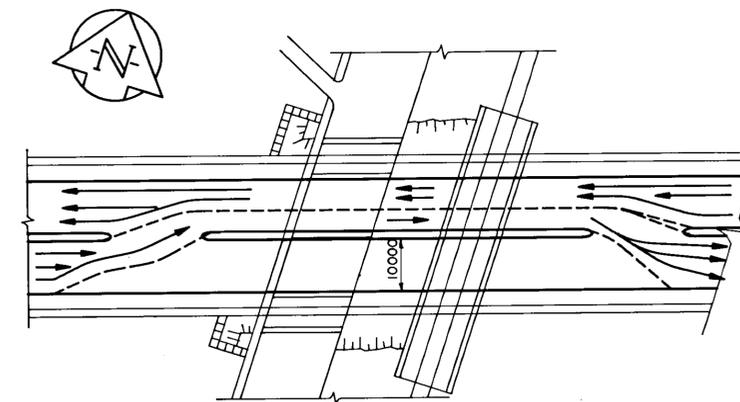


TYPE VI AM SUNDAY

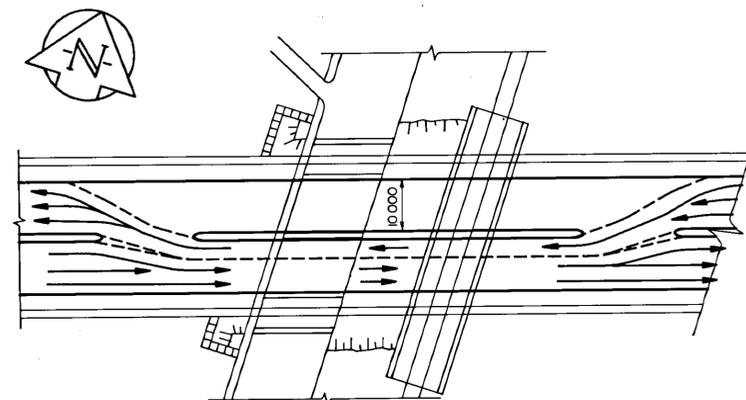

TYPE VI P.M. SUNDAY

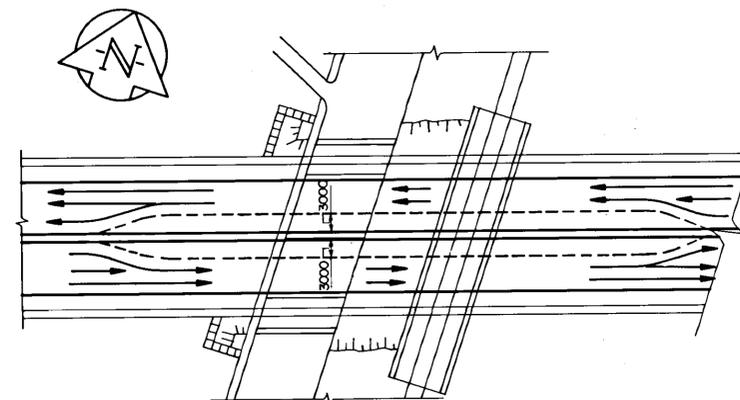

TYPE VII

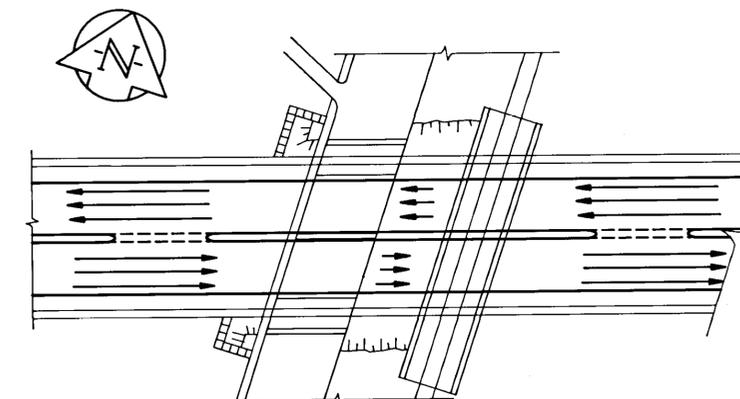

TYPE VIII

GENERAL NOTES:

- FOUR LANES OF TRAFFIC ALONG PORTAGE AVE. SHALL BE MAINTAINED AT ALL TIMES DURING CONSTRUCTION PERIOD EXCEPT DURING JACKING AND LOWERING OF THE BRIDGE SUPERSTRUCTURE.(TYPE VI TRAFFIC DIVERSION)
- INSTALLATION, REMOVAL AND RELOCATION OF PORTABLE CONCRETE BARRIERS ON PORTAGE AVE SHALL BE DONE BY THE CONTRACTOR.
- TRAFFIC SWITCHING (WHERE REQUIRED), JACKING AND LOWERING OF SUPERSTRUCTURE, SHALL BE DONE DURING SUNDAY ONLY.
- ANY CHANGE OF TRAFFIC DIVERSION PROPOSED BY CONTRACTOR SHALL BE SUBJECT FOR APPROVAL BY CONTRACT ADMINISTRATOR.
- DURING PEAK HOURS THE CITY MAY MODIFY TRAFFIC DIVERSIONS OUTSIDE THE CONTRACTOR'S WORK AREA.
- THE CONTRACTOR'S WORK AREA IS LIMITED TO TWO ADJACENT LANES UNLESS NOTED.

- CITY OF WINNIPEG TRAFFIC SERVICES MAY RESTRUCTURE THE TRAFFIC DIVERSIONS SHOWN IN OR TO PROVIDE THREE LANES OF TRAFFIC IN THE PEAK DIRECTION, HOWEVER THE CONTRACTORS WORK AREA WILL REMAIN CLOSED.
- REFER TO SCHEDULE OF WORK IN TENDER DOCUMENTS FOR SEQUENCING OF TRAFFIC DIVERSIONS DURING CONSTRUCTION.
- THE CONTRACTOR SHALL NOT INTERFERE OR INTERRUPT TRAFFIC FLOW ON PORTAGE AVENUE DURING CONSTRUCTION. ACCESS TO THE WORK AREA FOR MEN OR EQUIPMENT MUST BE MADE FROM OVERHEAD OR BY NOT CROSSING THE TRAVELLED LANES OR PRIOR TO ANY LANE CLOSURES.

LEGEND


- PORTABLE CONCRETE BARRIER TYPE A. (ALT. A ONLY)
- CONTRACTORS WORK AREA

AS-BUILT
DATE 9/22/26 BY *to*
CHECKED BY *fr*


△ DIMENSIONS SHOWN INDICATE MAXIMUM ALLOWABLE ROADWAY WORK AREA WIDTHS INCLUDING PORTABLE TRAFFIC BARRIERS.

B-5903-4


B.M. ELEV.		WARDROP ENGINEERING INC.		ENGINEER C. D. STEWART 90/02/20 REGISTERED ENGINEER		THE CITY OF WINNIPEG WORKS AND OPERATIONS DIVISION STREETS AND TRANSPORTATION DEPARTMENT		CITY DRAWING NUMBER B100-90-04(R)	
DESIGNED BY J.C. & F.P.C.		CHECKED BY <i>fr</i>		AUTHORIZED BY <i>to</i> DATE 9/22/26		CONSULTANT DRAWING NO. 890007-02-00		EMPRESS STREET OVERPASS STRUCTURE REHABILITATION, STRENGTHENING AND RELATED WORKS PORTAGE AVE. TRAFFIC DIVERSION TYPES	
DRAWN BY G.R.A.		APPROVED BY <i>to</i>		ACCEPTED BY <i>to</i> DATE 9/22/26		FPC			
HOR. SCALE: N.T.S.		VERTICAL: N.T.S.		DATE JAN 15, 1990					
2 REVISED AS CONSTRUCTED 90-12-14 FPC									
△ NOTE ADDED. 90-3-19 FPC									
NO. REVISIONS									

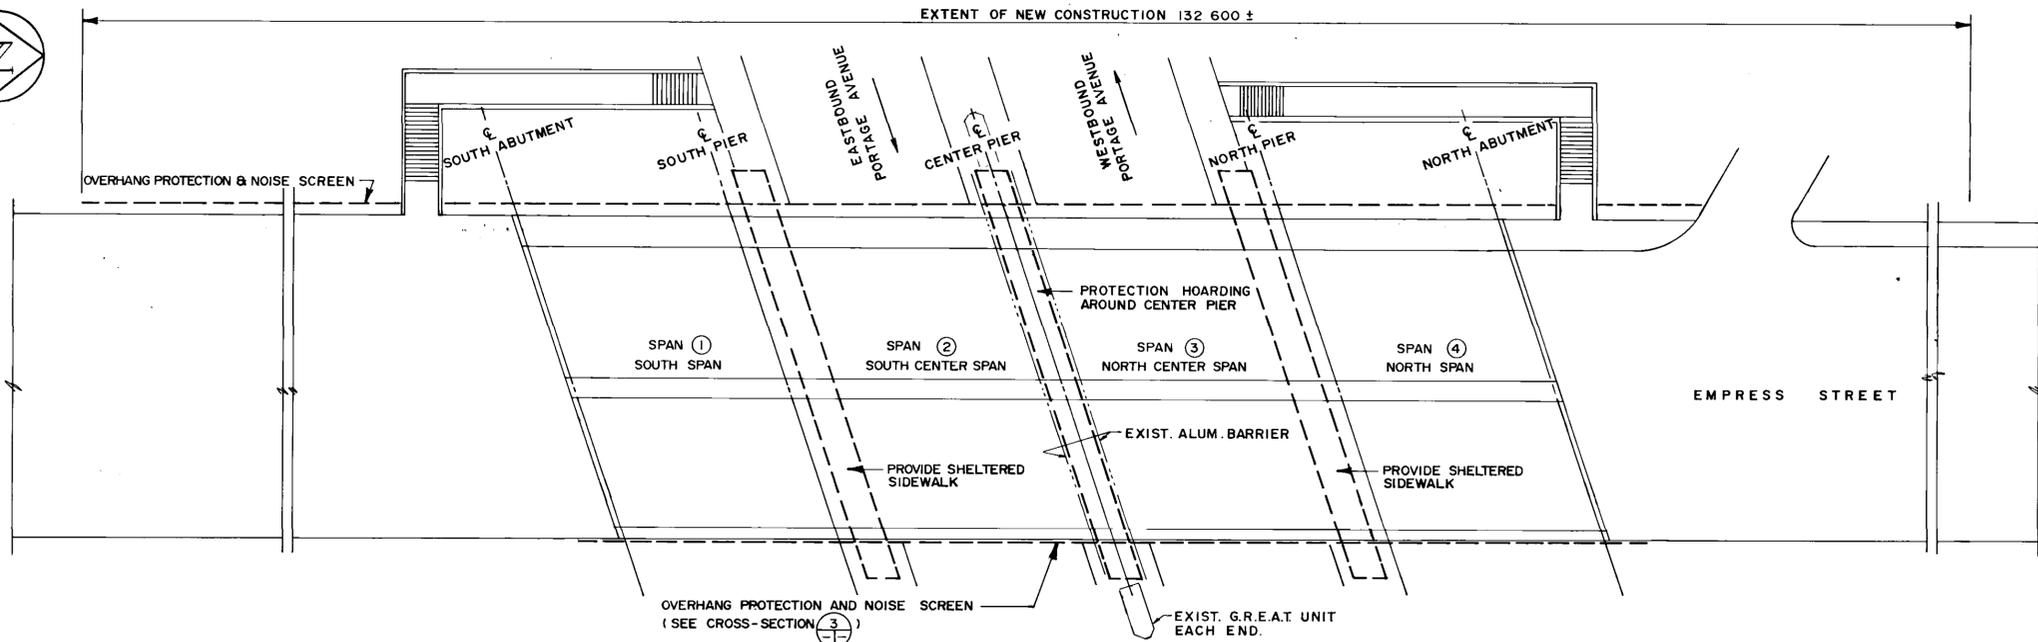

1 PLAN OF EXISTING BRIDGE
1" = 200

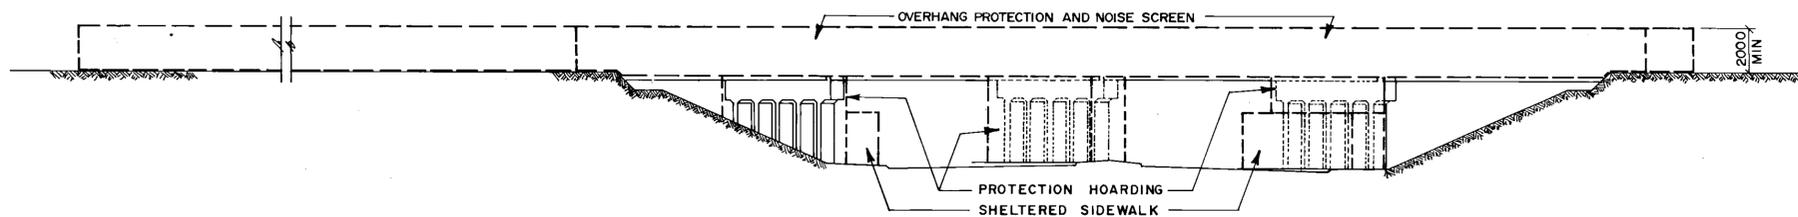

2 ELEVATION (LOOKING WEST)
1" = 200

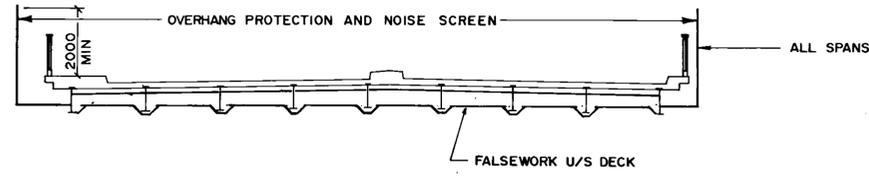

3 CROSS SECTION (LOOKING NORTH)
1" = 100


- NOTE:**
1. ALL OVERHANGING PROTECTION, NOISE SCREENS AND FALSEWORK U/S DECK, PIER HOARDING AND SHELTERED SIDEWALK SHALL BE IN PLACE FOR ENTIRE LENGTH OF CONSTRUCTION.
 2. SHOP DRAWINGS OF ALL TEMPORARY NOISE AND PROTECTION SCREENS AND FALSEWORK U/S DECK SHALL BE SUBMITTED TO THE CONTRACT ADMINISTRATOR FOR APPROVAL AT LEAST 10 WORKING DAYS PRIOR TO INSTALLATION.
 3. THE TEMPORARY NOISE AND PROTECTION SCREENS AND FALSEWORK U/S DECK SHALL BE DESIGNED BY A PROFESSIONAL ENGINEER REGISTERED IN THE PROVINCE OF MANITOBA.

B-5903-5


AS-BUILT
DATE 9/02/26 BY *[Signature]*
CHECKED BY *[Signature]*

LOCATION APPROVED UNDERGROUND STRUCTURES		B.M. ELEV.
N/A		
SUPV. U/G STRUCTURES COMMITTEE	DATE	
NOTE: LOCATION OF UNDERGROUND STRUCTURES AS SHOWN ARE BASED ON THE BEST INFORMATION AVAILABLE BUT NO GUARANTEE IS GIVEN THAT ALL EXISTING UTILITIES ARE SHOWN OR THAT THE GIVEN LOCATIONS ARE EXACT. CONFIRMATION OF EXISTENCE AND EXACT LOCATION OF ALL SERVICES MUST BE OBTAINED FROM THE INDIVIDUAL UTILITIES BEFORE PROCEEDING WITH CONSTRUCTION.		
NO. REVISIONS	DATE	BY
1	REVISED AS CONSTRUCTED 90-12-14	FPC


WARDROP ENGINEERING INC.	
DESIGNED BY JC & FPC	CHECKED BY <i>[Signature]</i>
DRAWN BY LG	APPROVED BY <i>[Signature]</i>
HOR. SCALE: AS NOTED	AUTHORIZED BY <i>[Signature]</i> DATE 90-02-23
VERTICAL: AS NOTED	ACCEPTED BY <i>[Signature]</i> DATE 90-02-23
DATE JAN. 15, 1990	REGISTERED ENGINEER

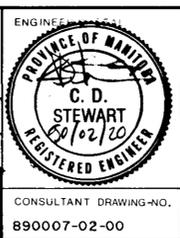


THE CITY OF WINNIPEG WORKS AND OPERATIONS DIVISION STREETS AND TRANSPORTATION DEPARTMENT	
EMPRESS STREET OVERPASS	
STRUCTURE REHABILITATION, STRENGTHENING AND RELATED WORKS	
TEMPORARY NOISE AND PROTECTION SCREEN REQUIREMENTS	
CITY DRAWING NUMBER	B100-90-05
CONSULTANT DRAWING-NO.	890007-02-00

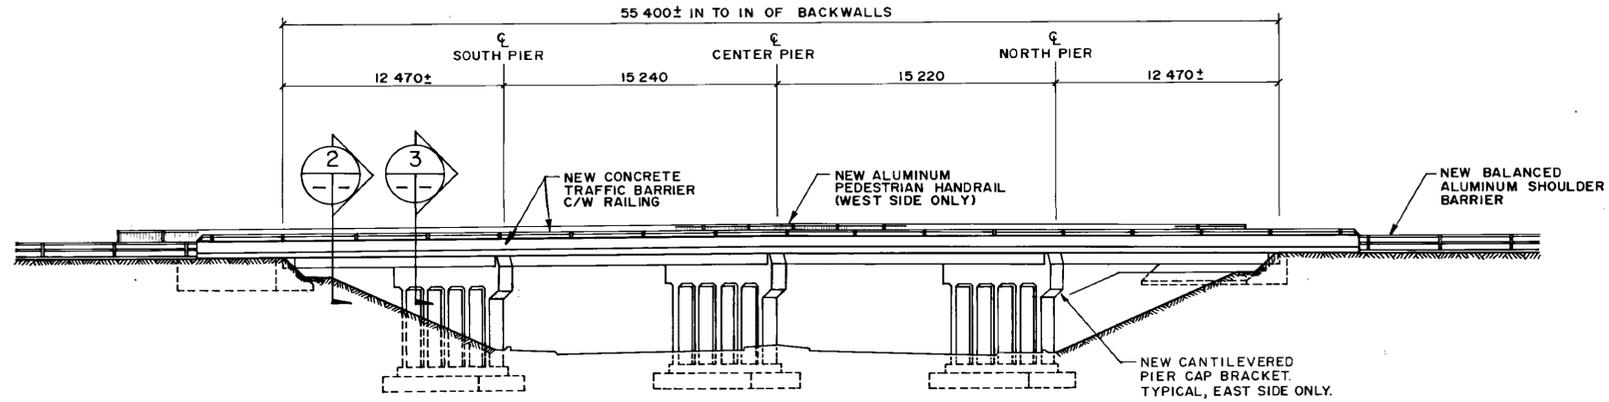

1 GENERAL ELEVATION AFTER REHABILITATION
1:200 (LOOKING WEST)

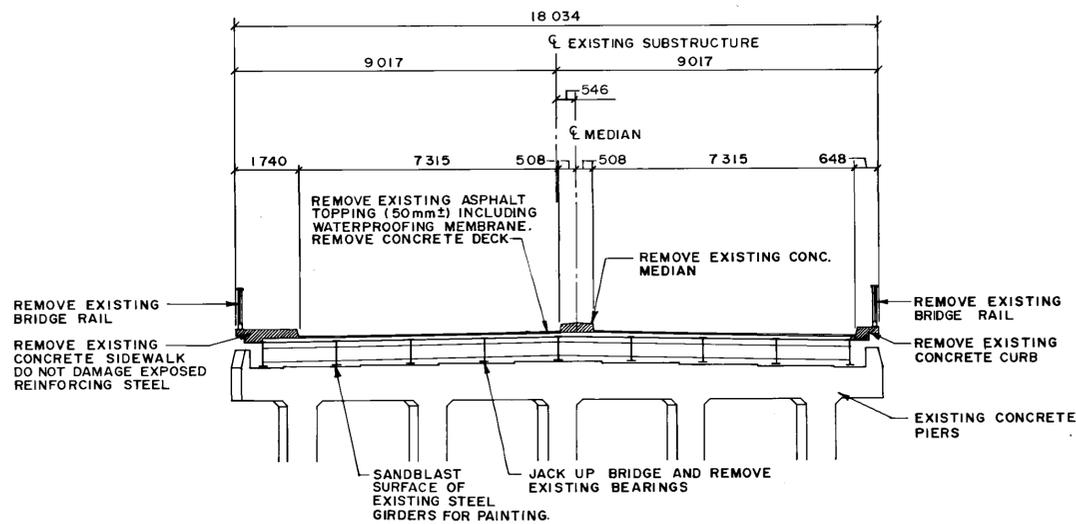

2 TYPICAL CROSS SECTION - DEMOLITION WORKS
1:100 (LOOKING NORTH)

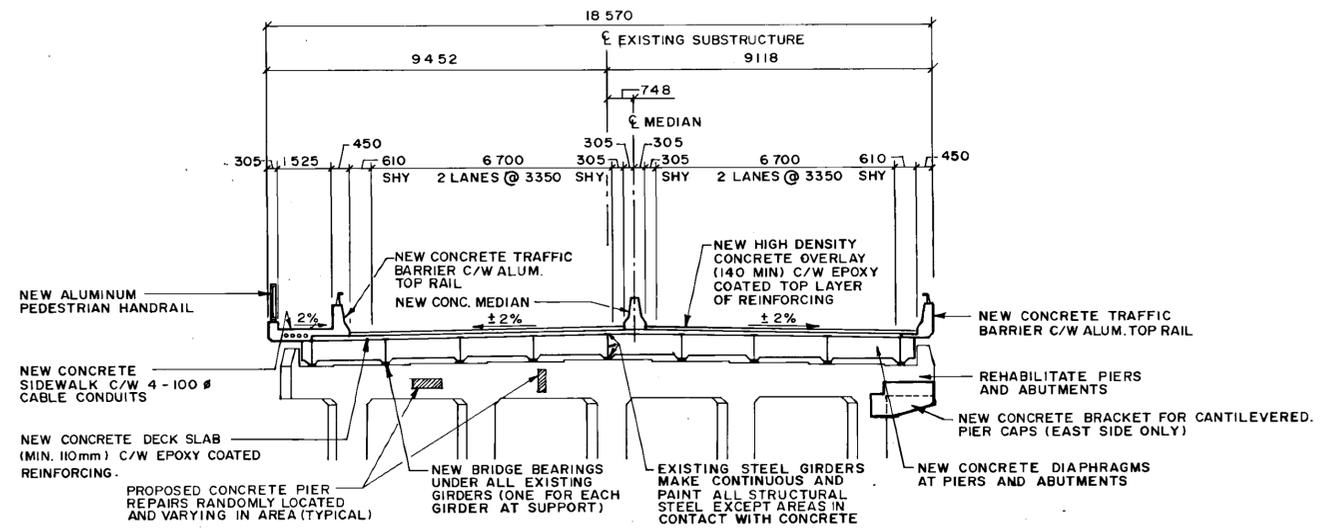

3 TYPICAL CROSS SECTION - NEW WORKS
1:100 (LOOKING NORTH)

B-5903-6

AS-BUILT
DATE 9/02/26 BY [Signature]
CHECKED BY [Signature]

LOCATION APPROVED UNDERGROUND STRUCTURES	B.M. ELEV.
N/A	
SUPV. U/G STRUCTURES COMMITTEE	
DATE	
NOTE:	
LOCATION OF UNDERGROUND STRUCTURES AS SHOWN ARE BASED ON THE BEST INFORMATION AVAILABLE BUT NO GUARANTEE IS GIVEN THAT ALL EXISTING UTILITIES ARE SHOWN OR THAT THE GIVEN LOCATIONS ARE EXACT CONFIRMATION OF EXISTENCE AND EXACT LOCATION OF ALL SERVICES MUST BE OBTAINED FROM THE INDIVIDUAL UTILITIES BEFORE PROCEEDING WITH CONSTRUCTION	
NO REVISIONS	DATE BY
1	REVISED AS CONSTRUCTED 9/02/26 FPC

DESIGNED BY	JC & FPC	CHECKED BY	[Signature]
DRAWN BY	LG	APPROVED BY	[Signature]
HOR SCALE	AS NOTED	AUTHORIZED BY	[Signature]
VERTICAL	AS NOTED	ACCEPTED BY	[Signature]
DATE	JAN. 15, 1990	DATE	9/22/23

WARDROP ENGINEERING INC.

ENGINEER

CONSULTANT DRAWING NO. 890007-02-00


PROVINCE OF MANITOBA
C. D. STEWART
REGISTERED ENGINEER
9/20/23

THE CITY OF WINNIPEG
WORKS AND OPERATIONS DIVISION
STREETS AND TRANSPORTATION DEPARTMENT


EMPRESS STREET OVERPASS
STRUCTURE REHABILITATION, STRENGTHENING AND RELATED WORKS

GENERAL ELEVATION AND CROSS SECTIONS


CITY DRAWING NUMBER B100-90-06A

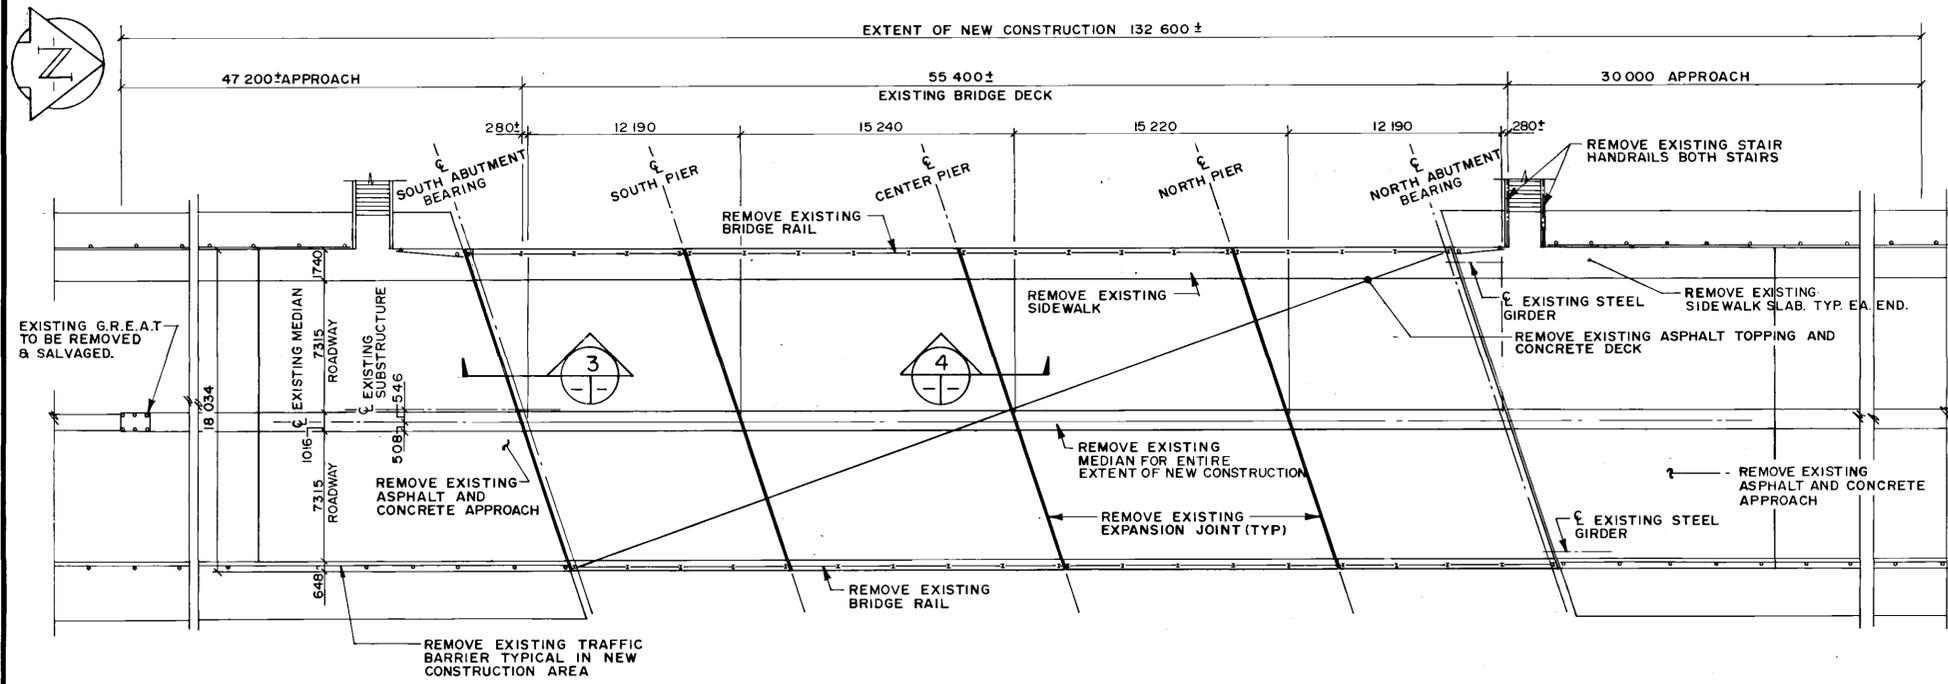


1 PLAN OF BRIDGE DECK
1:200

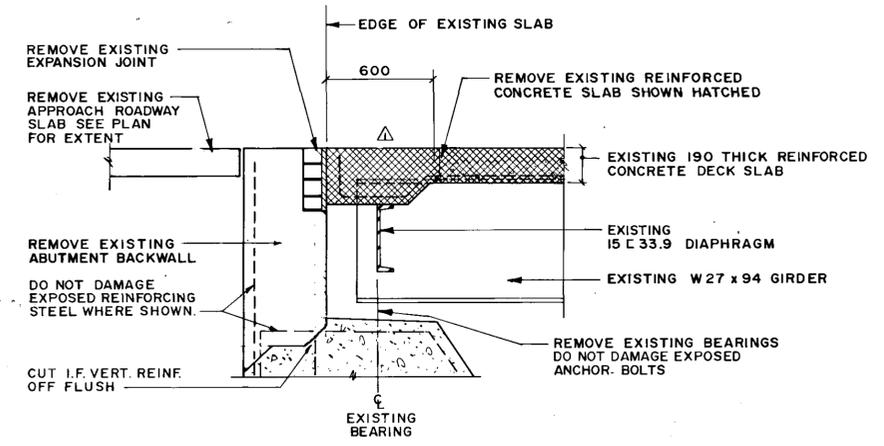


3 SECTION - EXISTING DIAPHRAGM AT ABUTMENT
1:20

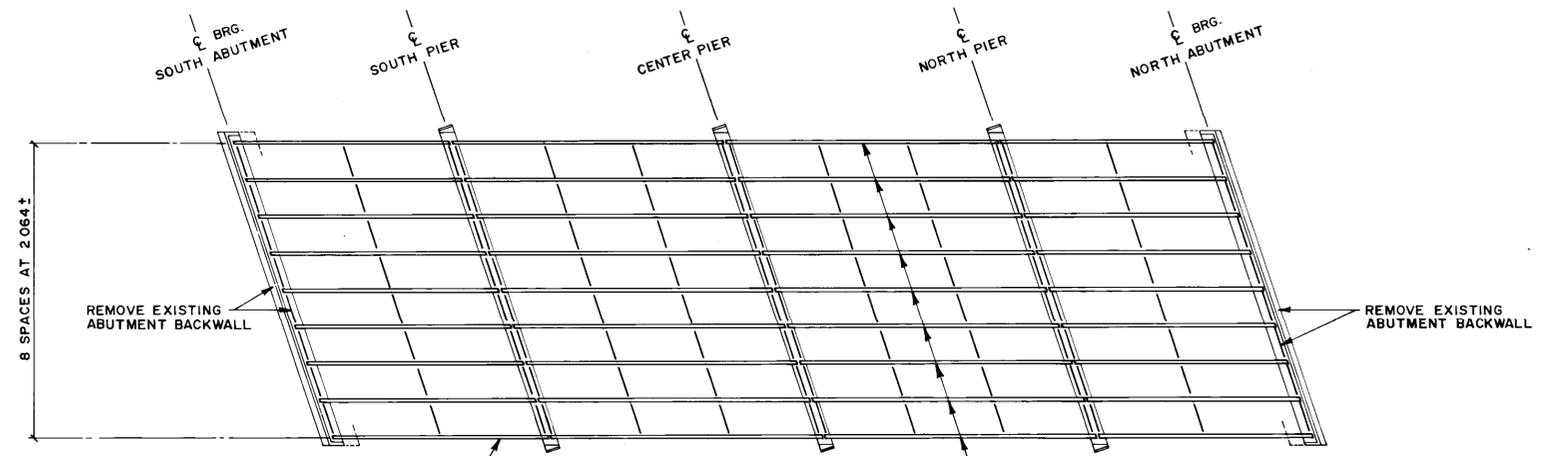

2 PLAN OF GIRDERS & SUBSTRUCTURE
1:200

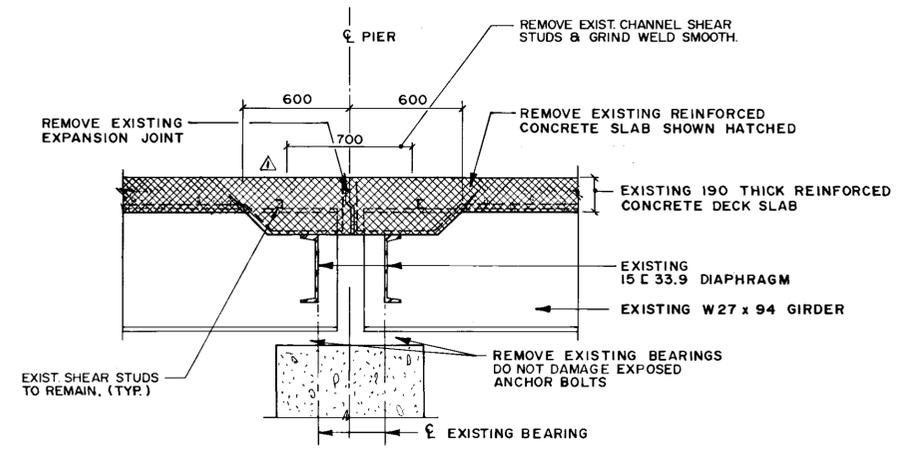

4 TYP. SECTION - EXISTING DIAPHRAGM AT PIERS
1:20

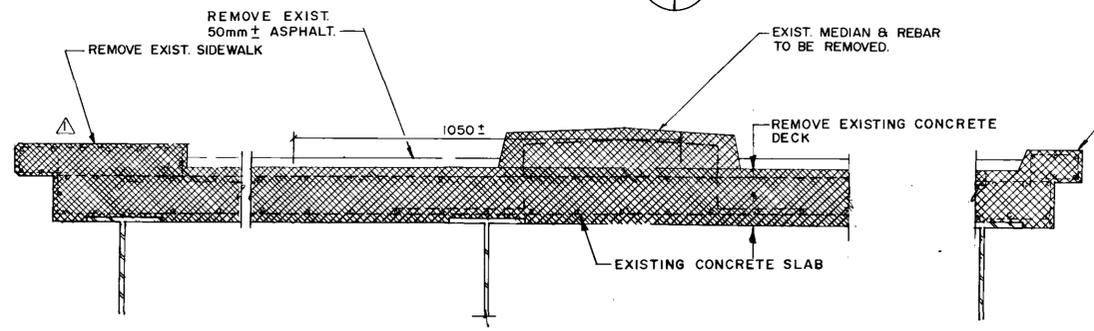

5 SECTION - SHOWING EXISTING DECK SLAB
NTS

AS-BUILT
DATE 31.02.26 BY [Signature]
CHECKED BY [Signature]

LOCATION APPROVED UNDERGROUND STRUCTURES
N/A
SUPV. U/G STRUCTURES COMMITTEE DATE
NOTE:
LOCATION OF UNDERGROUND STRUCTURES AS SHOWN ARE BASED ON THE BEST INFORMATION AVAILABLE BUT NO GUARANTEE IS GIVEN THAT ALL EXISTING UTILITIES ARE SHOWN OR THAT THE GIVEN LOCATIONS ARE EXACT. CONFIRMATION OF EXISTENCE AND EXACT LOCATION OF ALL SERVICES MUST BE OBTAINED FROM THE INDIVIDUAL UTILITIES BEFORE PROCEEDING WITH CONSTRUCTION

NO	REVISIONS	DATE	BY
2	REVISED AS CONSTRUCTED	90-2-14	FPC
	ADDENDUM	90-3-19	G.A.

WARDROP ENGINEERING INC.
DESIGNED BY JC & FPC
DRAWN BY LG
CHECKED BY [Signature]
APPROVED BY [Signature]
AUTHORIZED BY [Signature] DATE 90-2-23
ACCEPTED BY [Signature] DATE 90-2-23
G.R. SMITH BRIDGE ENGINEER

ENGINEER
C. D. STEWART
REGISTERED ENGINEER
CONSULTANT DRAWING NO. 890007-02-00







THE CITY OF WINNIPEG
WORKS AND OPERATIONS DIVISION
STREETS AND TRANSPORTATION DEPARTMENT

EMPRESS STREET OVERPASS
STRUCTURE REHABILITATION, STRENGTHENING AND RELATED WORKS

PLANS SHOWING LIMITS OF DEMOLITION

CITY DRAWING NUMBER
B100-90-07(R1)

B-5903-7

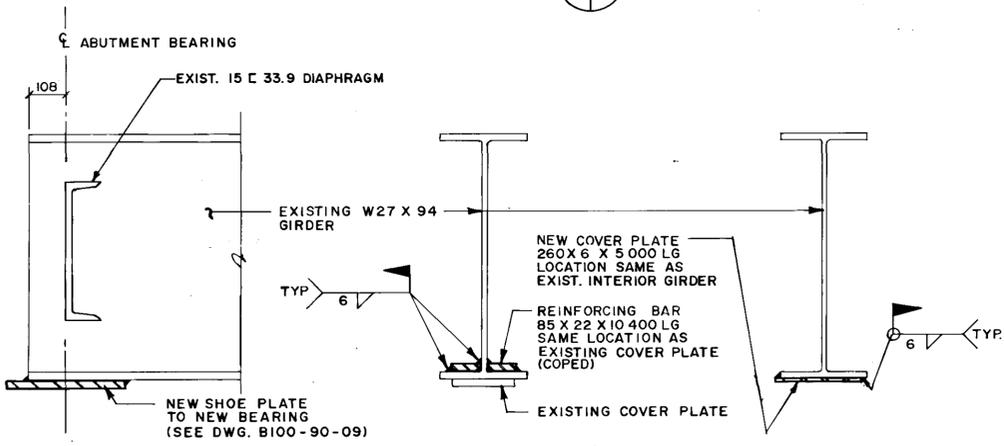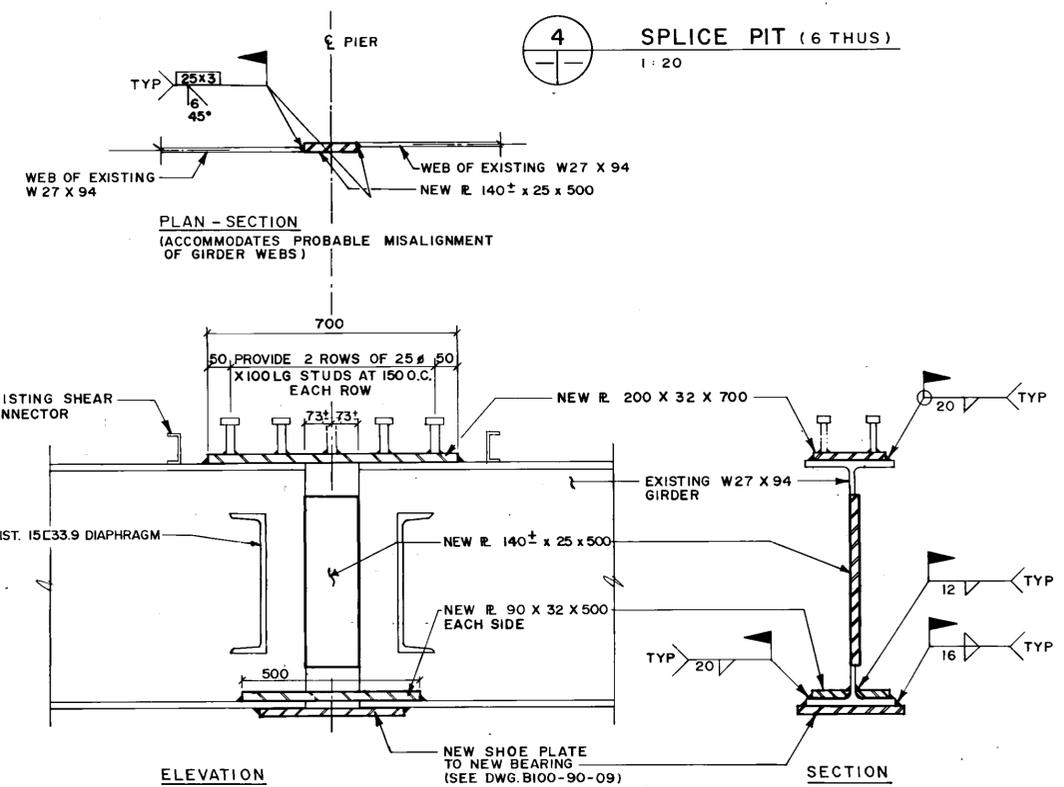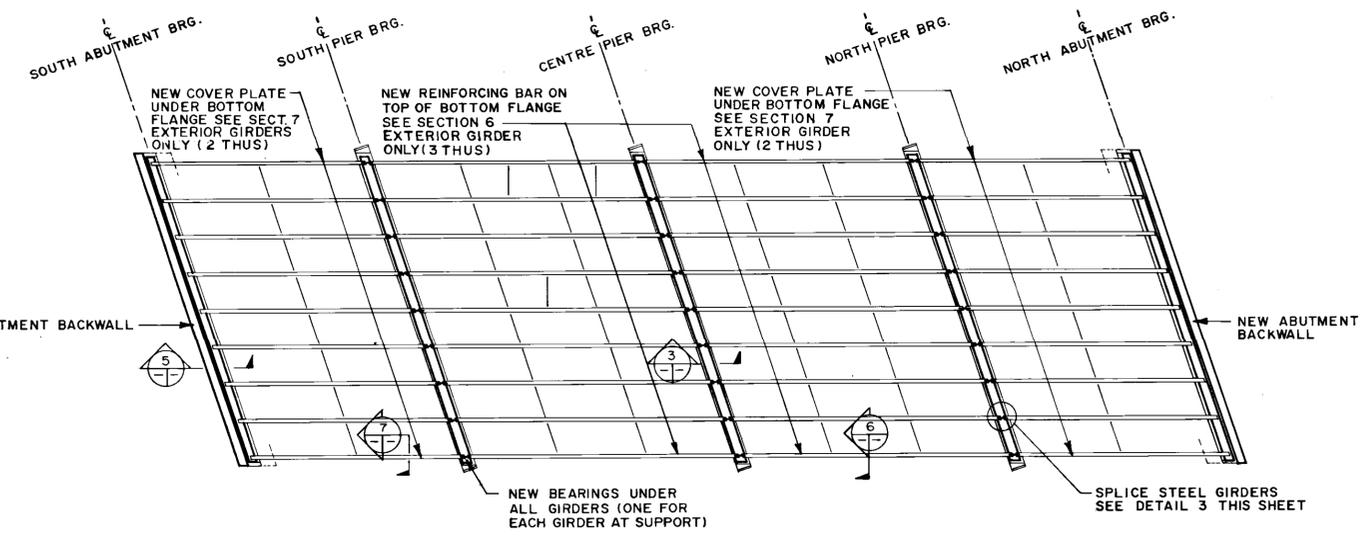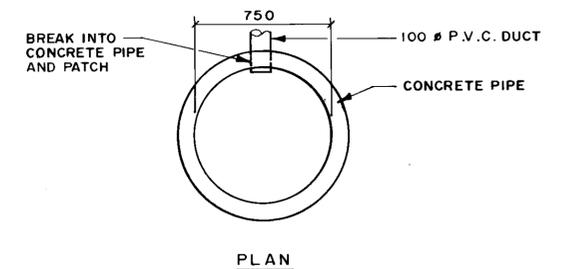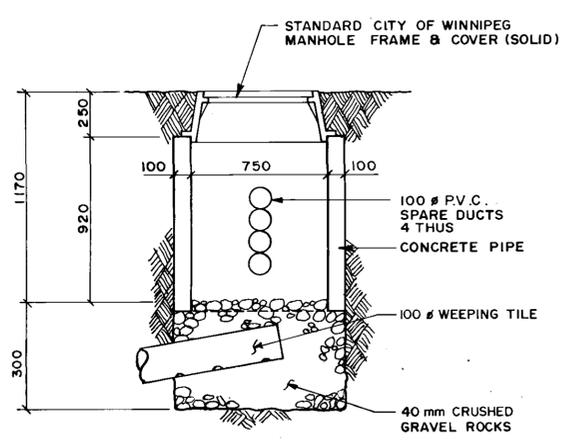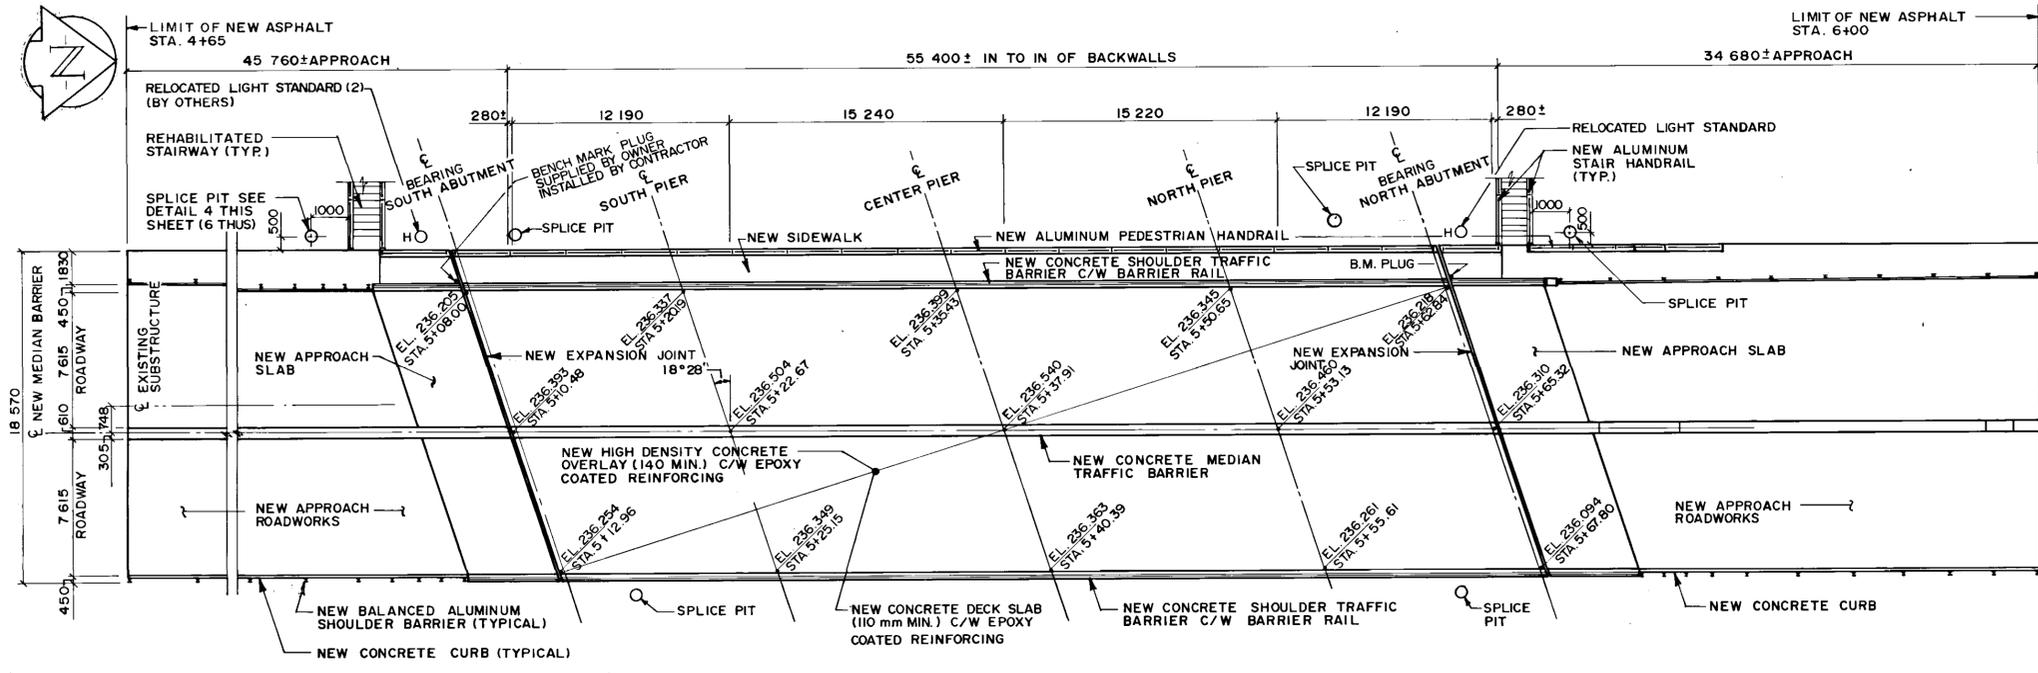

AS-BUILT
DATE 31-02-24 BY [Signature]
CHECKED BY [Signature]

LOCATION APPROVED UNDERGROUND STRUCTURES
N/A
SUPV. U/G STRUCTURES COMMITTEE DATE
NOTE:
LOCATION OF UNDERGROUND STRUCTURES AS SHOWN ARE BASED ON THE BEST INFORMATION AVAILABLE BUT NO GUARANTEE IS GIVEN THAT ALL EXISTING UTILITIES ARE SHOWN OR THAT THE GIVEN LOCATIONS ARE EXACT. CONFIRMATION OF EXISTENCE AND EXACT LOCATION OF ALL SERVICES MUST BE OBTAINED FROM THE INDIVIDUAL UTILITIES BEFORE PROCEEDING WITH CONSTRUCTION.




NO	REVISIONS	DATE	BY
1	REVISED AS CONSTRUCTED	30-12-14	FPC

WARDROP ENGINEERING INC.
DESIGNED BY JC & FPC
DRAWN BY LG
HOR SCALE AS NOTED
VERTICAL
JAN. 15, 1990

ENGINEER
C. D. STEWART
REGISTERED ENGINEER
CONSULTANT DRAWING NO. 890007-02-00

THE CITY OF WINNIPEG
WORKS AND OPERATIONS DIVISION
STREETS AND TRANSPORTATION DEPARTMENT
EMPRESS STREET OVERPASS
STRUCTURE REHABILITATION, STRENGTHENING AND RELATED WORKS
PLANS SHOWING LIMITS OF NEW WORKS
CITY DRAWING NUMBER B100-90-08


B-5903-8

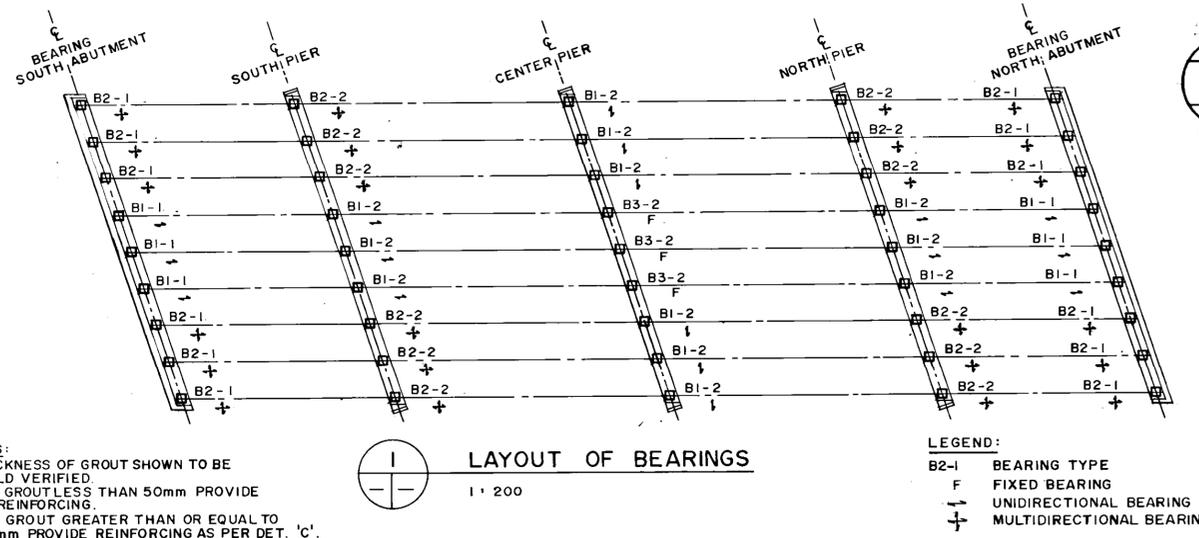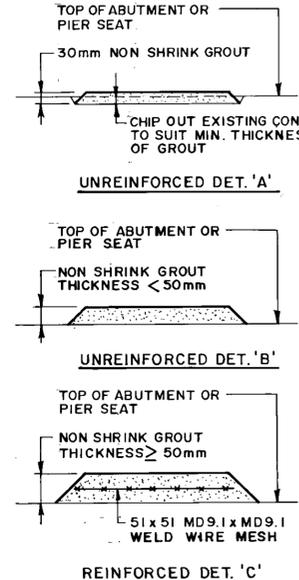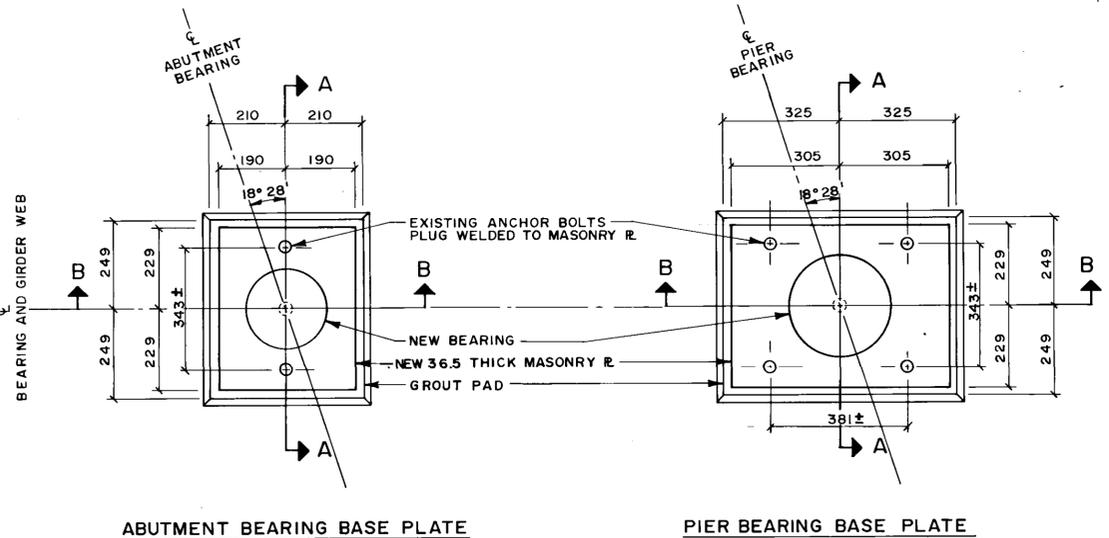


NOTES:
 1. THICKNESS OF GROUT SHOWN TO BE FIELD VERIFIED
 2. FOR GROUT LESS THAN 50mm PROVIDE NO REINFORCING.
 3. FOR GROUT GREATER THAN OR EQUAL TO 50mm PROVIDE REINFORCING AS PER DET. 'C'.

LEGEND:
 B2-1 BEARING TYPE
 F FIXED BEARING
 U UNIDIRECTIONAL BEARING
 M MULTIDIRECTIONAL BEARING

2 TYPICAL BEARING PLANS
 Scale: 1:10

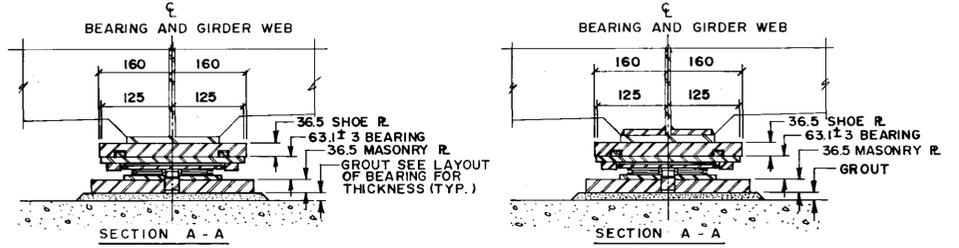


7 GROUT DETAILS
 NTS NOTE: ANCHOR BOLTS NOT SHOWN SEE DETAIL 6 BELOW

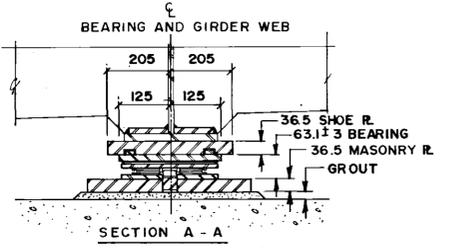







BEARING DESIGN DATA										
LOCATION	SOUTH ABUTMENT		SOUTH PIER		CENTER PIER		NORTH PIER		NORTH ABUTMENT	
BEARING TYPE	B1-1	B2-1	B1-2	B2-2	B1-2	B3-2	B1-2	B2-2	B1-1	B2-1
NUMBER REQUIRED	3	6	3	6	6	3	3	6	3	6
DEAD LOAD (KN)	135	135	420	420	430	430	420	420	135	135
DEAD LOAD+LIVE LOAD (KN)	370	370	455	455	460	460	455	455	370	370
LATERAL LOAD (KN)	10	—	20	—	—	25	20	—	10	—
LONGITUDINAL LOAD (KN)	—	—	—	—	95	95	—	—	—	—
LONGITUDINAL MOVEMENT *	+3	+3	+2	+2	—	—	+2	+2	+3	+3
LATERAL MOVEMENT * (MAX. FOR EXTERIOR GIRDER BRGS.)	-16	-16	-9	-9	-4	-4	-9	-9	-16	-16
SHOE PLATE	420 x 320	410 x 350	420 x 320	410 x 350	420 x 410	410 x 350	420 x 320	410 x 350	420 x 320	410 x 350
BEARING TOP PLATE	390 x 250	310 x 230	390 x 250	310 x 230	390 x 250	210 #	390 x 250	310 x 230	390 x 250	310 x 230
L1 *	157	157	151	151	—	—	151	151	157	157
L2 *	148	148	146	146	—	—	146	146	148	148

NOTES:
 * AT TEMPERATURE OF +20°C.
 DIFFERENCE IN TEMPERATURE MOVEMENT DUE TO DIFFERENT INSTALLATION TEMPERATURE:
 1. IN LONGITUDINAL DIRECTION
 a) AT NORTH AND SOUTH ABUTMENTS = 1.5mm PER 5°C.
 b) AT NORTH AND SOUTH PIERS = 0.8mm PER 5°C
 2. IN LATERAL DIRECTION FOR ALL EXTERIOR GIRDER BEARINGS AT ALL ABUTMENTS AND PIERS = 0.4mm PER 5°C

NOTES:
 1. BEARING SEAT ELEVATIONS SET TO SUIT ACTUAL HEIGHT OF BEARINGS.
 2. BEARING DESIGN TO ALLOW FOR FUTURE JACKING OF BRIDGE TO A MAXIMUM OF 5mm FOR BEARING REPLACEMENT.
 3. SHOE PLATE AND BEARING TOP PLATE TO BE INSTALLED IN ACCORDANCE WITH TABLE OF SETTING DIMENSIONS.
 4. BEARING DESIGN SHALL ALLOW FOR AN EXTRA 50mm MOVEMENT BEYOND VALUES SPECIFIED IN DESIGN DATA TABLE.

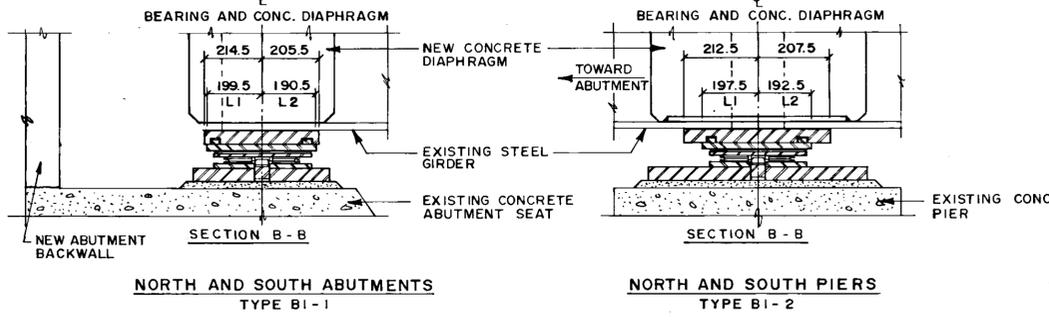

3 UNIDIRECTIONAL BEARINGS
 Scale: 1:10

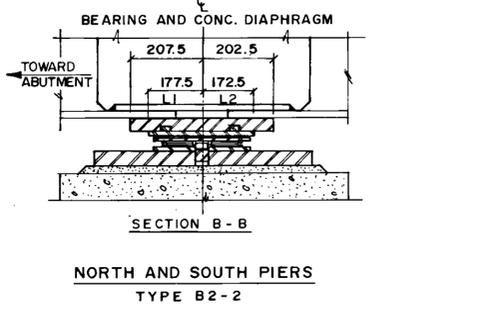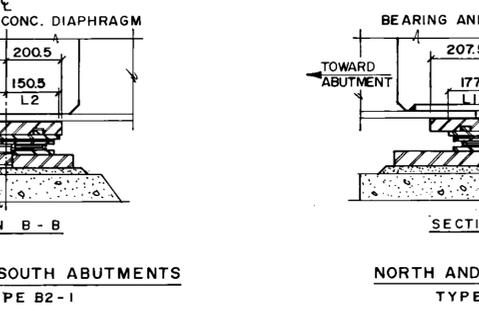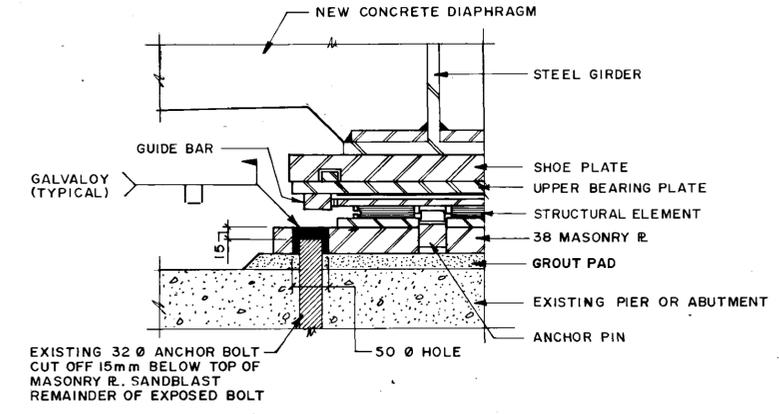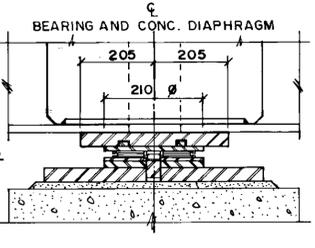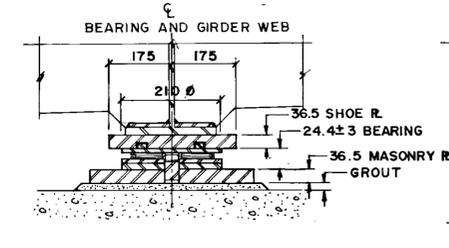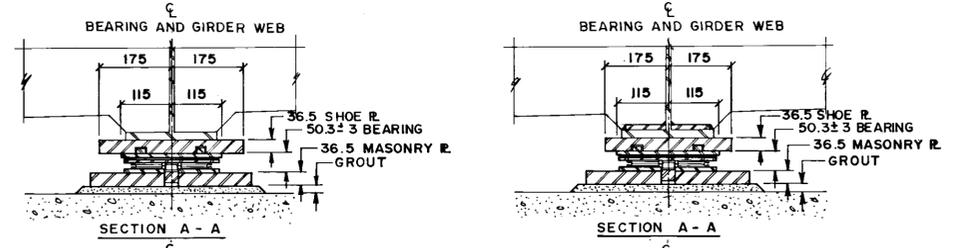

5 FIXED BEARINGS
 Scale: 1:10


AS-BUILT
 DATE 9/02/26 BY [Signature]
 CHECKED BY [Signature]

6 TYPICAL ANCHOR BOLT DETAIL
 Scale: 1:5


4 MULTIDIRECTIONAL BEARINGS
 Scale: 1:10

LOCATION APPROVED UNDERGROUND STRUCTURES N/A SUPV U/G STRUCTURES COMMITTEE DATE NOTE: LOCATION OF UNDERGROUND STRUCTURES AS SHOWN ARE BASED ON THE BEST INFORMATION AVAILABLE BUT NO GUARANTEE IS GIVEN THAT THE GIVEN LOCATIONS ARE EXACT CONFIRMATION OF EXISTENCE AND EXACT LOCATION OF ALL SERVICES MUST BE OBTAINED FROM THE INDIVIDUAL UTILITIES BEFORE PROCEEDING WITH CONSTRUCTION	B.M. ELEV. [Table with empty cells]	WARDROP ENGINEERING INC. DESIGNED BY JC & FPC DRAWN BY LG HOR SCALE AS NOTED VERTICAL AUTHORIZED BY [Signature] DATE 09/02/23 ACCEPTED BY [Signature] DATE 09/02/23 CONSULTANT DRAWING NO. 890007-02-00	ENGINEER C. D. STEWART REGISTERED ENGINEER CONSULTANT DRAWING NO. 890007-02-00	THE CITY OF WINNIPEG WORKS AND OPERATIONS DIVISION STREETS AND TRANSPORTATION DEPARTMENT EMPRESS STREET OVERPASS STRUCTURE REHABILITATION, STRENGTHENING AND RELATED WORKS BEARING DETAILS	CITY DRAWING NUMBER B100-90-09


B-5903-9

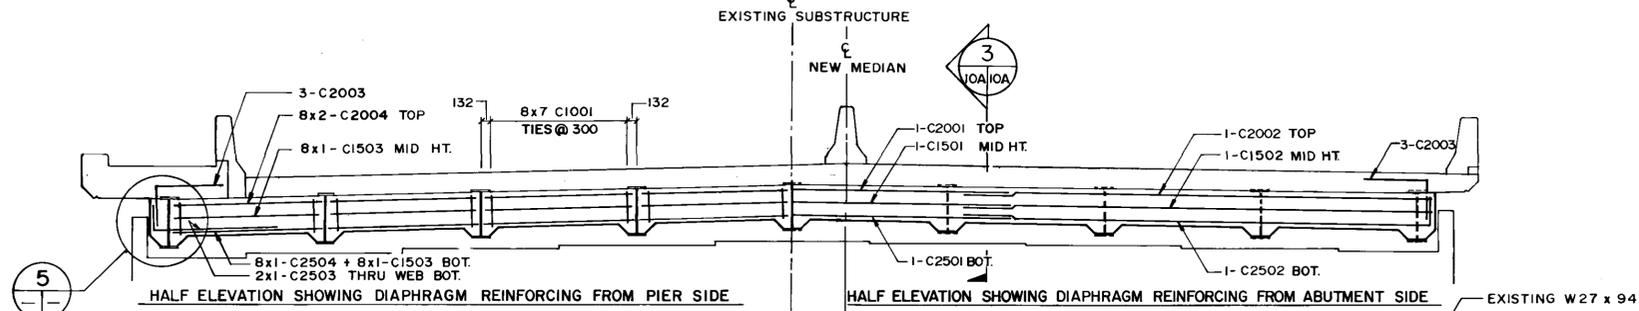


1 ELEVATION - AT ABUTMENT
1:50 (2 DIAPHRAGMS THUS)

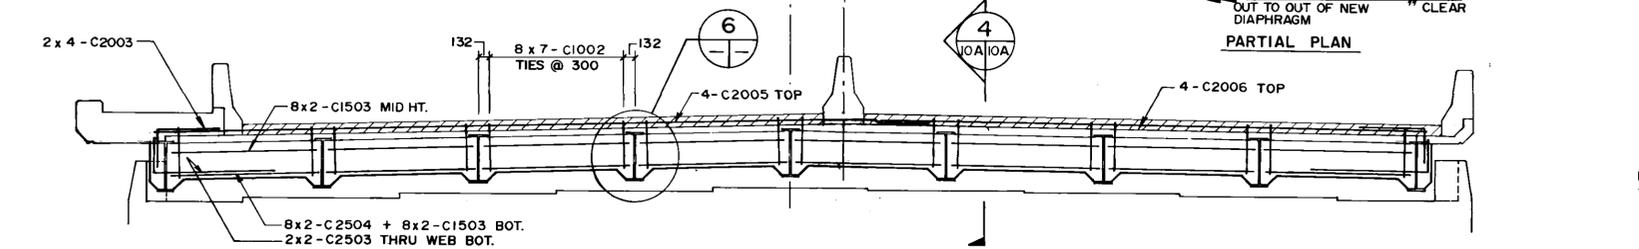

2 ELEVATION - AT PIER
1:50 (3 DIAPHRAGMS THUS)

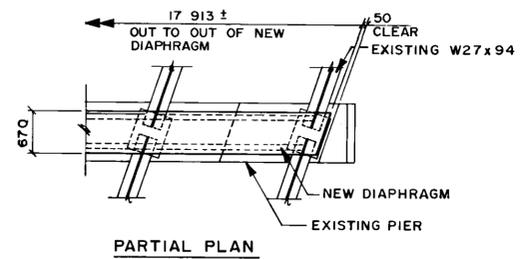


PARTIAL PLAN

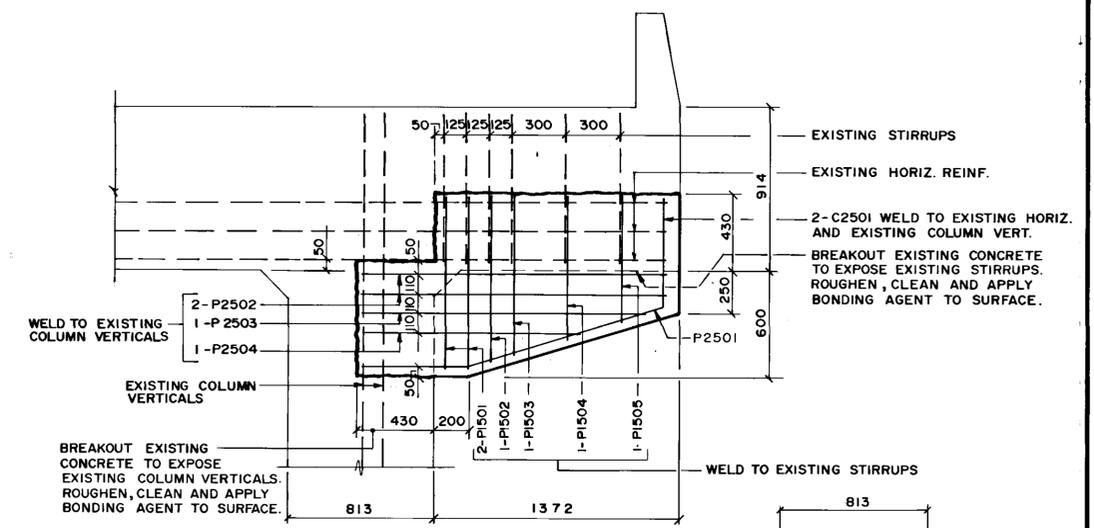

ELEVATION

SECTION


7 NEW CONCRETE BRACKET AT EXISTING PIER CAP
1:20 EAST SIDE ONLY 3 LOCATIONS THUS

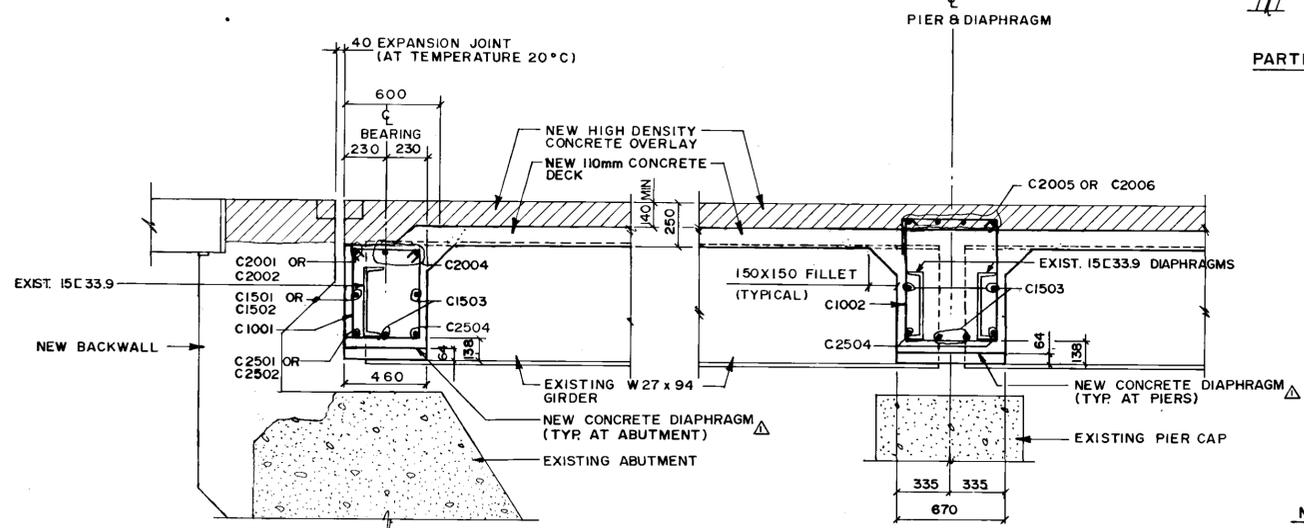


3 SECTION - AT ABUTMENT
1:20

4 SECTION - AT PIER
1:20

- NOTES FOR EXISTING CONDUITS & OTHER UTILITIES**
1. DISMANTLING OF EXISTING UTILITIES AND OTHER OUTLETS UNDER THE BRIDGE SHOULD BE PROPERLY COORDINATED TO CORRESPONDING AGENCIES.
 2. ACTUAL LOCATIONS OF EXISTING UTILITIES SHOULD BE VERIFIED IN THE FIELD BEFORE PROCEEDING WITH CONSTRUCTION.

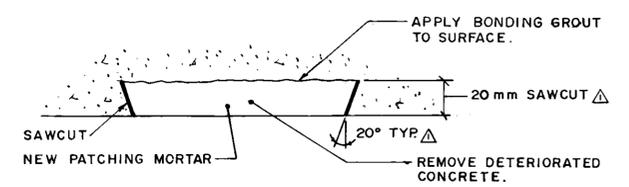

9 DETAIL
N.T.S.

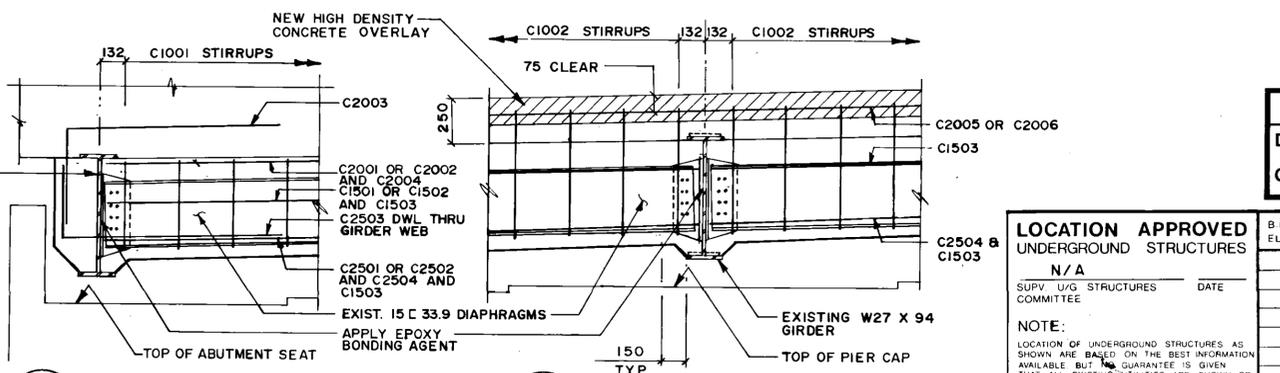

5 DETAIL - AT ABUTMENT
1:20

6 DETAIL - AT PIER
1:20

AS-BUILT
DATE 91.02.26 BY *[Signature]*
CHECKED BY *[Signature]*

LOCATION APPROVED UNDERGROUND STRUCTURES

N/A


SUPV. U/G STRUCTURES COMMITTEE DATE

NOTE: LOCATION OF UNDERGROUND STRUCTURES AS SHOWN ARE BASED ON THE BEST INFORMATION AVAILABLE BUT NO GUARANTEE IS GIVEN THAT ALL EXISTING UTILITIES ARE SHOWN OR THAT THE GIVEN LOCATIONS ARE EXACT CONFIRMATION OF EXISTENCE AND EXACT LOCATION OF ALL SERVICES MUST BE OBTAINED FROM THE INDIVIDUAL UTILITIES BEFORE PROCEEDING WITH CONSTRUCTION

NO	REVISIONS	DATE	BY
2	REVISED AS CONSTRUCTED	90/2-14	FPC
1	ADDENDUM	90/3-9	FPC

WARDROP ENGINEERING INC.

DESIGNED BY	JC & FPC	CHECKED BY	<i>[Signature]</i>
DRAWN BY	LG	APPROVED BY	<i>[Signature]</i>
HOR SCALE	AS NOTED	AUTHORIZED BY	DATE
VERTICAL	AS NOTED	DATE	91.12.23
DATE	JAN. 15, 1990	DATE	90.12.25

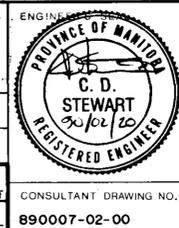

THE CITY OF WINNIPEG
WORKS AND OPERATIONS DIVISION
STREETS AND TRANSPORTATION DEPARTMENT


EMPRESS STREET OVERPASS
STRUCTURE REHABILITATION, STRENGTHENING AND RELATED WORKS

DIAPHRAGM DETAILS AND PIER CAP REINFORCING


CITY DRAWING NUMBER
B100-90-10A(RI)

CONSULTANT DRAWING NO.
890007-02-00


B-5903-10

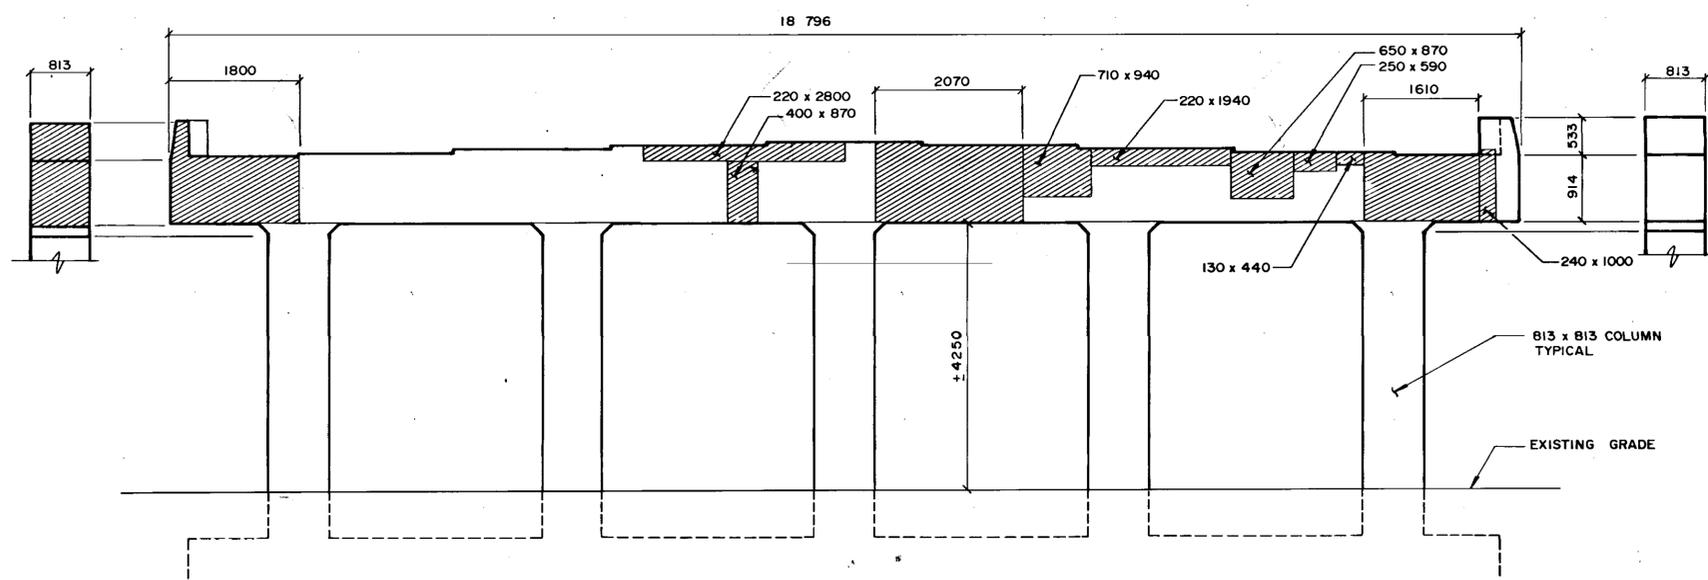

1 NORTH ELEVATION
1:50

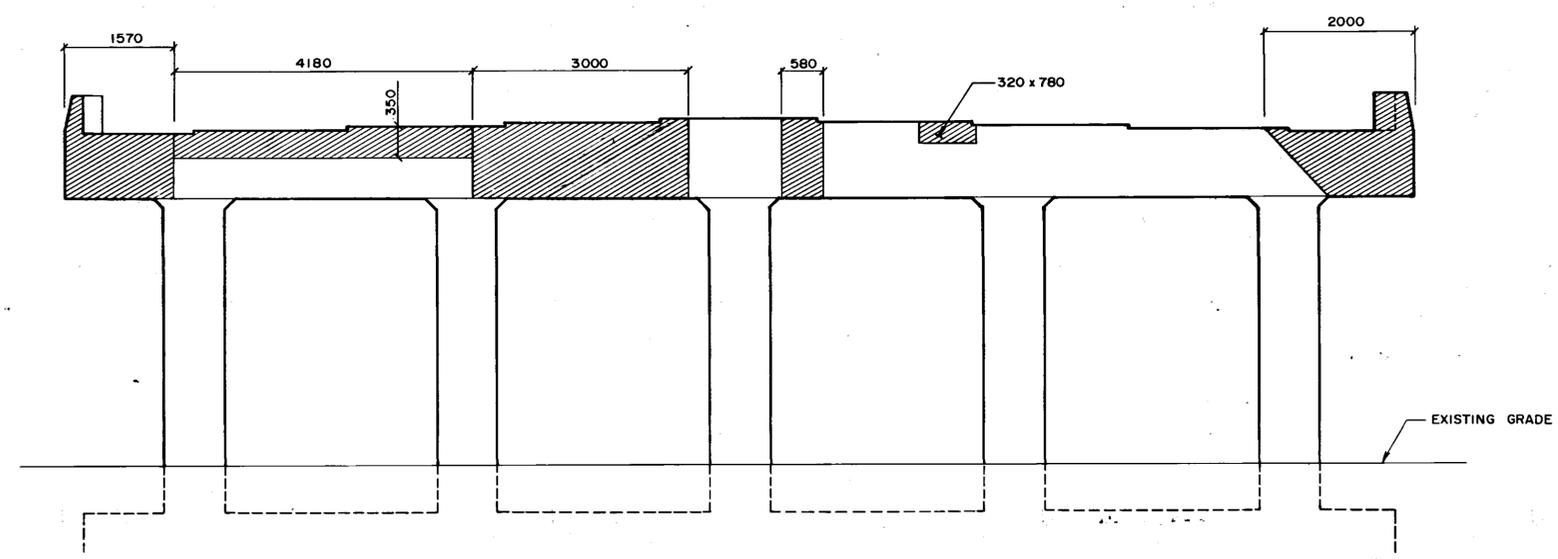


2 SOUTH ELEVATION
1:50

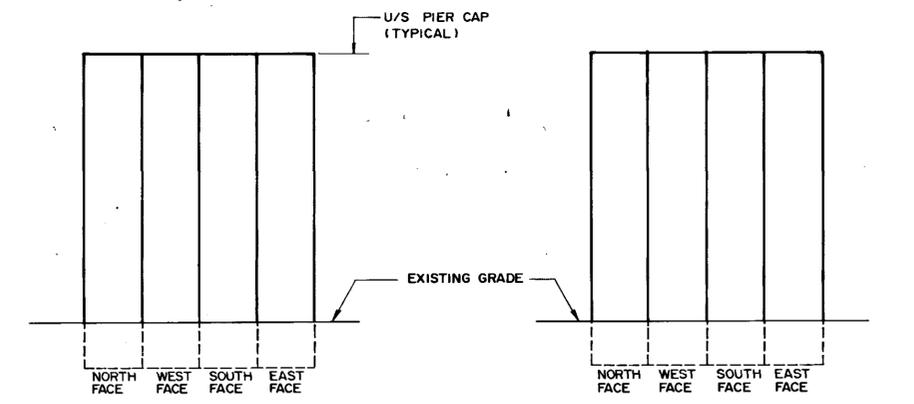


3 EAST COLUMN
1:50

4 EAST-CENTER COLUMN
1:50

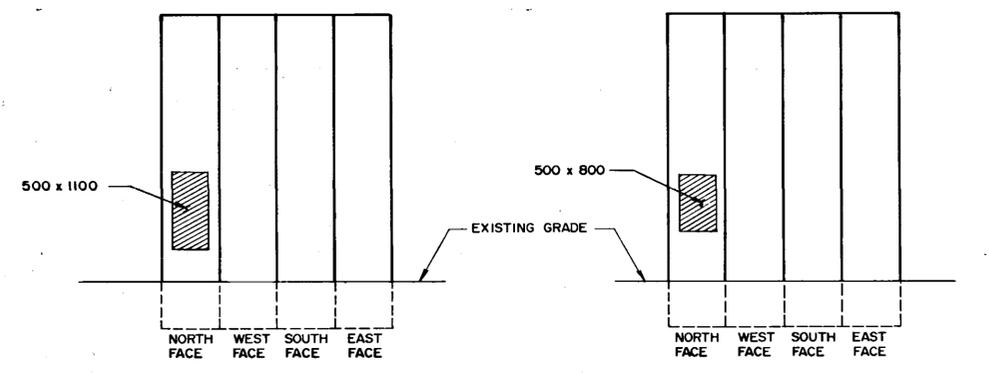

5 CENTER COLUMN
1:50

6 WEST-CENTER COLUMN
1:50

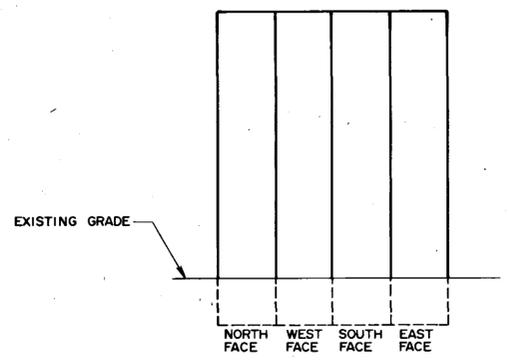

7 WEST COLUMN
1:50

- LEGEND:**
- TYPE 1 REPAIR**
- APPLY CEMENT WASH TO EXISTING SURFACE.
 - TYPE 2 REPAIR**
- CHIP 25mm TO SOUND CONCRETE.
- SANBLAST & EPOXY COAT EXPOSED REINF.
- APPLY BONDING AGENT.
- BUILD UP SURFACE TO PREVIOUS LEVEL BY TROWELLING ON CEMENT MORTAR.

AS-BUILT
DATE 91.02.26 BY [Signature]
CHECKED BY [Signature]

LOCATION APPROVED UNDERGROUND STRUCTURES		B.M. ELEV.
N/A		
SUPV. U/G STRUCTURES COMMITTEE	DATE	
NOTE: LOCATION OF UNDERGROUND STRUCTURES AS SHOWN ARE BASED ON THE BEST INFORMATION AVAILABLE BUT NO GUARANTEE IS GIVEN THAT ALL EXISTING UTILITIES ARE SHOWN OR THAT THE GIVEN LOCATIONS ARE EXACT. CONFIRMATION OF EXISTENCE AND EXACT LOCATION OF ALL SERVICES MUST BE OBTAINED FROM THE INDIVIDUAL UTILITIES BEFORE PROCEEDING WITH CONSTRUCTION.		
NO. REVISIONS	DATE	BY

WARDROP ENGINEERING INC.	
DESIGNED BY F.C.	CHECKED BY
DRAWN BY G.I.	APPROVED BY
HOR SCALE AS NOTED	AUTHORIZED BY DATE
VERTICAL	W. NAUMKO/STREETS & BRIDGE ENGINEER DATE
DATE JANUARY 12, 1991	ACCEPTED BY B.R. SMITH/BRIDGE ENGINEER

ENGINEER'S SEAL
PROVINCE OF MANITOBA
C.D. STEWART
REGISTERED ENGINEER
CONSULTANT DRAWING NO. 890007-02-00


B-5903-11

THE CITY OF WINNIPEG
WORKS AND OPERATIONS DIVISION
STREETS AND TRANSPORTATION DEPARTMENT


EMPRESS STREET OVERPASS
STRUCTURE REHABILITATION, STRENGTHENING AND RELATED WORKS

SOUTH PIER
EXPOSED CONCRETE SURFACE REPAIRS


CITY DRAWING NUMBER
B100-90-10B

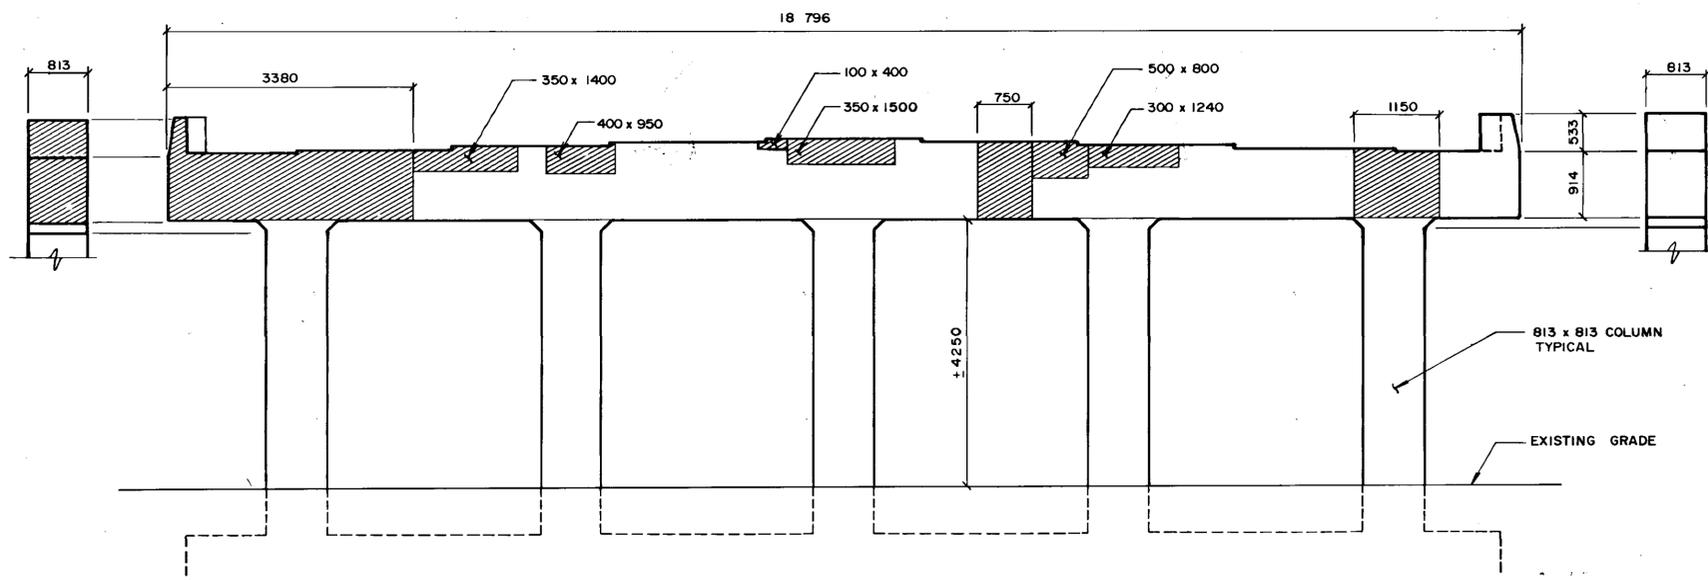

1 NORTH ELEVATION
1:50

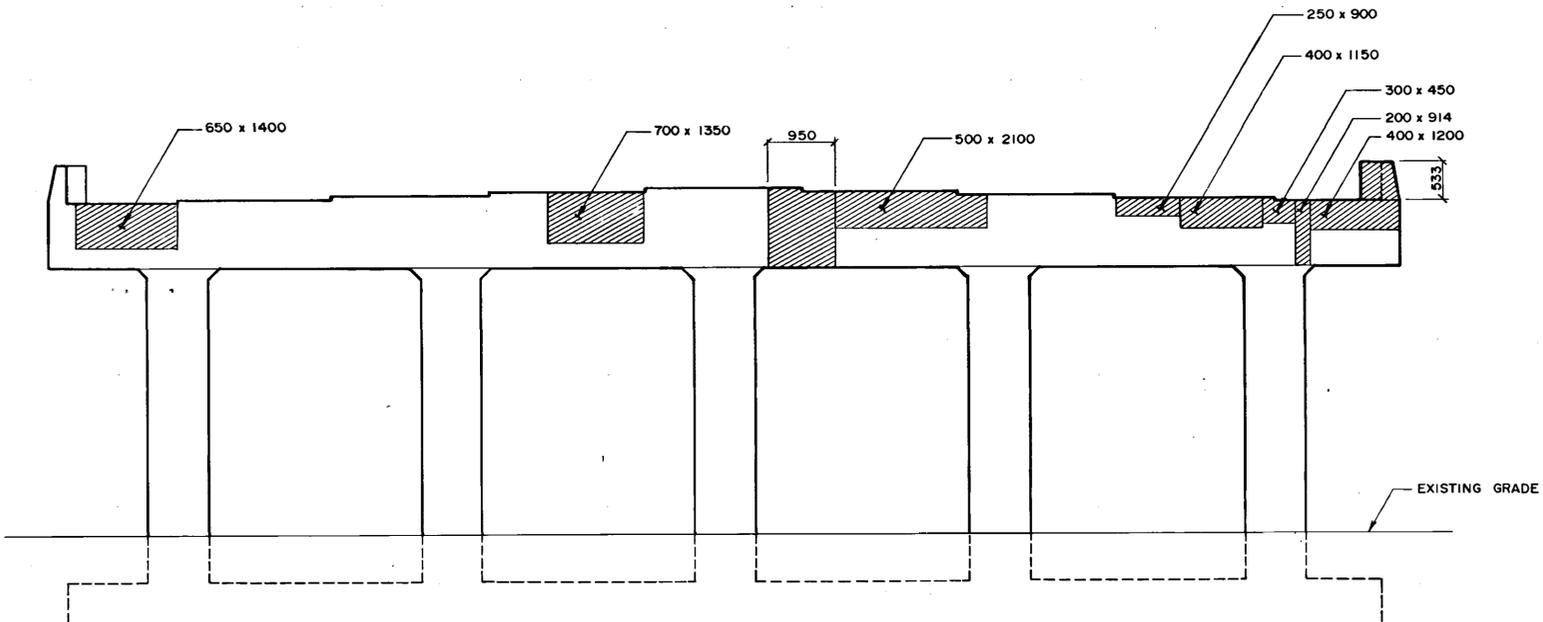


2 SOUTH ELEVATION
1:50

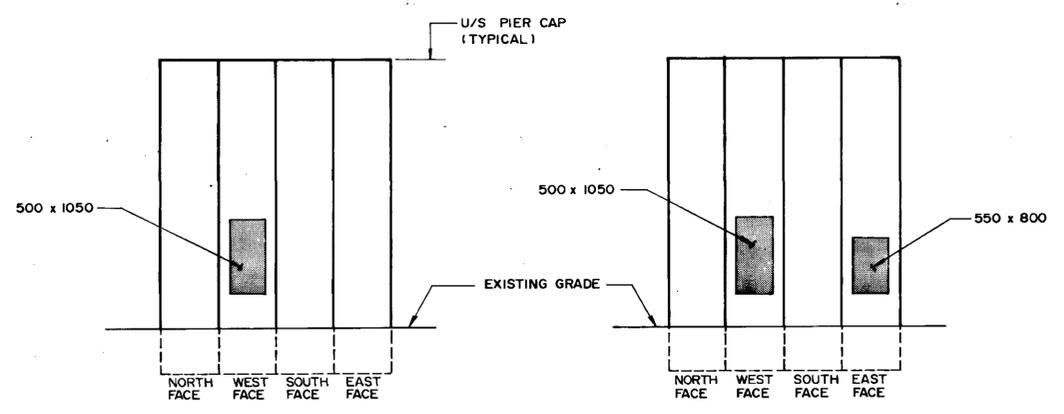


3 EAST COLUMN
1:50

4 EAST-CENTER COLUMN
1:50

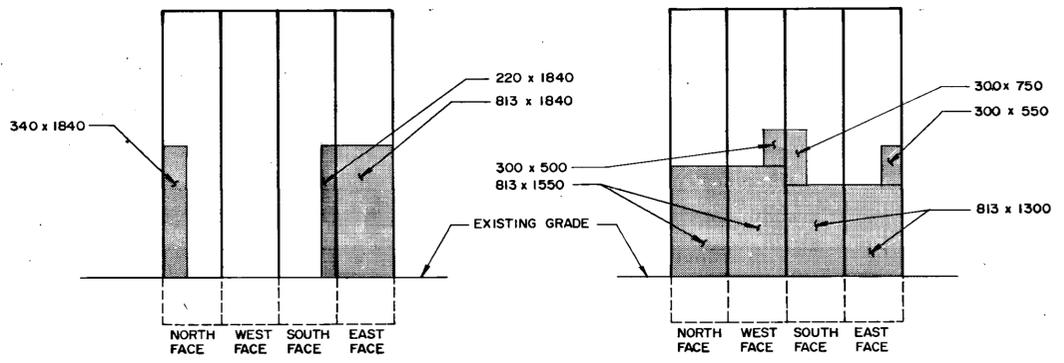

5 CENTER COLUMN
1:50

6 WEST-CENTER COLUMN
1:50

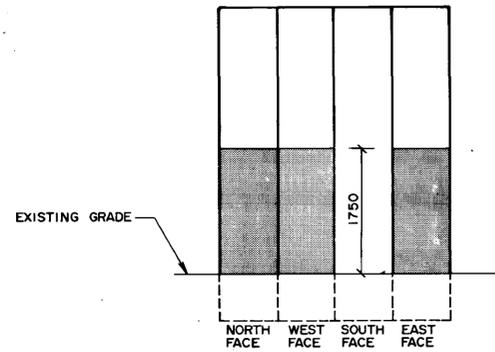

7 WEST COLUMN
1:50

- LEGEND:**
- TYPE 1 REPAIR**
- APPLY CEMENT WASH TO EXISTING SURFACE.
 - TYPE 2 REPAIR**
- CHIP 25mm TO SOUND CONCRETE.
- SANBLAST & EPOXY COAT EXPOSED REINF.
- APPLY BONDING AGENT.
- BUILD UP SURFACE TO PREVIOUS LEVEL BY TROWELLING ON CEMENT MORTAR.
 - TYPE 3 REPAIR**
- CHIP OFF 50mm TO SOUND CONCRETE.
- SANDBLAST & EPOXY COAT EXPOSED REINF.
- APPLY BONDING AGENT.
- INSTALL FORMWORK
- CAST CONCRETE WITH 9mm AGGREGATE

B-5903-12

AS-BUILT
DATE 91.02.26 BY [Signature]
CHECKED BY [Signature]

LOCATION APPROVED UNDERGROUND STRUCTURES		B.M. ELEV.
N/A		
SUPV U/G STRUCTURES COMMITTEE	DATE	
NOTE: LOCATION OF UNDERGROUND STRUCTURES AS SHOWN ARE BASED ON THE BEST INFORMATION AVAILABLE BUT NO GUARANTEE IS GIVEN THAT ALL EXISTING UTILITIES ARE SHOWN OR THAT THE GIVEN LOCATIONS ARE EXACT CONFIRMATION OF EXISTENCE AND EXACT LOCATION OF ALL SERVICES MUST BE OBTAINED FROM THE INDIVIDUAL UTILITIES BEFORE PROCEEDING WITH CONSTRUCTION		
NO REVISIONS	DATE	BY

WARDROP ENGINEERING INC.	
DESIGNED BY F.C.	CHECKED BY
DRAWN BY G.I.	APPROVED BY
HOR SCALE AS NOTED	AUTHORIZED BY DATE
VERTICAL	W. WARDROP/STREETS & BRIDGE ENGINEER DATE
DATE JANUARY 12, 1991	ACCEPTED BY
	S.K. SMITH/ BRIDGE ENGINEER

ENGINEER'S SEAL

PROVINCE OF MANITOBA

C. D. STEWART

REGISTERED ENGINEER


CONSULTANT DRAWING NO. 890007-02-00

THE CITY OF WINNIPEG
WORKS AND OPERATIONS DIVISION
STREETS AND TRANSPORTATION DEPARTMENT


EMPRESS STREET OVERPASS
STRUCTURE REHABILITATION, STRENGTHENING AND RELATED WORKS

CENTER PIER
EXPOSED CONCRETE SURFACE REPAIRS

CITY DRAWING NUMBER B100-90-10C

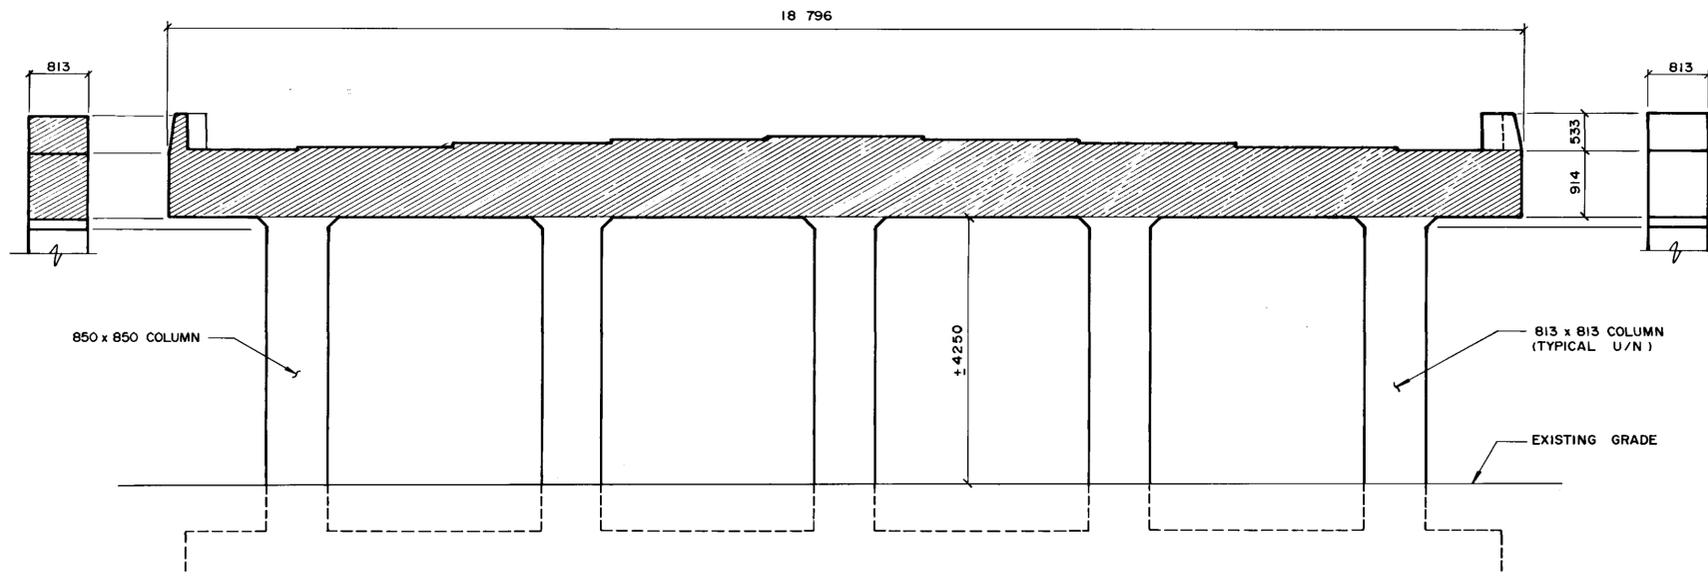


1 NORTH ELEVATION
1:50

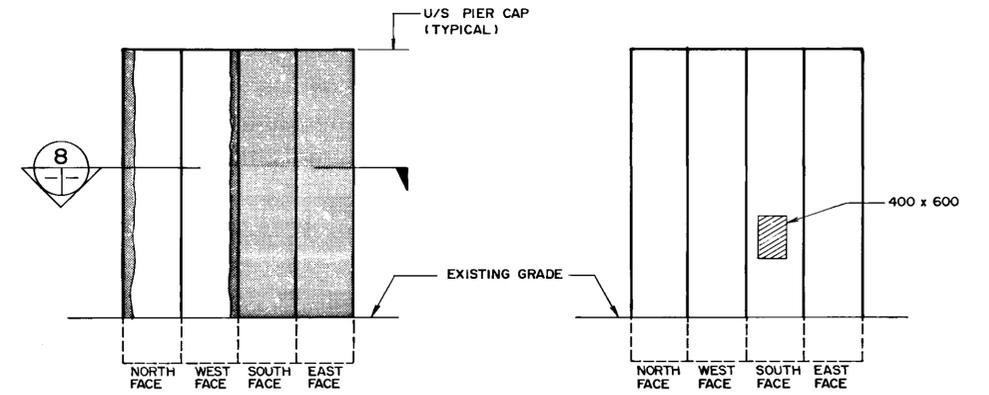


3 EAST COLUMN
1:50

4 EAST-CENTER COLUMN
1:50

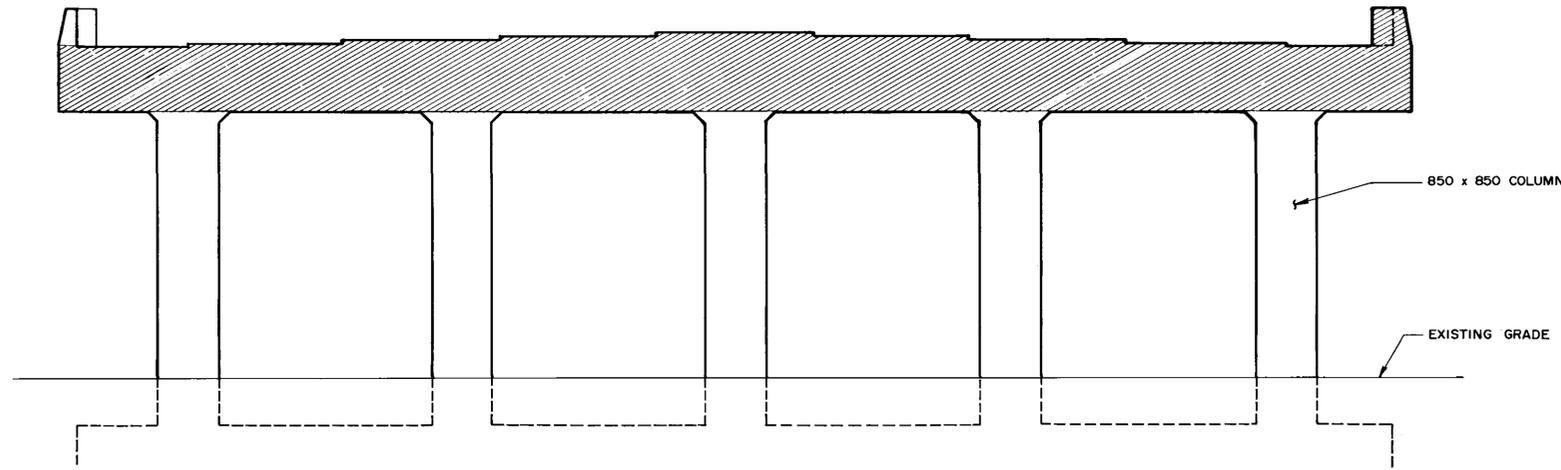


2 SOUTH ELEVATION
1:50

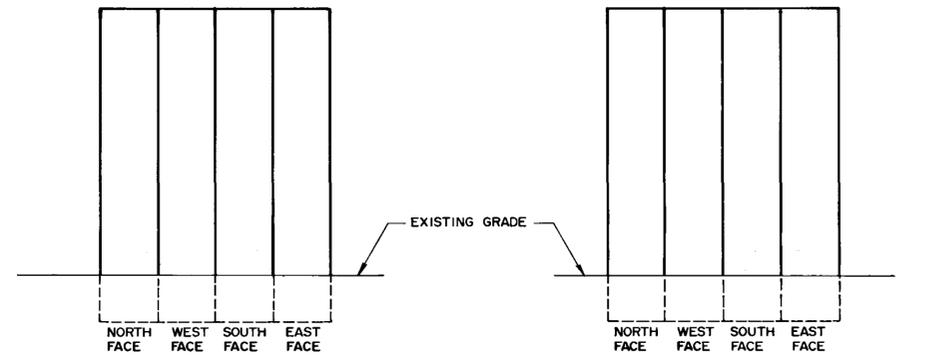

5 CENTER COLUMN
1:50


6 WEST-CENTER COLUMN
1:50

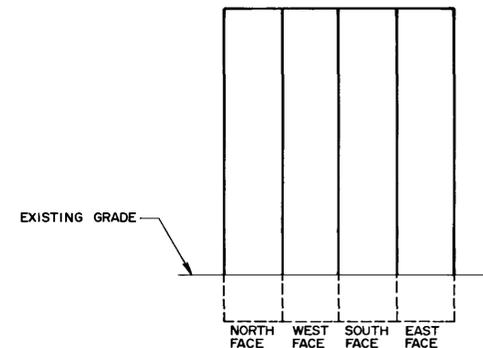

7 WEST COLUMN
1:50

LEGEND:

- TYPE 1 REPAIR**
- APPLY CEMENT WASH TO EXISTING SURFACE.
- TYPE 2 REPAIR**
- CHIP 25mm TO SOUND CONCRETE.
- SANBLAST & EPOXY COAT EXPOSED REINF.
- APPLY BONDING AGENT.
- BUILD UP SURFACE TO PREVIOUS LEVEL BY TROWELLING ON CEMENT MORTAR.
- TYPE 4 REPAIR**
- CHIP OFF 75mm MINIMUM TO SOUND CONCRETE.
- SANBLAST & EPOXY COAT EXPOSED REINF.
- DRILL IN DOWELS AND TIE REINF. AS DIRECTED BY THE CONTRACT ADMINISTRATOR.
- APPLY BONDING AGENT.
- INSTALL FORMWORK
- CAST CONCRETE WITH 9mm AGGREGATE

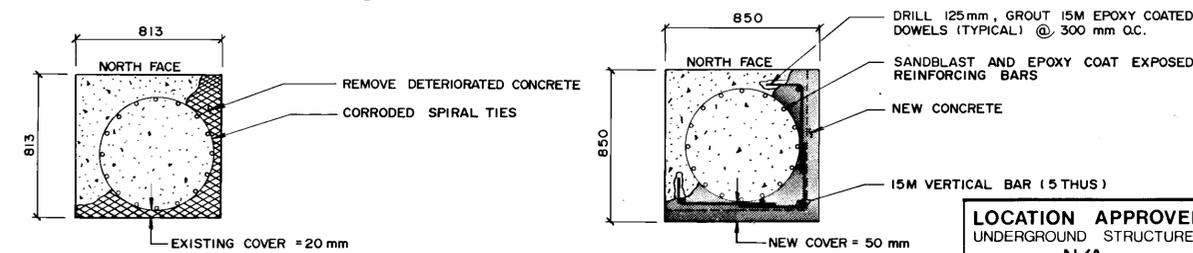

8 SECTION
SHOWING PIER COLUMN BEFORE DEMOLITION
1:20

8 SECTION
SHOWING PIER COLUMN REPAIR
1:20

AS-BUILT
DATE 9/02/26 BY [Signature]
CHECKED BY [Signature]

LOCATION APPROVED UNDERGROUND STRUCTURES
N/A
DATE
NOTE:
LOCATION OF UNDERGROUND STRUCTURES AS SHOWN ARE BASED ON THE BEST INFORMATION AVAILABLE BUT NO GUARANTEE IS GIVEN THAT ALL EXISTING UTILITIES ARE SHOWN OR THAT THE GIVEN LOCATIONS ARE EXACT. CONFIRMATION OF EXISTENCE AND EXACT LOCATION OF ALL SERVICES MUST BE OBTAINED FROM THE INDIVIDUAL UTILITIES BEFORE PROCEEDING WITH CONSTRUCTION.




NO.	REVISIONS	DATE	BY

WARDROP ENGINEERING INC.
DESIGNED BY F.C.
DRAWN BY G.I.
HOR SCALE AS NOTED
VERTICAL
DATE JANUARY 12, 1991



ENGINEER'S SEAL
PROVINCE OF MANITOBA
C.D. STEWART
REGISTERED ENGINEER
CONSULTANT DRAWING NO. 890007-02-00

THE CITY OF WINNIPEG
WORKS AND OPERATIONS DIVISION
STREETS AND TRANSPORTATION DEPARTMENT
EMPRESS STREET OVERPASS
STRUCTURE REHABILITATION, STRENGTHENING AND RELATED WORKS
NORTH PIER
EXPOSED CONCRETE SURFACE REPAIRS
CITY DRAWING NUMBER B100-90-10D

B-5903-13

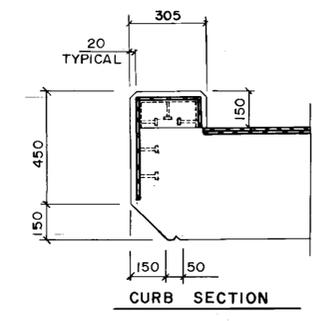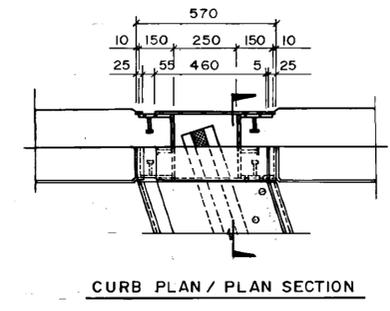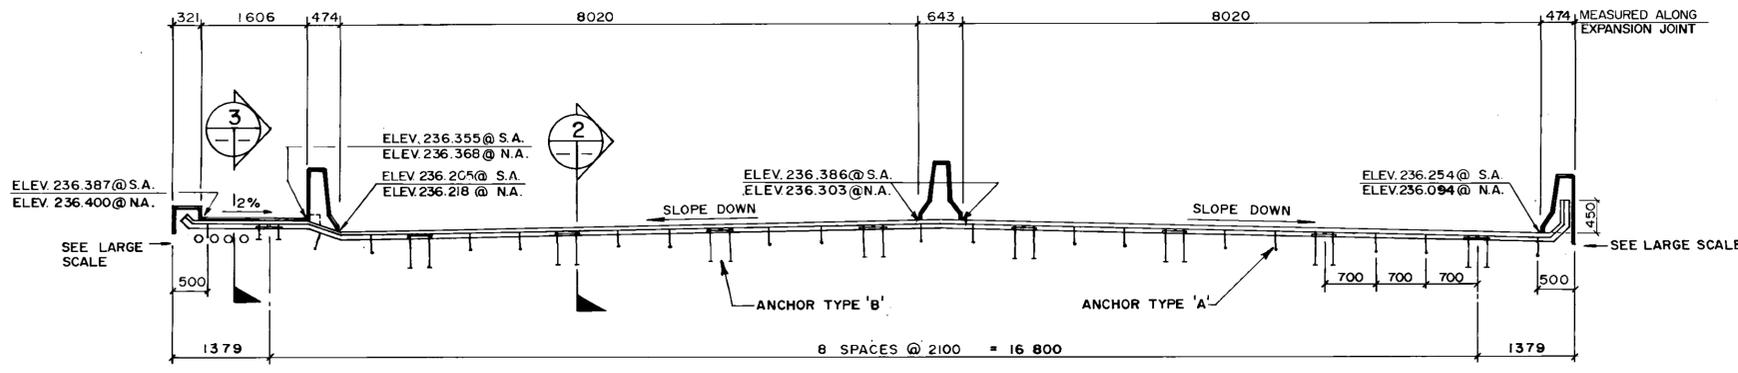


1 ELEVATION
1:50

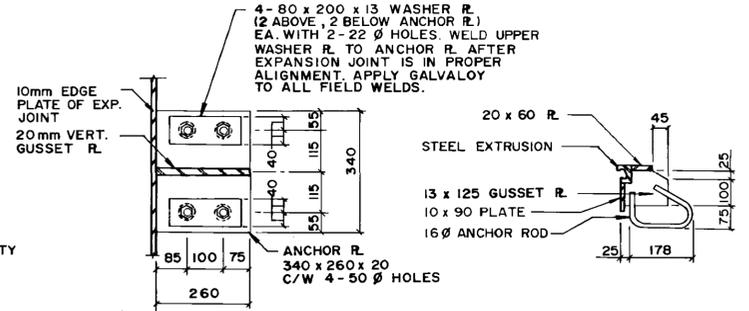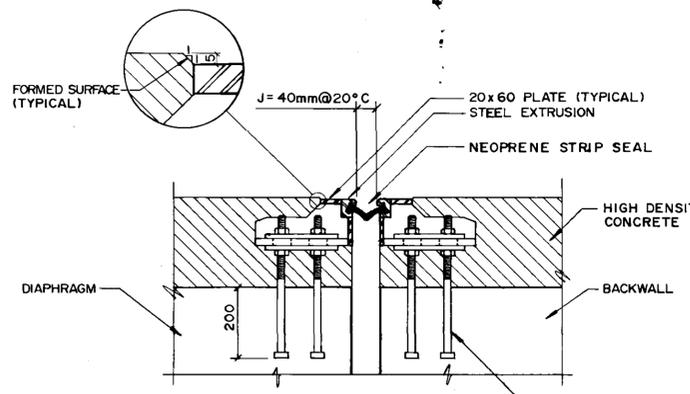


4 ANCHOR TYPE 'B'
1:10

5 ANCHOR TYPE 'A'
1:10

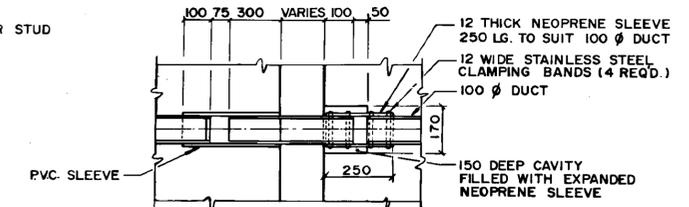


6 TYPICAL DUCT EXPANSION JOINT ASSEMBLY
N.T.S.

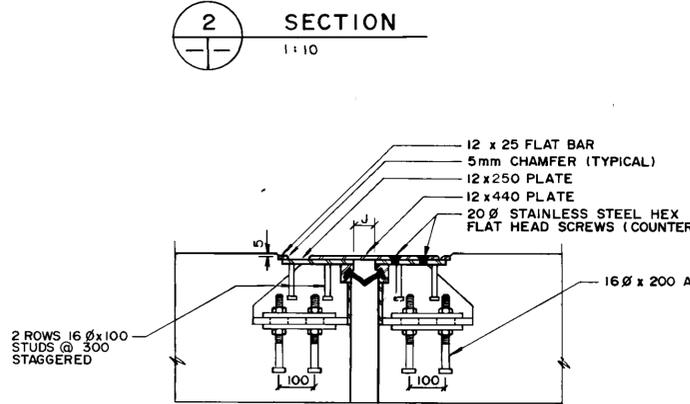


2 SECTION
1:10

2 ROWS 16 Øx100 STUDS @ 300 STAGGERED


- NOTES:**
- Manufacturer's shop drawings shall be submitted to the contract administrator for approval at least fourteen (14) working days prior to fabrication. The expansion joint assemblies shall be designed to carry AASHTO HS30-44 live loading.
 - Steel shall be in accordance with CSA Standard G40.21M Grade 300 WT or equal.
 - Steel extrusions shall be in accordance with CSA Standard G40.21M Grade 230 G minimum.
 - All steel surfaces shall be hot dip galvanized to a net retention of 600 G/M2 in accordance with CSA Standard G 164 after fabrication and installed in one continuous piece.
 - Joint assembly shall be fabricated and completely shop assembled and preset to dimension 'J' for 15C prior to shipment.
 - Welding shall be of low hydrogen classification. Manual electrode shall be E7016 or E7018. All welding shall be in accordance with CSA Standard W59.
 - Seal shall be performed neoprene rubber seal. Each rubber seal shall be supplied and installed in one continuous piece. No splices in the rubber seal will be permitted unless authorized by the contract administrator.
 - Joint assembly shall be installed 5mm below elevation and grade of bridge deck.
 - After removal of clamping channels and spacer dam, bolt and bleeder holes to be filled with an approved epoxy grout.
 - Installation temperature shall be taken as the mean shade air temperature prior to joint installation at the structure as follows: for concrete structures - 48 hours. For steel structures - 24 hours.
 - All areas of damaged galvanizing shall be repaired by using the galvaloy procedure as specified.
 - All barrier coverplates shall be recessed 20mm from the face of concrete.

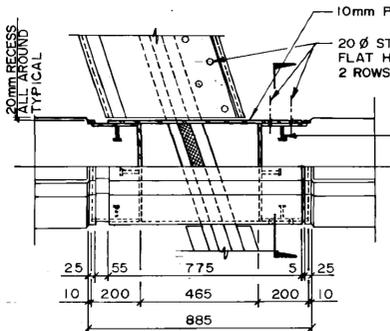


SIDEWALK SHOULDER BARRIER PLAN / PLAN SECTION

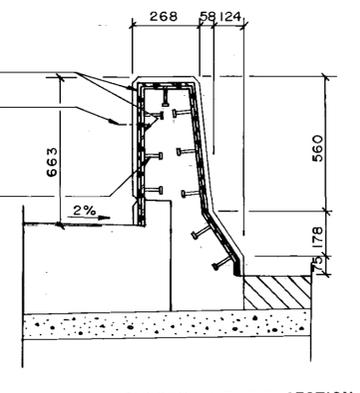


SIDEWALK SHOULDER BARRIER SECTION

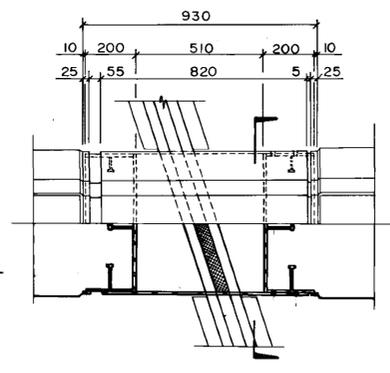


MEDIAN BARRIER PLAN / PLAN SECTION

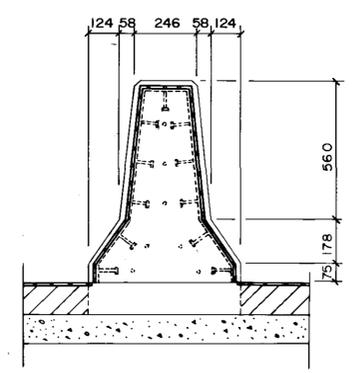

MEDIAN BARRIER SECTION

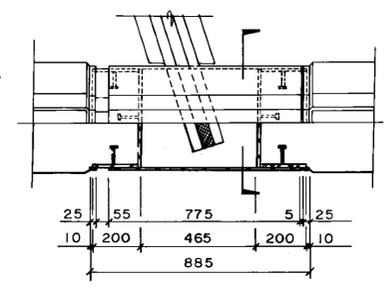

SHOULDER BARRIER PLAN / PLAN SECTION

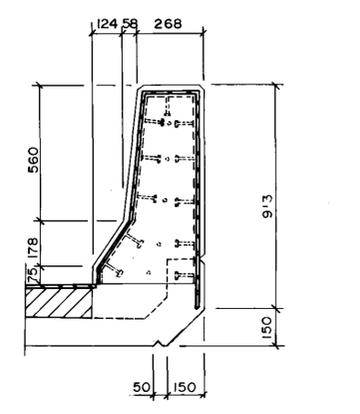

SHOULDER BARRIER SECTION

3 SECTION
1:10

7 CONCRETE TRAFFIC BARRIER EXPANSION DETAILS
NTS

TEMPERATURE WIDTH ADJUSTMENT TABLE								
TEMP. °C	5	10	15	20	25	30	MIN.	MAX.
DIM. 'J' mm	45	43	42	40	38	37	35	76

AS-BUILT
DATE 3/02/26 BY [Signature]
CHECKED BY [Signature]

LOCATION APPROVED UNDERGROUND STRUCTURES	B.M. ELEV.
N/A	
SUPV U/G STRUCTURES COMMITTEE	DATE
NOTE: LOCATION OF UNDERGROUND STRUCTURES AS SHOWN ARE BASED ON THE BEST INFORMATION AVAILABLE BUT NO GUARANTEE IS GIVEN THAT ALL EXISTING UTILITIES ARE SHOWN OR THAT THE GIVEN LOCATIONS ARE EXACT. CONFIRMATION OF EXISTENCE AND EXACT LOCATION OF ALL SERVICES MUST BE OBTAINED FROM THE INDIVIDUAL UTILITIES BEFORE PROCEEDING WITH CONSTRUCTION.	
DESIGNED BY JC & FPC	CHECKED BY [Signature]
DRAWN BY LG	APPROVED BY [Signature]
HOR SCALE AS NOTED	VERTICAL AS NOTED
1 REVISED AS CONSTRUCTED 30-12-14 FPC	AUTHORIZED BY [Signature] DATE 01/22/23
NO REVISIONS	DATE JAN 15, 1990

WARDROP ENGINEERING INC.

DESIGNED BY JC & FPC
DRAWN BY LG
HOR SCALE AS NOTED
VERTICAL AS NOTED
DATE JAN 15, 1990

CHECKED BY [Signature]
APPROVED BY [Signature]
AUTHORIZED BY [Signature] DATE 01/22/23
ACCEPTED BY [Signature] DATE 01/22/23
C.R. SMITH / BRIDGE ENGINEER


THE CITY OF WINNIPEG
WORKS AND OPERATIONS DIVISION
STREETS AND TRANSPORTATION DEPARTMENT

EMPRESS STREET OVERPASS
STRUCTURE REHABILITATION, STRENGTHENING AND RELATED WORKS
EXPANSION JOINT DETAILS

CITY DRAWING NUMBER
B100-90-11

CONSULTANT DRAWING NO.
890007-02-00

B-5903-14

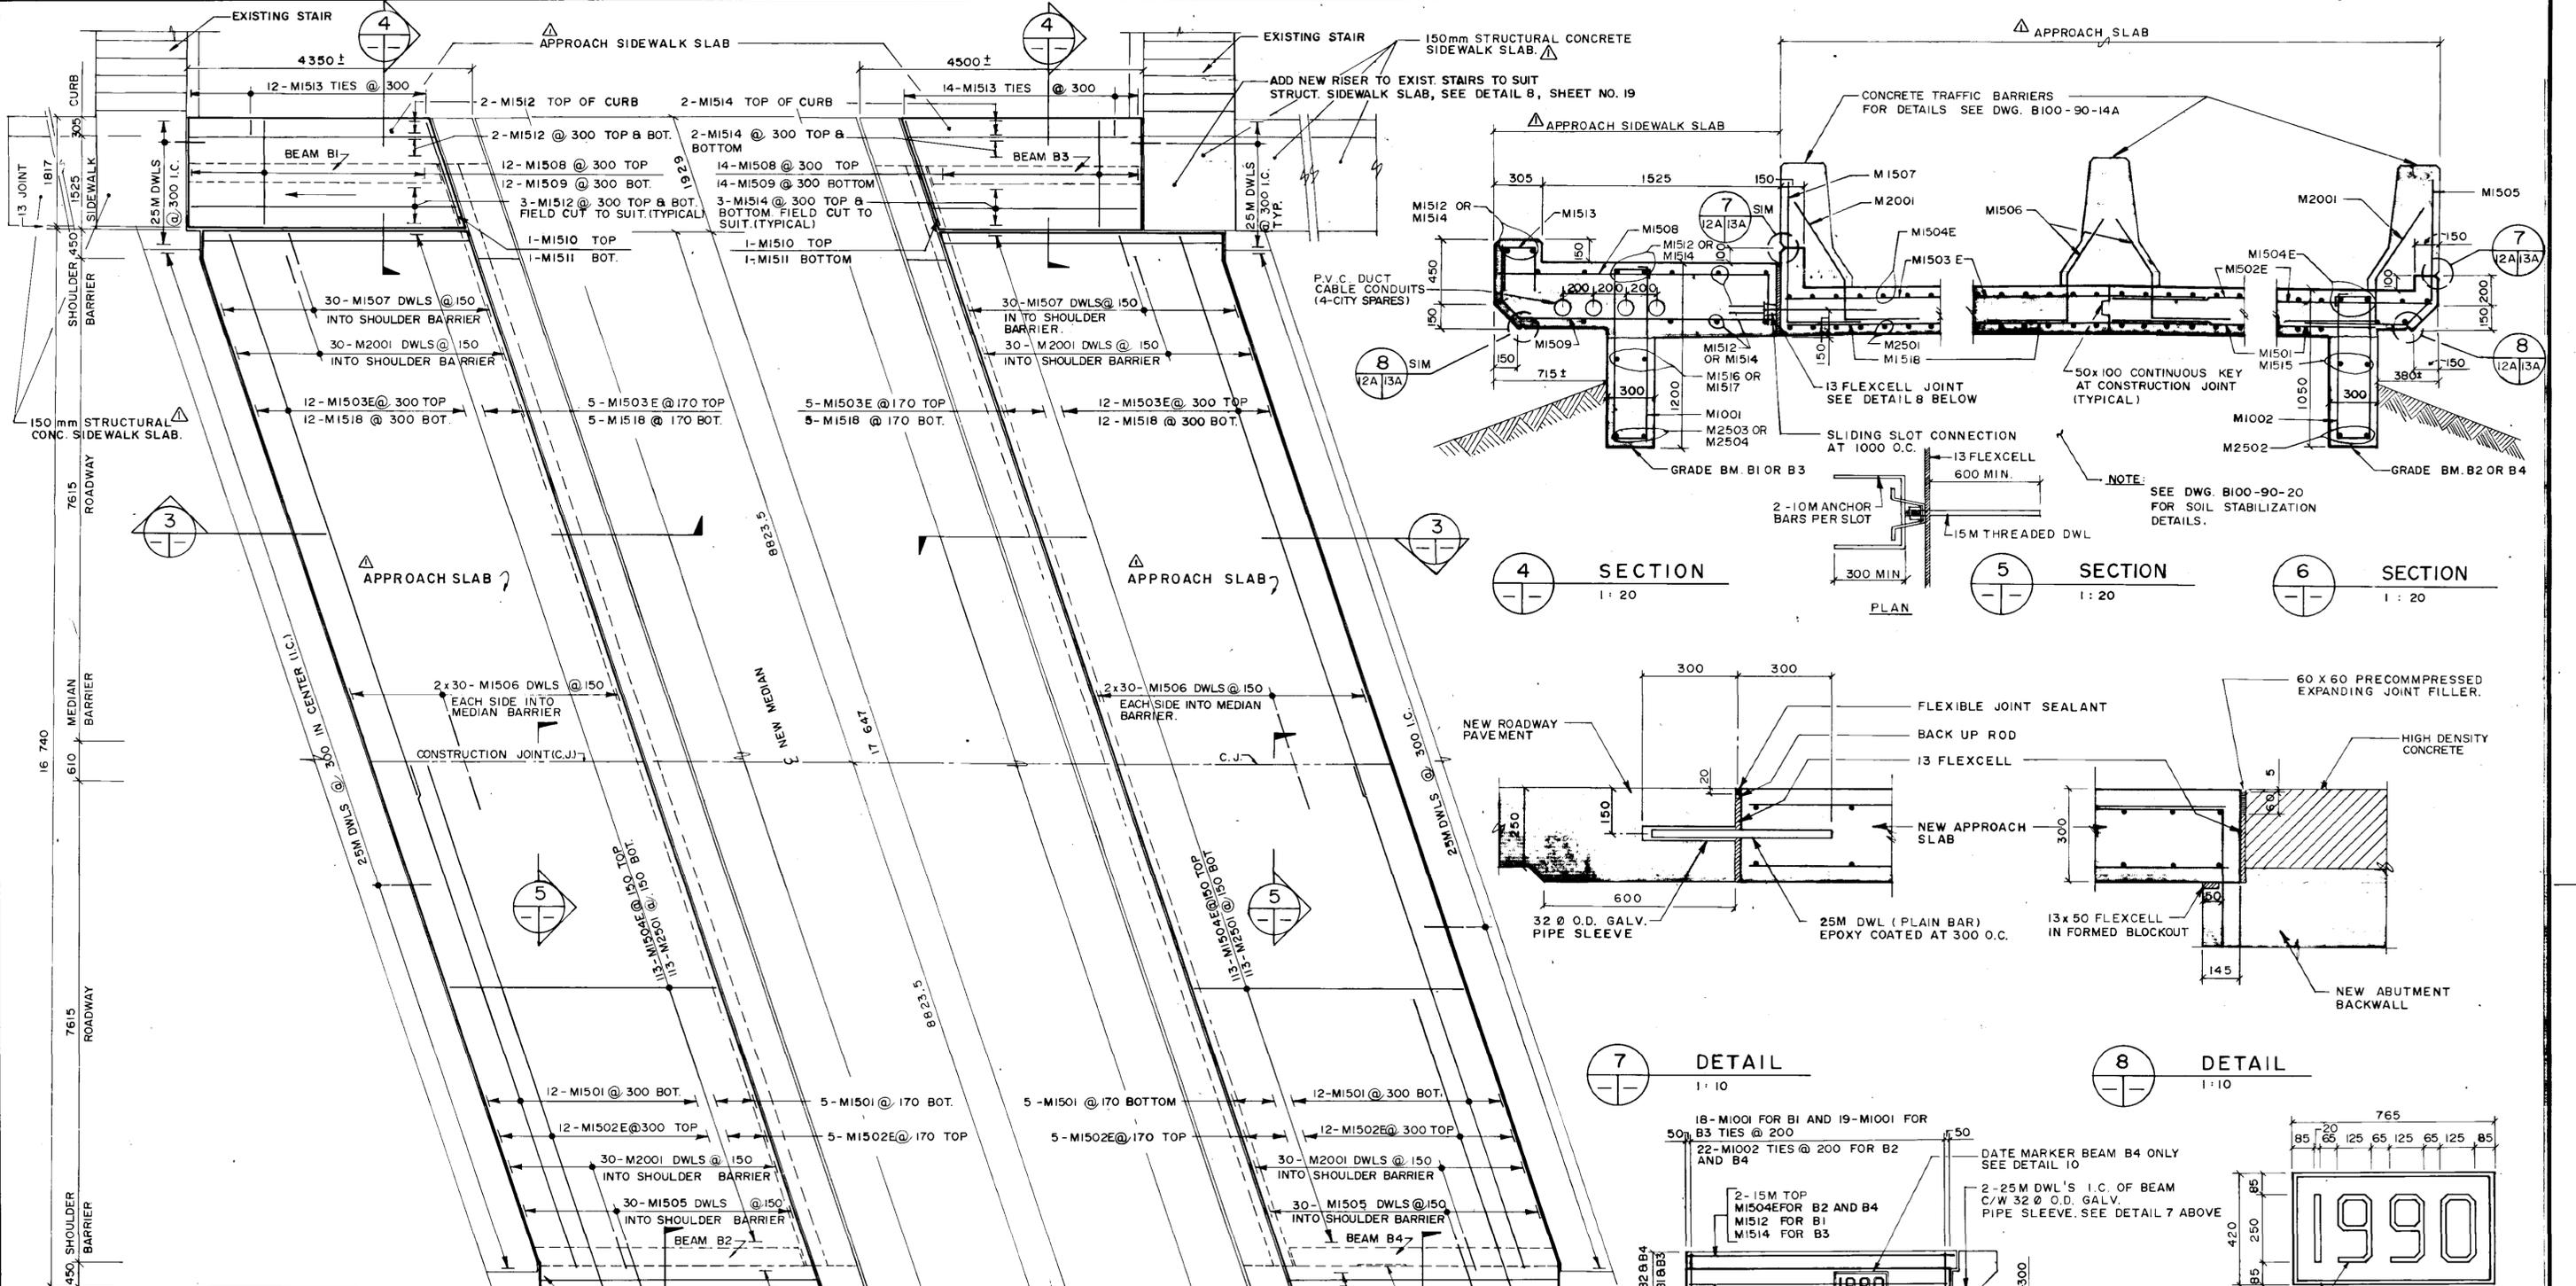

NOTE: FIELD BEND LAST TOP BAR M1502 AS REQUIRED TO FOLLOW SHAPE OF APPROACH SLAB (TYPICAL)

1 PLAN - SOUTH APPROACH SLAB
1:50


2 PLAN - NORTH APPROACH SLAB
1:50

7 DETAIL
1:10

8 DETAIL
1:10

9 ELEVATION GRADE BM. B2 SHOWN.
1:50 BEAM B1, B3 & B4 SIMILAR


10 DATE MARKER DETAIL
NTS

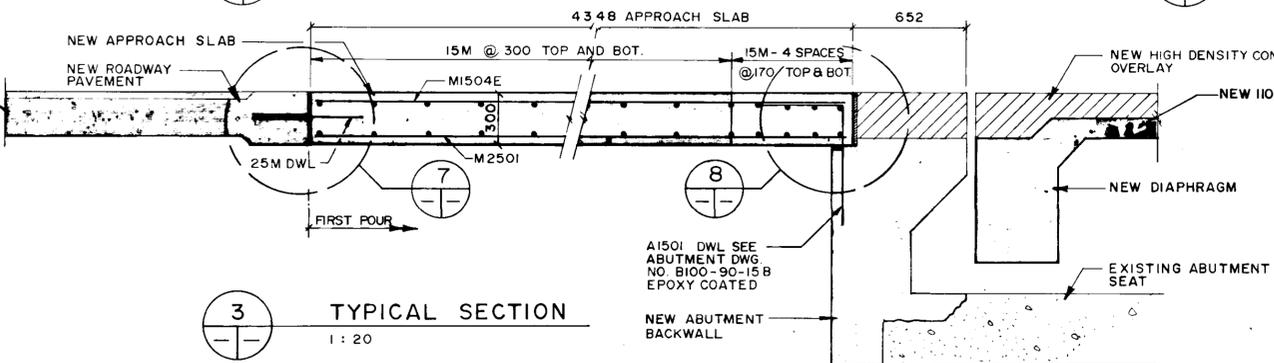

3 TYPICAL SECTION
1:20

AS-BUILT
DATE 21.02.24 BY [Signature]
CHECKED BY [Signature]

B.M. ELEV.					
WARDROP ENGINEERING INC.					
DESIGNED BY	JC & FPC	CHECKED BY	[Signature]		
DRAWN BY	LG	APPROVED BY	[Signature]		
HOR. SCALE	AS NOTED	AUTHORIZED BY	[Signature]		
VERTICAL	AS NOTED	DATE	90-02-14		
NO. REVISIONS	2	DATE	90-02-14		
	ADDENDUM	DATE	90-03-19		
		DATE	JAN. 15, 1990		

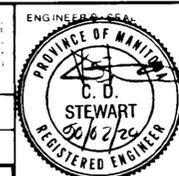


THE CITY OF WINNIPEG
WORKS AND OPERATIONS DIVISION
STREETS AND TRANSPORTATION DEPARTMENT

EMPRESS STREET OVERPASS
STRUCTURE REHABILITATION, STRENGTHENING AND RELATED WORKS

CONCRETE & REINFORCING DETAILS APPROACH SLABS AND SIDEWALKS


CITY DRAWING NUMBER
B100-90-12A(RI)

CONSULTANT DRAWING NO.
890007-02-00

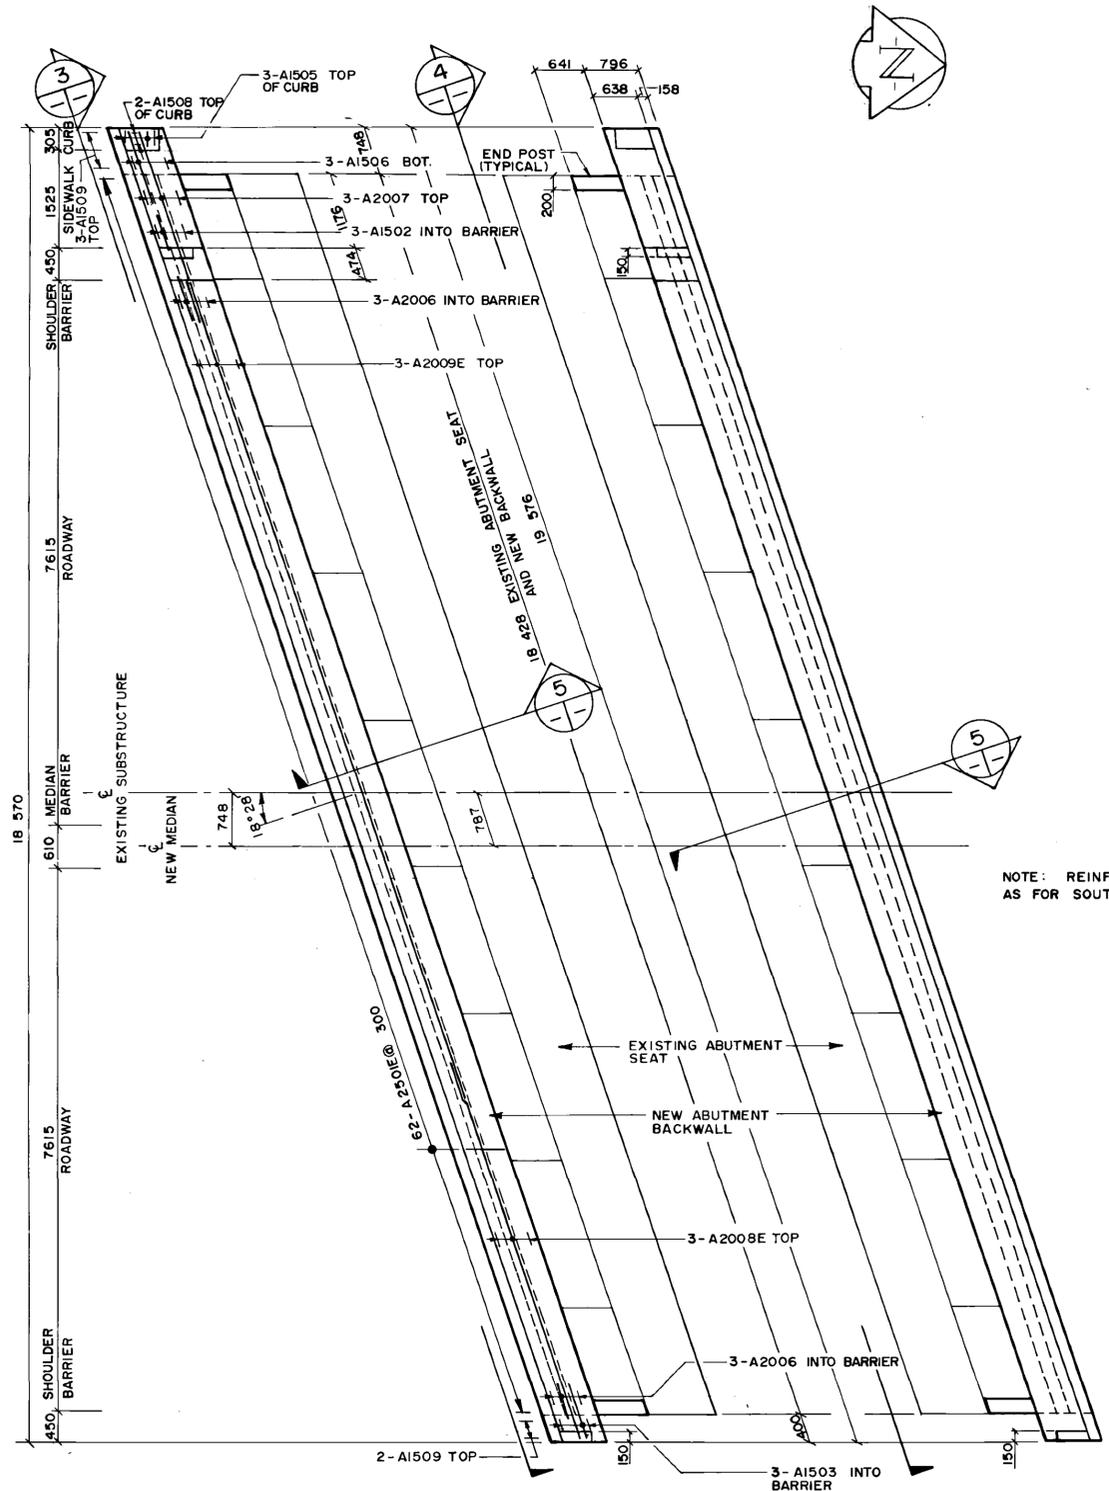


1 PLAN - SOUTH ABUTMENT
1:50

2 PLAN - NORTH ABUTMENT
1:50


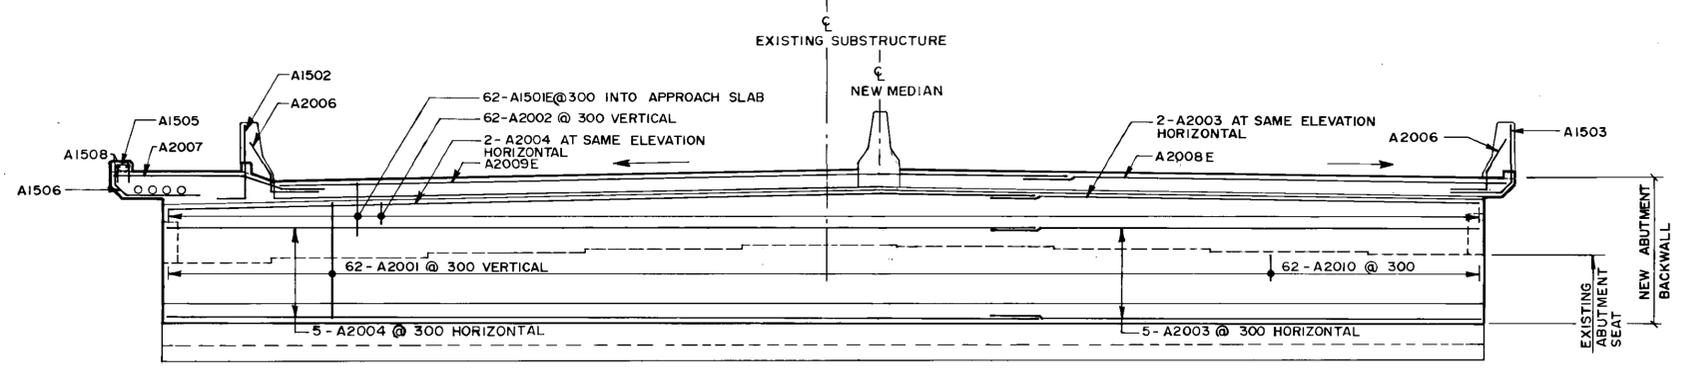


3 ELEVATION - SOUTH ABUTMENT
1:50

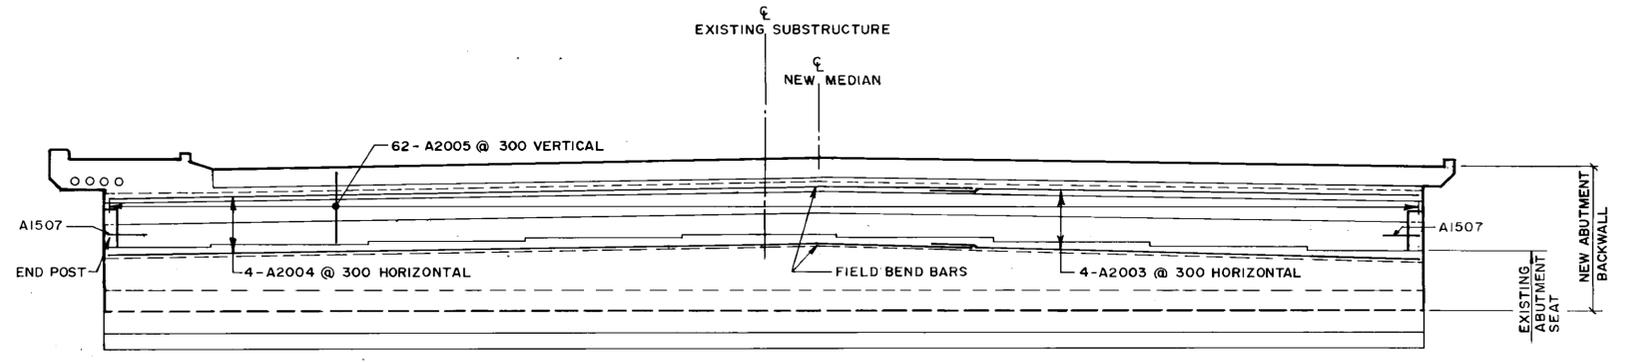

4 ELEVATION - NORTH ABUTMENT
1:50

NOTE: REINFORCING SAME AS FOR SOUTH ABUTMENT.

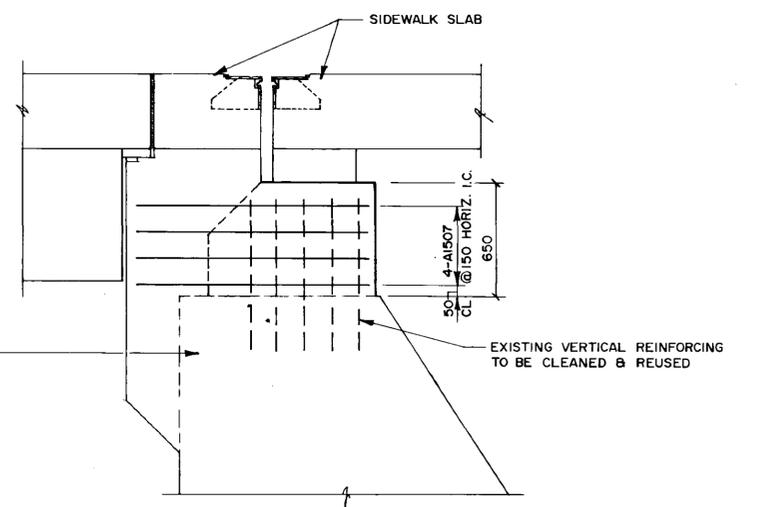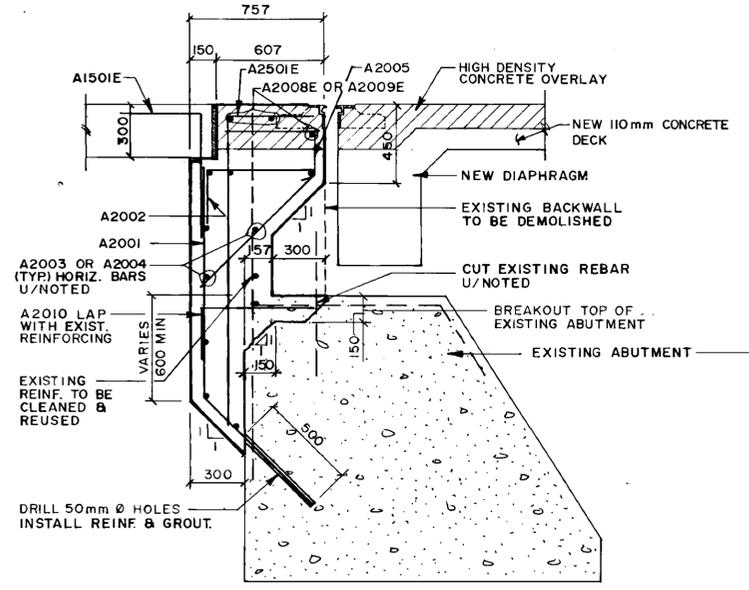

6 SECTION/ELEVATION - SIDEWALK / END POST
1:20

5 SECTION
1:20

B-5903-18

AS-BUILT
DATE 9-1-02 BY [Signature]
CHECKED BY [Signature]

LOCATION APPROVED UNDERGROUND STRUCTURES
N/A
SUPV. U/G STRUCTURES COMMITTEE DATE
NOTE:
LOCATION OF UNDERGROUND STRUCTURES AS SHOWN ARE BASED ON THE BEST INFORMATION AVAILABLE BUT NO GUARANTEE IS GIVEN THAT ALL EXISTING UTILITIES ARE SHOWN OR THAT THE GIVEN LOCATIONS ARE EXACT CONFIRMATION OF EXISTENCE AND EXACT LOCATION OF ALL SERVICES MUST BE OBTAINED FROM THE INDIVIDUAL UTILITIES BEFORE PROCEEDING WITH CONSTRUCTION

B.M. ELEV.			
1	REVISED AS CONSTRUCTED	90-12-14	FPC
NO	REVISIONS	DATE	BY

WARDROP ENGINEERING INC.

DESIGNED BY JC & FPC
DRAWN BY LG
HOR. SCALE AS NOTED
VERTICAL AS NOTED

CHECKED BY [Signature]
APPROVED BY [Signature]
AUTHORIZED BY [Signature] DATE 11/16/92
ACCEPTED BY [Signature] DATE 11/16/92
REGISTERED ENGINEER

ENGINEER
PROVINCE OF MANITOBA
C.D.
STEWART
REGISTERED ENGINEER


THE CITY OF WINNIPEG
WORKS AND OPERATIONS DIVISION
STREETS AND TRANSPORTATION DEPARTMENT

EMPRESS STREET OVERPASS
STRUCTURE REHABILITATION, STRENGTHENING AND RELATED WORKS



ABUTMENT MODIFICATIONS AND BACKWALL REINFORCING DETAILS

CITY DRAWING NUMBER
B100-90-15A


CONSULTANT DRAWING NO.
890007-02-00

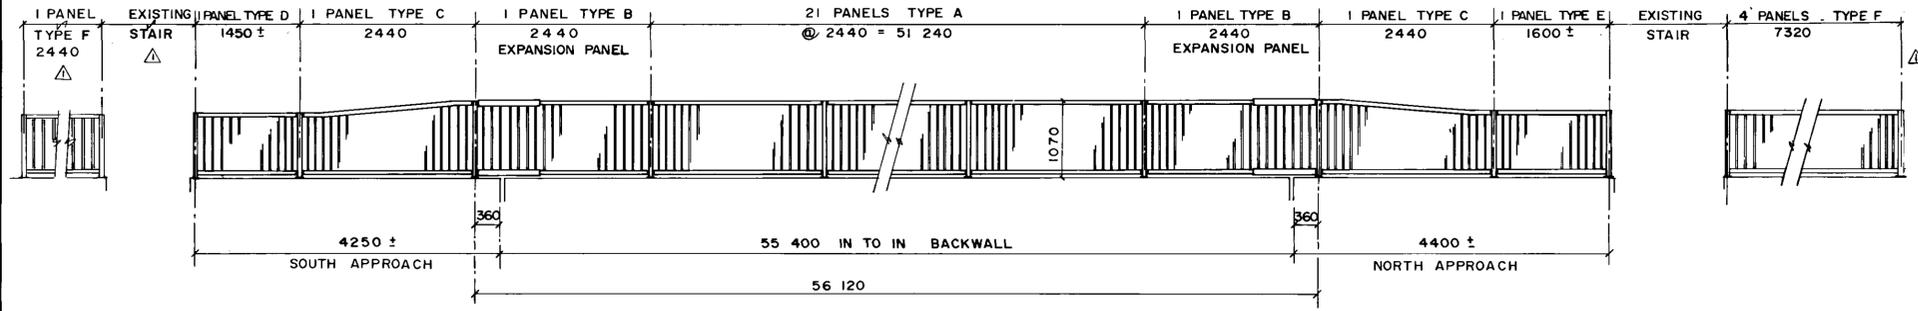

PEDESTRIAN HANDRAIL PANEL DATA							
PANEL	NO. REQ'D.	HEIGHT	①	②	③	④	⑤
A	21 △	1070	2440	2376	20	108	108
B	2 △	1070	2440	2376	20	108	108
C	2 △	VARIES	2440	2376	20	108	108
D	1 △	920	1450 ±	1386	11	108	99
E	1 △	920	1600 ±	1536	13	104	92
F	5 △	920	2440	2376	20	108	108

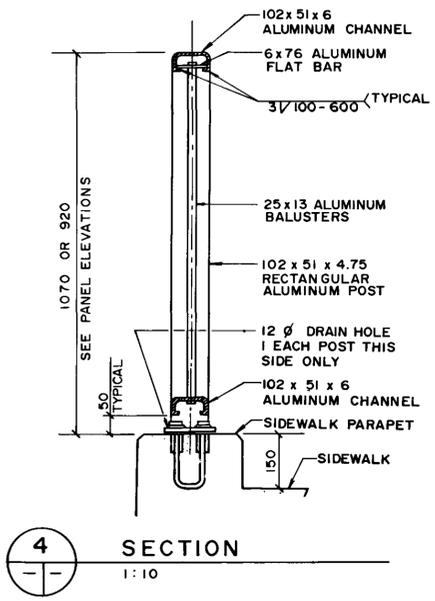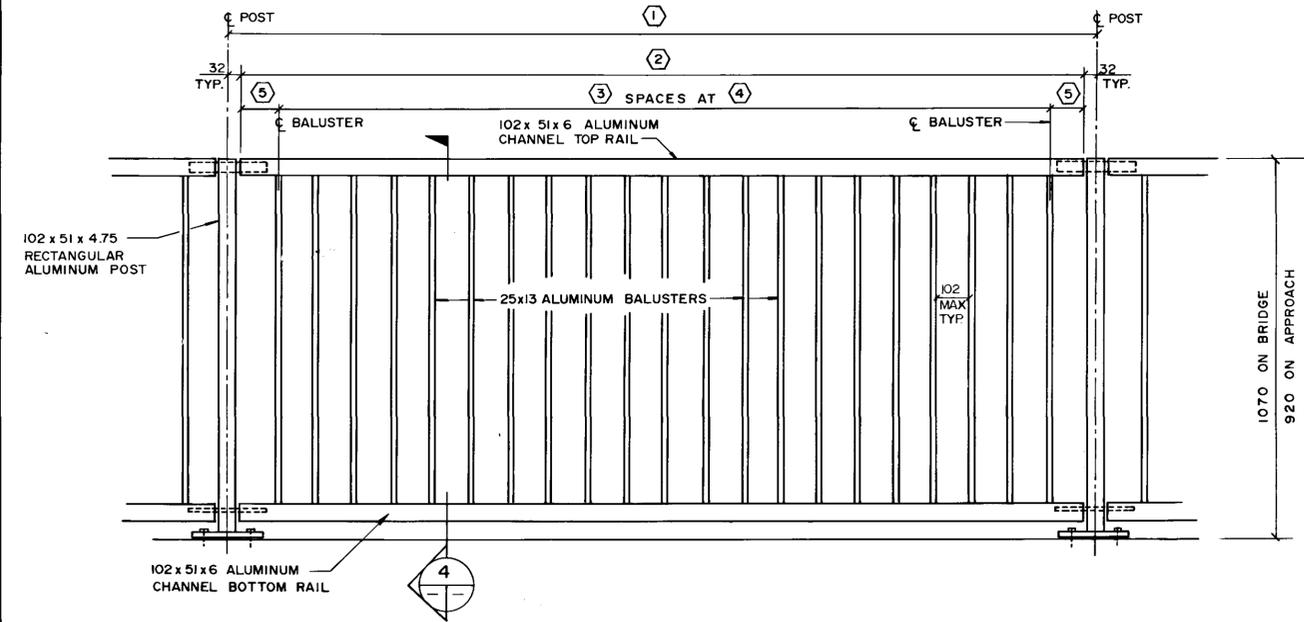

- NOTES:
- Aluminum extrusions shall conform to ASTM B221, Alloy 6351-T6. Aluminum plates shall conform to ASTM B221 Alloy 5083.
 - The M.I.G. process of welding shall be used.
 - S/S denotes stainless steel.
 - Rail posts shall be set vertical.
 - Place minimum of one 3mm aluminum shim under each post. Additional shims may be required for vertical alignment. The surface of shims in contact with concrete shall be painted with 2 coats of alkali resistant bituminous paint meeting the requirements of CGSB 31-GP-3M.
 - Handrail anchor inserts shall be Acrow-Richmond type DCR-1.



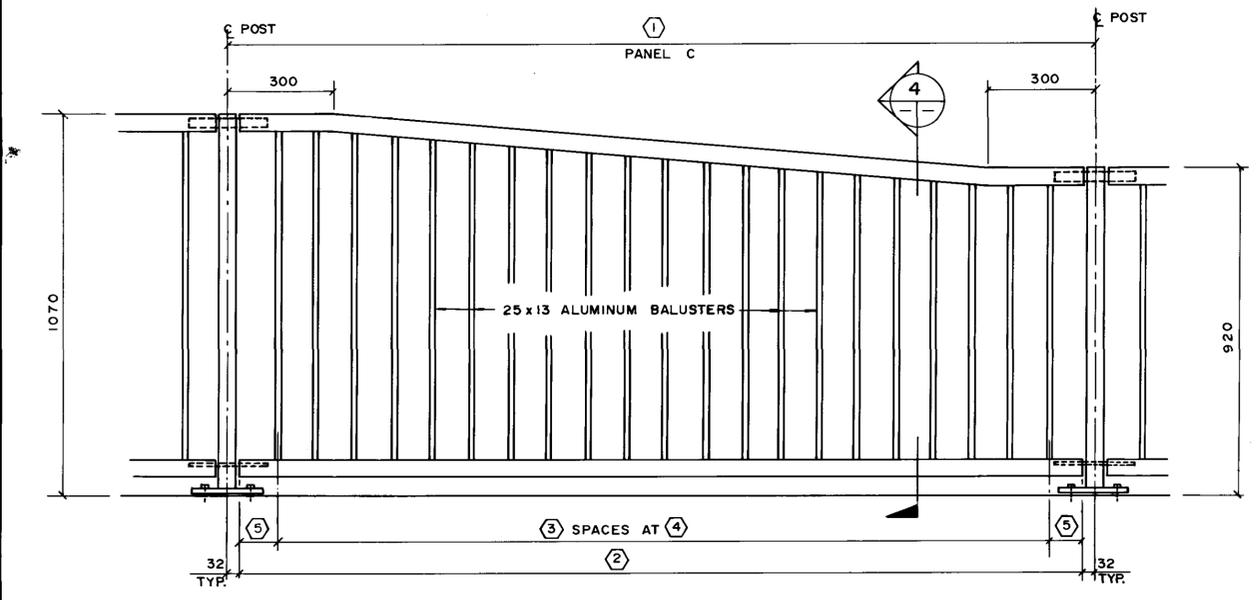


STAND BY MATERIALS TO BE SUPPLIED TO THE CITY		
ITEM	QUANTITY	DESCRIPTION
1	2 SETS	ALL COMPONENTS ASSEMBLED FOR 2 COMPLETE HANDRAIL SECTIONS (2440 x 1070) INCLUDING 4 POSTS
2	4 SETS	ALL COMPONENTS ASSEMBLED FOR 4 COMPLETE HANDRAIL SECTIONS (2440 x 920) INCLUDING 8 POSTS.


B-5903-19

B.M. ELEV.	WARDROP ENGINEERING INC.			THE CITY OF WINNIPEG WORKS AND OPERATIONS DIVISION STREETS AND TRANSPORTATION DEPARTMENT	EMPRESS STREET OVERPASS STRUCTURE REHABILITATION, STRENGTHENING AND RELATED WORKS ALUMINUM PEDESTRIAN HANDRAIL DETAILS 1	CITY DRAWING NUMBER B100-90-16(R)
	DESIGNED BY JC & FPC	CHECKED BY [Signature]				
	DRAWN BY LG & GI	APPROVED BY [Signature]				
2 REVISED AS CONSTRUCTED 901214 FPC	HOR. SCALE AS NOTED	AUTHORIZED BY [Signature] DATE 9/22/90				
ADDENDUM 900314 FC	VERTICAL AS NOTED	ACCEPTED BY [Signature] DATE 9/22/90				
NO REVISIONS	DATE BY	DATE JAN. 15, 1990				

AS-BUILT
DATE 9/22/90 BY [Signature]
CHECKED BY [Signature]

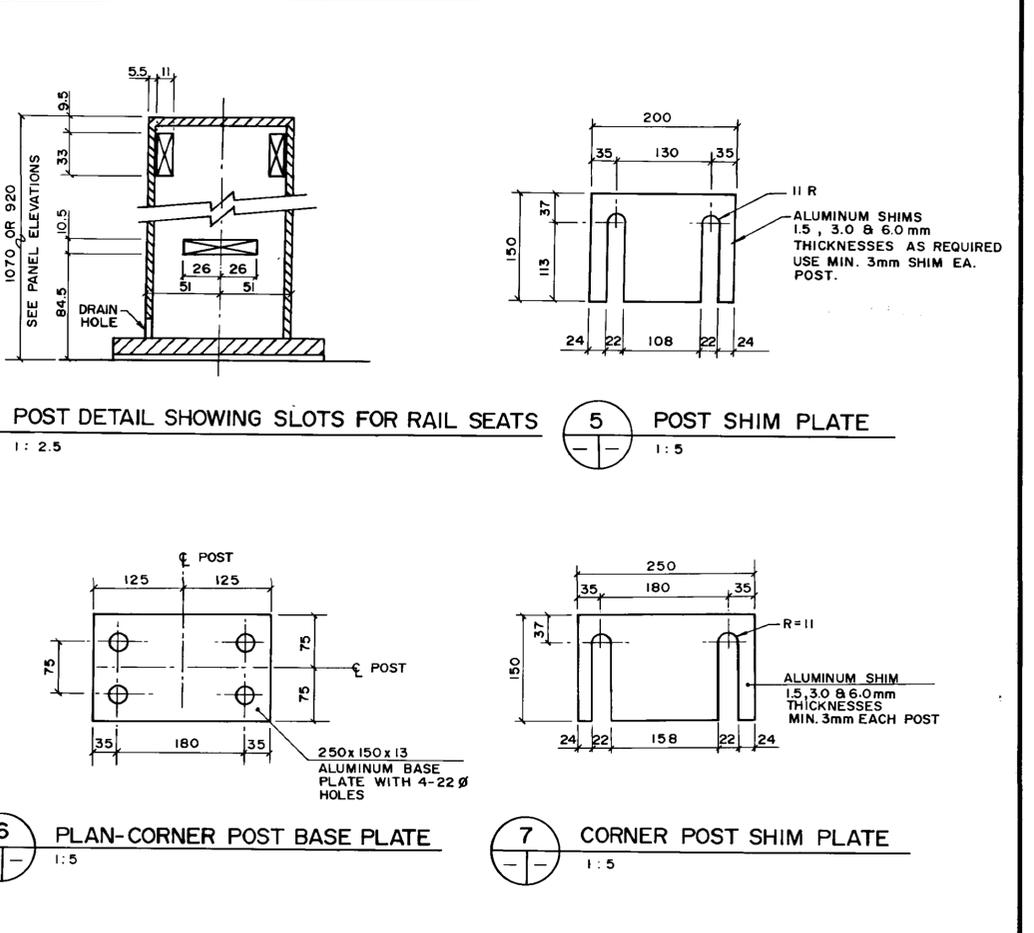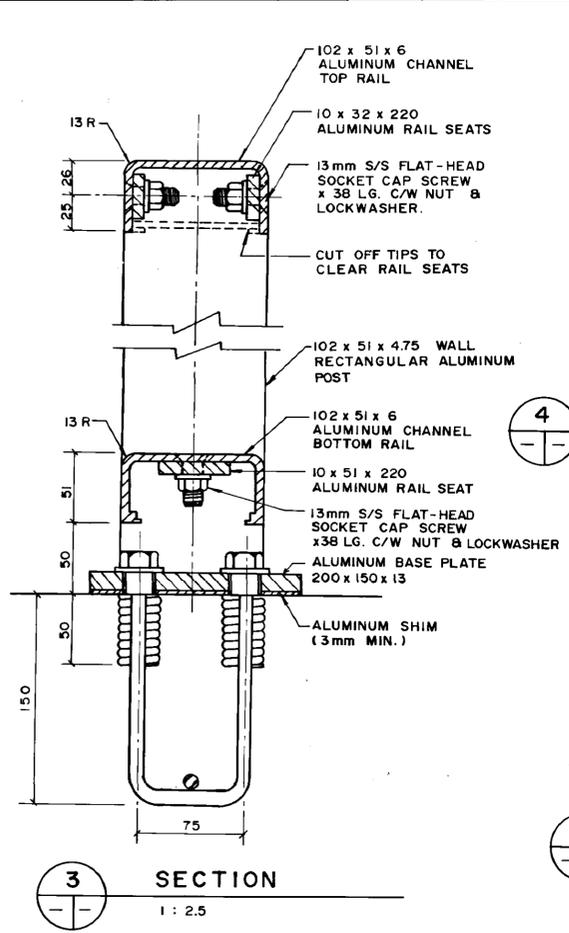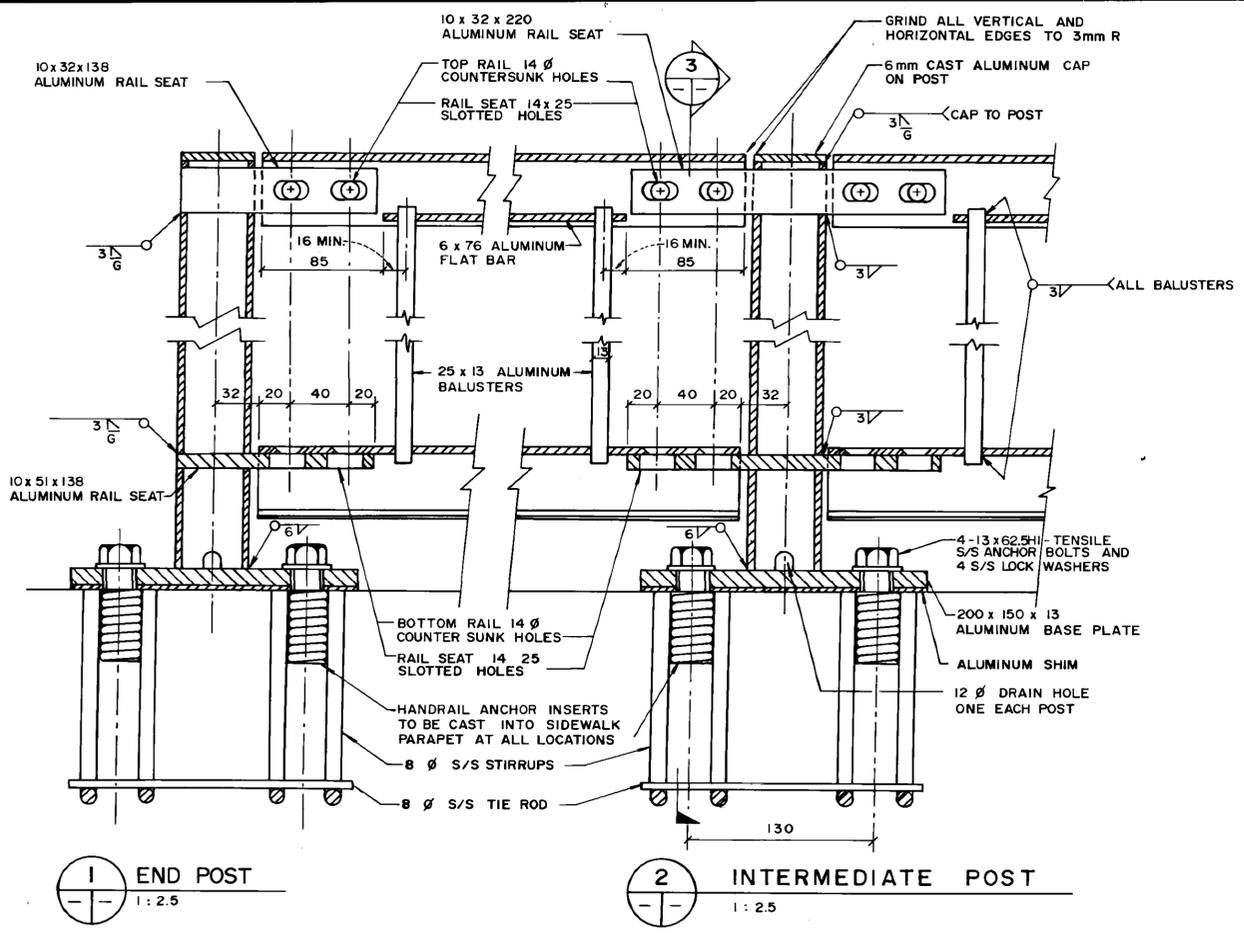

TYPICAL POST DETAILS

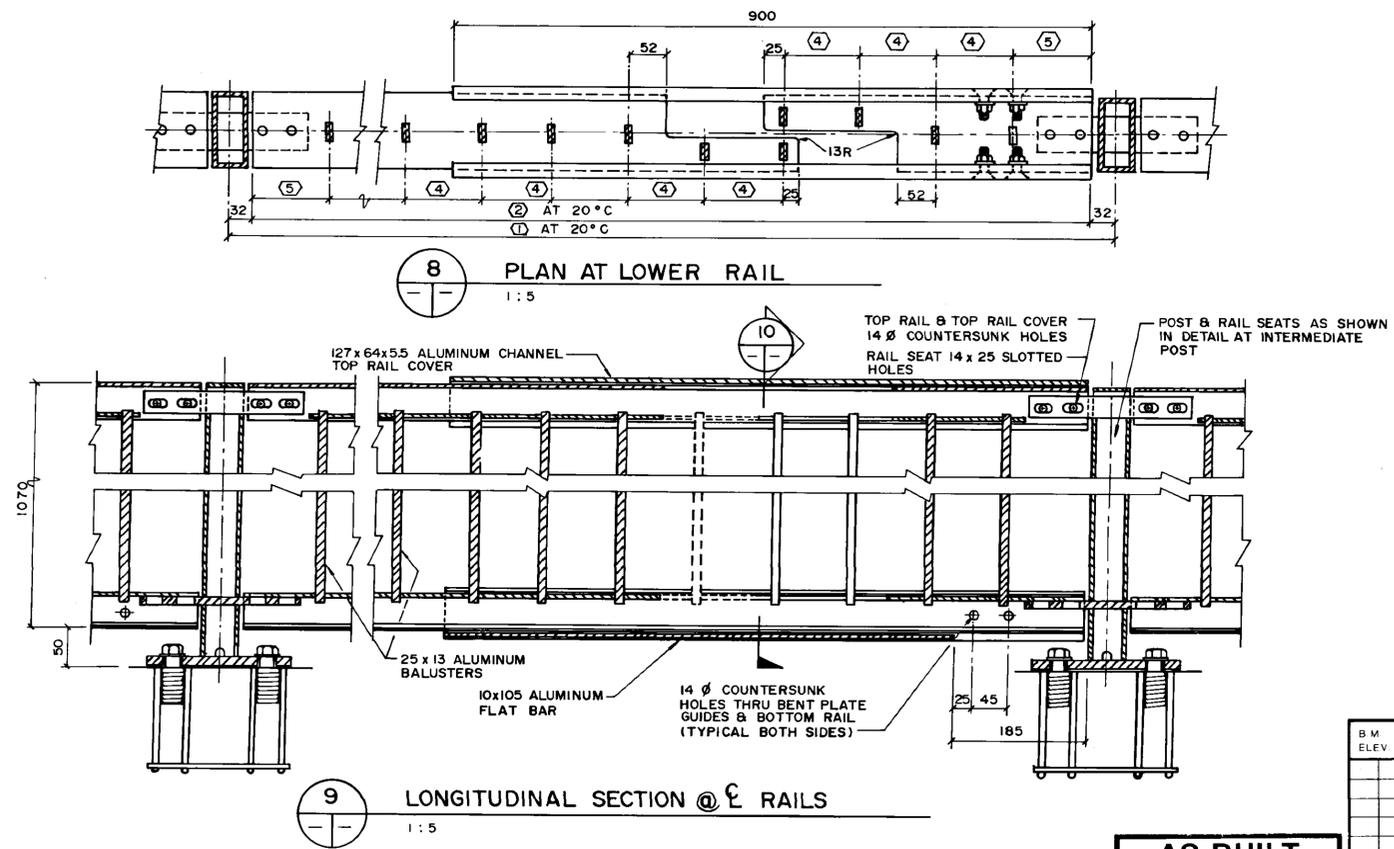

EXPANSION PANEL TYPE 'B' DETAILS

AS-BUILT
DATE 9.02.26 BY *JW*
CHECKED BY *JW*

B.M. ELEV.	
DESIGNED BY	JC & FPC
DRAWN BY	GI
HOR. SCALE	AS NOTED
VERTICAL	AS NOTED
NO. REVISIONS	
DATE	JAN. 15, 1990

WARDROP ENGINEERING INC.	
DESIGNED BY	JC & FPC
DRAWN BY	GI
HOR. SCALE	AS NOTED
VERTICAL	AS NOTED
NO. REVISIONS	
DATE	JAN. 15, 1990

ENGINEER
C. D. STEWART
REGISTERED ENGINEER
CONSULTANT DRAWING NO. 890007-02-00


THE CITY OF WINNIPEG
WORKS AND OPERATIONS DIVISION
STREETS AND TRANSPORTATION DEPARTMENT

EMPRESS STREET OVERPASS
STRUCTURE REHABILITATION, STRENGTHENING AND RELATED WORKS


ALUMINUM PEDESTRIAN HANDRAIL DETAILS 2

CITY DRAWING NUMBER
B100-90-17

B-5903-20

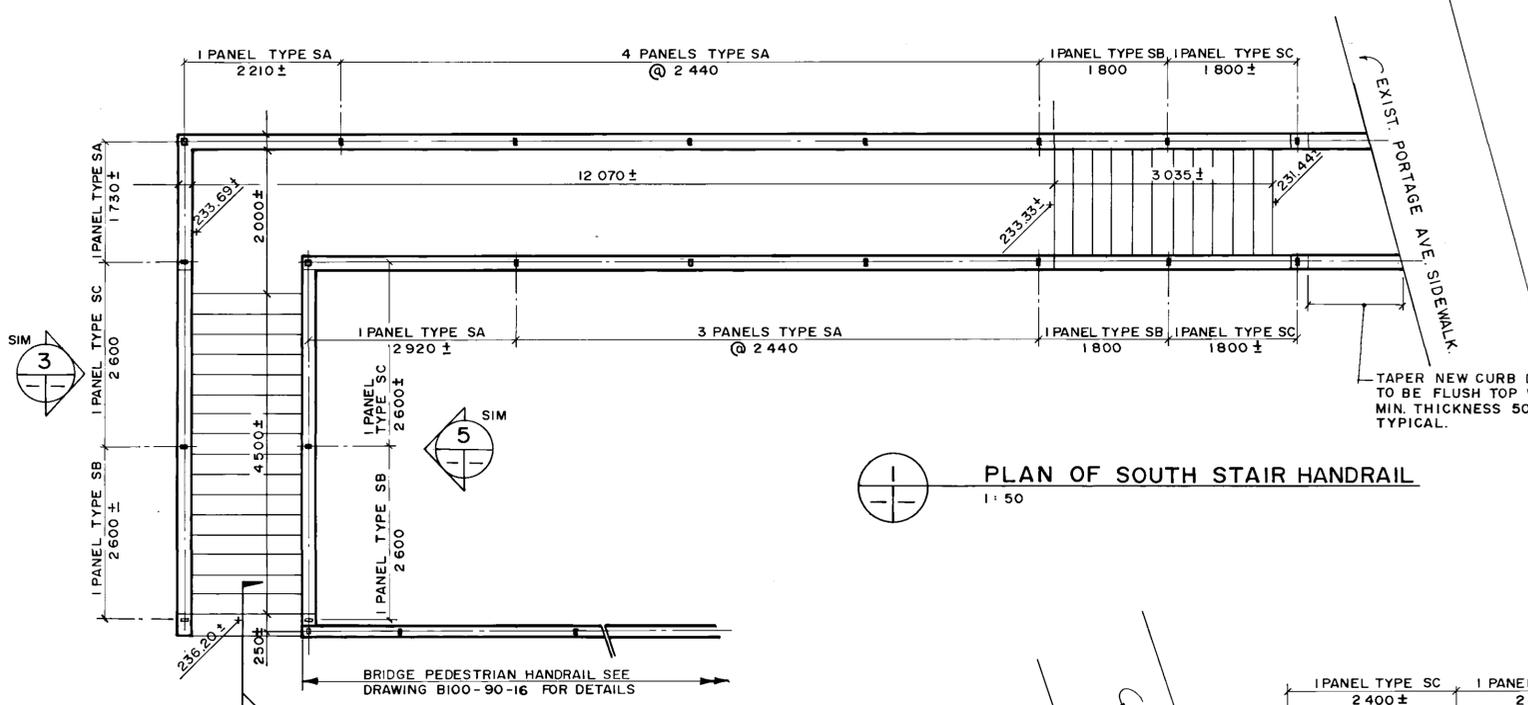

1 PLAN OF SOUTH STAIR HANDRAIL
1:50

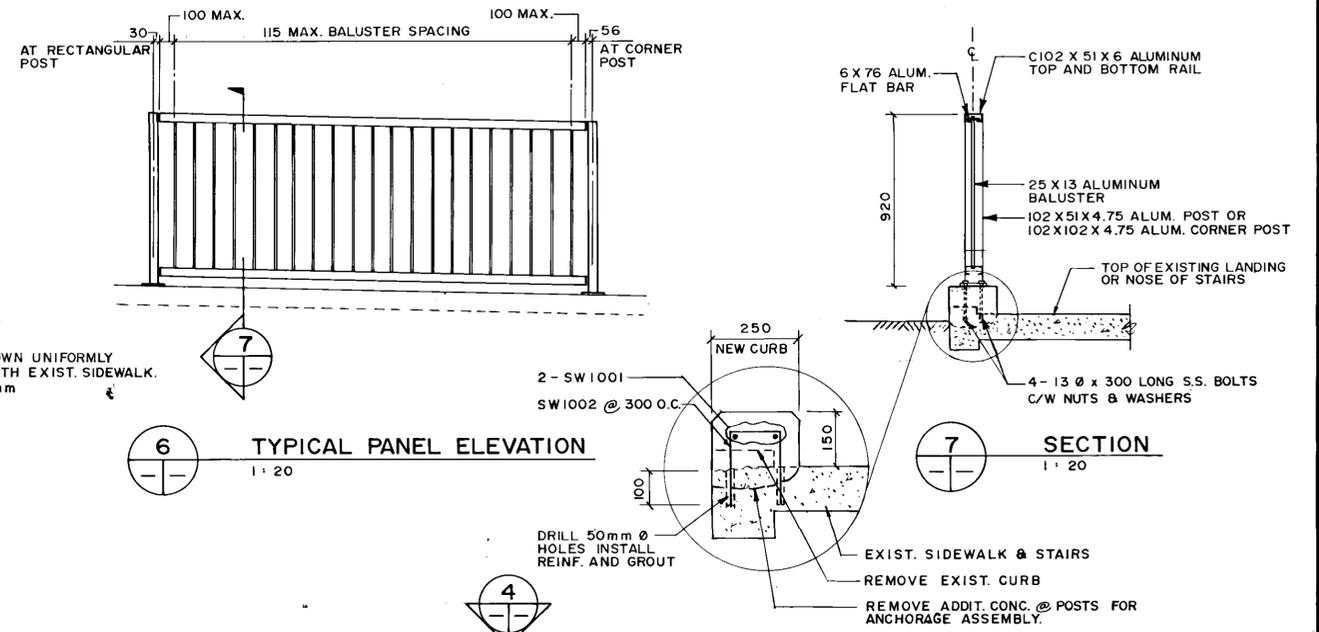


6 TYPICAL PANEL ELEVATION
1:20


7 SECTION
1:20

NOTES:


1. Remove existing steel pipe handrail and replace with new aluminum pedestrian handrail as shown.
2. This drawing is representational only. All dimensions must be verified by the contractor prior to fabrication of handrails.
3. Connections, inserts, notes, and handrail panel details same as bridge pedestrian handrail details unless noted otherwise. Refer to drawing B100-90-16.
4. Existing stair concrete to be patched with epoxy grout as directed by Contract Administrator.
5. Remove existing concrete curbs, chip down additional 50mm @ posts to accommodate post bolting assembly & install new curb. See Section 7.

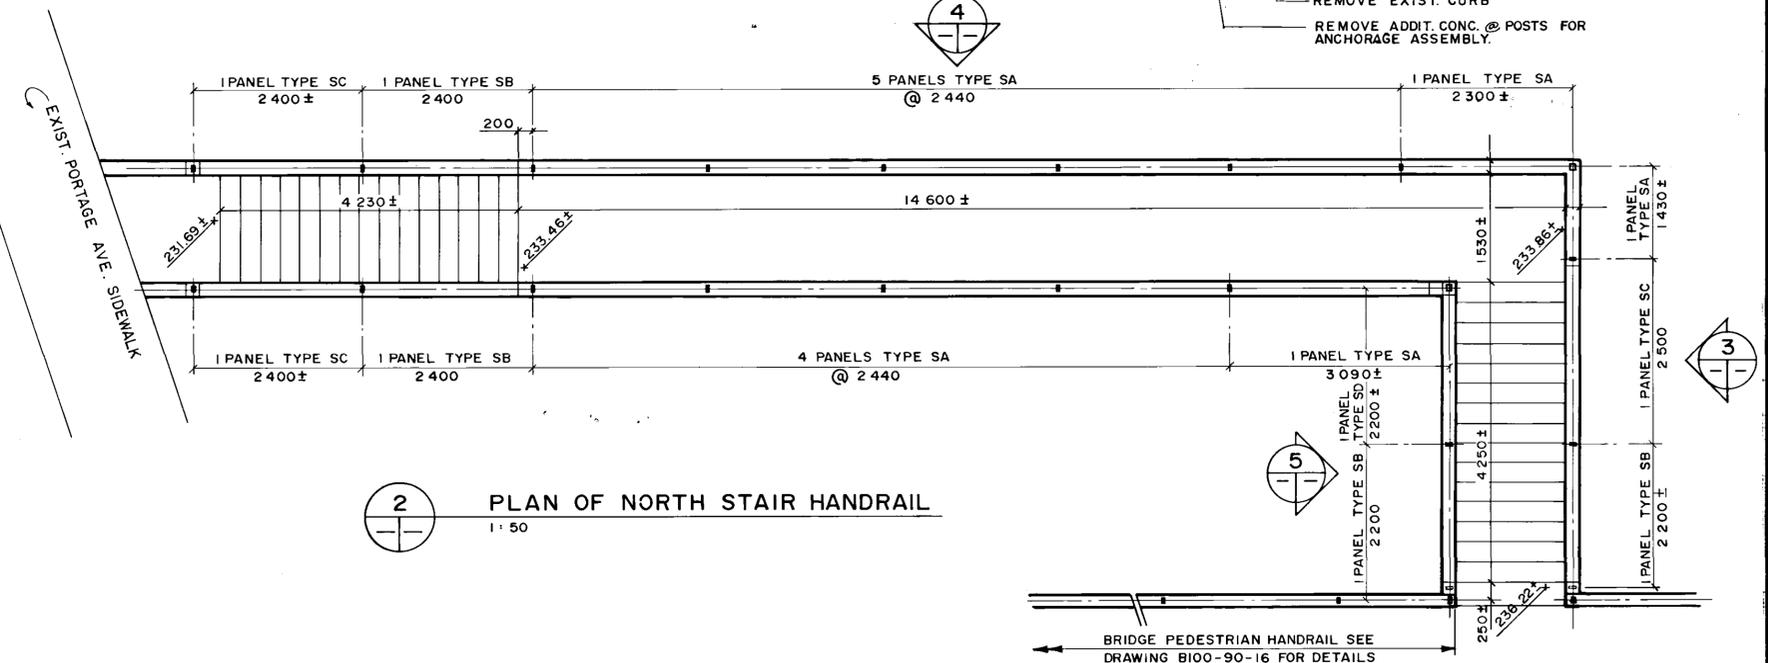


2 PLAN OF NORTH STAIR HANDRAIL
1:50

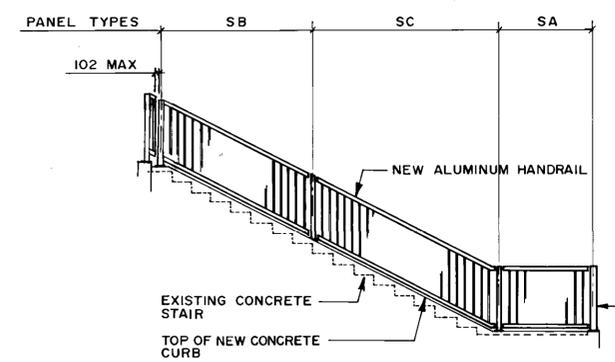


3 TYPICAL ELEVATION
1:50

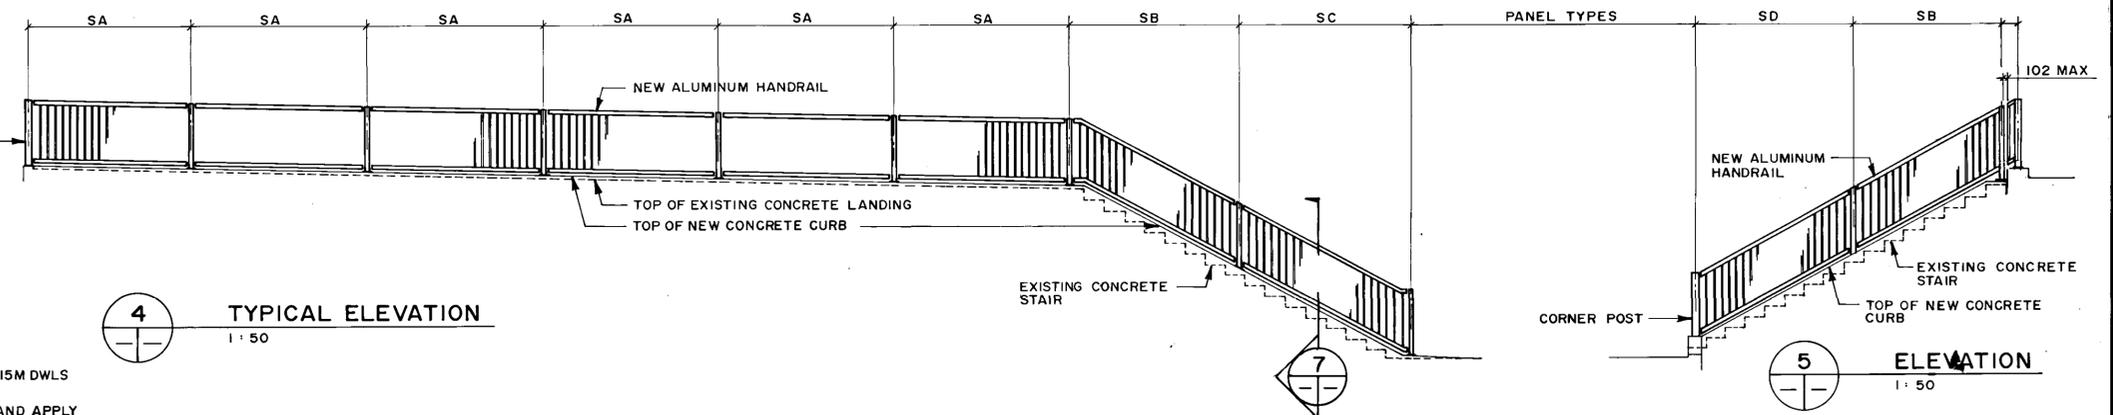

4 TYPICAL ELEVATION
1:50

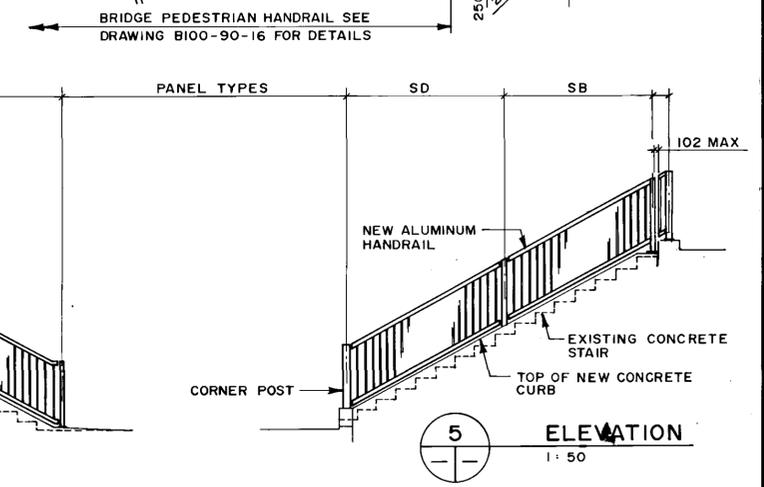

5 ELEVATION
1:50

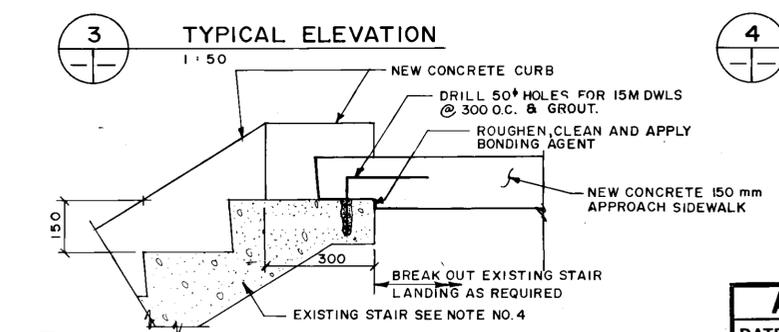

8 SECTION - TOP OF EXISTING STAIR
1:10

AS-BUILT
DATE 9/22/26 BY [Signature]
CHECKED BY [Signature]





LOCATION APPROVED UNDERGROUND STRUCTURES
N/A
SUPV. U/G STRUCTURES COMMITTEE DATE
NOTE:
LOCATION OF UNDERGROUND STRUCTURES AS SHOWN ARE BASED ON THE BEST INFORMATION AVAILABLE BUT NO GUARANTEE IS GIVEN THAT ALL EXISTING UTILITIES ARE SHOWN OR THAT THE GIVEN LOCATIONS ARE EXACT. CONFIRMATION OF EXISTENCE AND EXACT LOCATION OF ALL SERVICES MUST BE OBTAINED FROM THE INDIVIDUAL UTILITIES BEFORE PROCEEDING WITH CONSTRUCTION.

B.M. ELEV.	
DESIGNED BY	JC & FPC
CHECKED BY	[Signature]
DRAWN BY	LG
APPROVED BY	[Signature]
HOR. SCALE	AS NOTED
VERTICAL	AS NOTED
REVISIONS	






WARDROP ENGINEERING INC.
DESIGNED BY JC & FPC
CHECKED BY [Signature]
DRAWN BY LG
APPROVED BY [Signature]
HORIZ. SCALE: AS NOTED
VERTICAL: AS NOTED
DATE: JAN 15, 1990

ENGINEER
PROVINCE OF MANITOBA
C.D. STEWART
REGISTERED ENGINEER
CONSULTANT DRAWING NO. 890007-02-00

THE CITY OF WINNIPEG
WORKS AND OPERATIONS DIVISION
STREETS AND TRANSPORTATION DEPARTMENT
EMPRESS STREET OVERPASS
STRUCTURE REHABILITATION, STRENGTHENING AND RELATED WORKS
ALUMINUM PEDESTRIAN HANDRAILS NORTH AND SOUTH STAIRS
CITY DRAWING NUMBER: B100-90-19
B-5903-22

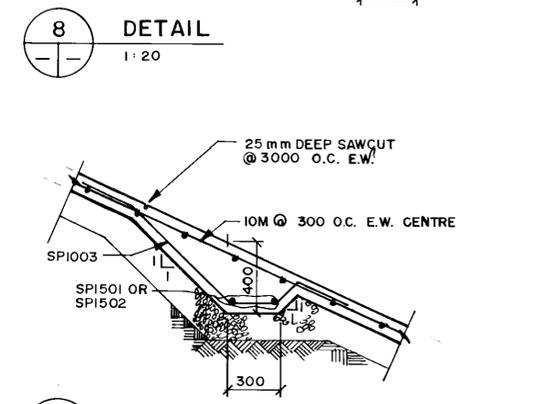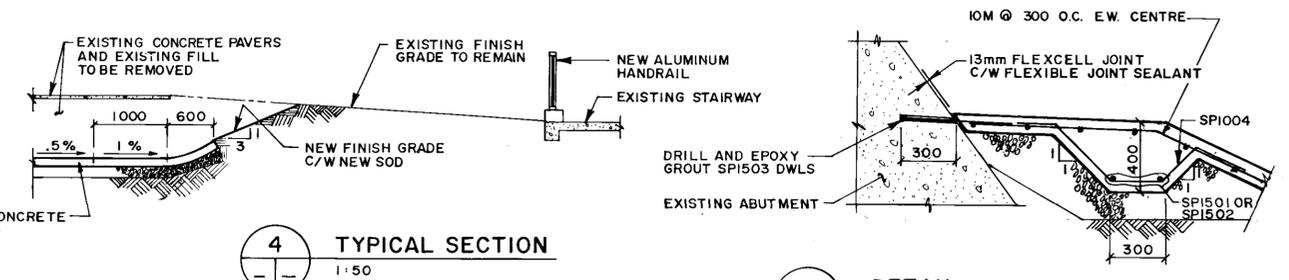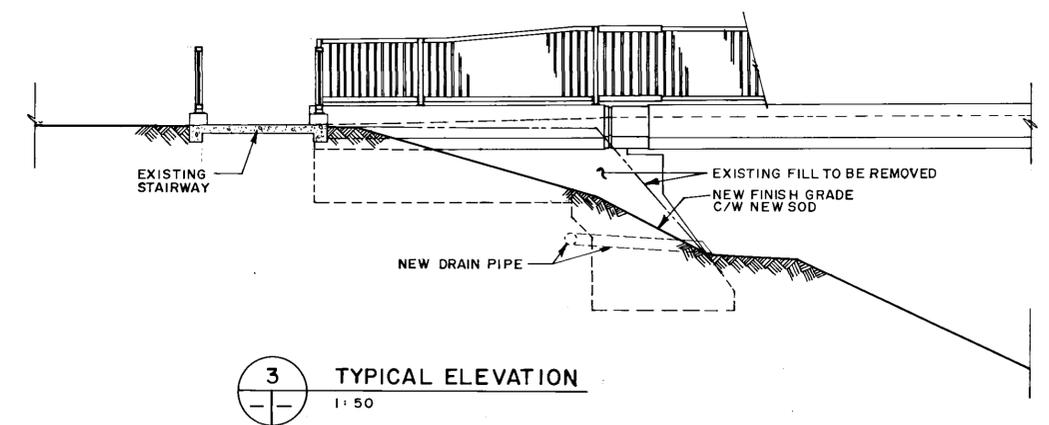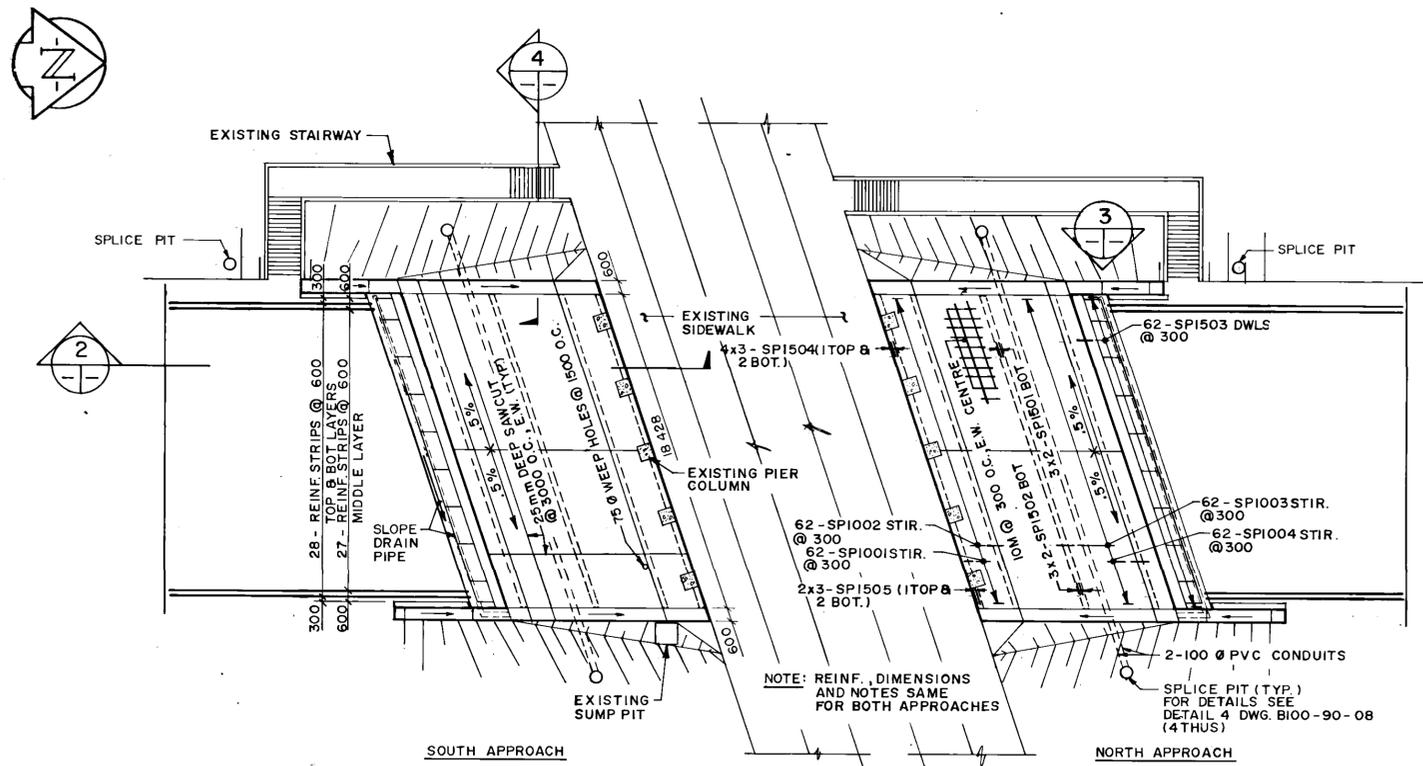

100 WIDE GEOGRID SOIL REINFORCEMENT STRIPS LAPPED TO GALVANIZED STEEL REINF. STRIPS AS SHOWN.

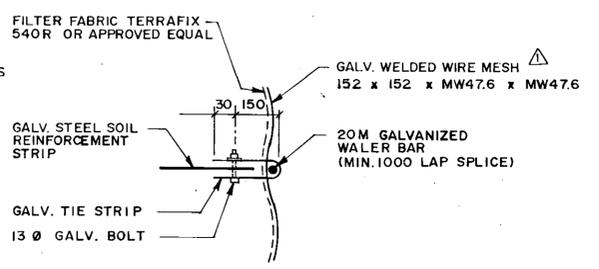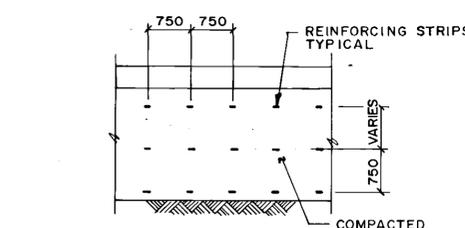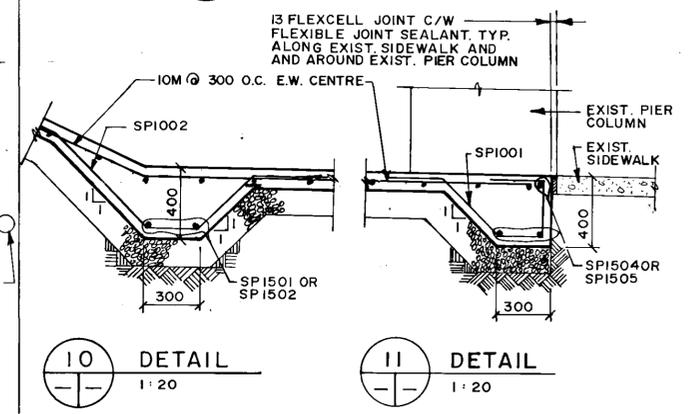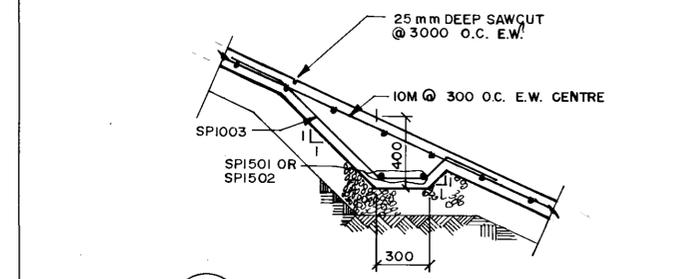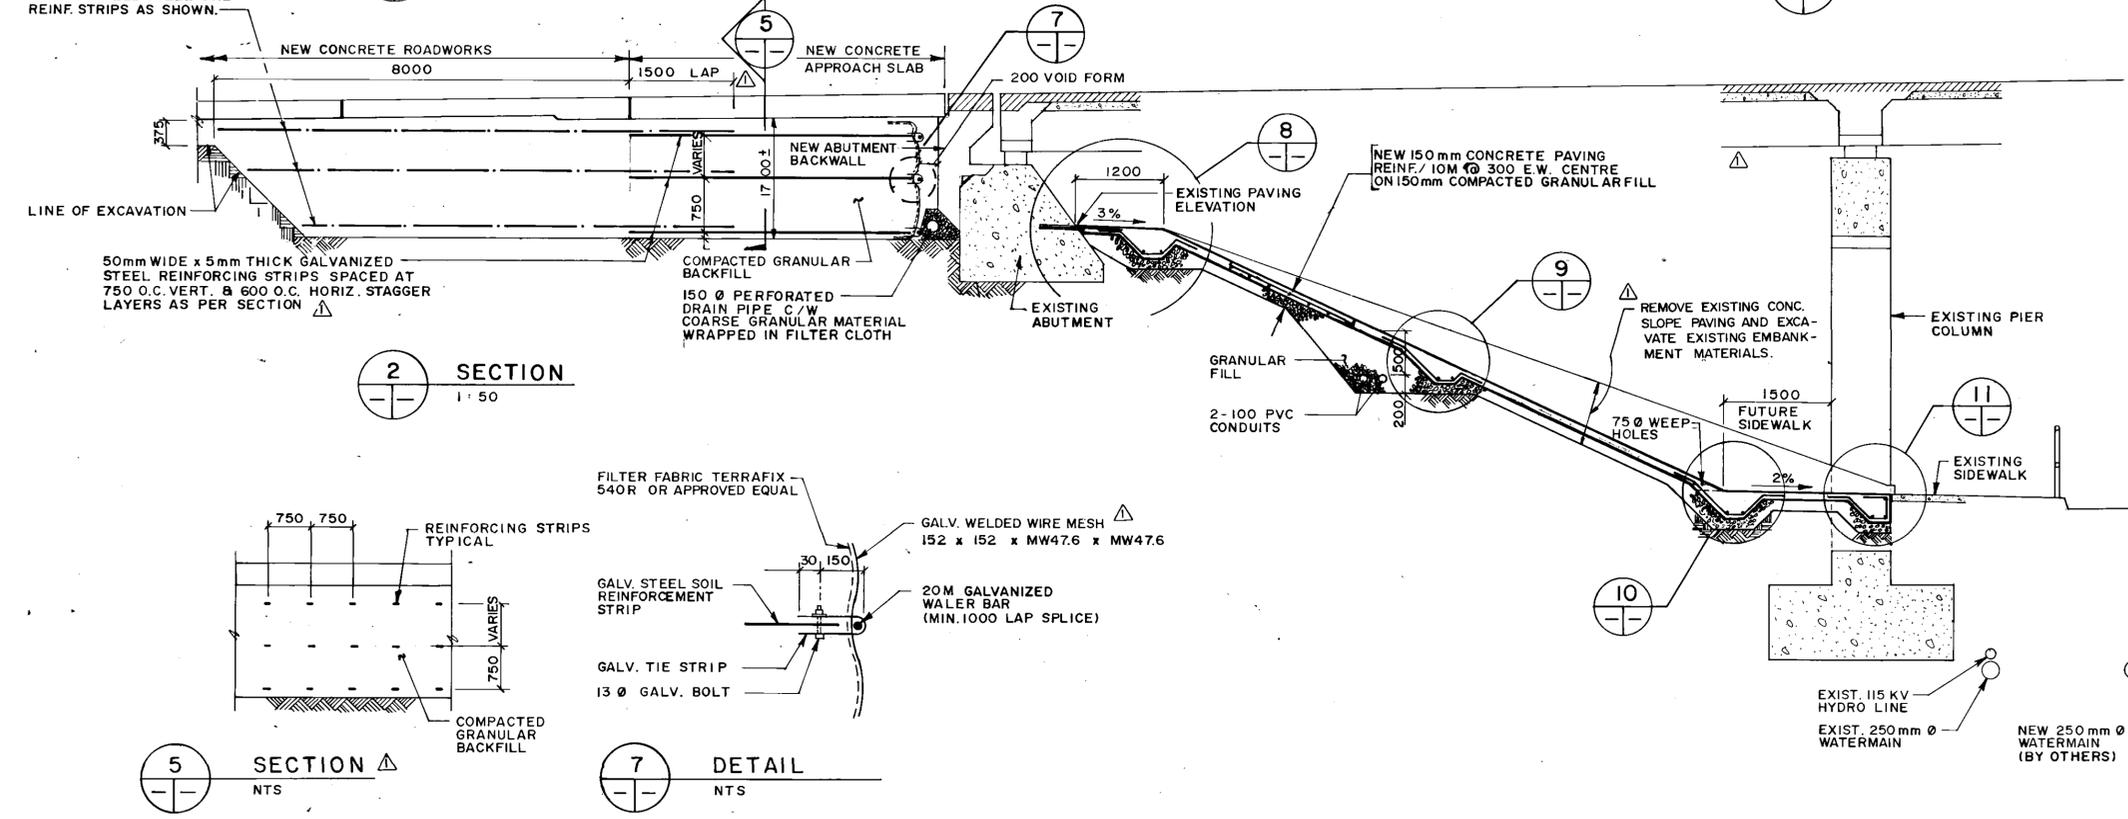

B-5903-23

LOCATION APPROVED UNDERGROUND STRUCTURES N/A SUPV. U/G STRUCTURES DATE COMMITTEE		WARDROP ENGINEERING INC.		ENGINEER 		THE CITY OF WINNIPEG WORKS AND OPERATIONS DIVISION STREETS AND TRANSPORTATION DEPARTMENT	
NOTE: LOCATION OF UNDERGROUND STRUCTURES AS SHOWN ARE BASED ON THE BEST INFORMATION AVAILABLE BUT NO GUARANTEE IS GIVEN THAT ALL EXISTING UTILITIES ARE SHOWN OR THAT THE GIVEN LOCATIONS ARE EXACT CONFIRMATION OF EXISTENCE AND EXACT LOCATION OF ALL SERVICES MUST BE OBTAINED FROM THE INDIVIDUAL UTILITIES BEFORE PROCEEDING WITH CONSTRUCTION		DESIGNED BY JC & FPC DRAWN BY LG 2 REVISED AS CONSTRUCTED 90-2-14 FPC ADDENDUM 90-3-19 F.P.C. NO REVISIONS		CHECKED BY <i>fu</i> APPROVED BY <i>[Signature]</i> AUTHORIZED BY DATE <i>9/12/93</i> ACCEPTED BY DATE <i>9/12/93</i> S. SMITH/ BRIDGE ENGINEER		CITY DRAWING NUMBER B100-90-20(R1)	
AS-BUILT DATE 9/12/93 BY <i>[Signature]</i> CHECKED BY <i>[Signature]</i>		HOR. SCALE AS NOTED VERTICAL AS NOTED DATE JAN. 15, 1990		CONSULTANT DRAWING NO. 890007-02-00		EMPRESS STREET OVERPASS STRUCTURE REHABILITATION, STRENGTHENING AND RELATED WORKS RECONSTRUCTION OF CONCRETE SLOPE PAVING AND APPROACH SOIL STABILIZATION	

MARK	NO. BARS	SIZE	LENGTH	TYPE	A	B	C	D	E	F	G	H	J	K	L	M	O	R	SHAPE	MASS Kg
TRAFFIC BARRIER																				
B1001E	240	10	1180	T2	100	190	300	190	300		100								□	222.3
B1002E	96	10	600	ST																45.2
B1003E	6	10	3800	ST																17.9
B1501E	192	15	5625	ST																1695.6
B1502E	14	15	4370	ST																96.1
B1503E	14	15	375	ST																8.2
B1504E	14	15	4130	ST																90.8
B1505E	14	15	4520	ST																99.4
B1506E	14	15	225	ST																4.9
B1507E	14	15	4430	ST																97.4
B1508E	780	15	1035	16	-	500	170	365				300	210						□	1267.5
B1509E	20	15	4420	ST																138.8
B1510E	16	15	275	ST																6.9
B1511E	16	15	4280	ST																107.5
ABUTMENT BACKWALL																				
A1501E	124	15	1300	17		500	800	-											□	253.1
A1502	6	15	1200	17		-	300	900											□	11.3
A1503	6	15	1685	X2	675	215	800					150	150						□	15.9
A1505	6	15	825	17		300	225	300											□	7.8
A1506	6	15	1565	X2	1000	215	350					150	150						□	14.7
A1507	16	15	1600	17		300	1300	-											□	40.2
A1508	4	15	450	ST																2.8
A1509	10	15	500	ST																7.9
A2001	124	20	2220	X3	920	1300						650	650						□	648.3
A2002	124	20	1360	T5	210	650					500	140							□	379.2
A2003	22	20	7000	ST																362.7
A2004	22	20	12000	ST																621.7
A2005	124	20	1670	X4	500	250	920					650	650						□	487.7
A2006	12	20	1100	X1	300	250	550					315	450						□	31.1
A2007	6	20	2765	6	-	1950	215	600				-	150						□	39.1
A2008E	6	20	7000	ST																98.9
A2009E	6	20	12000	ST																169.6
A2010	124	20	900	17		300	600	-											□	262.8
A2501E	124	25	2200	17		1700	500	-											□	1070.7

- NOTES:
- ALL DIMENSIONS ARE OUT TO OUT OF BAR EXCEPT "A" AND "G" ON STANDARD 180 AND 135 DEGREE HOOKS.
 - "J" DIMENSION ON 180° HOOKS TO BE SHOWN ONLY WHERE NECESSARY TO RESTRICT HOOK SIZE. OTHERWISE STANDARD HOOKS ARE TO BE USED.
 - WHERE "J" IS NOT SHOWN, "J" WILL BE KEPT EQUAL TO OR LESS THAN "H" ON TRUSS BARS. WHERE "J" CAN EXCEED "H", IT SHOULD BE SHOWN.
 - "H" DIMENSION ON STIRRUPS TO BE SHOWN WHERE NECESSARY TO FIT WITHIN CONCRETE.
 - WHERE BARS ARE TO BE BENT MORE ACCURATELY THAN STANDARD BENDING TOLERANCES. BENDING DIMENSIONS WHICH REQUIRE CLOSER TOLERANCES SHOULD HAVE LIMITS INDICATED.
 - FIGURES IN ELLIPSES SHOW TYPES.
 - NO ALLOWANCE FOR BEND CURVATURE HAS BEEN MADE EXCEPT FOR STANDARD HOOK & RADII IN EXCESS OF SAME.
 - WEIGHT OF SUPPORT BARS, AND SPACERS NOT INCLUDED ON THIS TABLE.

9) ALL REINFORCING STEEL WITH & WITHOUT SUFFIX "E" SHALL BE EPOXY COATED.

WHERE SLOPE DIFFERS FROM 45°, DIMENSIONS "H" & "K" MUST BE SHOWN.




BAR BENDING DETAIL

AS-BUILT
DATE 9.22.26 BY [Signature]
CHECKED BY [Signature]

MARK	NO. BARS	SIZE	LENGTH	TYPE	A	B	C	D	E	F	G	H	J	K	L	M	O	R	SHAPE	MASS Kg
SLOPED PAVING																				
SP1001	124	10	1525	X6	300	425	200	300	300			300		300					□	148.4
SP1002	124	10	1925	X7	300	700	200	425	300		130	270	495	495	300	300	-	-	□	187.4
SP1003	124	10	1780	X7	300	790	200	190	300		130	270	560	560	135	135	130	270	□	173.3
SP1004	124	10	1500	X7	300	425	200	275	300		-	-	300	300	195	195	130	270	□	146.0
SP1501	12	15	12000	ST																226.1
SP1502	12	15	6825	ST																128.6
SP1503	124	15	600	ST																116.8
SP1504	24	15	2900	ST																109.3
SP1505	12	15	1250	ST																23.6
WELD WIRE FABRIC - 12x152 MW18.7x18.7 = 500 SQ. METERS																				
STAIR SIDEWALK																				
S1001	20	10	12000	ST															□	187.2
S1002	360	10	600	17		225	150	225											□	168.5
NORTH PAVEMENT/BARRIER																				
R1001	6	10	9900	ST																46.6
R1002	12	10	12000	ST																113.0
R2001	1	20	1510	X5		680	150	680				210	647						□	3.6
R2002	1	20	1420	X5		635	150	635				196	605						□	3.3
R2003	1	20	1330	X5		590	150	590				183	562						□	3.1
R2004	1	20	1240	X5		545	150	545				169	519						□	2.9
R2005	1	20	1150	X5		500	150	500				155	476						□	2.7
R2006	1	20	1060	X5		455	150	455				141	433						□	2.5
R2007	1	20	970	X5		410	150	410				127	390						□	2.3
R2008	1	20	880	X5		365	150	365				113	347						□	2.1
R2009	1	20	790	X5		320	150	320				99	305						□	1.9
R2010	1	20	700	X5		275	150	275				85	262						□	1.6
R2011	1	20	610	X5		230	150	230				71	219						□	1.4
R2012	24	20	400	X3	200	200						114	164						□	22.6
R2013	114	20	280	X3	30	250						17	24						□	75.2



BREAKDOWN OF REINFORCING STEEL MASS

LOCATION	EPOXY COATED
DIAPHRAGMS	3374.1
PIER BRACKET	356.6
SOUTH PAVEMENT / BARRIER	507.2
STRUCTURAL SIDEWALK	201.7
APPROACH SLABS & SIDEWALKS	8849.8
DECK SLAB & SIDEWALK	27845.1
TRAFFIC BARRIER	6492.9
ABUTMENT BACKWALL	4530.5
SLOPED PAVING	1259.5
STAIR SIDEWALKS	355.7
NORTH PAVEMENT / BARRIER	284.8
TOTAL MASS (Kg)	54057.9

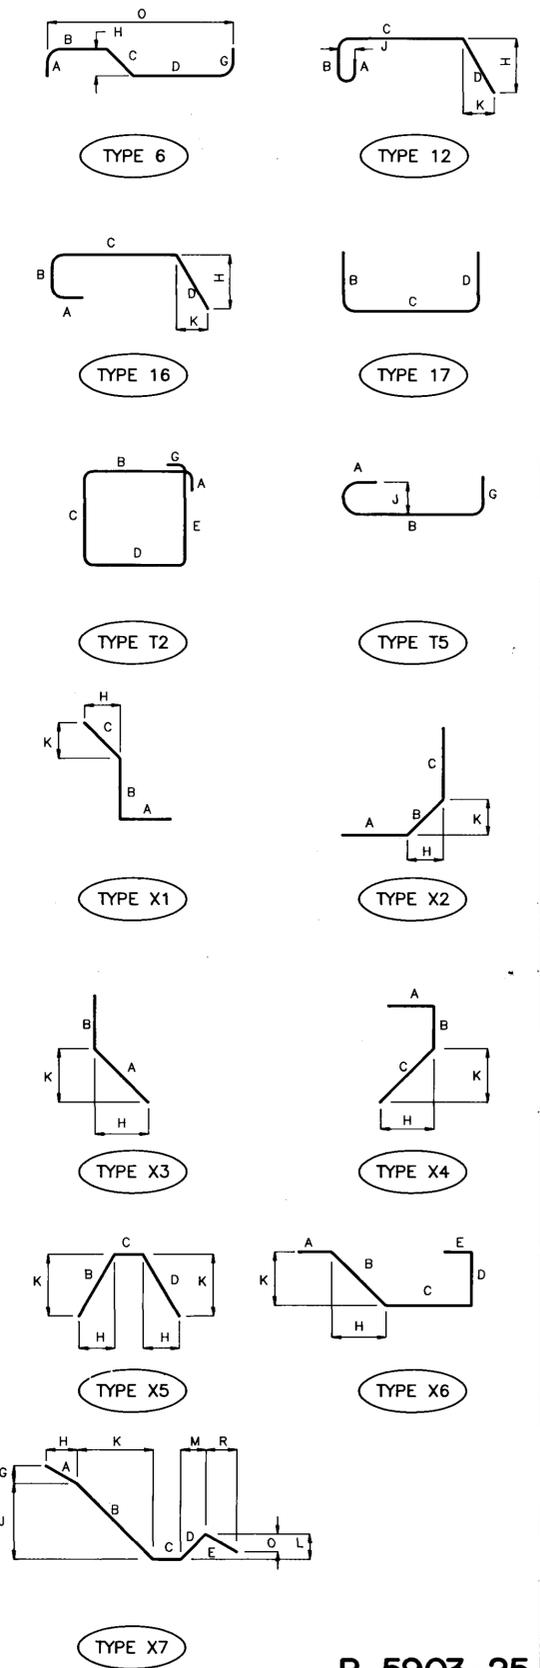

B-5903-25

B.M. ELEV.	WARDROP ENGINEERING INC.		ENGINEER'S SEAL C.D. STEWART REGISTERED ENGINEER	THE CITY OF WINNIPEG WORKS AND OPERATIONS DIVISION STREETS AND TRANSPORTATION DEPARTMENT
DESIGNED BY J.C. & F.P.C.	CHECKED BY [Signature]	APPROVED BY [Signature]	EMPRESS STREET OVERPASS	CITY DRAWING NUMBER
DRAWN BY G.R.A.	HOR. SCALE: N.T.S.	DATE JAN 15, 1990	STRUCTURE REHABILITATION, STRENGTHENING AND RELATED WORKS	B100-90-22A(RI)
2 REVISED AS CONSTRUCTED 90-12-14 FPC	ACCEPTED BY [Signature]	DATE 9.12.23	REINFORCING STEEL SCHEDULE ALTERNATIVE A	
ADDENDUM 90-3-19 FC	CONSULTANT DRAWING NO. 890007-02-00			

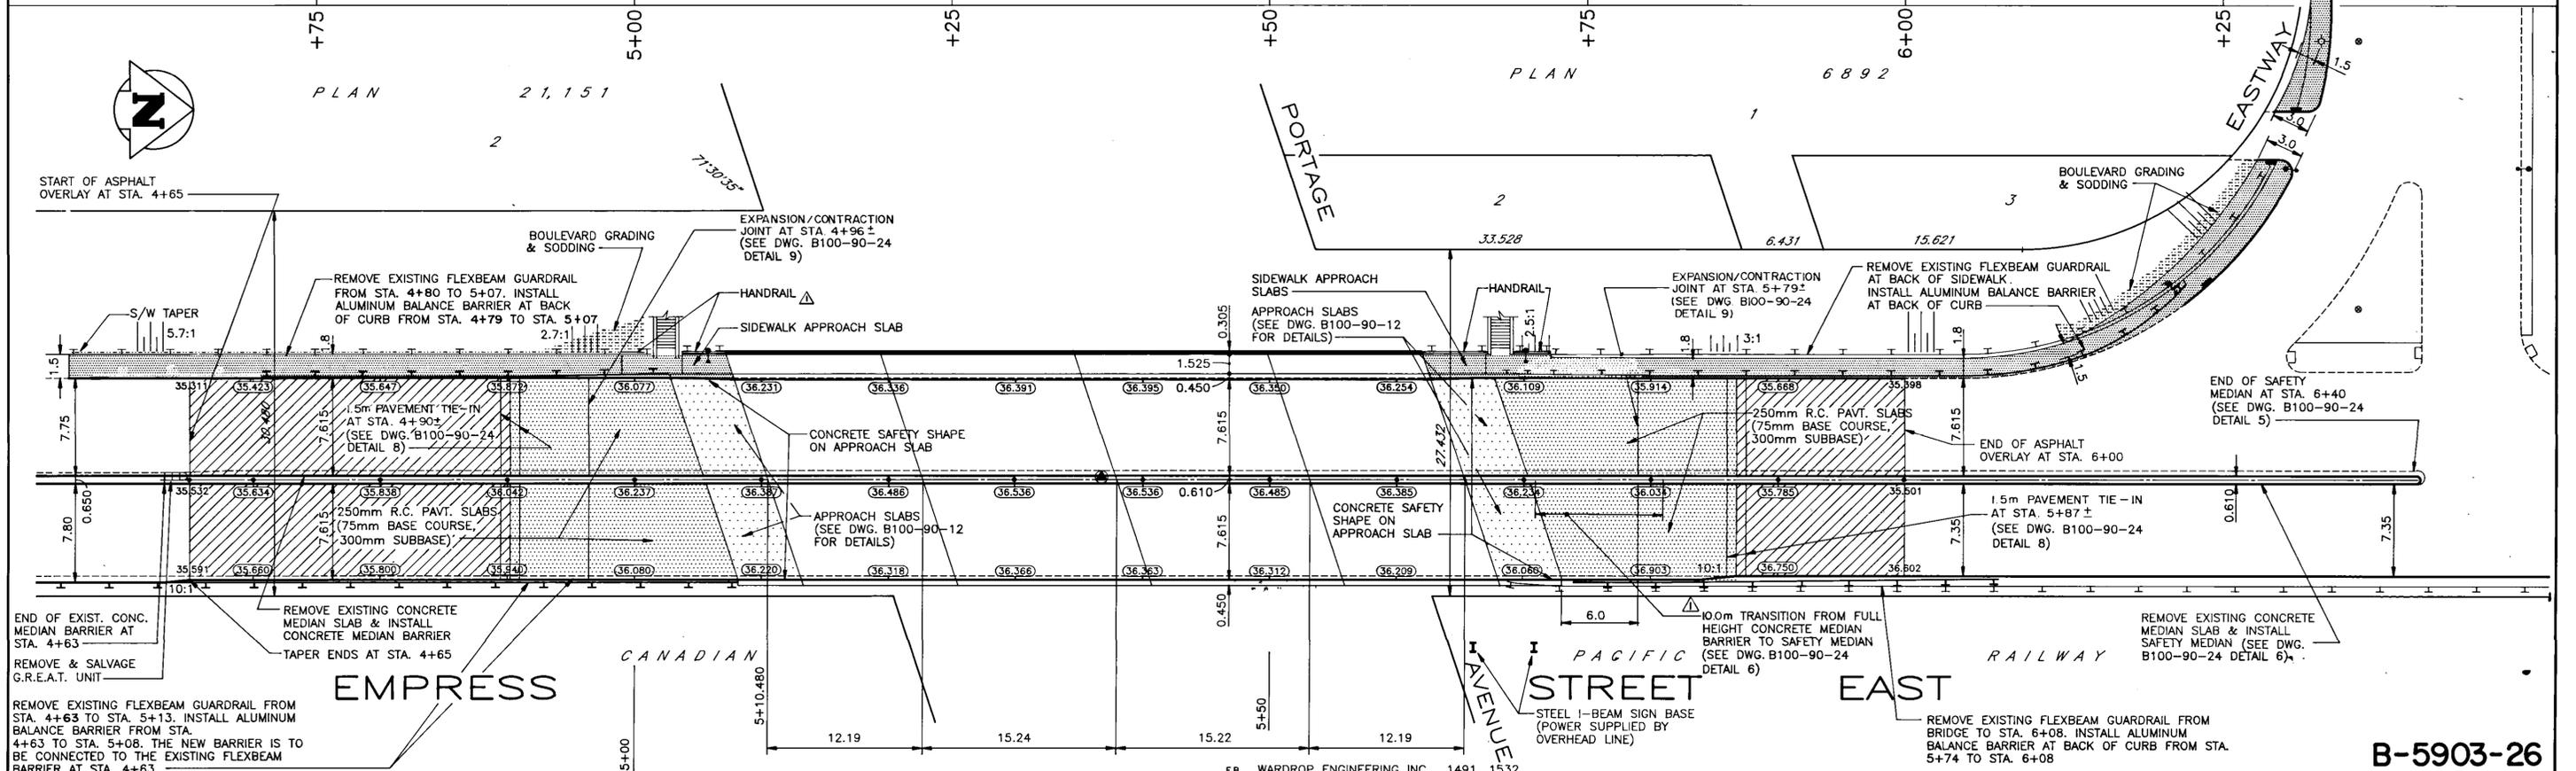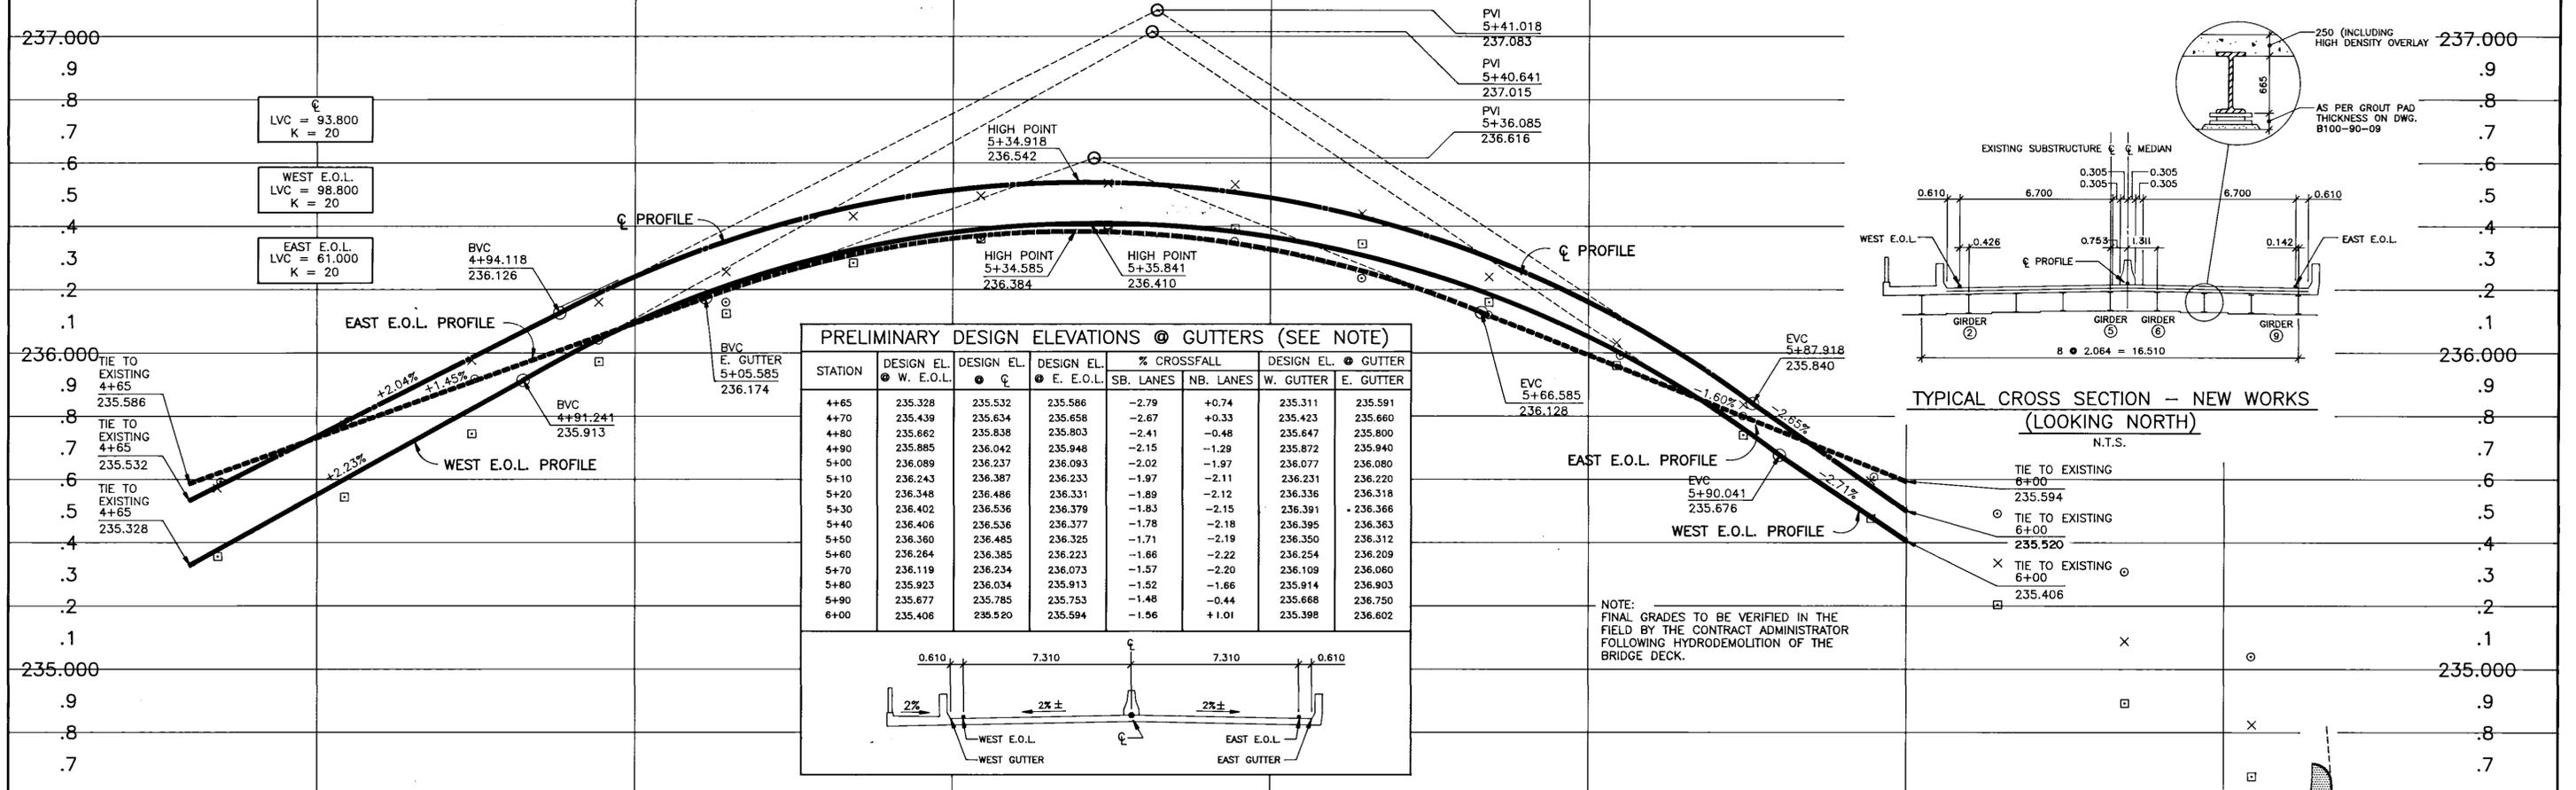

F.B. WARDROP ENGINEERING INC. 1491, 1532

B.M. CITY OF WINNIPEG ELEV. 36.733 37-041

WARDROP ENGINEERING INC.

DESIGNED BY G.O. CHECKED BY M.S.

DRAWN BY G.M.D. APPROVED BY *[Signature]*

AUTHORIZED BY *[Signature]* DATE 9/12/15

ACCEPTED BY *[Signature]* DATE 9/22/15

CONSULTANT DRAWING NO. 89007-02-00

THE CITY OF WINNIPEG
WORKS AND OPERATIONS DIVISION
STREETS AND TRANSPORTATION DEPARTMENT

EMPRESS STREET OVERPASS
STRUCTURE REHABILITATION, STRENGTHENING AND RELATED WORKS

ROADWAY RECONSTRUCTION PLAN AND PROFILE


CITY DRAWING NUMBER B100-90-23(RI)

AS-BUILT
DATE 9/02/26 BY *[Signature]*
CHECKED BY *[Signature]*


NO.	REVISIONS	DATE	BY
2	REVISED AS CONSTRUCTED	90/12/14	F.P.C.
1	ADDENDUM	90/3/19	G.O.

EXISTING	LEGEND-PLAN	PROPOSED	EXISTING	LEGEND-PLAN	PROPOSED	EXISTING	LEGEND-PROFILE	PROPOSED
---	SIDEWALK RAMP	---	CONCRETE PAVEMENT SLABS	---	ASPHALT RESURFACING	---	WEST GUTTER	---
+	HYDRANT	+	APPROACH SLABS	+	APPROACH SLABS	+	EAST GUTTER	+
○	VALVE	○	CENTRELINE ELEVATION	○	GUTTER ELEVATION	○	WEST E.O.L.	○
—	PROPERTY LINE	—	SIDEWALK	—	GUARDRAIL	—	EAST E.O.L.	—
●	GEODETIC BENCHMARK	●	GUARDRAIL	●	---	●	CENTRELINE	●


- NOTES:
1. CONCRETE AS PER CW 3310-R4
 2. TRANSVERSE JOINT SPACING TO MATCH EXISTING PAVEMENT SLAB JOINT SPACING
 3. ALL REINFORCING FOR MEDIAN BARRIER AND SAFETY MEDIAN TO BE EPOXY COATED.

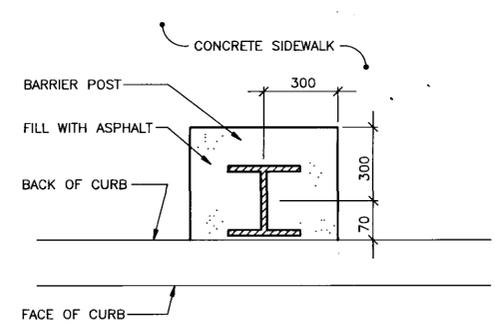


1 ALUMINUM BALANCE BARRIER POST BLOCKOUT IN CONCRETE SIDEWALK (PLAN VIEW)
N.T.S.

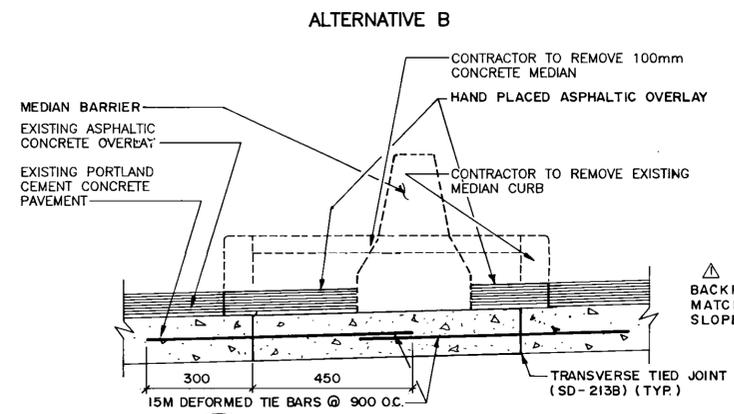


2 TYPICAL CROSS-SECTION DETOUR - ROADWAY CROSSOVER
N.T.S.

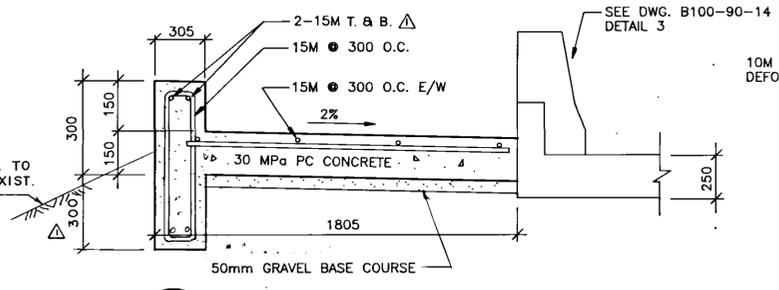


3 DETAIL @ APPROACH SIDEWALK SLAB WITH RAILING AT NORTH WEST CORNER OF BRIDGE
N.T.S.

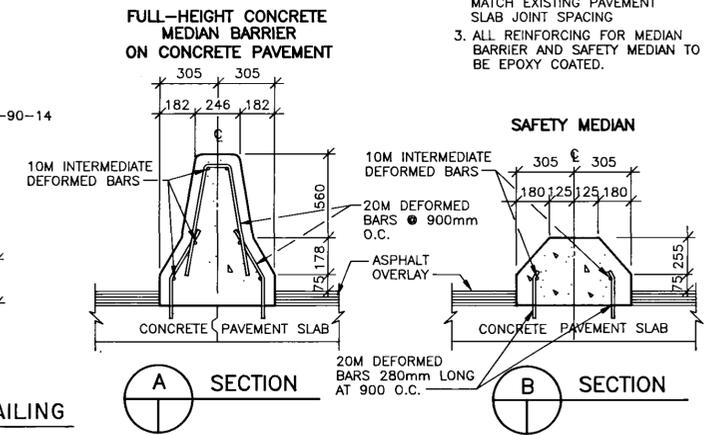


4 TRANSITION FROM FULL-HEIGHT CONCRETE MEDIAN BARRIER TO SAFETY MEDIAN
N.T.S.

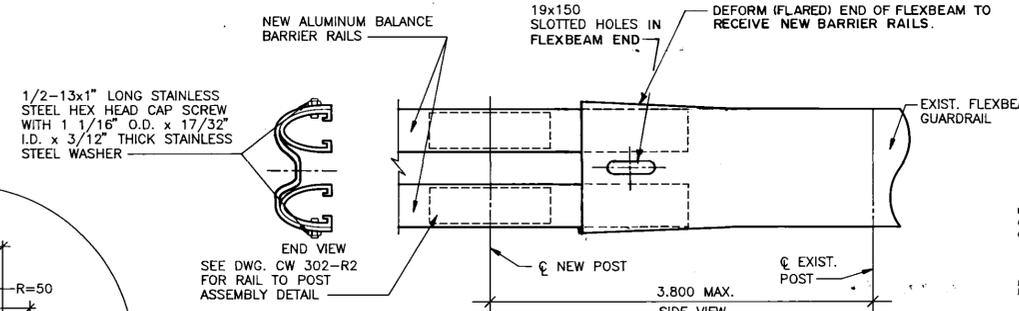


5 ALUMINUM BALANCE BARRIER & FLEXBEAM GUARDRAIL CONNECTION AT STA. 4+63 (E. SIDE OF EMPRESS ST.)
N.T.S.

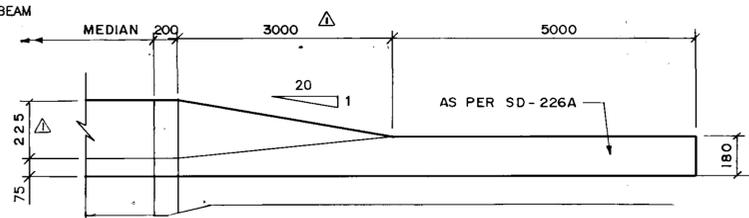


6 END OF SAFETY MEDIAN AT STA. 6+40
N.T.S.

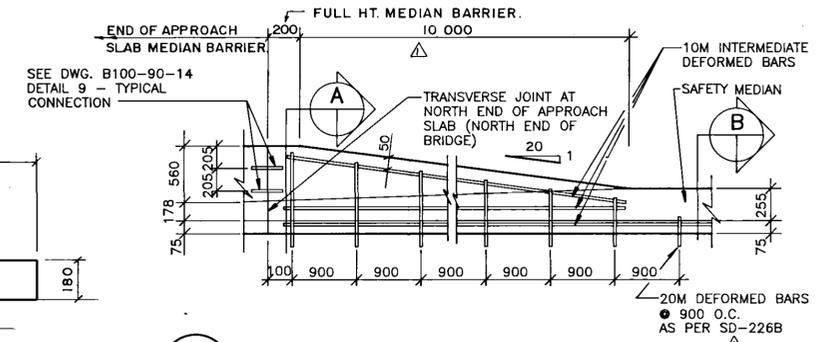


7 TRANSITION FROM FULL-HEIGHT CONCRETE MEDIAN BARRIER TO SAFETY MEDIAN
N.T.S.

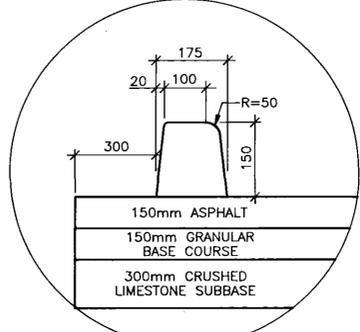


8 TEMPORARY LEFT-TURN LANE ON PORTAGE AVENUE EASTBOUND FOR DETOUR ALTERNATIVE A
N.T.S.

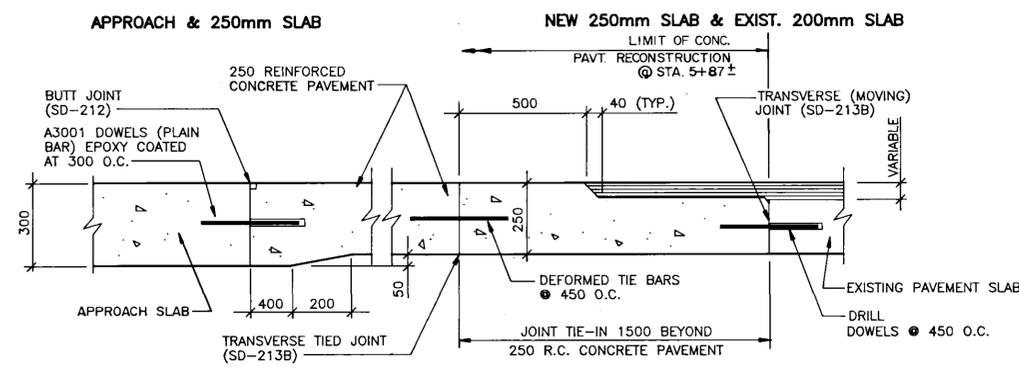

9 TYPICAL CONCRETE PAVEMENT TIE-IN
N.T.S.

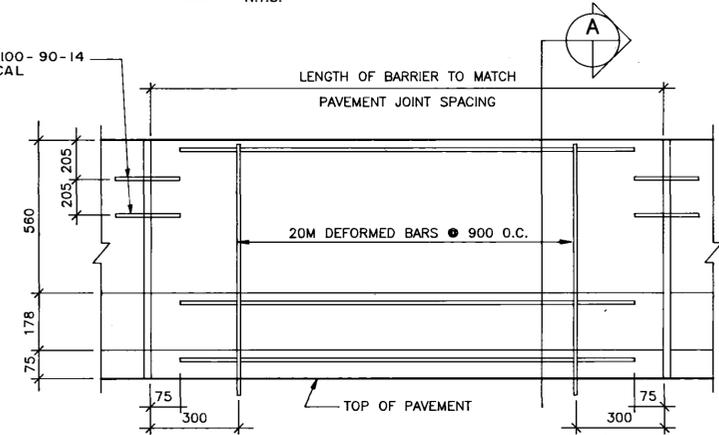

10 MEDIAN BARRIER - PAVEMENT
N.T.S.

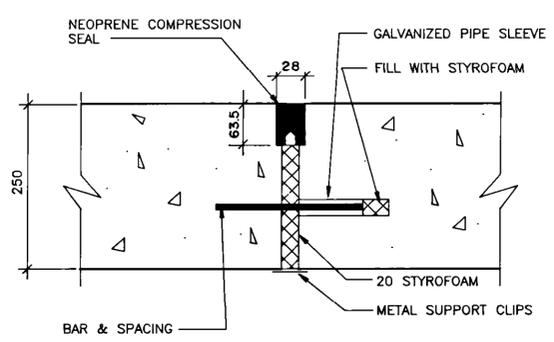

11 ROADWAY EXPANSION/CONTRACTION JOINT
N.T.S.

AS-BUILT
DATE 9/02/26 BY [Signature]
CHECKED BY [Signature]

NO.	REVISIONS	DATE	BY
2	REVISED AS CONSTRUCTED	90/2/14	F.P.C.
1	ADDENDUM	90/3/19	G.O.

WARDROP ENGINEERING INC.		ENGINEER'S SEAL PROVINCE OF MANITOBA 20/20 G.O. OUELLETTE REGISTERED PROFESSIONAL ENGINEER	
DESIGNED BY	G.O.	CHECKED BY	M.S.
DRAWN BY	G.M.D.	APPROVED BY	[Signature]
HOR. SCALE:	AS NOTED	AUTHORIZED BY	[Signature]
VERTICAL:	AS NOTED	DATE	9/02/23
DATE	90/01/15	ACCEPTED BY	[Signature]
		DATE	9/02/23

THE CITY OF WINNIPEG
WORKS AND OPERATIONS DIVISION
STREETS AND TRANSPORTATION DEPARTMENT


EMPRESS STREET OVERPASS
STRUCTURE REHABILITATION, STRENGTHENING AND RELATED WORKS

ROADWAY RECONSTRUCTION DETAILS


CITY DRAWING NUMBER
B100-90-24(R1)

CONSULTANT DRAWING NO.
890007-02-00

B-5903-27

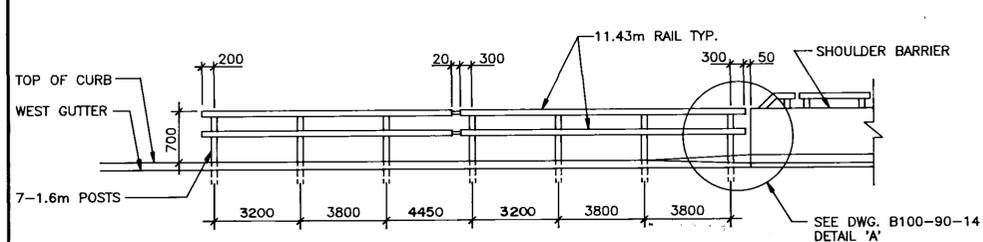


ELEVATION

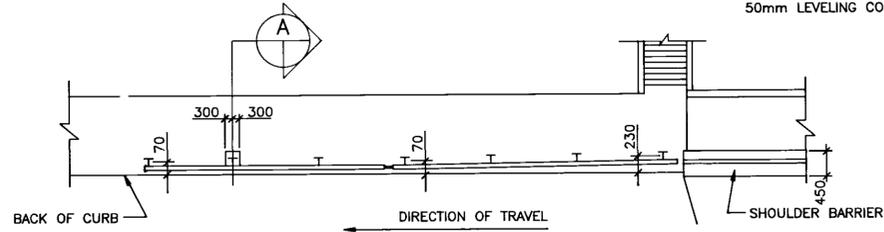


PLAN


1 WEST SIDE - SOUTH END OF BRIDGE

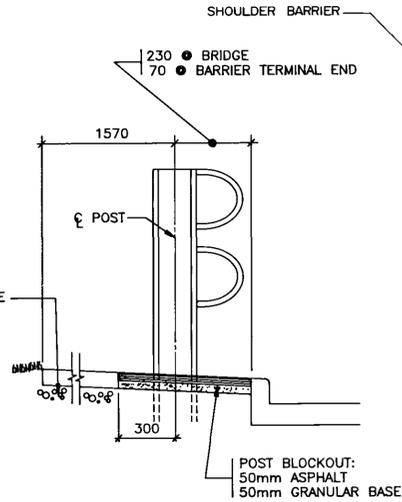

A SECTION

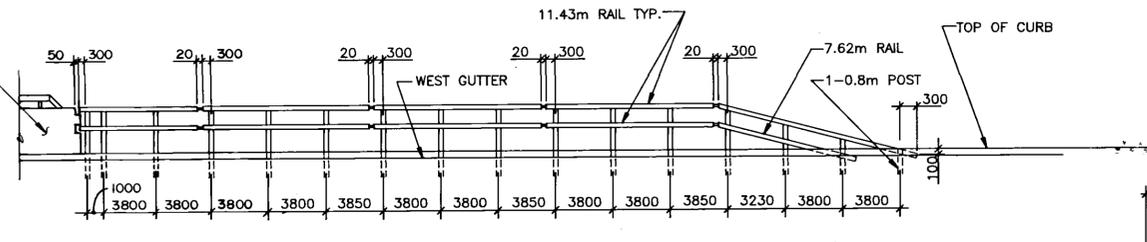


ELEVATION

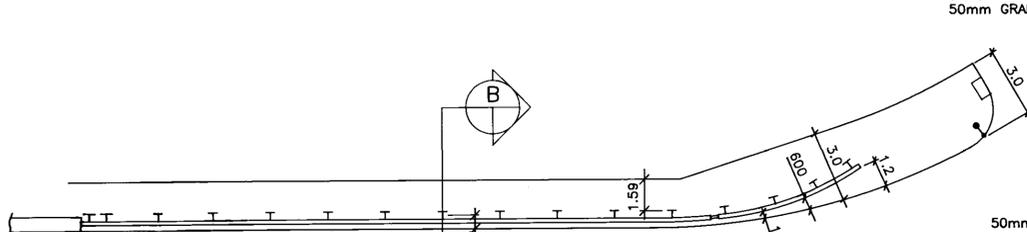


PLAN


2 WEST SIDE - NORTH END OF BRIDGE

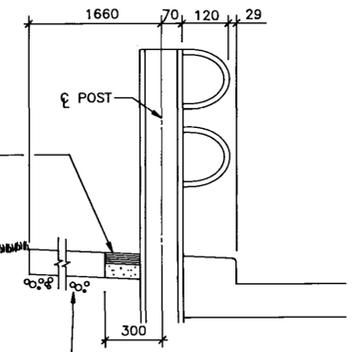

B SECTION

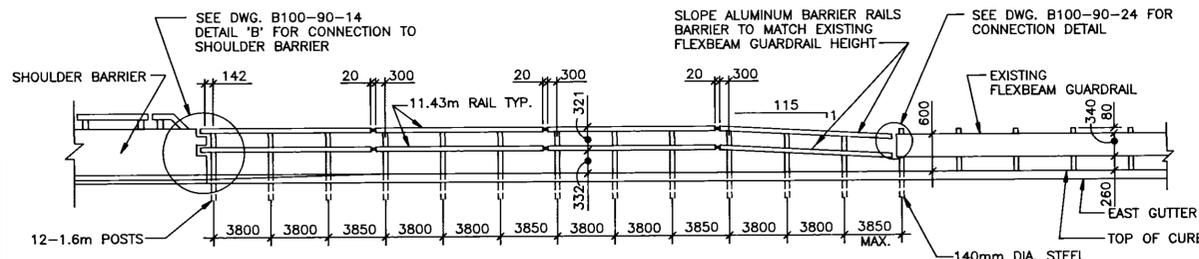


ELEVATION

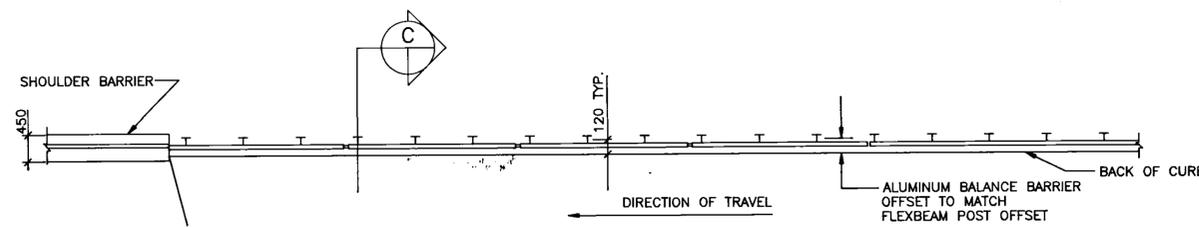


PLAN


3 EAST SIDE - SOUTH END OF BRIDGE

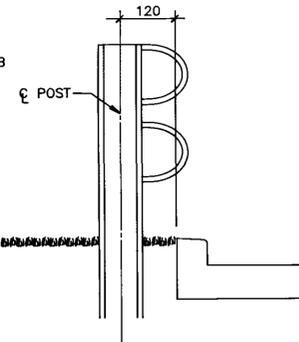

C SECTION

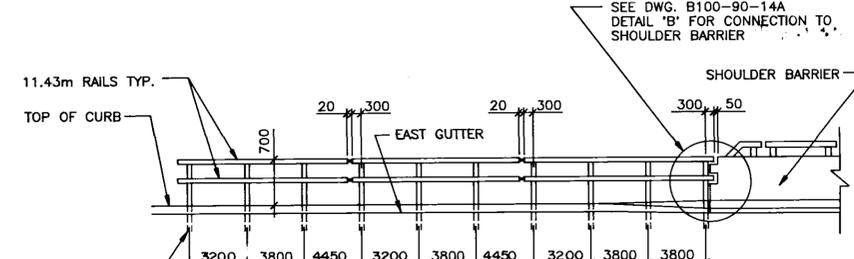


ELEVATION

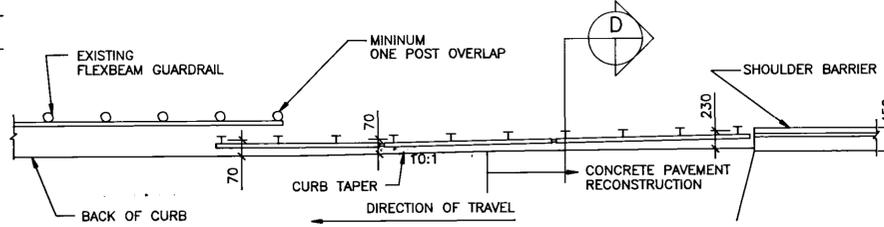

PLAN

3 EAST SIDE - NORTH END OF BRIDGE

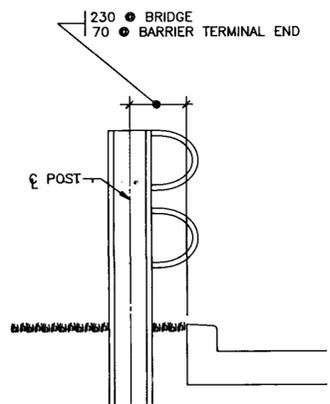

D SECTION

ITEM	QUANTITY			
	WEST SIDE - SOUTH END OF BRIDGE	WEST SIDE - NORTH END OF BRIDGE	EAST SIDE - SOUTH END OF BRIDGE	EAST SIDE - NORTH END OF BRIDGE
13-13 X 25 STAINLESS STEEL HEX. HEAD CAP SCREW	56	110	96	80
27 O.D. X 14 I.D. X 2 THICK STAINLESS STEEL WASHER	56	110	96	80
RAIL CLAMP BAR	28	54	48	40
SPLICE BAR	2	6	6	4
RAIL END CAP	4	2	0	4
BARRIER POST 1600 mm	7	13	12	10
BARRIER POST 800 mm	0	1	0	0
BARRIER RAIL 11430 mm	4	7	8	6
BARRIER RAIL 7620 mm	0	1	0	0

AS-BUILT
DATE 9/02/26 BY [Signature]
CHECKED BY [Signature]


NO.	REVISIONS	DATE	BY	DATE
2	REVISED AS CONSTRUCTED	90-12-14	FPC	
1	ADDENDUM	90-3-19	G.O.	

WARDROP ENGINEERING INC.

DESIGNED BY G.O. CHECKED BY M.S.
DRAWN BY G.M.D. APPROVED BY [Signature]

HOR. SCALE: NOT TO SCALE
VERTICAL: NOT TO SCALE

AUTHORIZED BY [Signature] DATE 9/02/23
ACCEPTED BY [Signature] DATE 9/02/23
C.E. QULETTE REGISTERED PROFESSIONAL ENGINEER

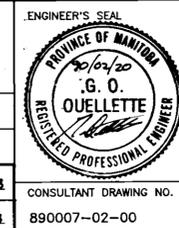

THE CITY OF WINNIPEG
WORKS AND OPERATIONS DIVISION
STREETS AND TRANSPORTATION DEPARTMENT


EMPRESS STREET OVERPASS
STRUCTURE REHABILITATION, STRENGTHENING AND RELATED WORKS

LAYOUT OF BALANCE ALUMINUM SHOULDER BARRIER AND DETAILS


CITY DRAWING NUMBER B100-90-25(R1)

890007-02-00


B-5903-28

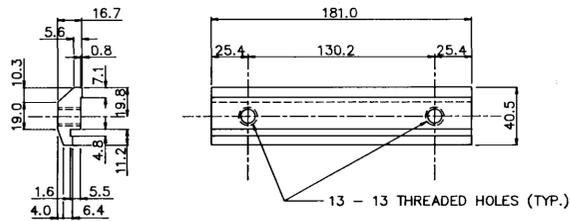

RAIL CLAMP BAR
SCALE - 1 : 25

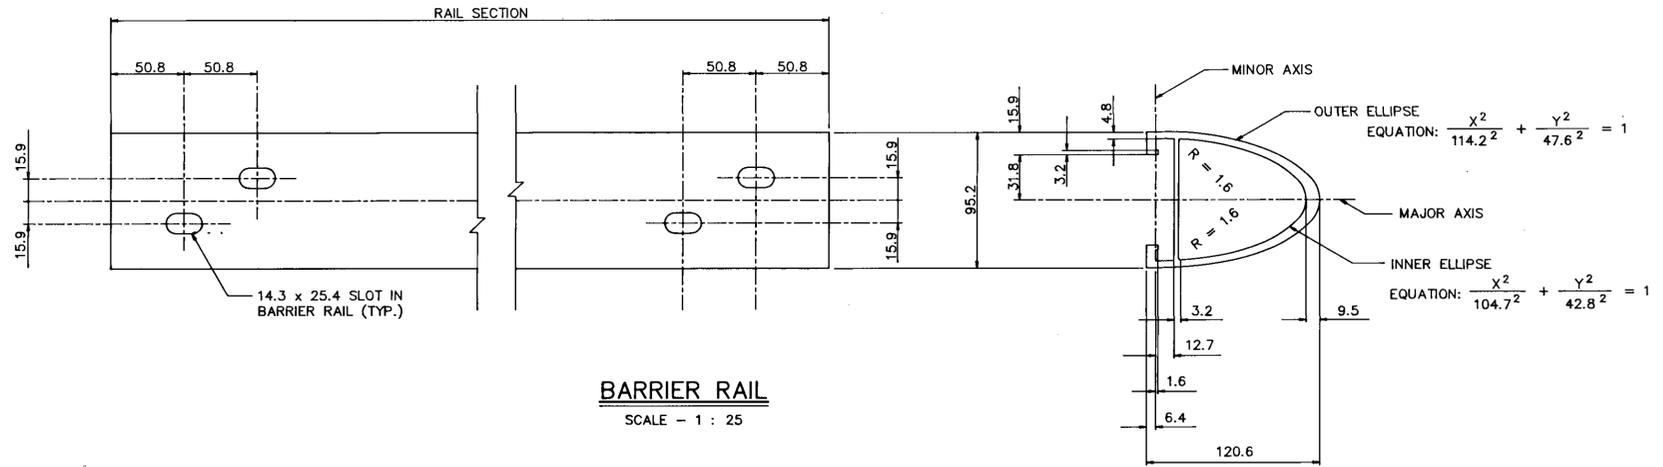

BARRIER RAIL
SCALE - 1 : 25

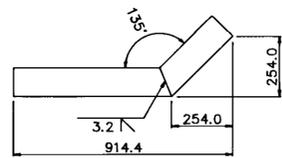


PLAN




FRONT ELEVATION

TERMINAL END



(FABRICATED FROM BARRIER RAIL)
SCALE - 1 : 150

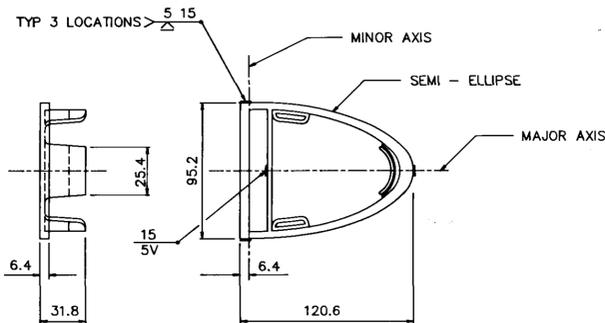


RAIL END CAP
SCALE - 1 : 25

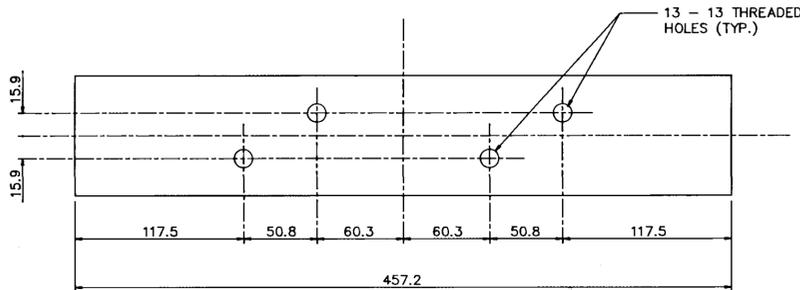


SPLICE BAR
SCALE - 1 : 25

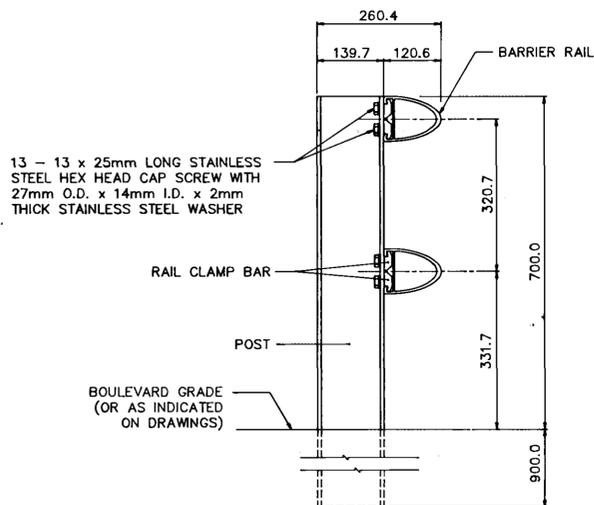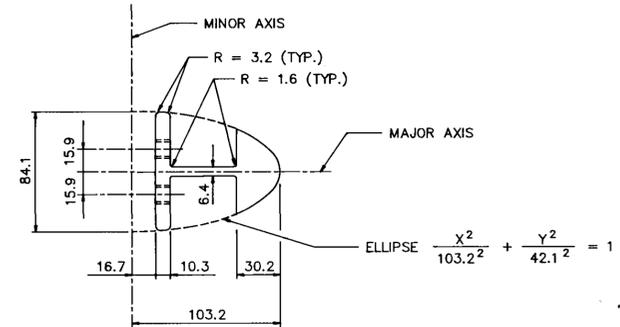

RAIL TO POST ASSEMBLY DETAIL
SCALE - 1 : 75

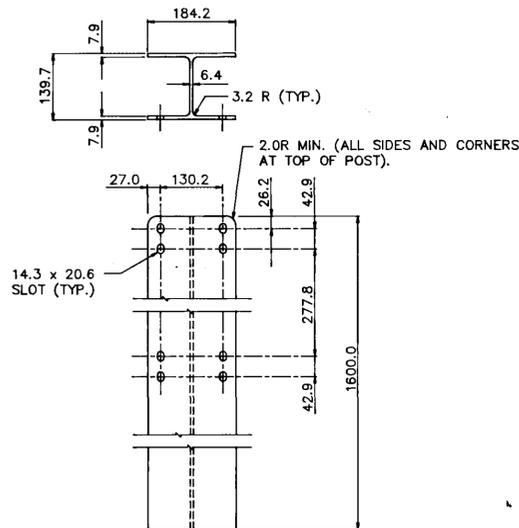

1.600m POST
(0.800m POST SIMILAR EXCEPT WITH ONLY FOUR SLOTS AT TOP OF POST)
SCALE - 1 : 75

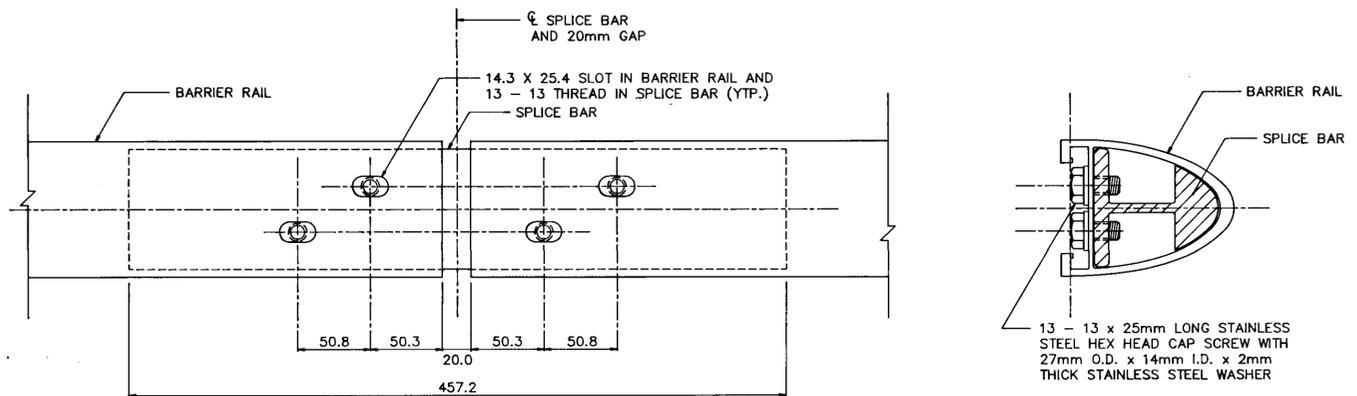

SPLICE BAR TO RAIL ASSEMBLY DETAIL
SCALE - 1 : 25

MATERIAL SPECIFICATION

- ALUMINUM RAILS, POSTS, SPLICE BARS, AND RAIL END CAPS SHALL CONFORM TO ASTM B221, ALLOY 6061 - T6, OR ALLOY 6351 - T6.
- TYPE 316. STAINLESS STEEL WASHERS SHALL CONFORM TO ASTM A296, TYPE 316.
- CAP SCREWS SHALL CONFORM TO ASTM A276, TYPE 316 STAINLESS STEEL.
- ANTI-SEIZE COATING TO BE APPLIED TO ALL THREADED COMPONENTS WHEN BEING ASSEMBLED, i.e. LPS-3-MANUFACTURED BY HOLT LLOYD (CANADA) LTD., MARKHAM, ONTARIO L3R 2Z3
- TWO COATS, EACH 1mm IN THICKNESS OF ALKALI-RESISTANT BITUMINOUS PAINT SHALL BE APPLIED ON THE SURFACES OF POSTS AND RAILS THAT ARE TO BE IN CONTACT WITH THE GROUND.

METRIC
ALL DIMENSIONS SHOWN ARE IN MILLIMETRES

AS-BUILT
DATE 91.02.26 BY [Signature]
CHECKED BY [Signature]

LOCATION APPROVED UNDERGROUND STRUCTURES			
N/A			
SUPV. 1/6 STRUCTURES	DATE	COMMITTEE	
NOTE:	LOCATION OF UNDERGROUND STRUCTURES AS SHOWN ARE BASED ON THE BEST INFORMATION AVAILABLE BUT NO GUARANTEE IS GIVEN THAT ALL EXISTING UTILITIES ARE SHOWN OR THAT THE GIVEN LOCATIONS ARE EXACT. LOCATION OF ALL SERVICES MUST BE OBTAINED FROM THE INDIVIDUAL UTILITIES BEFORE PROCEEDING WITH CONSTRUCTION.		
NO.	REVISIONS	DATE	BY
1	REVISED AS CONSTRUCTED	901214	FPC

B.M. ELEV.			

WARDROP ENGINEERING INC.	
DESIGNED BY	CHECKED BY
DRAWN BY	APPROVED BY [Signature]
HOR. SCALE: AS SHOWN	AUTHORIZED BY [Signature] DATE 91.02.23
VERTICAL:	ACCEPTED BY [Signature] DATE 91.02.23
	G. R. SMITH, P. ENG. 90223
DATE 90/01/15	

ENGINEER'S SEAL
PROVINCE OF MANITOBA
G. O. OUELLETTE
REGISTERED PROFESSIONAL ENGINEER
CONSULTANT DRAWING NO. 890007-02-00




THE CITY OF WINNIPEG
WORKS AND OPERATIONS DIVISION
STREETS AND TRANSPORTATION DEPARTMENT

EMPRESS STREET OVERPASS
STRUCTURE REHABILITATION, STRENGTHENING AND RELATED WORKS

BALANCE SHOULDER BARRIER STANDARD DETAIL

CITY DRAWING NUMBER B100-90-26
CITY STANDARD DRWG. NO. CW-302-R-2




B-5903-29

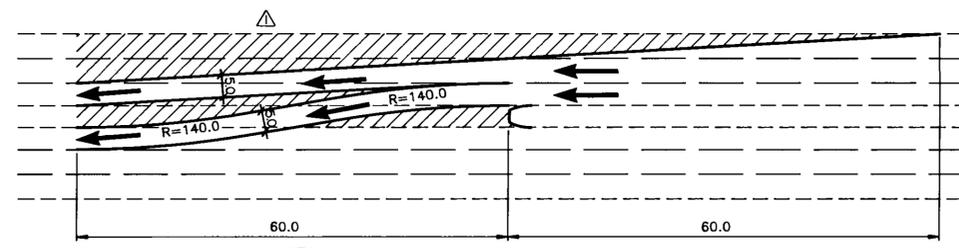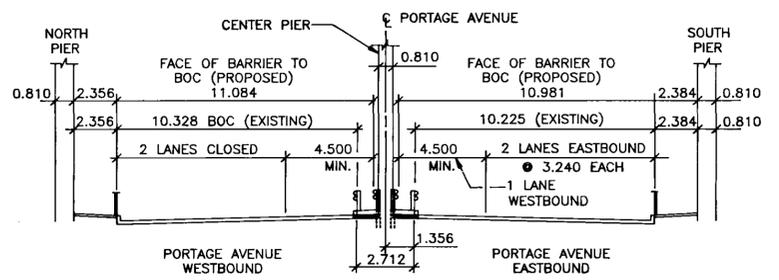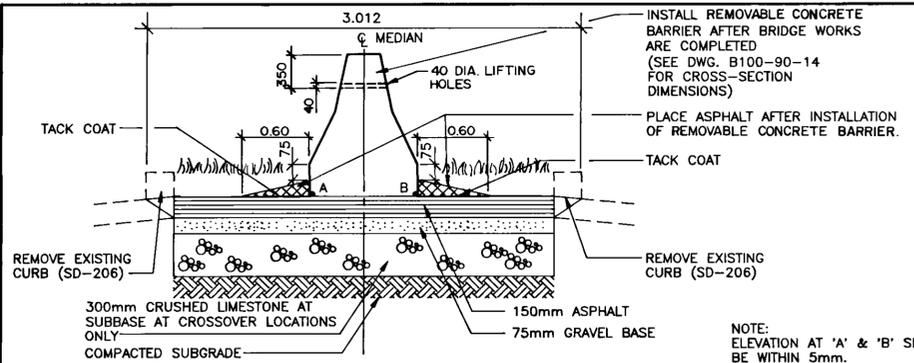

1 RECONSTRUCTION OF PORTAGE AVENUE MEDIAN
N.T.S.

2 TYPICAL CROSS SECTION LOOKING EAST
N.T.S. (SHOWING RELOCATION OF ALUMINUM MEDIAN BARRIER)

3 TYPICAL MEDIAN CROSSOVER LAYOUT
N.T.S.

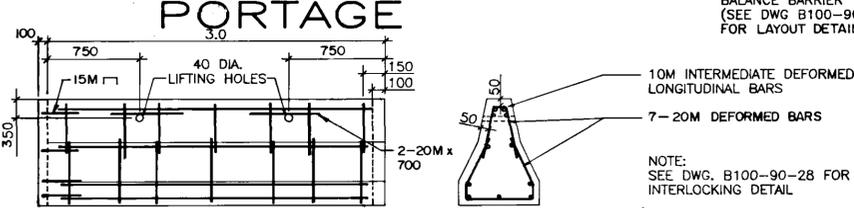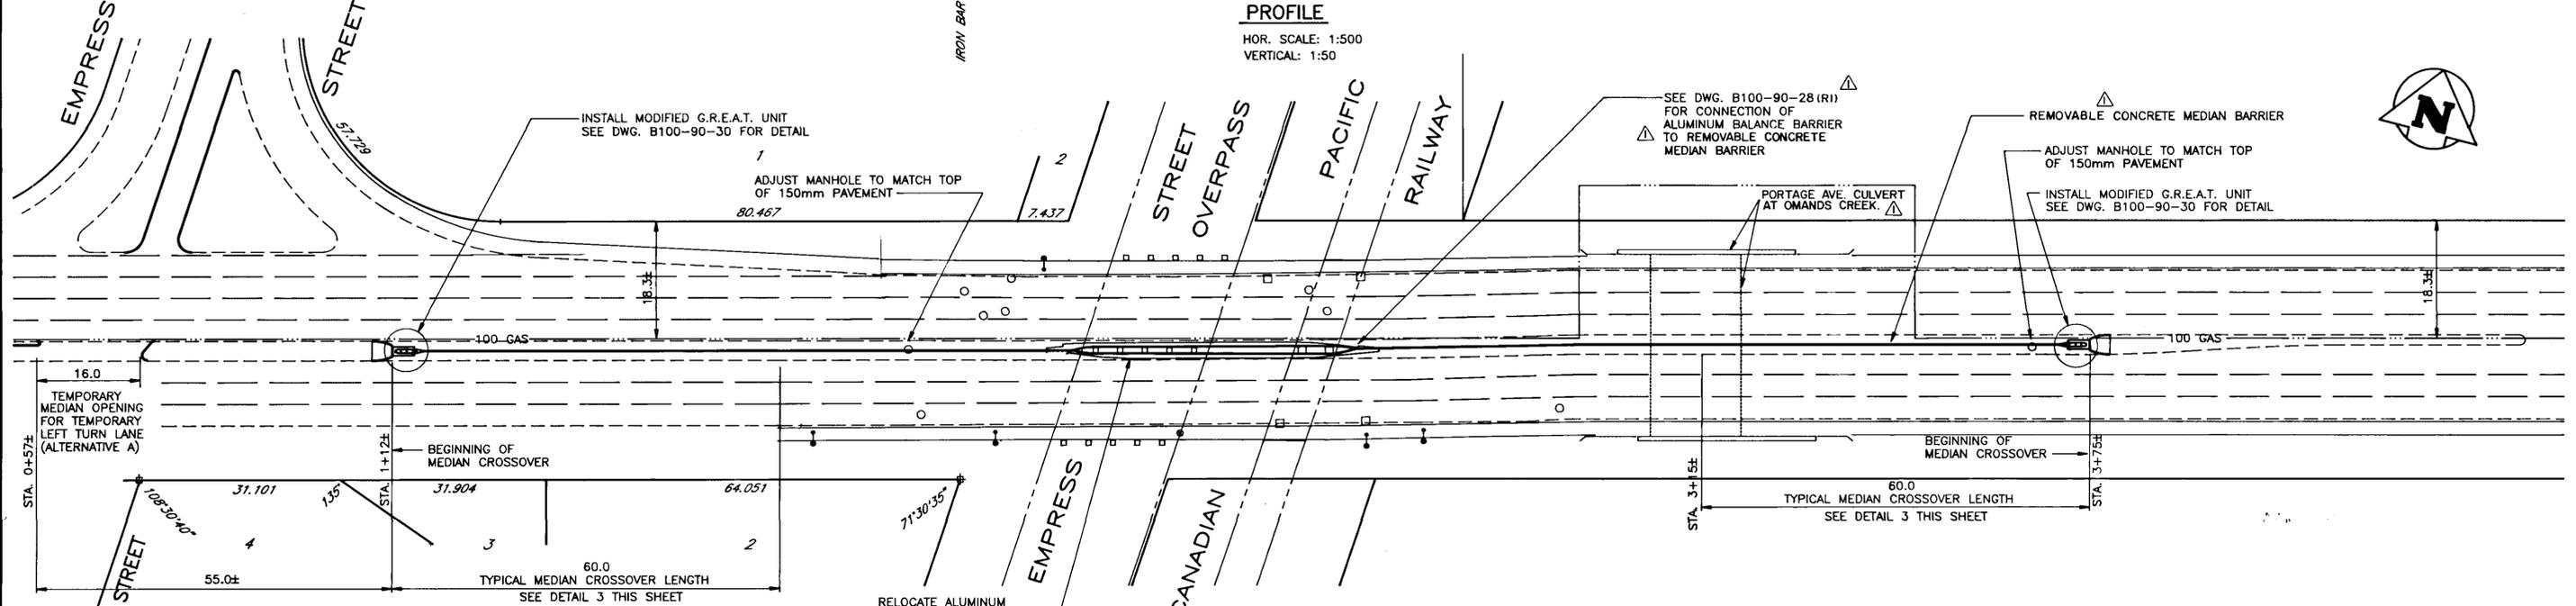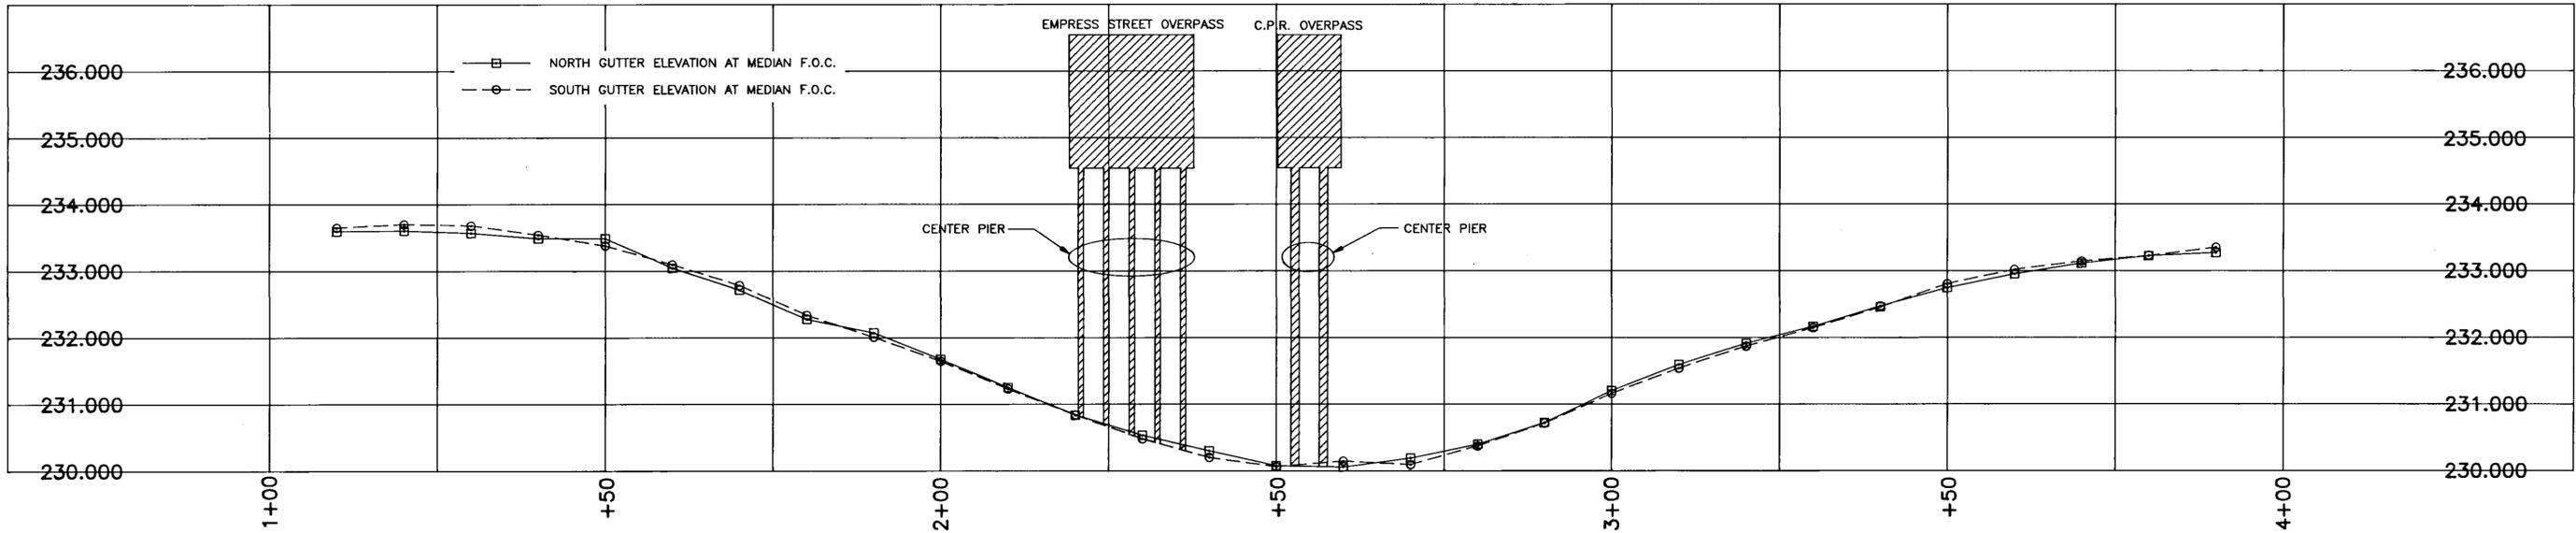

4 REMOVABLE CONCRETE MEDIAN DETAIL
N.T.S.

AS-BUILT
DATE 9.02.26 BY [Signature]
CHECKED BY [Signature]

NO.	REVISIONS	DATE	BY	DATE
2	REVISED AS CONSTRUCTED	90/2/14	FPC	
1	ADDENDUM	90/3/12	G.O.	

WARDROP ENGINEERING INC.

DESIGNED BY G.O. CHECKED BY M.S.

DRAWN BY G.M.D. APPROVED BY [Signature]

HOR. SCALE: 1:500 OR AS NOTED

VERTICAL: AS NOTED

DATE 90/01/15

ENGINEER'S SEAL

PROVINCE OF MANITOBA

90/03/27

G. O.

OUELLETTE

REGISTERED PROFESSIONAL ENGINEER




CONSULTANT DRAWING NO. 890007-02-00

THE CITY OF WINNIPEG
WORKS AND OPERATIONS DIVISION
STREETS AND TRANSPORTATION DEPARTMENT


EMPIRESS STREET OVERPASS
STRUCTURE REHABILITATION, STRENGTHENING AND RELATED WORKS

PORTAGE AVENUE MEDIAN RECONSTRUCTION


CITY DRAWING NUMBER B100-90-27(R1)

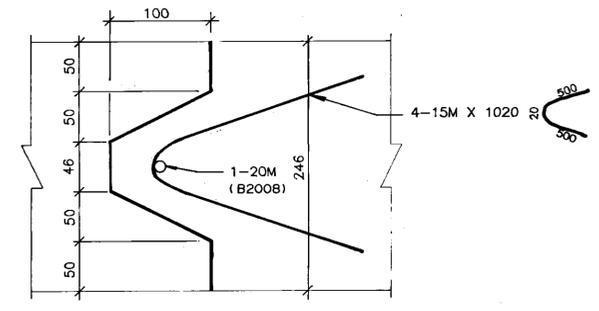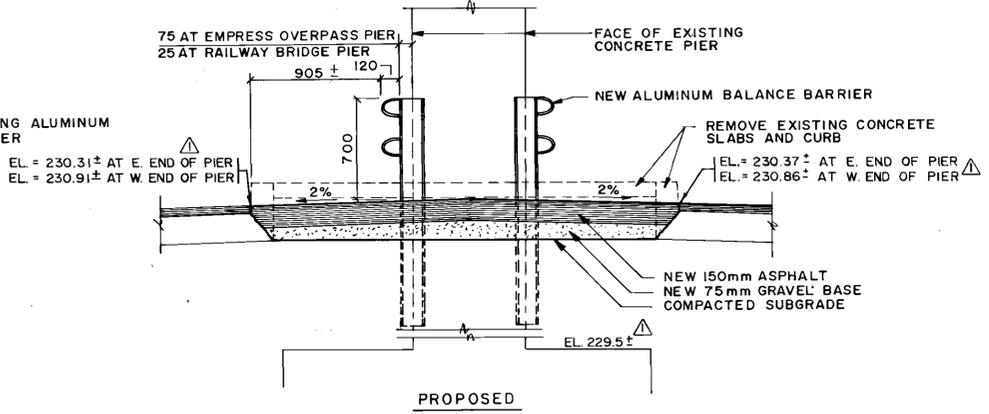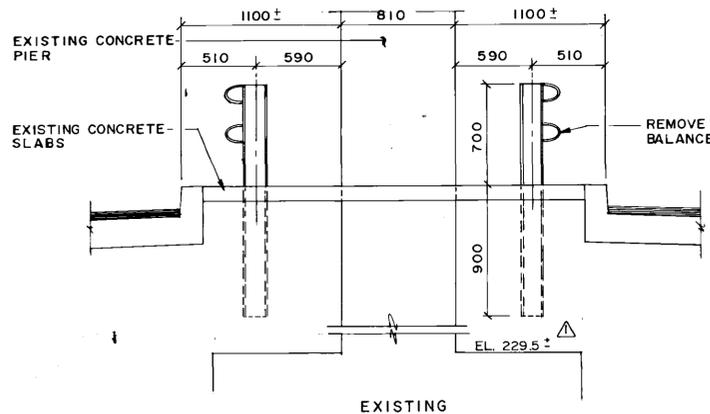


SECTION A-A
NTS

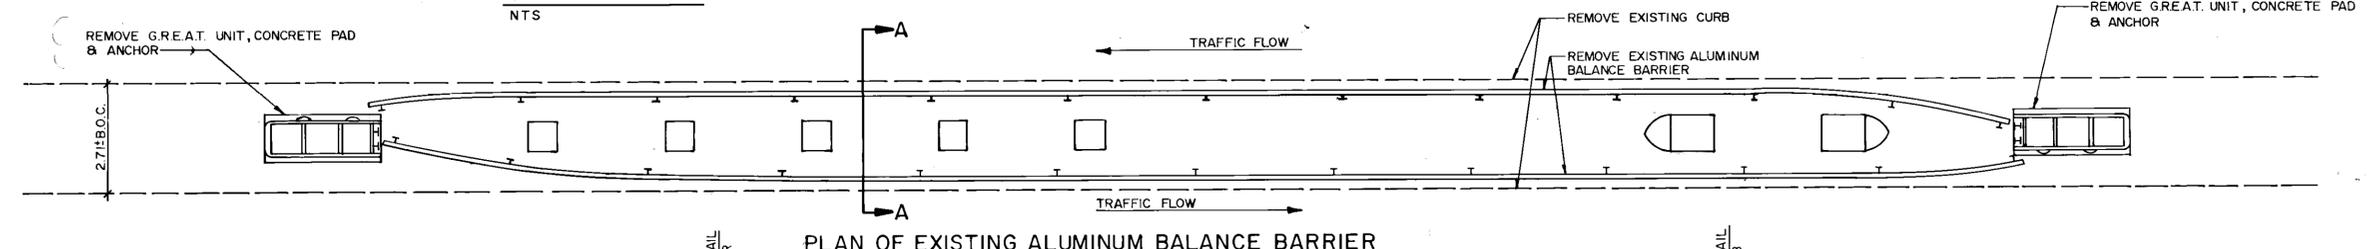

PLAN OF EXISTING ALUMINUM BALANCE BARRIER

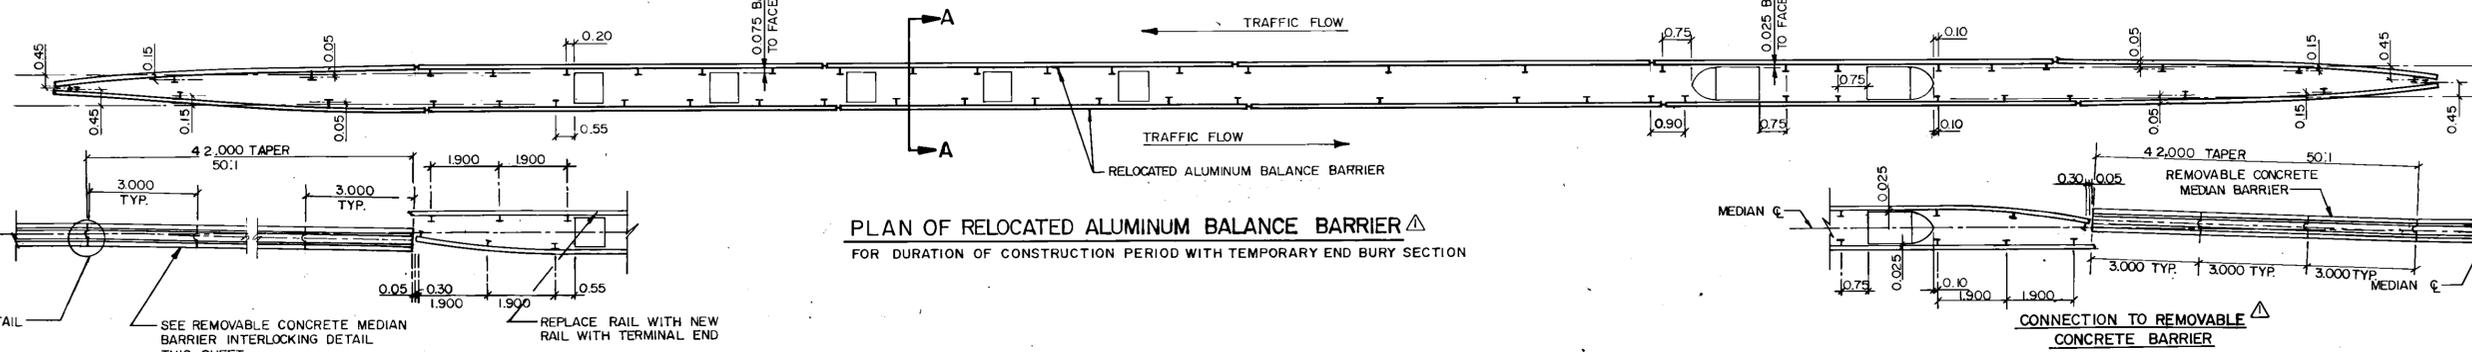

PLAN OF RELOCATED ALUMINUM BALANCE BARRIER
FOR DURATION OF CONSTRUCTION PERIOD WITH TEMPORARY END BURY SECTION

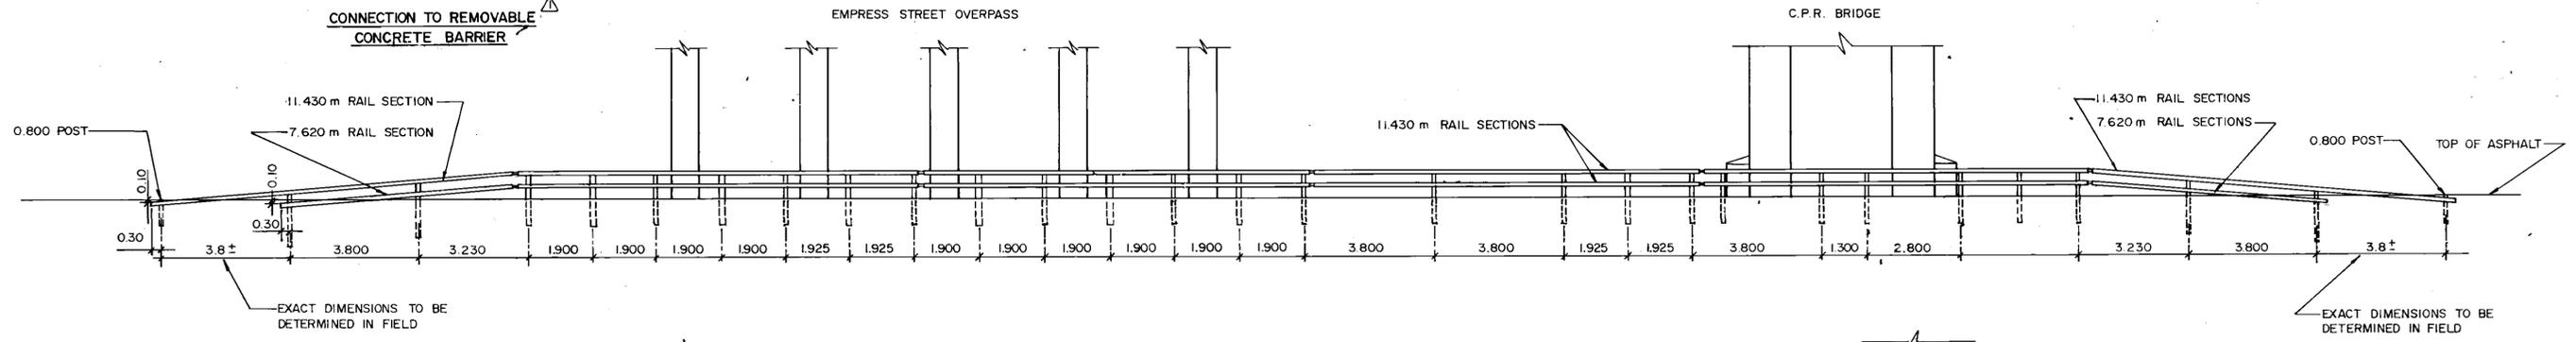

ELEVATION OF RELOCATED ALUMINUM BALANCE BARRIER
FOR DURATION OF CONSTRUCTION PERIOD WITH TEMPORARY END BURY SECTION.

BILL OF MATERIALS		
ITEM	QUANTITY REQUIRED FOR RELOCATED BARRIER	QUANTITY AVAILABLE FROM EXISTING BARRIER
11.430 m RAIL SECTIONS	20	16
7.620 m RAIL SECTIONS	4	NIL
1.600 m POSTS	52	26
0.800 m POSTS	4	NIL
SPLICE BARS	20	12
RAIL CLAMP BARS	216	104
CAP SCREWS	432	256
WASHERS	432	256

- NOTES:
- NEW LOCATION OF POSTS MAY VARY FROM LOCATION SHOWN DUE TO PIER FOOTINGS.
 - ALL POSTS 1.600 m LONG EXCEPT WHERE NOTED OTHERWISE.
 - ADDITIONAL BARRIER COMPONENTS WILL BE SUPPLIED BY THE CITY OF WINNIPEG.

AS-BUILT
DATE 9/02/26 BY [Signature]
CHECKED BY [Signature]

LOCATION APPROVED UNDERGROUND STRUCTURES
N/A
SUPV. U/G STRUCTURES COMMITTEE DATE
NOTE: LOCATION OF UNDERGROUND STRUCTURES AS SHOWN ARE BASED ON THE BEST INFORMATION AVAILABLE BUT NO GUARANTEE IS GIVEN THAT ALL EXISTING UTILITIES ARE SHOWN OR THAT THE GIVEN LOCATIONS ARE EXACT CONFIRMATION OF EXISTENCE AND EXACT LOCATION OF ALL SERVICES MUST BE OBTAINED FROM THE INDIVIDUAL UTILITIES BEFORE PROCEEDING WITH CONSTRUCTION

NO.	REVISIONS	DATE	BY
2	REVISED AS CONSTRUCTED	90/2/14	FPC
1	ADDENDUM	90/3/12	G.O.


WARDROP ENGINEERING INC.
DESIGNED BY G.O.
CHECKED BY M.S.
DRAWN BY G.M.D.
APPROVED BY [Signature]
AUTHORISED BY [Signature] DATE 90/2/23
ACCEPTED BY [Signature] DATE 90/2/23
FOR SMITH BRIDGE ENGINEER

ENGINEER'S SEAL
PROVINCE OF MANITOBA
G.O. QUELLETTE
REGISTERED PROFESSIONAL ENGINEER
CONSULTANT DRAWING NO. 890007-02-00


THE CITY OF WINNIPEG
WORKS AND OPERATIONS DIVISION
STREETS AND TRANSPORTATION DEPARTMENT
EMPRESS STREET OVERPASS
STRUCTURE REHABILITATION, STRENGTHENING AND RELATED WORKS
MISCELLANEOUS DETAILS
CITY DRAWING NUMBER B100-90-28(RI)

B-5903-31

NOTES:
SPRAY ALL HOLES DRILLED IN FIELD WITH GALVANIZING COMPOUND.

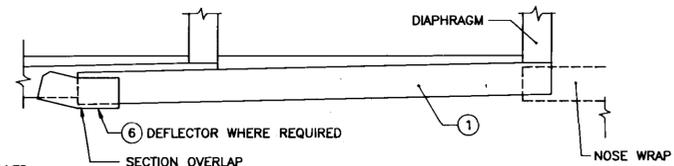


TOP ASSEMBLY VIEW

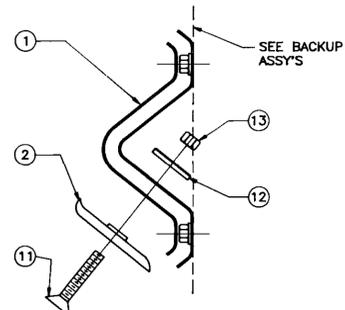

DETAIL "A"
MUSHROOM BOLT ASSEMBLY
N.T.S.

ITEM	STOCK NO.	DESCRIPTION	REQ'D
1	35-05-012	ASSEMBLY	1
2	27-38-111	THRIE BEAM FENDER PANEL	1
3	27-08-153	MUSHROOM WASHER	2
4	27-01-641	3/8" x 2" H.H. BOLT	2
5	27-04-091	3/8" NUT	2
6	27-08-081	3/8" FLAT WASHER	2
7	27-08-031	DEFLECTOR PANEL (WHERE REQUIRED)	1
8	27-06-181	1/2" x 1" FLAT HEAD CAP SCREW	2
9	27-02-651	MUSHROOM BOLT DEFLECTOR	1
10	27-04-011	1/2" H.H. NUT	2
11	27-01-731	3/8" x 3" F.H. ALLEN HEAD MACHINE BOLT	2
12	27-08-381	2" x 2" x 1/4" W 3/8" HOLE SQ. WASHER	2
13	27-04-141	3/8" H.H. NUT	6

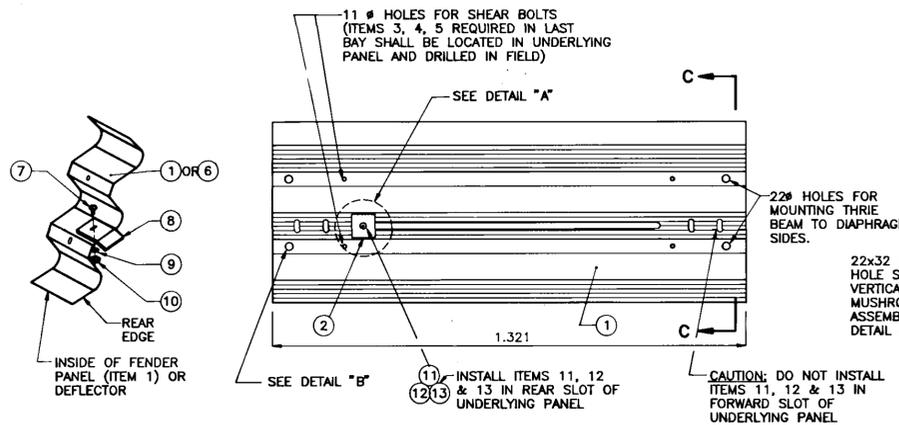

DETAIL "B"
N.T.S.



SIDE VIEW

SECTION C-C

ITEM	STOCK NO.	DESCRIPTION	REQ'D
1	SEE TABLE	BACKUP	1
2	27-52-111	THRIE-BEAM SIDE PANEL	1
3	27-52-241	TRANSITION PANEL	1
4	SEE TABLE	RIGHT ATTACHMENT BRACKET	1
5	27-52-201	LEFT ATTACHMENT BRACKET	1
6	27-52-271	SUPPORT BRACKET	1
7	27-01-261	3/4" x 4 1/4" CONC. ANCHOR BOLT (EXP. TYPE)	4
8	27-01-381	3/4" x 2" H.H. BOLT	12
9	27-01-641	3/8" x 1 1/2" H.H. BOLT	2
10	27-01-681	3/8" FLUSH ANCHOR	2
11	27-08-081	3/8" FLAT WASHER	12
12	27-04-091	3/8" H.H. NUT	12
13	27-08-201	3/4" LOCK WASHER	14
14	27-52-591	CARTRIDGE SUPPORT BRACKET	1
15	27-52-611	CLAMPING BAR	1
16	27-01-331	3/8" x 4 1/2" H.H. BOLT	2
17	27-01-221	3/8" x 1" H.H. BOLT	2
18	27-04-031	3/8" H.H. NUT	4
19	27-08-021	3/8" FLAT WASHER	6


UNIT MODEL NO.	ASSEMBLY NO.	ITEM 1 (BACKUP) STOCK NO.	ITEM 4 STOCK NO.	ITEM 7 STOCK NO.	REQ'D
200200	38-21-021	29-03-211	27-52-191	27-52-641	12
206206	38-21-022	29-03-212	27-52-641	27-52-641	14
300300	38-21-023	29-03-213	27-52-641	27-52-641	14

TABLE FOR BACKUP ASSEMBLY
N.T.S. U/N

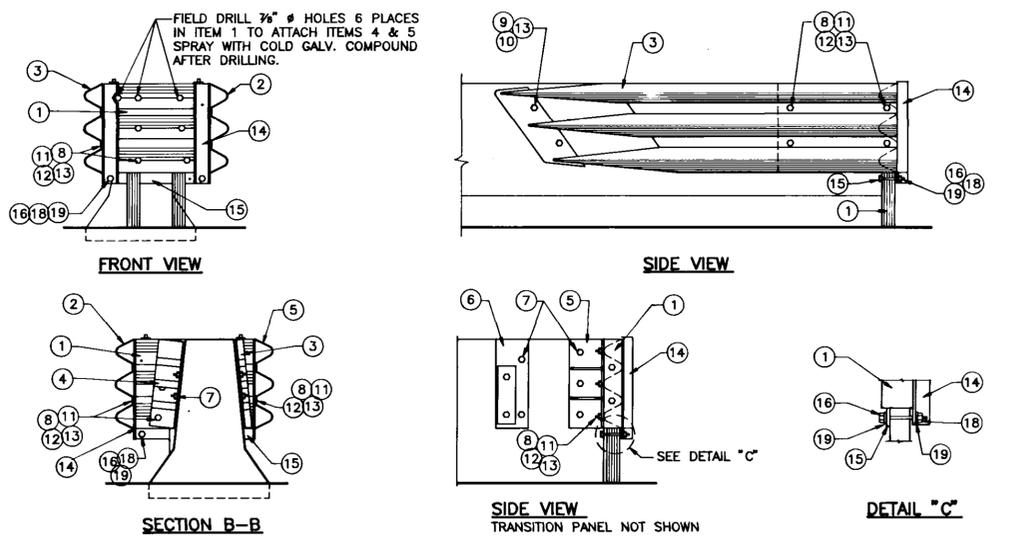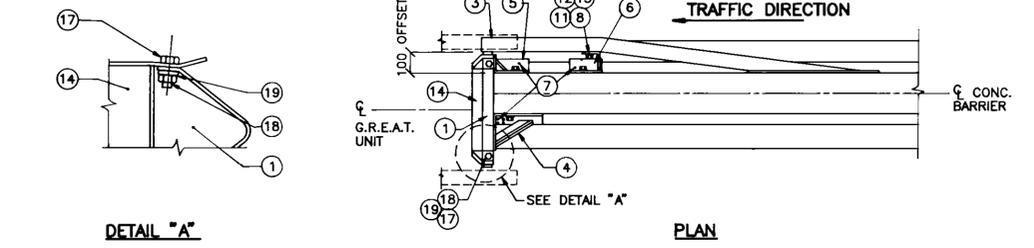

DETAIL OF BACKUP ASSEMBLY FOR CONCRETE MEDIAN TRAFFIC BARRIER BI-DIRECTIONAL
N.T.S. U/N

THRIE BEAM FENDER PANEL ASSEMBLY DETAILS
(TYPICAL FOR EACH FENDER PANEL)
1 : 10 U/N

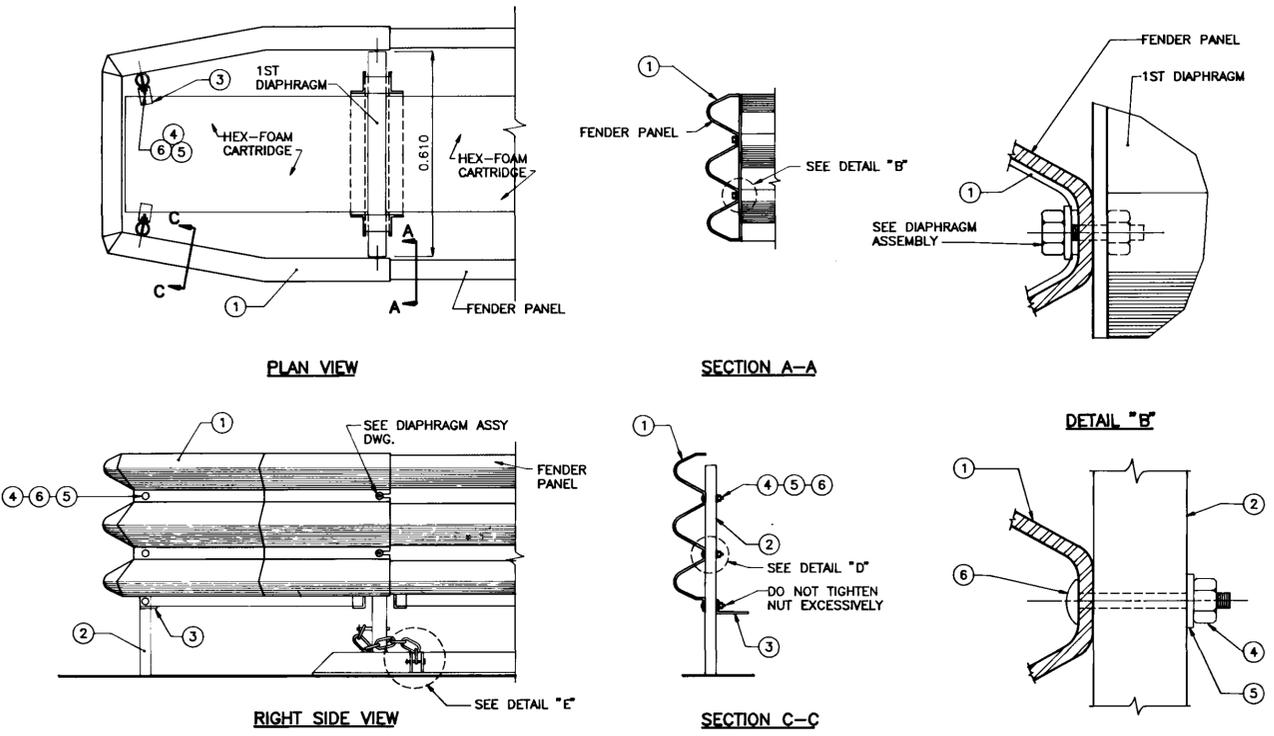


ITEM	STOCK NO.	DESCRIPTION
1	27-52-021	PROOF COIL CHAIN 1/2" (9 LINKS)
2	27-02-101	3/8" x 2" CLEVIS PIN
3	27-02-111	PIN KEEPER SPRING
4	27-22-033	CHAIN RAIL (8'-10')

NOSE COVER ASSEMBLY DETAILS
(USING HEX-FOAM CARTRIDGES)
N.T.S. U/N


ITEM	STOCK NO.	DESCRIPTION
1	35-02-08	UNIVERSAL NOSE COVER ASSEMBLY
2	20-20-811	NOSE COVER
3	27-14-892	SUPPORT LEG
4	27-14-891	SUPPORT TAB
5	27-04-031	3/8" H.H. NUT
6	27-08-021	3/8" FLAT WASHER
7	27-01-171	3/8" x 2-1/4" CARRIAGE BOLT

NOTES:
TORQUE (4) TO 50-100 FT-LBS

ITEM	STOCK NO.	DESCRIPTION
1	27-20-031	DIAPHRAGM
2	27-52-581	CARTRIDGE SUPPORT BRACKET
3	27-01-381	3/4" x 2" H.H. BOLT
4	27-00-071	3/8" x 5" H.H. BOLT
5	27-01-221	3/8" x 1" H.H. BOLT
6	27-04-091	3/8" H.H. NUT
7	27-04-031	3/8" H.H. NUT
8	27-08-081	3/8" FLAT WASHER
9	27-08-021	3/8" FLAT WASHER

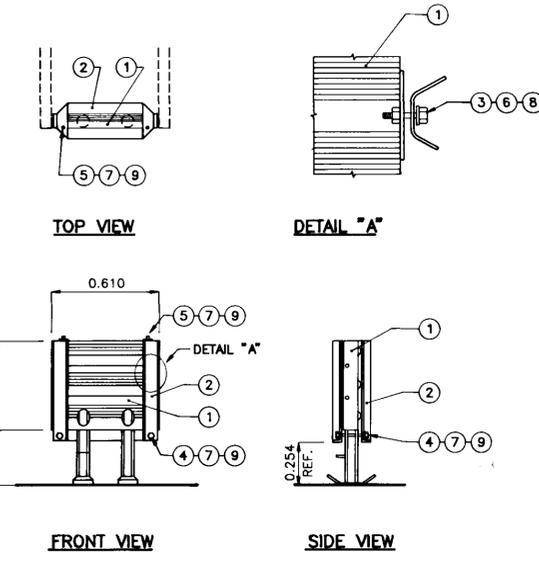

DIAPHRAGM ASSEMBLY DETAIL
(FOR HEX-FOAM CARTRIDGE)
N.T.S. U/N

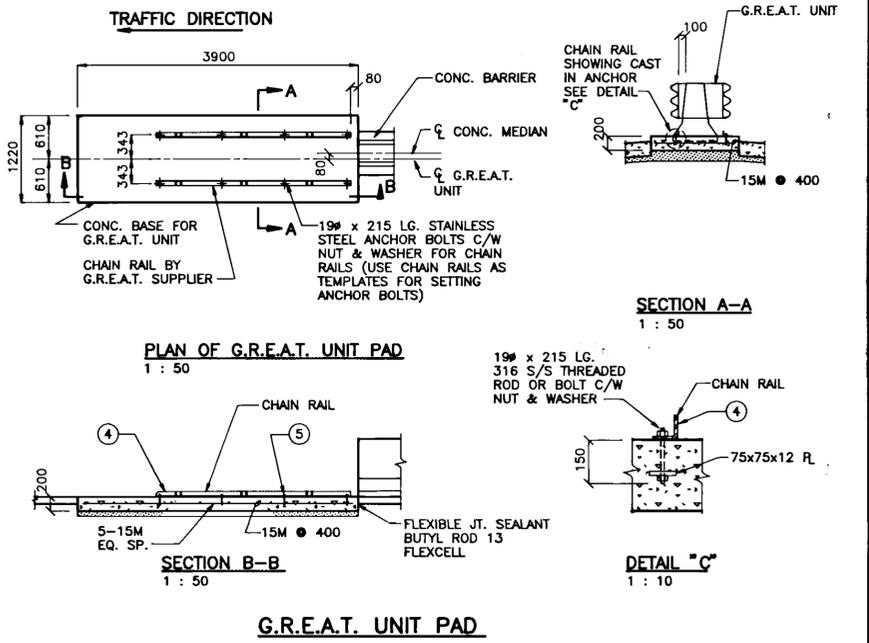


G.R.E.A.T. UNIT PAD

- GENERAL NOTES:
- USE CHAIN RAILS AS TEMPLATE TO LOCATE ANCHOR SYSTEM
 - G.R.E.A.T. BARRIER TO BE INSTALLED IN ACCORDANCE WITH THESE DRAWINGS AND THE MANUFACTURER'S CURRENT ASSEMBLY DRAWINGS.
 - REINFORCING STEEL USED IN THE CONCRETE BASE SHALL BE EPOXY COATED.
 - INSTALLATION OF SNOW COVER TO BE DONE BY THE CONTRACTOR, AS PER INSTRUCTIONS OF THE CITY BRIDGE ENGINEER. PARTS WILL BE SUPPLIED BY THE CITY OF WINNIPEG.
 - INSTALLATION OF SHEAR BOLTS TO BE DONE BY THE CONTRACTOR, AS PER INSTRUCTIONS OF THE CITY BRIDGE ENGINEER.
 - ALL CHAIN RAILS SHALL BE INSTALLED ONLY BY CASTING THE ANCHOR RODS INTO THE CONCRETE.


AS-BUILT
DATE 9.02.26 BY [Signature]
CHECKED BY [Signature]

B-5903-32


B.M. ELEV.		WARDROP ENGINEERING INC.		ENGINEER'S SEAL PROVINCE OF MANITOBA G. O. OUELLETTE REGISTERED PROFESSIONAL ENGINEER	
DESIGNED BY G.O.	CHECKED BY F.P.C.	DRAWN BY G.R.A.		APPROVED BY [Signature]	
HOR. SCALE: AS NOTED		VERTICAL: AS NOTED		CONSULTANT DRAWING NO. 890007-02-00	
NO REVISIONS		DATE BY DATE		THE CITY OF WINNIPEG WORKS AND OPERATIONS DIVISION STREETS AND TRANSPORTATION DEPARTMENT	
REVISIONS		DATE BY DATE		EMPRESS STREET OVERPASS STRUCTURE REHABILITATION, STRENGTHENING AND RELATED WORKS GUARDRAIL ENERGY ABSORBING TERMINAL STANDARD DETAILS	
				CITY DRAWING NUMBER B100-90-29	

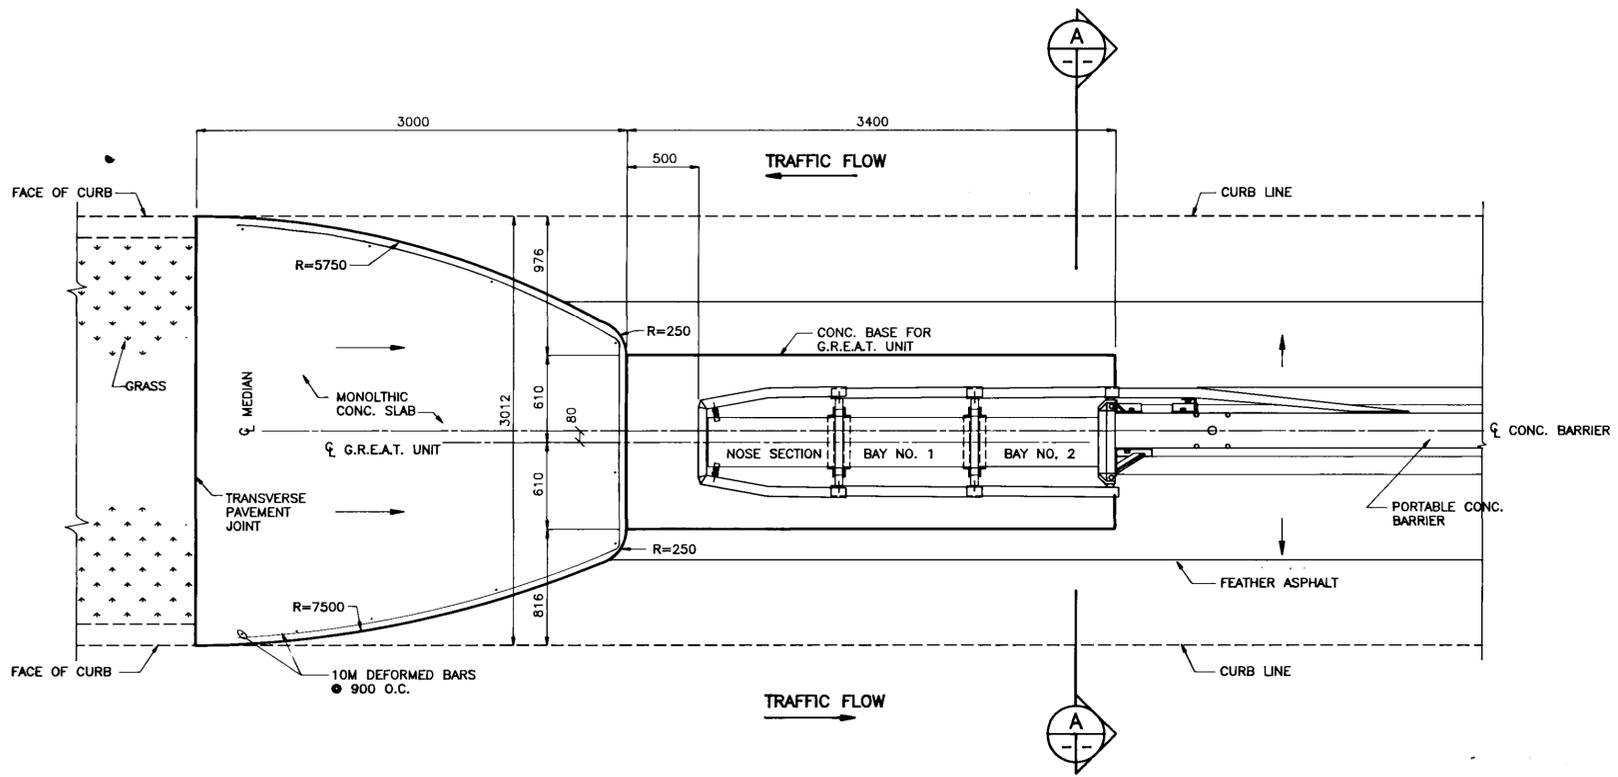

PLAN AT WEST END
 PLAN AT EAST END IS SIMILAR
 1 : 25

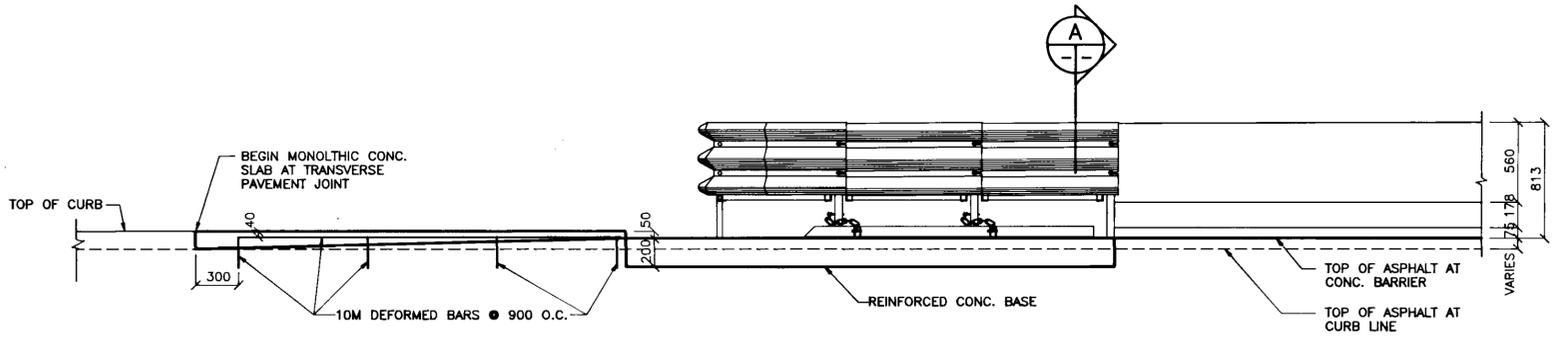

ELEVATION
 1 : 25

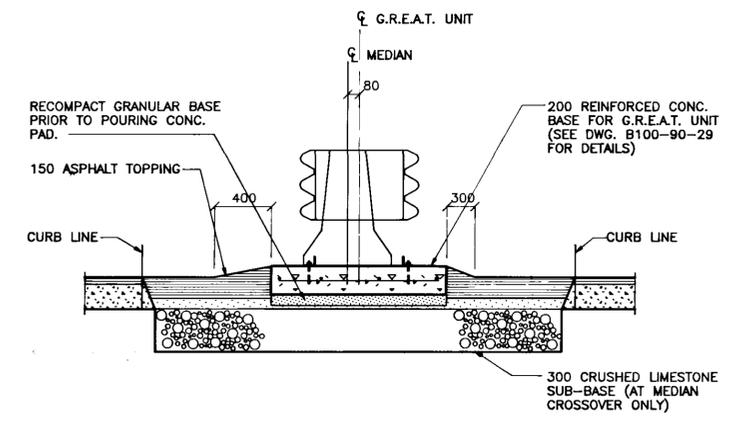


SECTION A-A
 1 : 25

B-5903-33

AS-BUILT
 DATE 9.02.26 BY [Signature]
 CHECKED BY [Signature]

NO.	REVISIONS	DATE	BY
1	REVISED AS CONSTRUCTED	904214	FPC
2	ISSUED WITH ADDENDUM	903119	FPC

WARDROP ENGINEERING INC.	
DESIGNED BY G.O.	CHECKED BY F.P.C.
DRAWN BY G.R.A.	APPROVED BY [Signature]
HOR. SCALE: AS SHOWN	AUTHORIZED BY [Signature]
VERTICAL: AS SHOWN	DATE 9.02.26
DATE	DATE

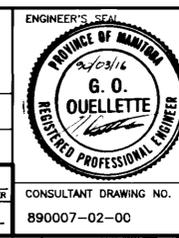

THE CITY OF WINNIPEG
 WORKS AND OPERATIONS DIVISION
 STREETS AND TRANSPORTATION DEPARTMENT

EMPRESS STREET OVERPASS
 STRUCTURE REHABILITATION, STRENGTHENING AND RELATED WORKS

GUARDRAIL ENERGY ABSORBING TERMINAL LOCATION PLAN

CITY DRAWING NUMBER
 B100-90-30

CONSULTANT DRAWING NO.
 890007-02-00