
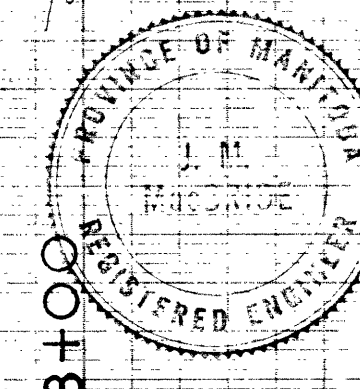
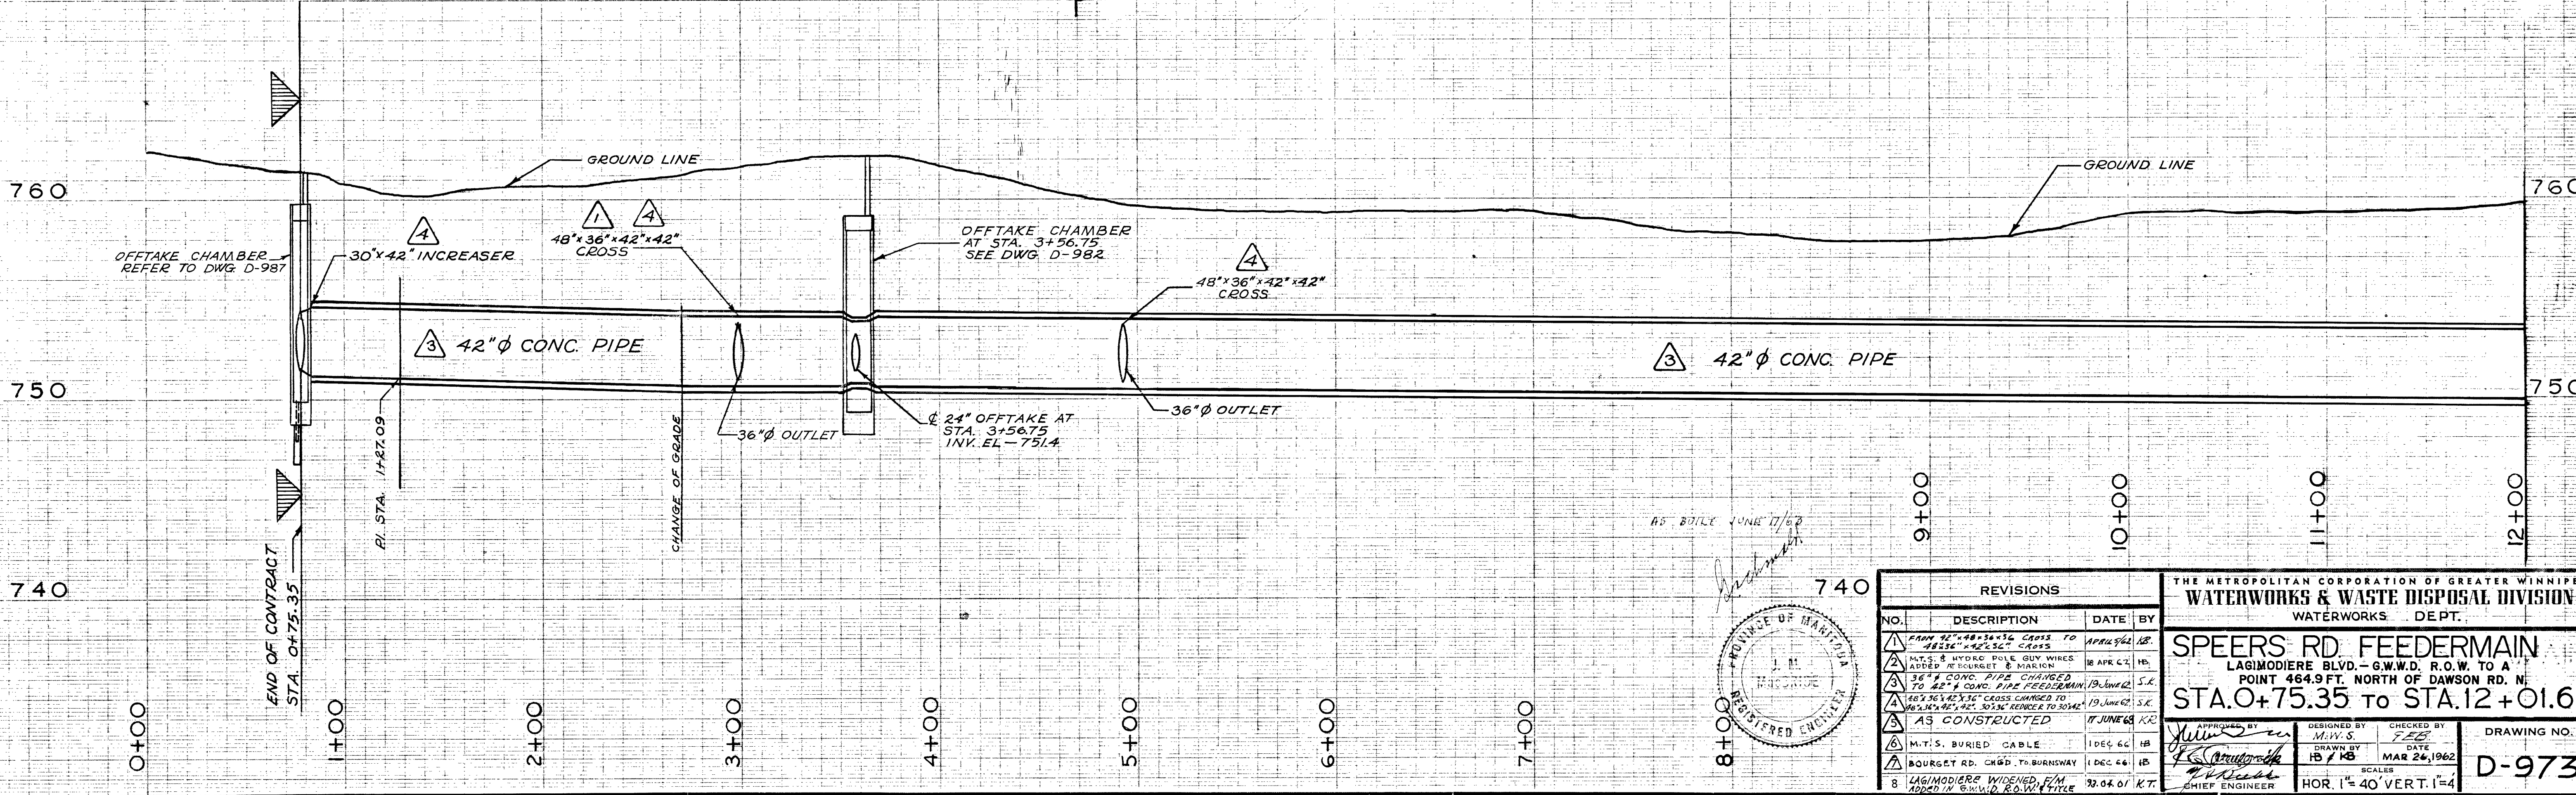


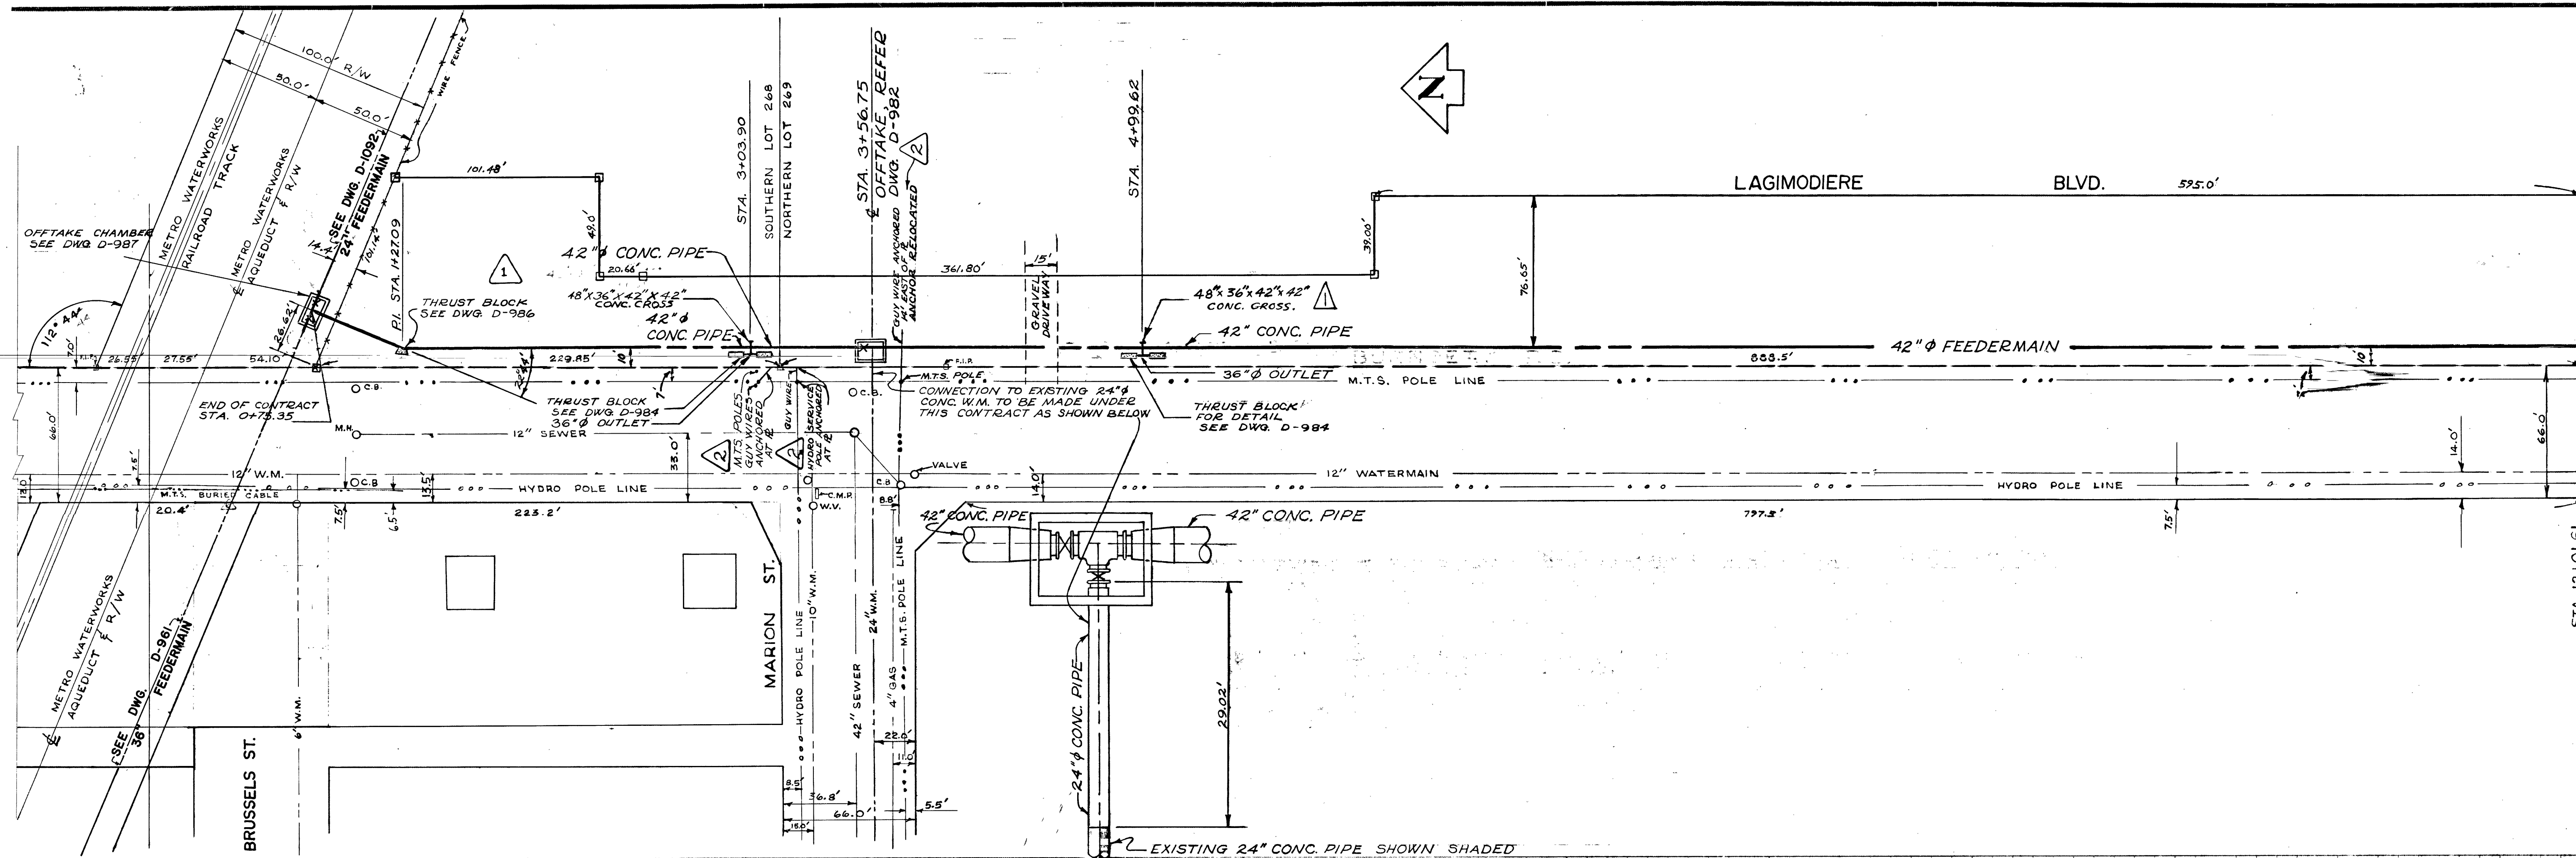

REVISIONS			
NO.	DESCRIPTION	DATE	BY
1	FROM 24" x 48" x 36" CROSS TO 48" x 36" x 42" x 42" CROSS	APRIL 24, 1962	HB
2	M.T.S. & HYDRO POLE GUY WIRES ADDED AT BOURGET & MARION	18 APR 62	HB
3	36" ϕ CONC. PIPE CHANGED TO 42" ϕ CONC. PIPE FEEDERMAIN	19 JUNE 62	S.K.
4	48" x 36" x 42" x 36" CROSS CHANGED TO 48" x 36" x 42" x 42" CROSS	19 JUNE 62	S.K.
5	AS CONSTRUCTED	17 JUNE 62	KR
6	M.T.S. BURIED CABLE	1 DEC 62	HB
7	BOURGET RD. CHGD. TO BURNSEY	1 DEC 62	HB
8	LAGIMODIERE WIDENED, F.M. ADDED IN G.W.W.D. R.O.W. TITLE	30 OCT 61	K.T.

THE METROPOLITAN CORPORATION OF GREATER WINNIPEG WATERWORKS & WASTE DISPOSAL DIVISION WATERWORKS DEPT.			
SPEERS RD. FEEDERMAIN LAGIMODIERE BLVD. - G.W.W.D. R.O.W. TO A POINT 464.9 FT. NORTH OF DAWSON RD. N. STA. 0+75.35 TO STA. 12+01.61			
APPROVED BY J. M. Macdonald CHIEF ENGINEER	DESIGNED BY M.W.S. DRAWN BY HB / MS DATE MAR 26, 1962	CHECKED BY F.E.B. DATE MAR 26, 1962	DRAWING NO. D-973
SCALES HOR. 1" = 40' VERT. 1" = 4'			