

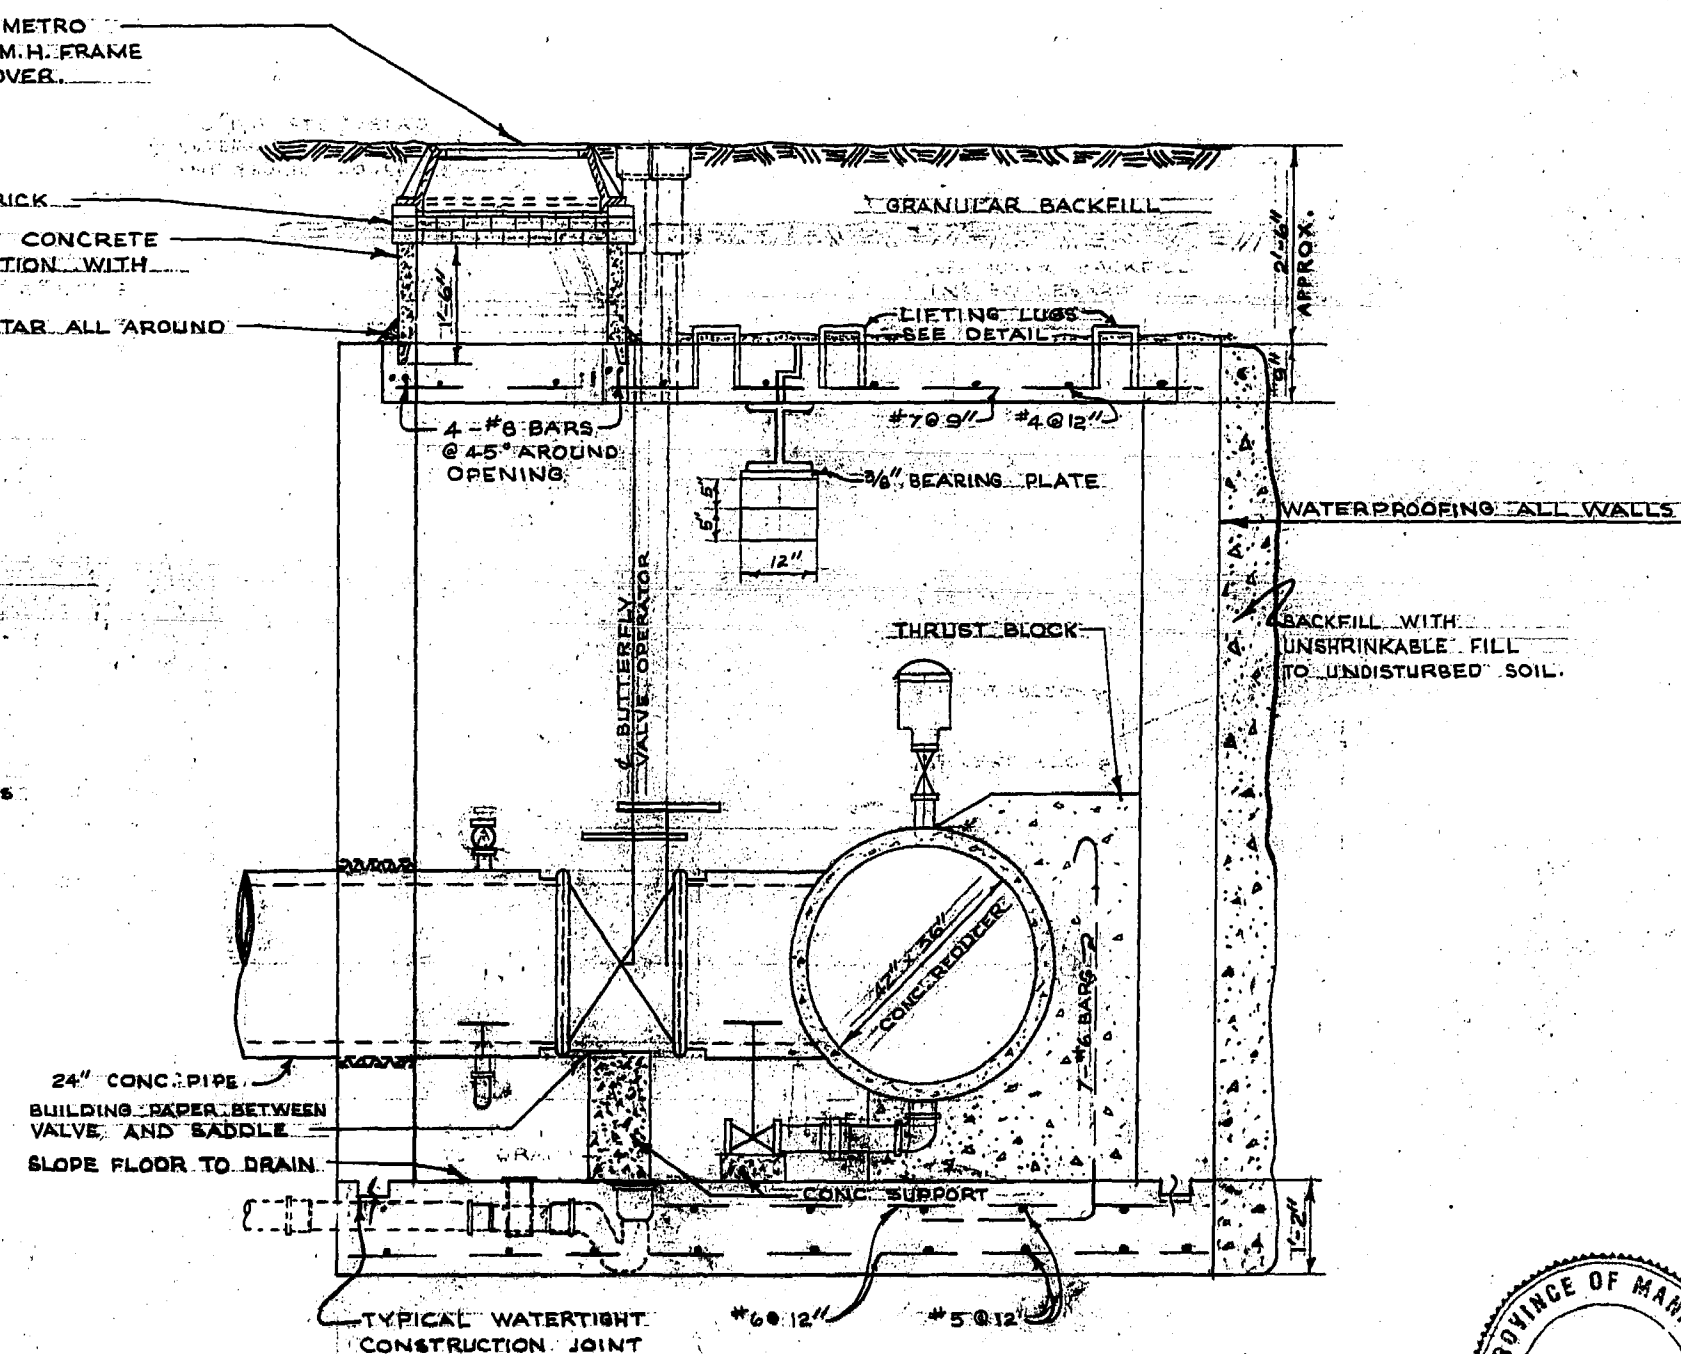
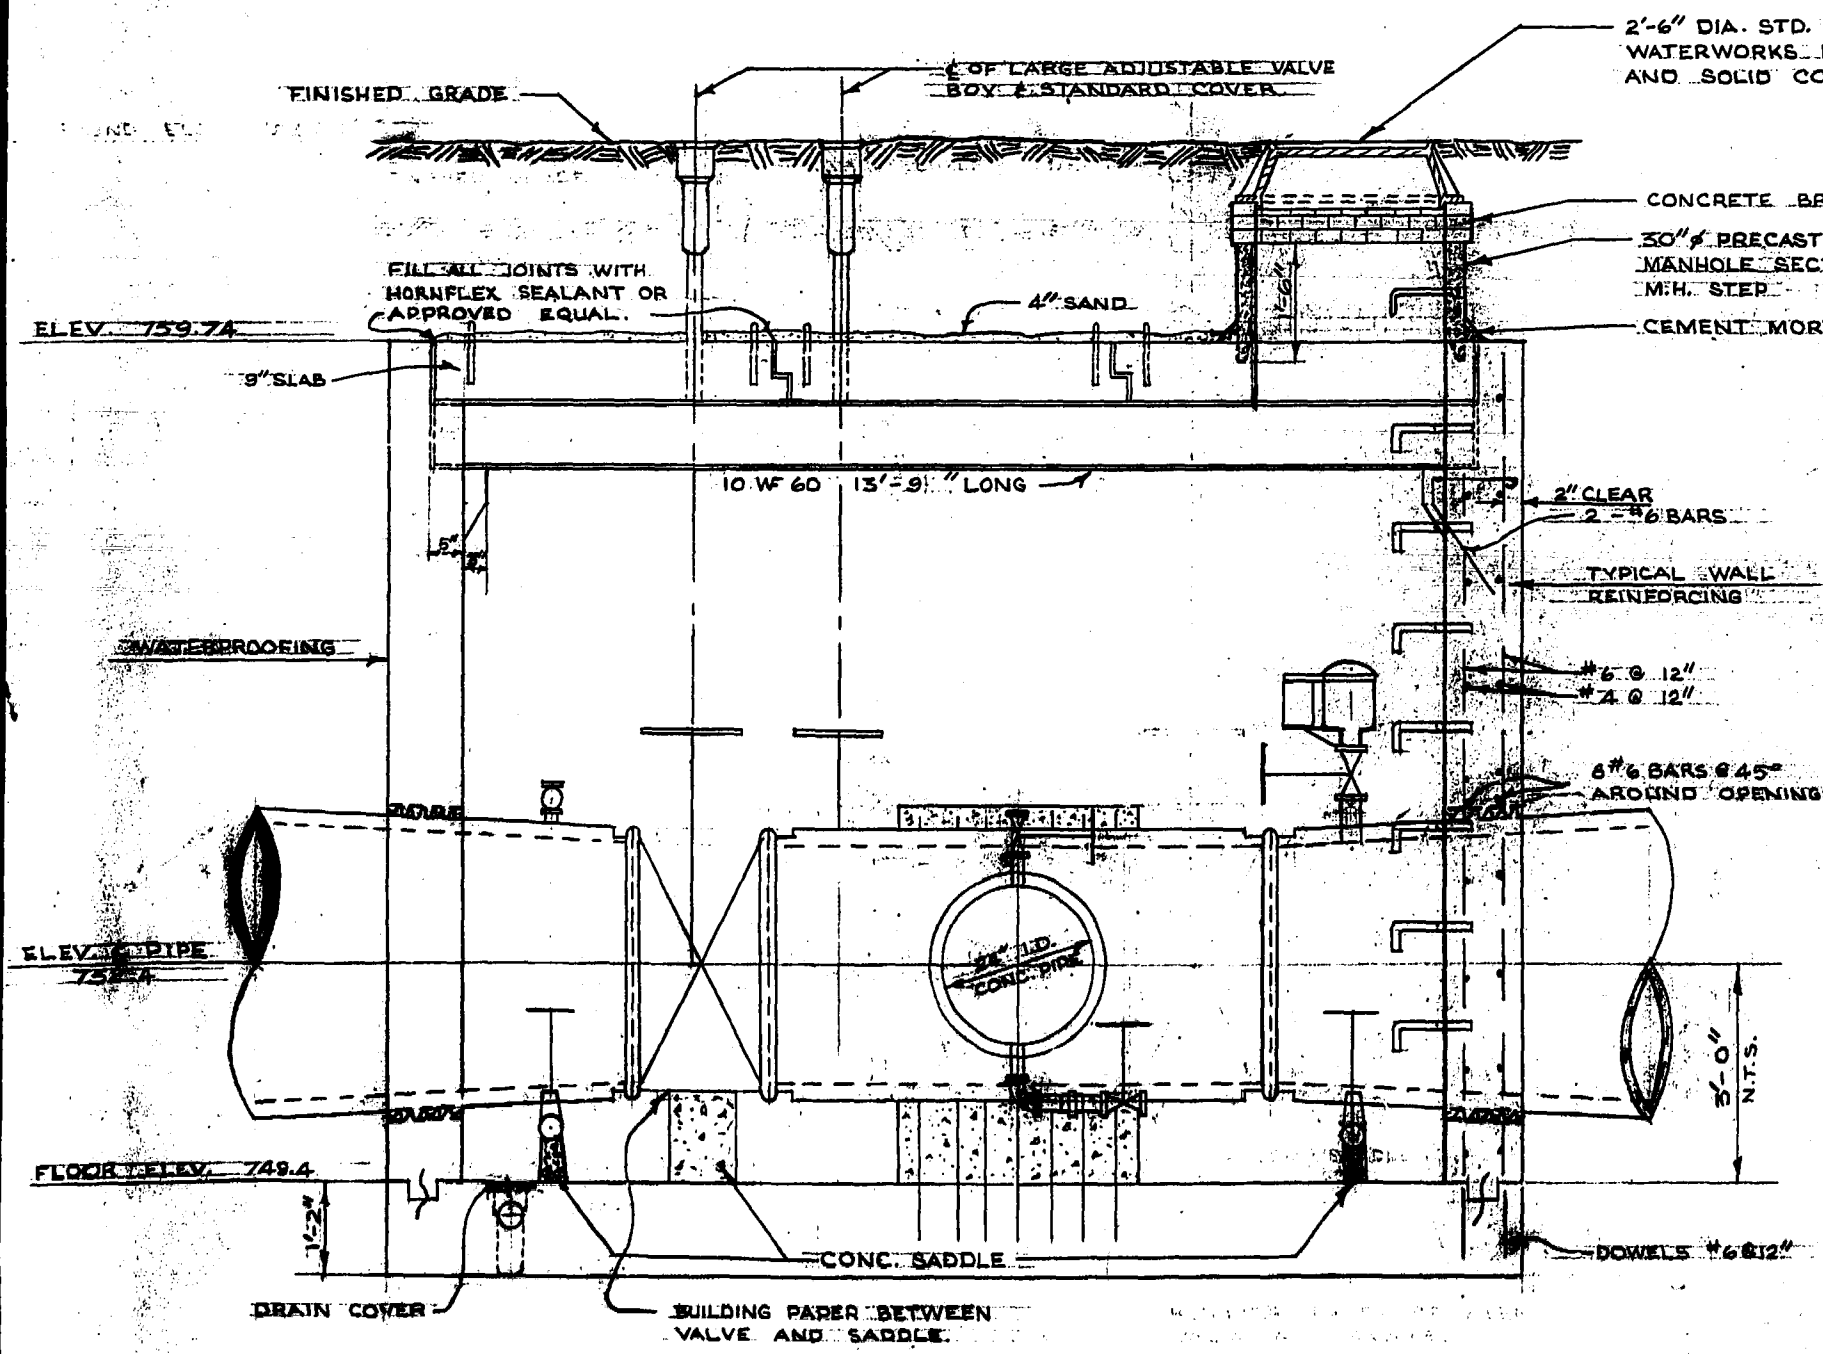
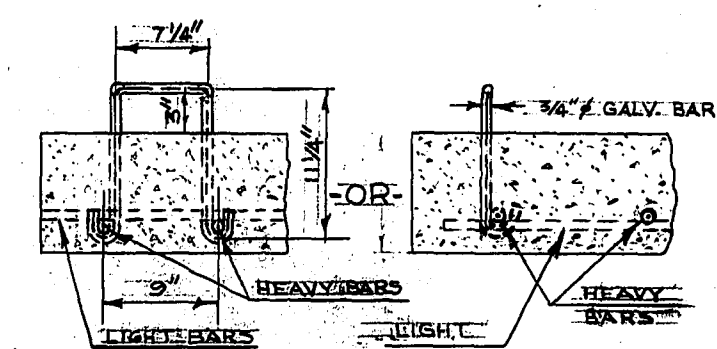
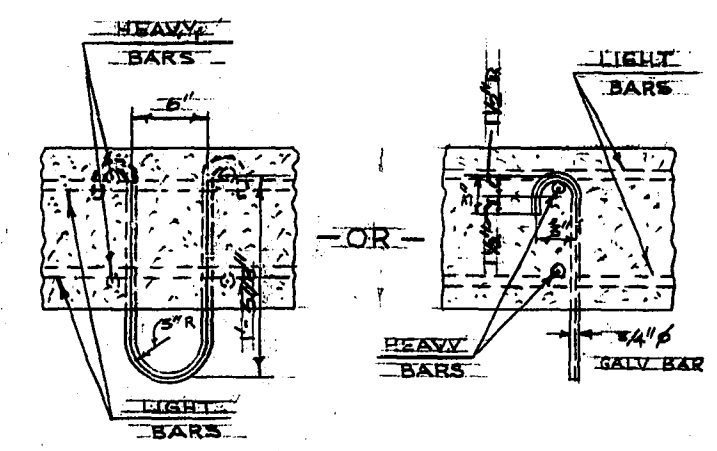
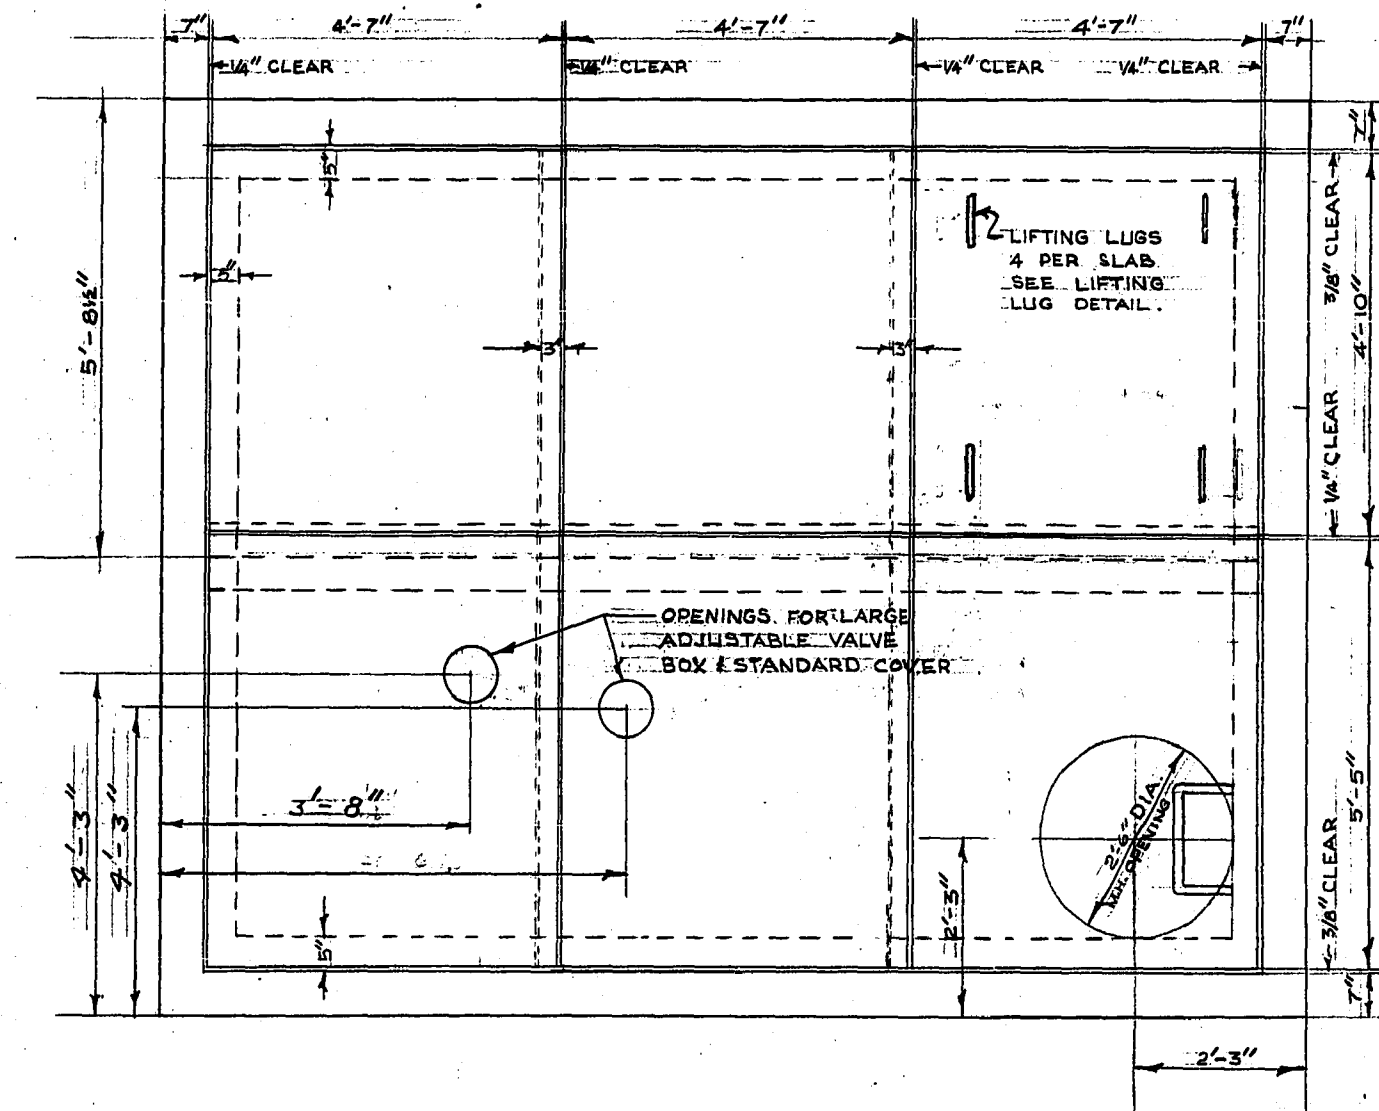


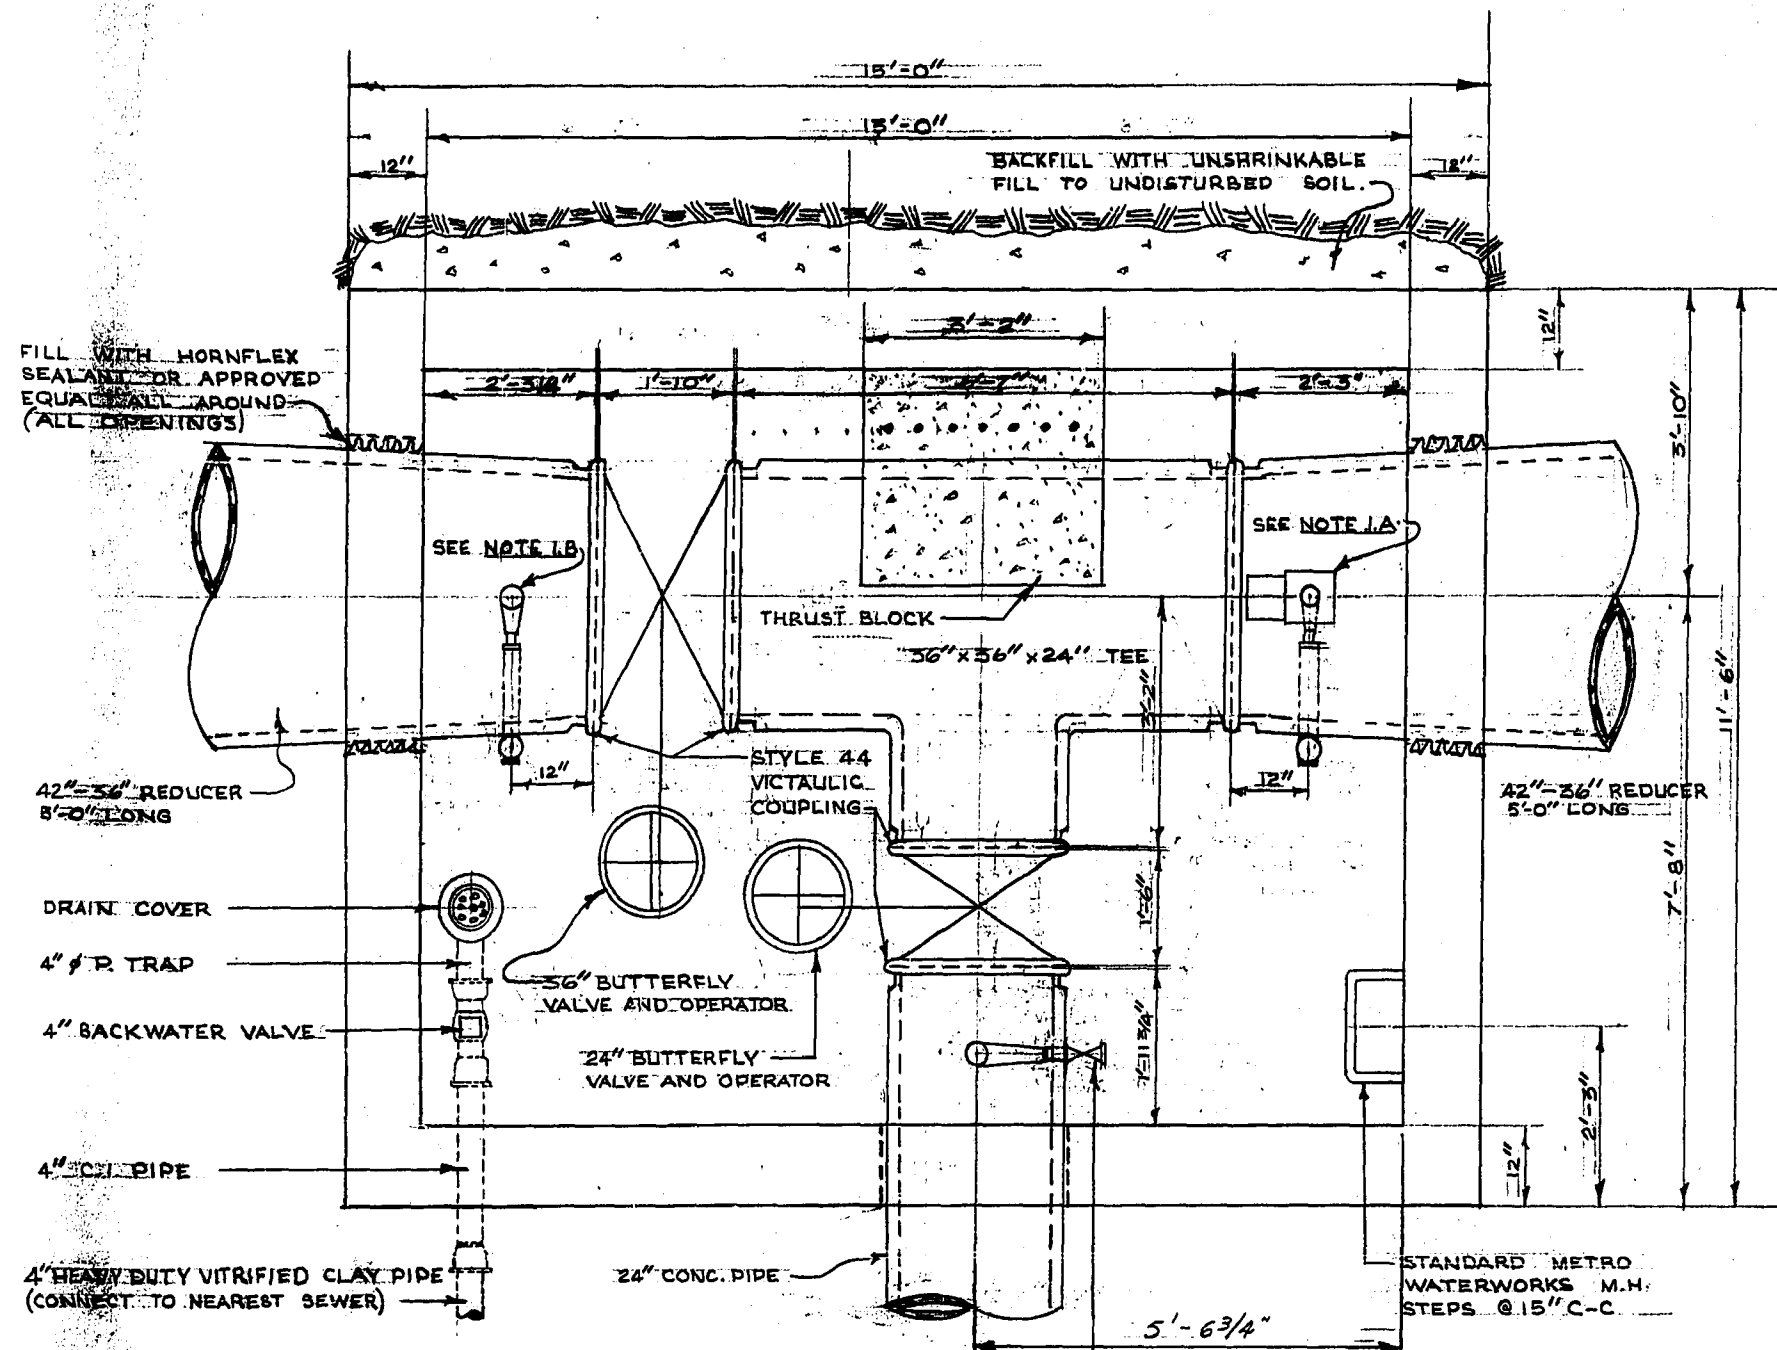

NOTES:

1. 42" 2" REDUCERS
2. 2" NIPPLES SCREWED ON LARGE GATE VALVE ELBOW, 2" VALVE ELBOW ON TOP
3. 2" NIPPLES ELBOW, 2" SHORT 2" UNION
4. 2" GATE VALVE ON BOTTOM (SCREWED FITTINGS)
5. 2" NIPPLES 2" GATE VALVE ON TOP
6. 2" NIPPLES 2" ELBOW, 2" SHORT 2" UNION
7. 2" GATE VALVE ON BOTTOM (SCREWED FITTINGS)
8. ALL 2" SCREWED FITTINGS ARE TO BE GROUND
9. ALL PRECAST CHAMBER SLABS ARE TO BE NUMBERED ON THE UNDERSIDE IN THE ORDER IN WHICH THEY CAN BE REMOVED (CASTING HOUSE NUMBERS)
10. ALL PRECAST CHAMBER SLABS ARE TO BE REMOVED BY HAND
11. ALL PRECAST CHAMBER SLABS ARE TO BE REMOVED BY HAND
12. ALL PRECAST CHAMBER SLABS ARE TO BE REMOVED BY HAND

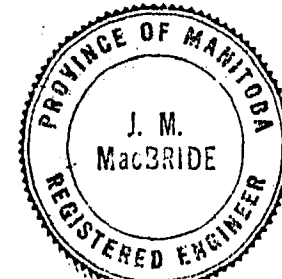

REVISIONS				THE METROPOLITAN CORPORATION OF GREATER WINNIPEG WATERWORKS & WASTE DISPOSAL DIVISION WATERWORKS DEPT.	
NO.	DESCRIPTION	DATE	BY		
1	AS CONSTRUCTED	27 JULY 1972		SPEERS RD FEEDER MAIN MARION ST. OFF TAKE CHAMBER	
2					
3				APPROVED BY: <i>[Signature]</i> DATE: <i>[Date]</i> DESIGNED BY: <i>[Signature]</i> DATE: <i>[Date]</i> DRAWN BY: <i>[Signature]</i> DATE: <i>[Date]</i> CHECKED BY: <i>[Signature]</i> DATE: <i>[Date]</i> SCALE: AS SHOWN	
4					
5				DRAWING NO. D-982	
6					
7					
8					