




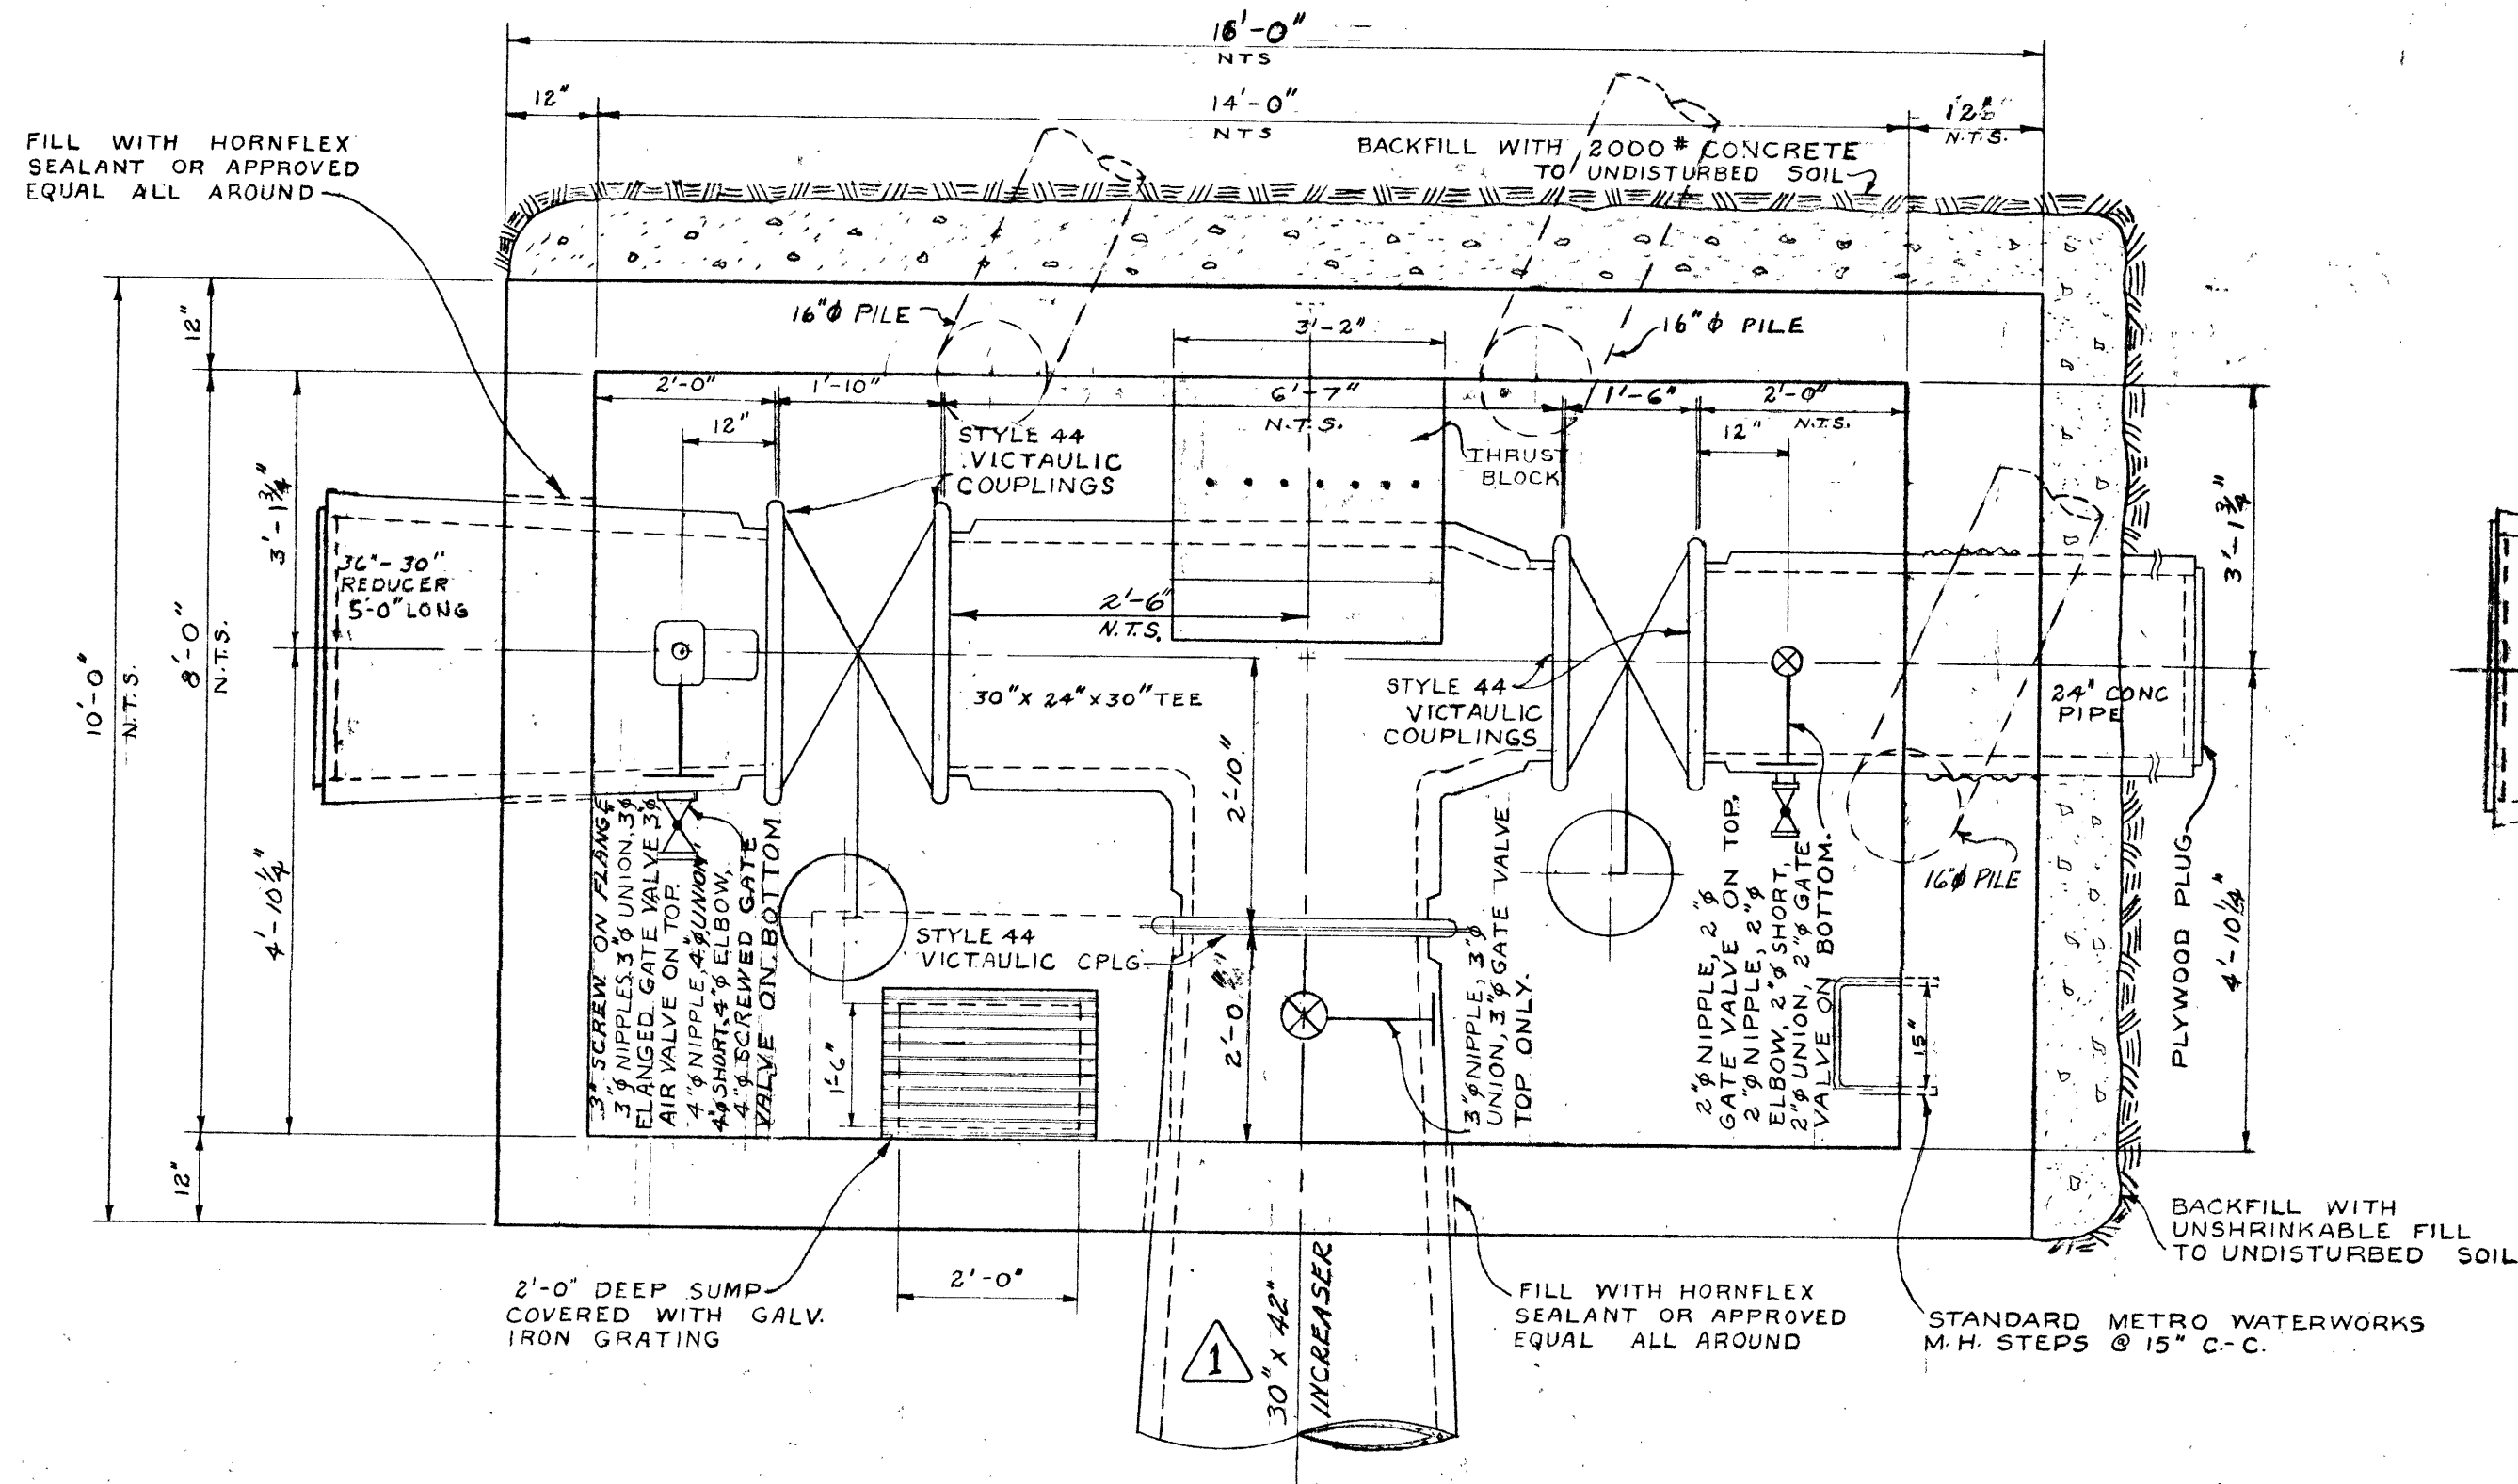

FLOOR PLAN

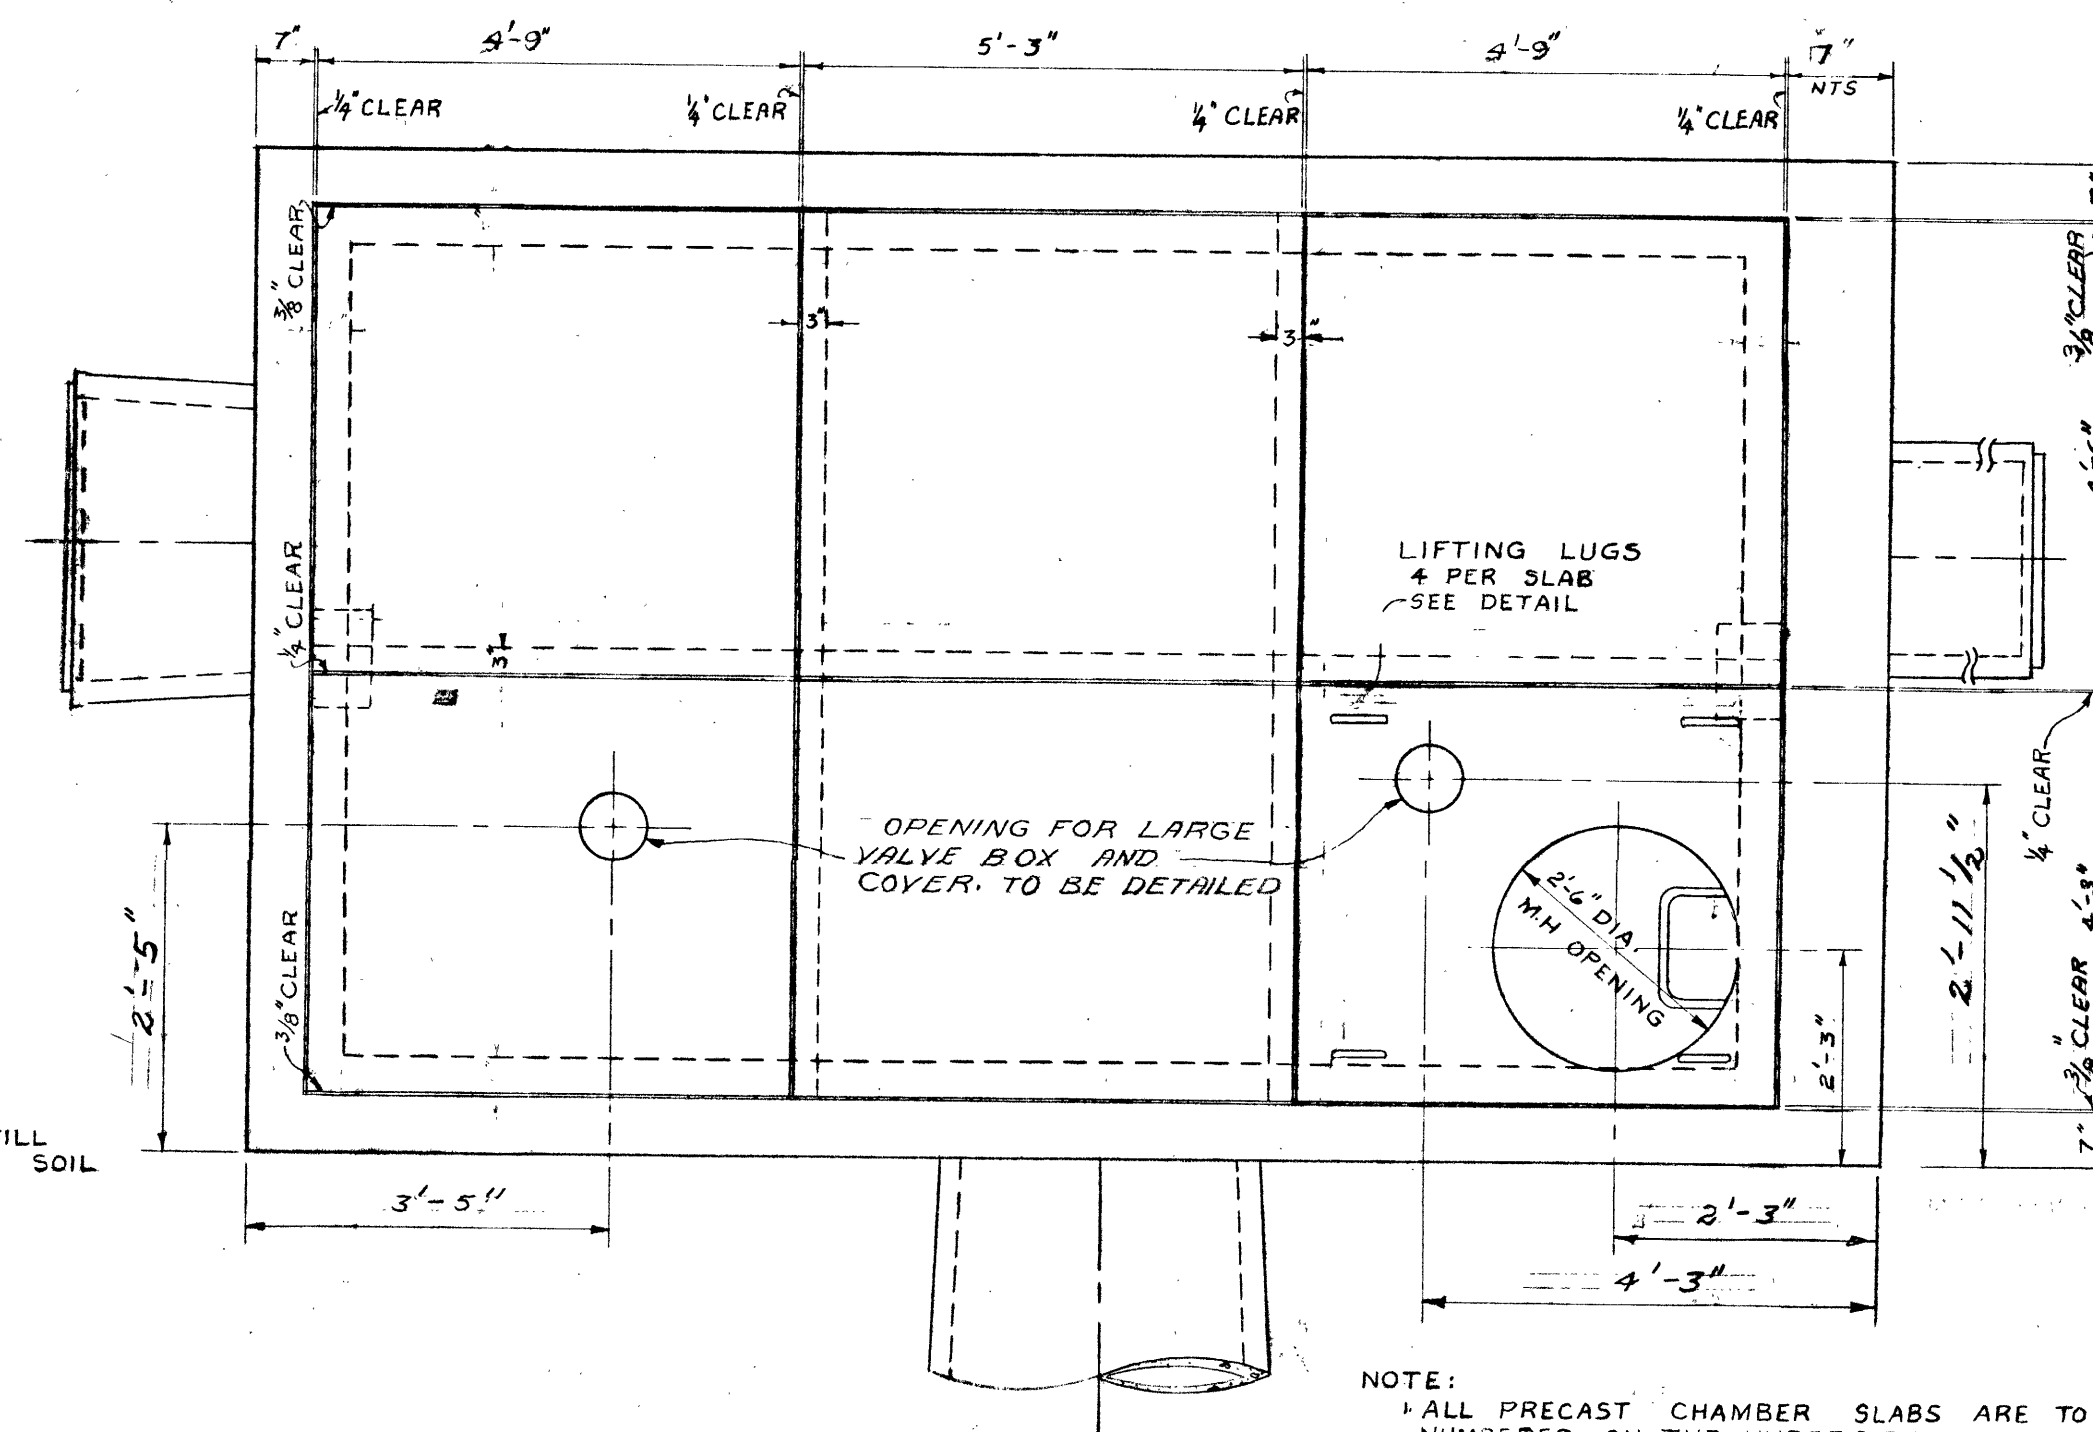


ROOF PLAN

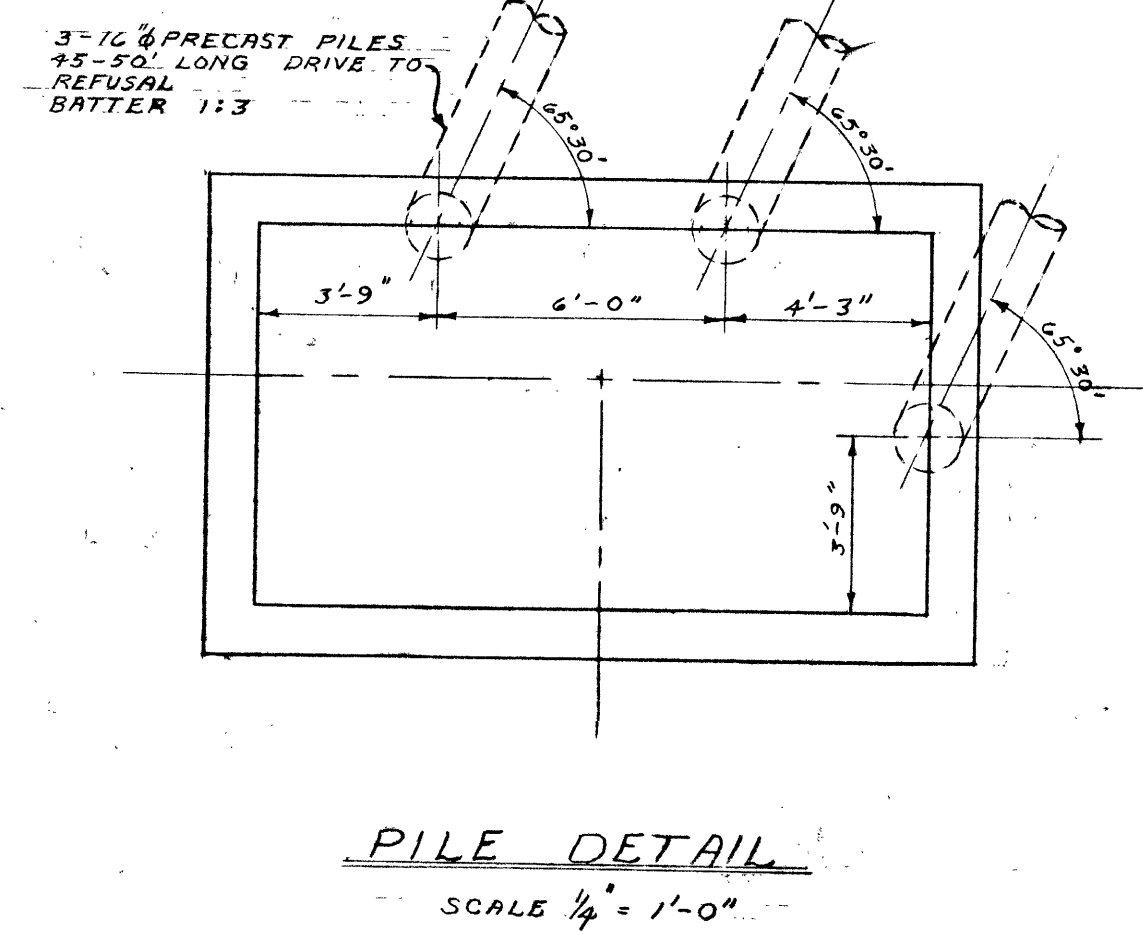


PILE DETAIL

NOTE:
 1. ALL PRECAST CHAMBER SLABS ARE TO BE NUMBERED ON THE UNDERSIDE, IN THE ORDER BY WHICH THEY CAN BE REMOVED. CAST IN TYPICAL HOUSE NUMBERS.
 2. CONCRETE ON TEE TO BE ROUGHENED AND COATED WITH "EPOXY" BINDING AGENT PRIOR TO POURING THRUST BLOCK.

NOTE:
 ALL FITTINGS TO BE GALVANIZED. SCREWED FITTINGS EXCEPT WHERE NOTED.

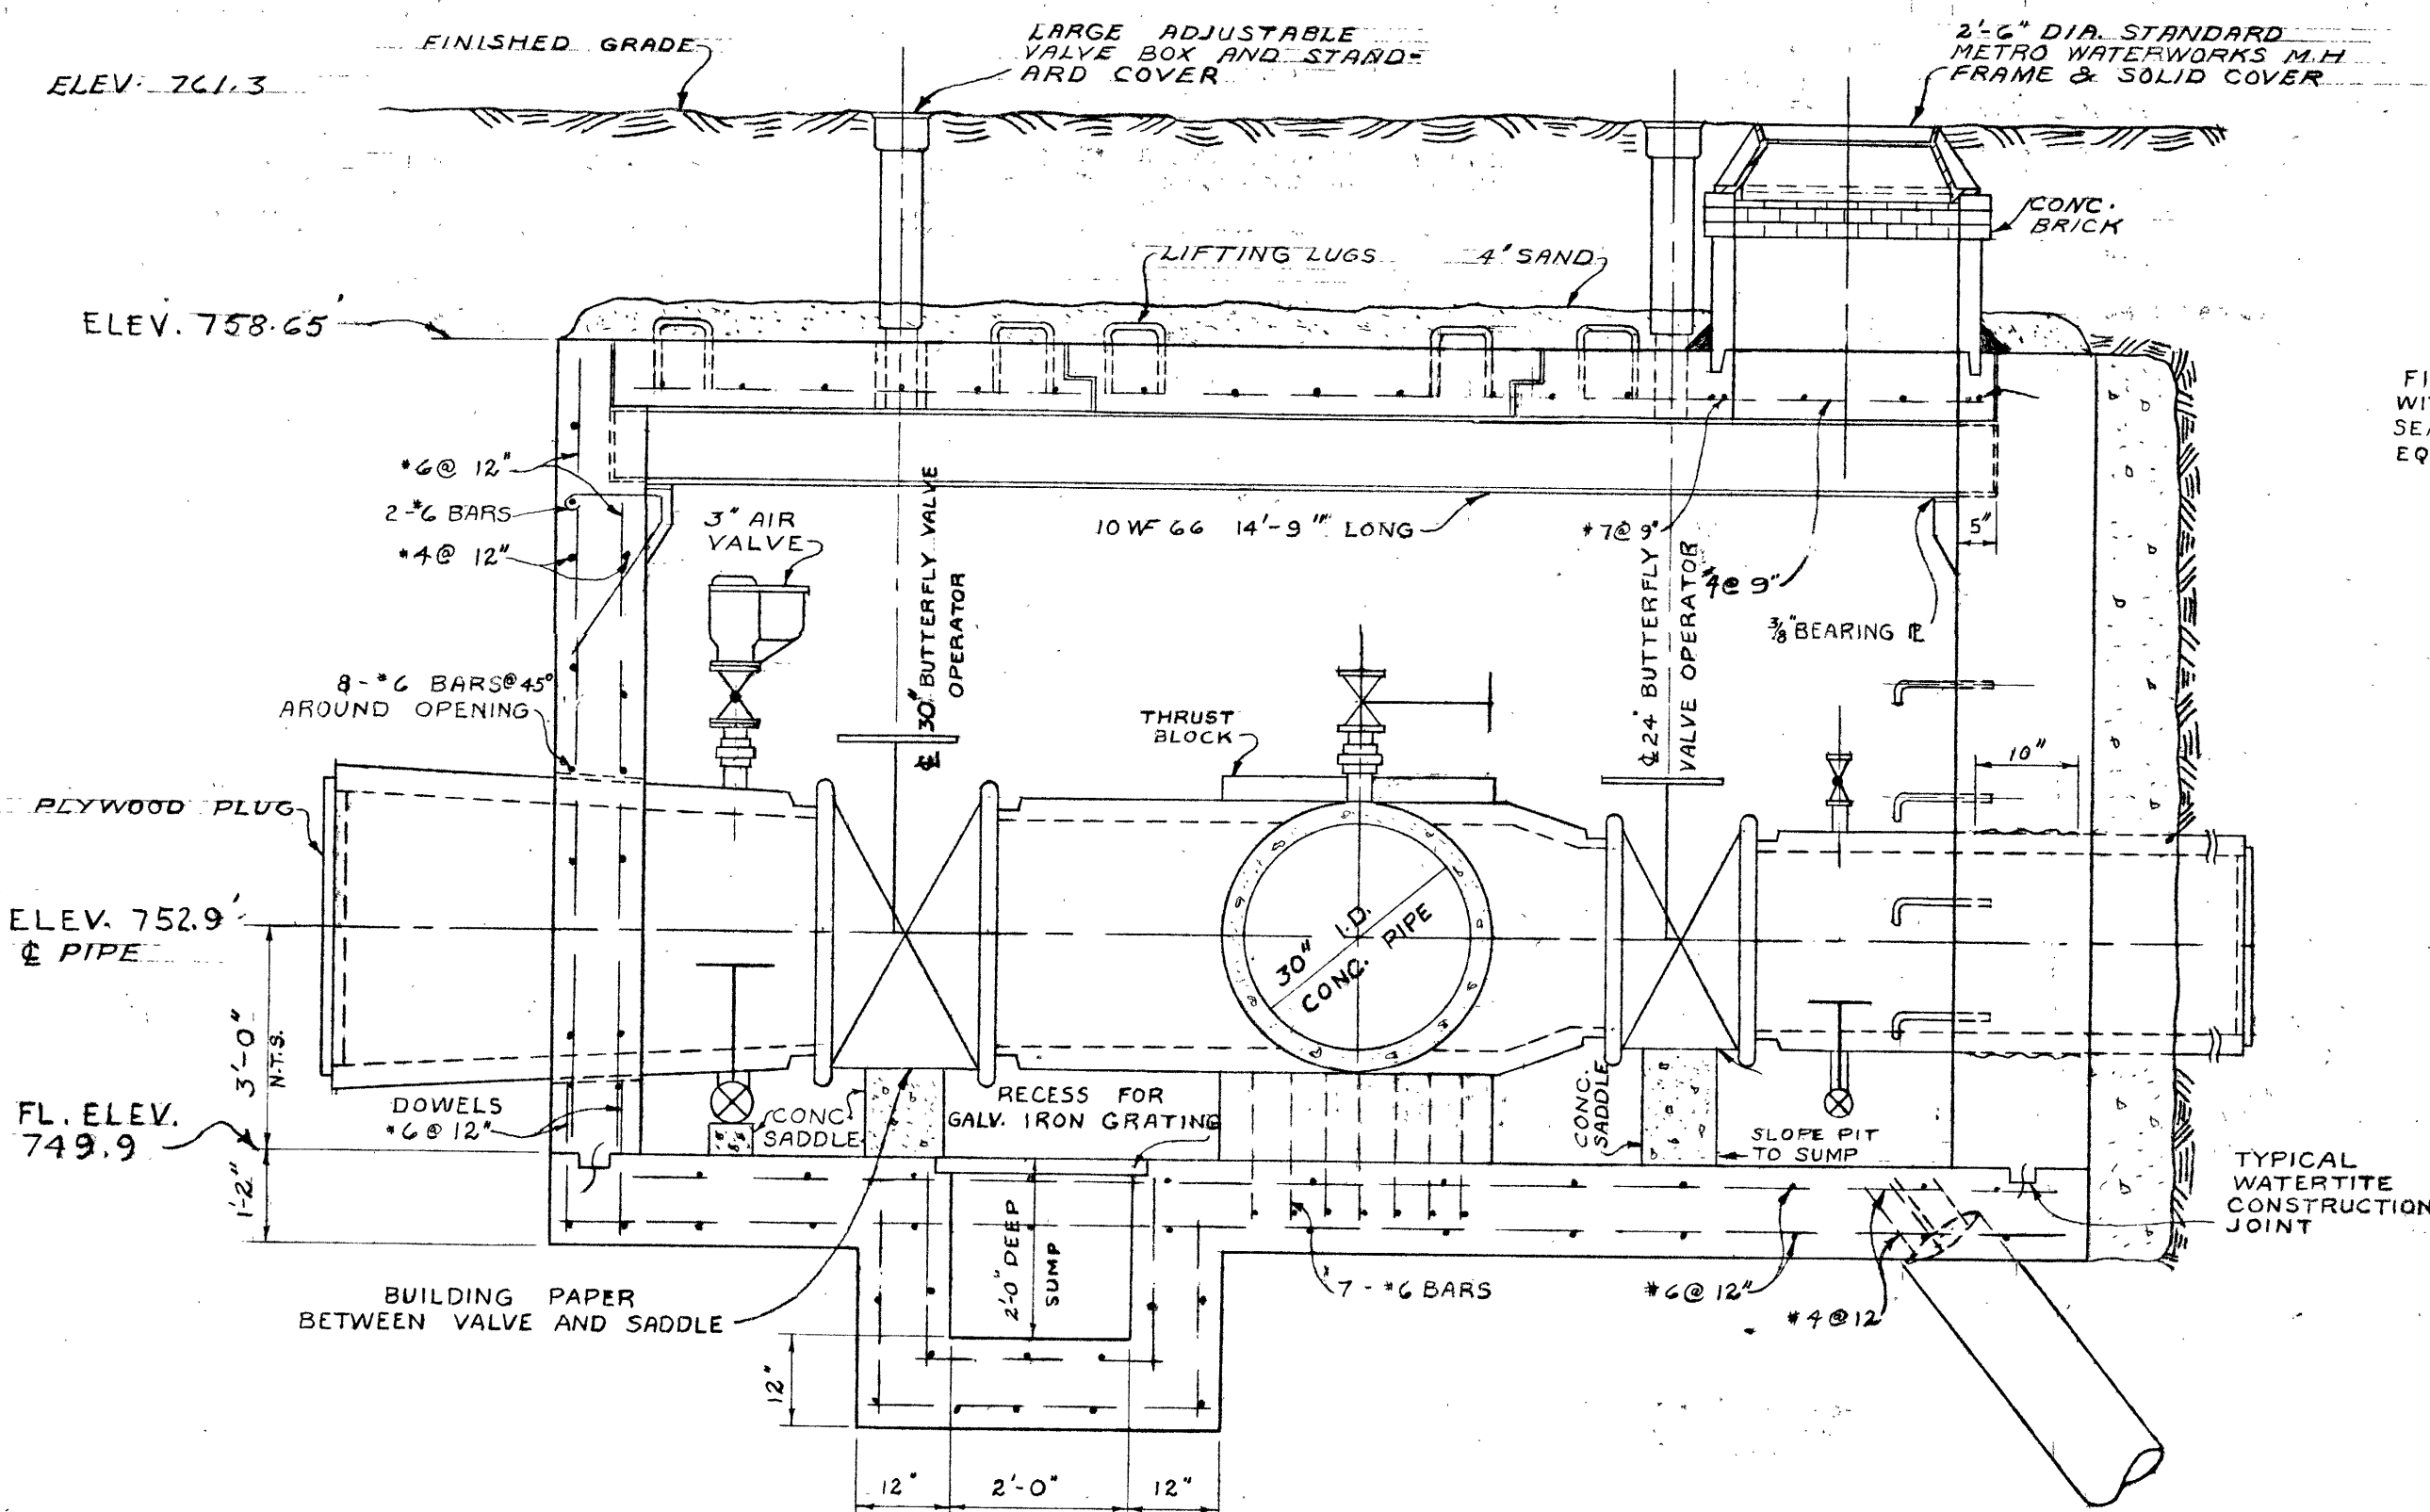

LONG. SECTION

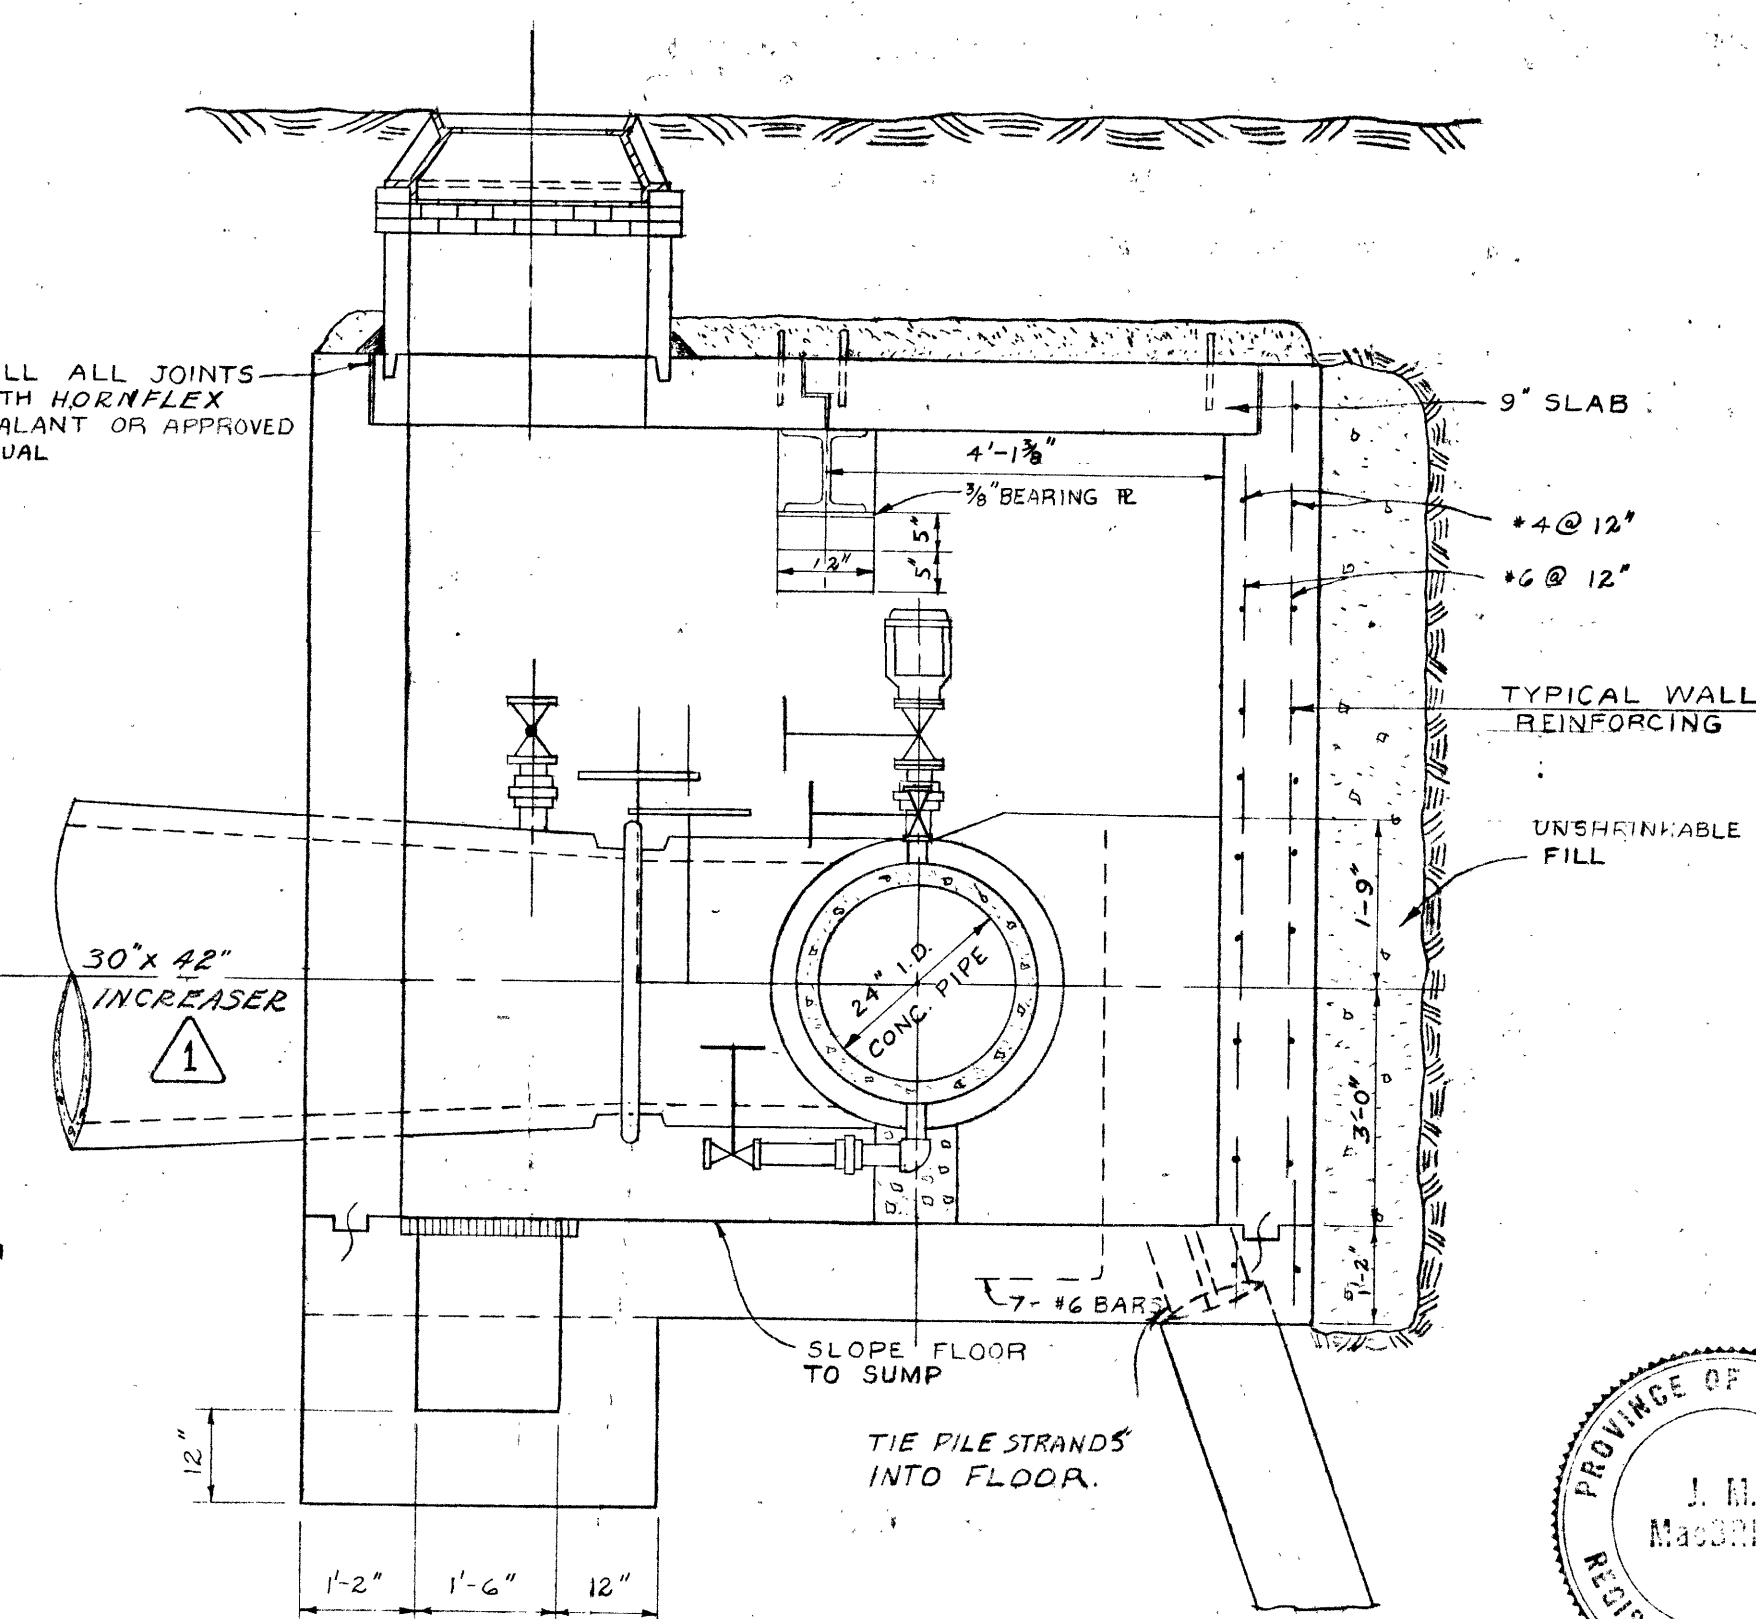

X-SECTION



REVISIONS				THE METROPOLITAN CORPORATION OF GREATER WINNIPEG			
				WATERWORKS & WASTE DISPOSAL DIVISION			
				WATERWORKS DEPT.			
NO.	DESCRIPTION	DATE	BY	SPEERS ROAD FEEDERMAIN			
1	30" x 36" INCREASER CHANGED TO 30" x 42" INCREASER	22-NOV-62	S.K.	OFFTAKE CHAMBER AT LAGIMODIERE			
2	AS CONSTRUCTED	14-AUG-64	K.A.	BLVD. & G.W.W.D. WATERWORKS R/W			
3	CHANGED TITLE BLOCK: ROUSET TO LAGIMODIERE METRO TO G.W.W.D.	93-04-05	K.T.				
4							
5							
6							
7							
8							

APPROVED BY: *[Signature]* DESIGNED BY: *[Signature]* CHECKED BY: *[Signature]*
 DRAWN BY: V.D. DATE: MAR. 29, 1962
 CHIEF ENGINEER
 SCALE: 1/2" = 1'-0"

DRAWING NO.
D-987

Micro-Filmed 1985

D-0987