


- CONSTRUCTION NOTES:**
- ISOLATE MISCELLANEOUS ITEMS IN NEW CONCRETE WORKS AS PER SD-228C.
 - LEGAL PLAN AND UNDERGROUND INFORMATION FROM CITY OF WINNIPEG LBIS. CONTRACTOR VERIFY ALL UNDERGROUNDS IN THE FIELD.
 - CONTRACTOR TO TAKE PRECAUTIONARY STEPS TO AVOID DAMAGE FROM CONSTRUCTION ACTIVITIES TO TREES WITHIN THE LIMITS OF CONSTRUCTION.
 - LOCATION OF EXISTING SERVICES TO BE CONFIRMED IN THE FIELD BY THE CONTRACTOR.
 - INSTALL CB LEADS AT MIN. 1.0% SLOPE OR AS DIRECTED BY CONTRACT ADMINISTRATOR.
 - FOR CB LEADS, RIP RAP AND LDS INFORMATION SEE "CU" DRAWINGS.
 - CONTRACTOR SHALL CONFIRM EXISTING LEAD INVERT ELEVATIONS PRIOR TO INSTALLATION.

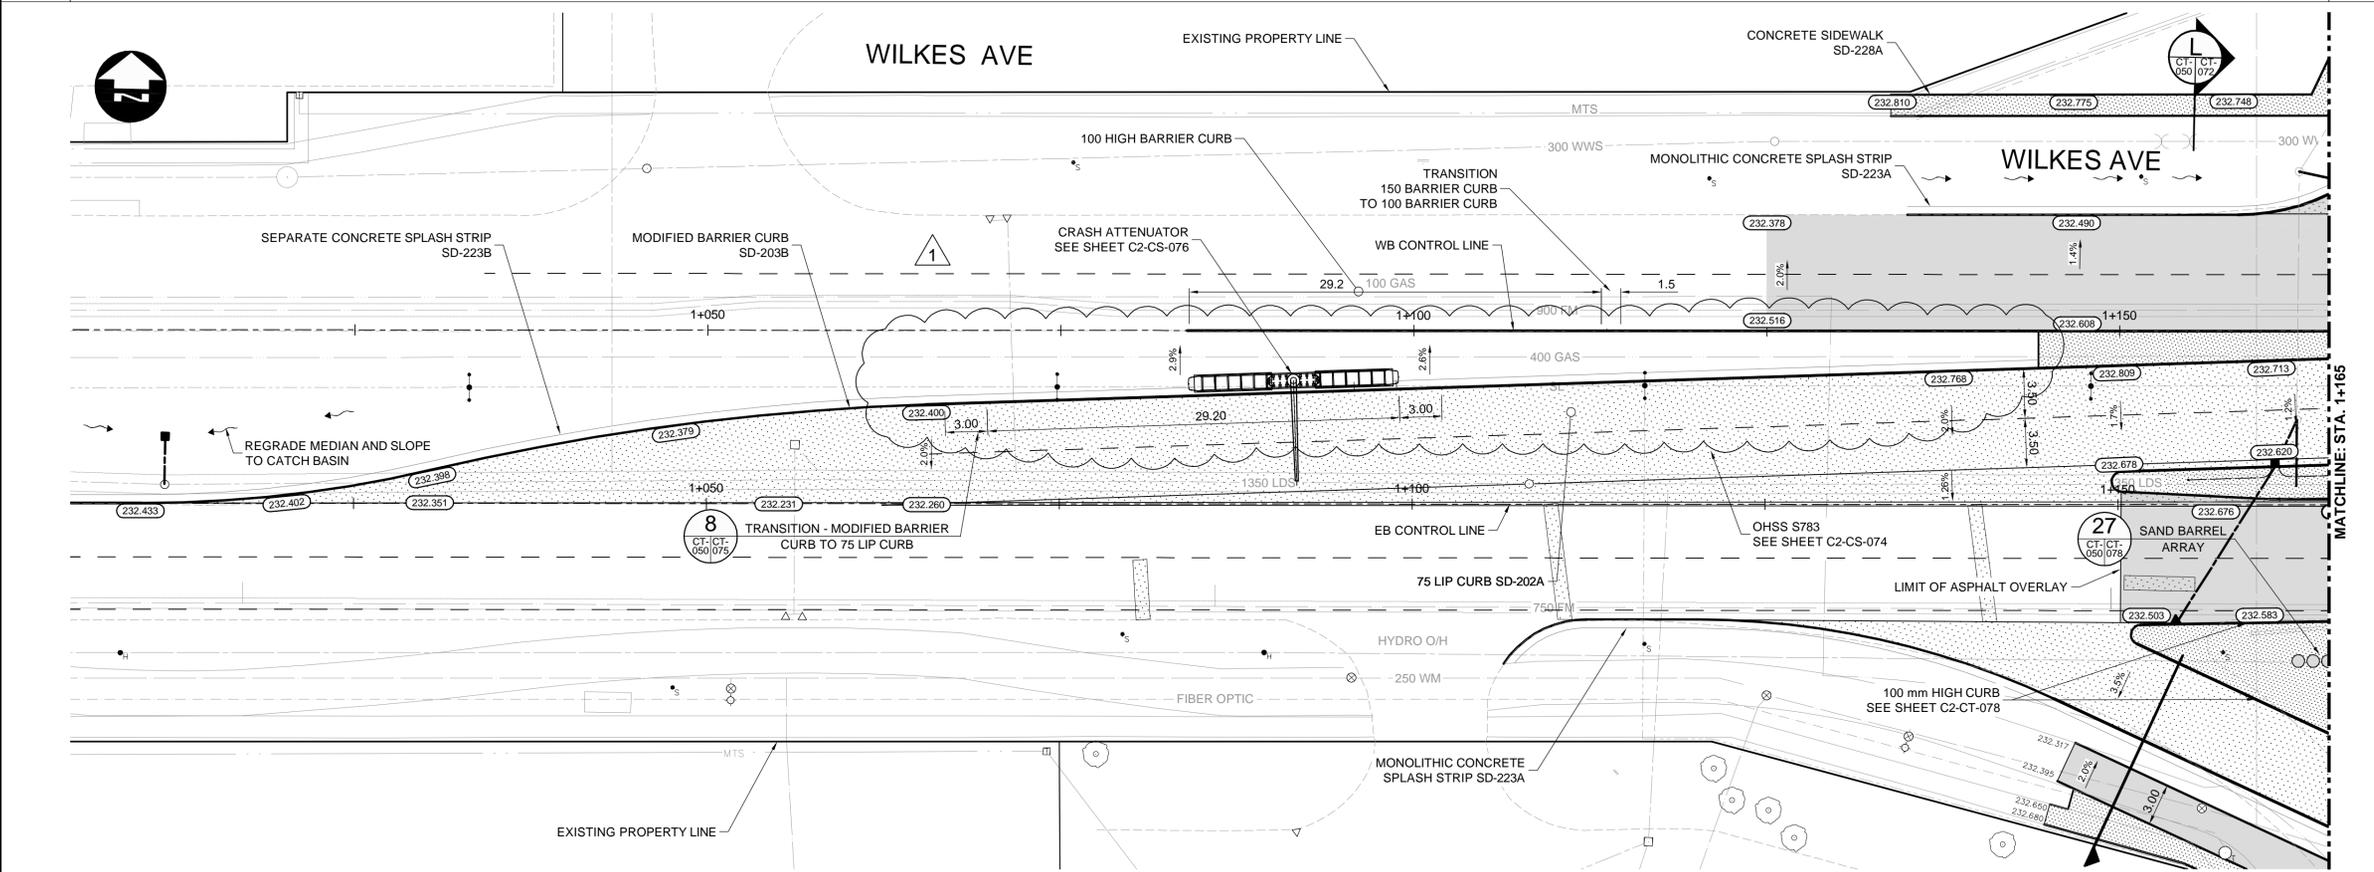

METRIC

WHOLE NUMBERS INDICATE MILLIMETRES
 DECIMALIZED NUMBERS INDICATE METRES

WARNING

IF POWER EQUIPMENT OR EXPLOSIVES ARE TO BE USED FOR EXCAVATION ON THIS PROJECT THE CONTRACTOR MUST:

- NOTIFY THE GAS COMPANY OF THE PROPOSED LOCATION OF EXCAVATION.
- TAKE PRECAUTION TO AVOID DAMAGE TO GAS COMPANY INSTALLATIONS SEE PROVINCIAL REGULATION 210/72 FOR DETAILS.
- OBTAIN EXCAVATION PERMITS PRIOR TO CONSTRUCTION.



150 WM	WATERMAIN	150 WM	CONCRETE	150 WM	WATERMAIN	150 WM	WATERMAIN	B.M. ELEV.	SEE SHEET C2-CT-007 FOR CONTROL POINT INFORMATION		ENGINEER'S SEAL		THE CITY OF WINNIPEG PUBLIC WORKS DEPARTMENT	WAVERLEY STREET UNDERPASS AT CN MILE 3.89 RIVERS SUB CONTRACT 2: UNDERPASS STRUCTURES, RAILWORKS, ROADWORKS, LAND DRAINAGE SEWER, PUMPING STATION AND LANDSCAPING WORKS	CITY DRAWING NUMBER U-239-2016-C2-CT-050 SHEET 050 OF 081 CONSULTANT DRAWING NUMBER C2-CT-050
300 LDS	LAND DRAINAGE SEWER	300 LDS	ASPHALT	300 LDS	LAND DRAINAGE SEWER	300 LDS	LAND DRAINAGE SEWER	DESIGNED BY	PMW		CHECKED BY				
250 WWS	WASTE WATER SEWER	250 WWS	PLANING	250 WWS	WASTE WATER SEWER	250 WWS	WASTE WATER SEWER	DRAWN BY	PMW	APPROVED BY	DBW	Member 22480	16-3353		
HYDRO	HYDRO	HYDRO	SIDEWALK	+	HYDRANT	+	HYDRANT	HR. SCALE	1:250	RELEASED FOR CONSTRUCTION	DATE				
MTS	M.T.S.	MTS	PAVING STONES	+	VALVE	+	VALVE	VERTICAL	1:10	DATE					
100 GAS	GAS	100 GAS	PARTIAL DEPTH REPAIR	+	PROPERTY LINE	---	PROPERTY LINE	NO. REVISIONS							
EXISTING	LEGEND-PLAN	PROPOSED	DRAINAGE ARROW	→	CURB RAMP (SD-229C)	---	CURB RAMP (SD-229C)	1	ADDENDUM #6	17/03/13	DBW				
			DETECTABLE WARNING SURFACE TILE (SD-229AA)	□	DETECTABLE WARNING SURFACE TILE (SD-229AA)	□	DETECTABLE WARNING SURFACE TILE (SD-229AA)	0	ISSUED FOR TENDER	17/01/09	DBW				

G:\CAD\163353\Technical\Workspaces\Engineering\Drawings and Figures\Roadworks\Contract\163353-C2-CON-CT-PLAN-PROFILE-HURST.dwg