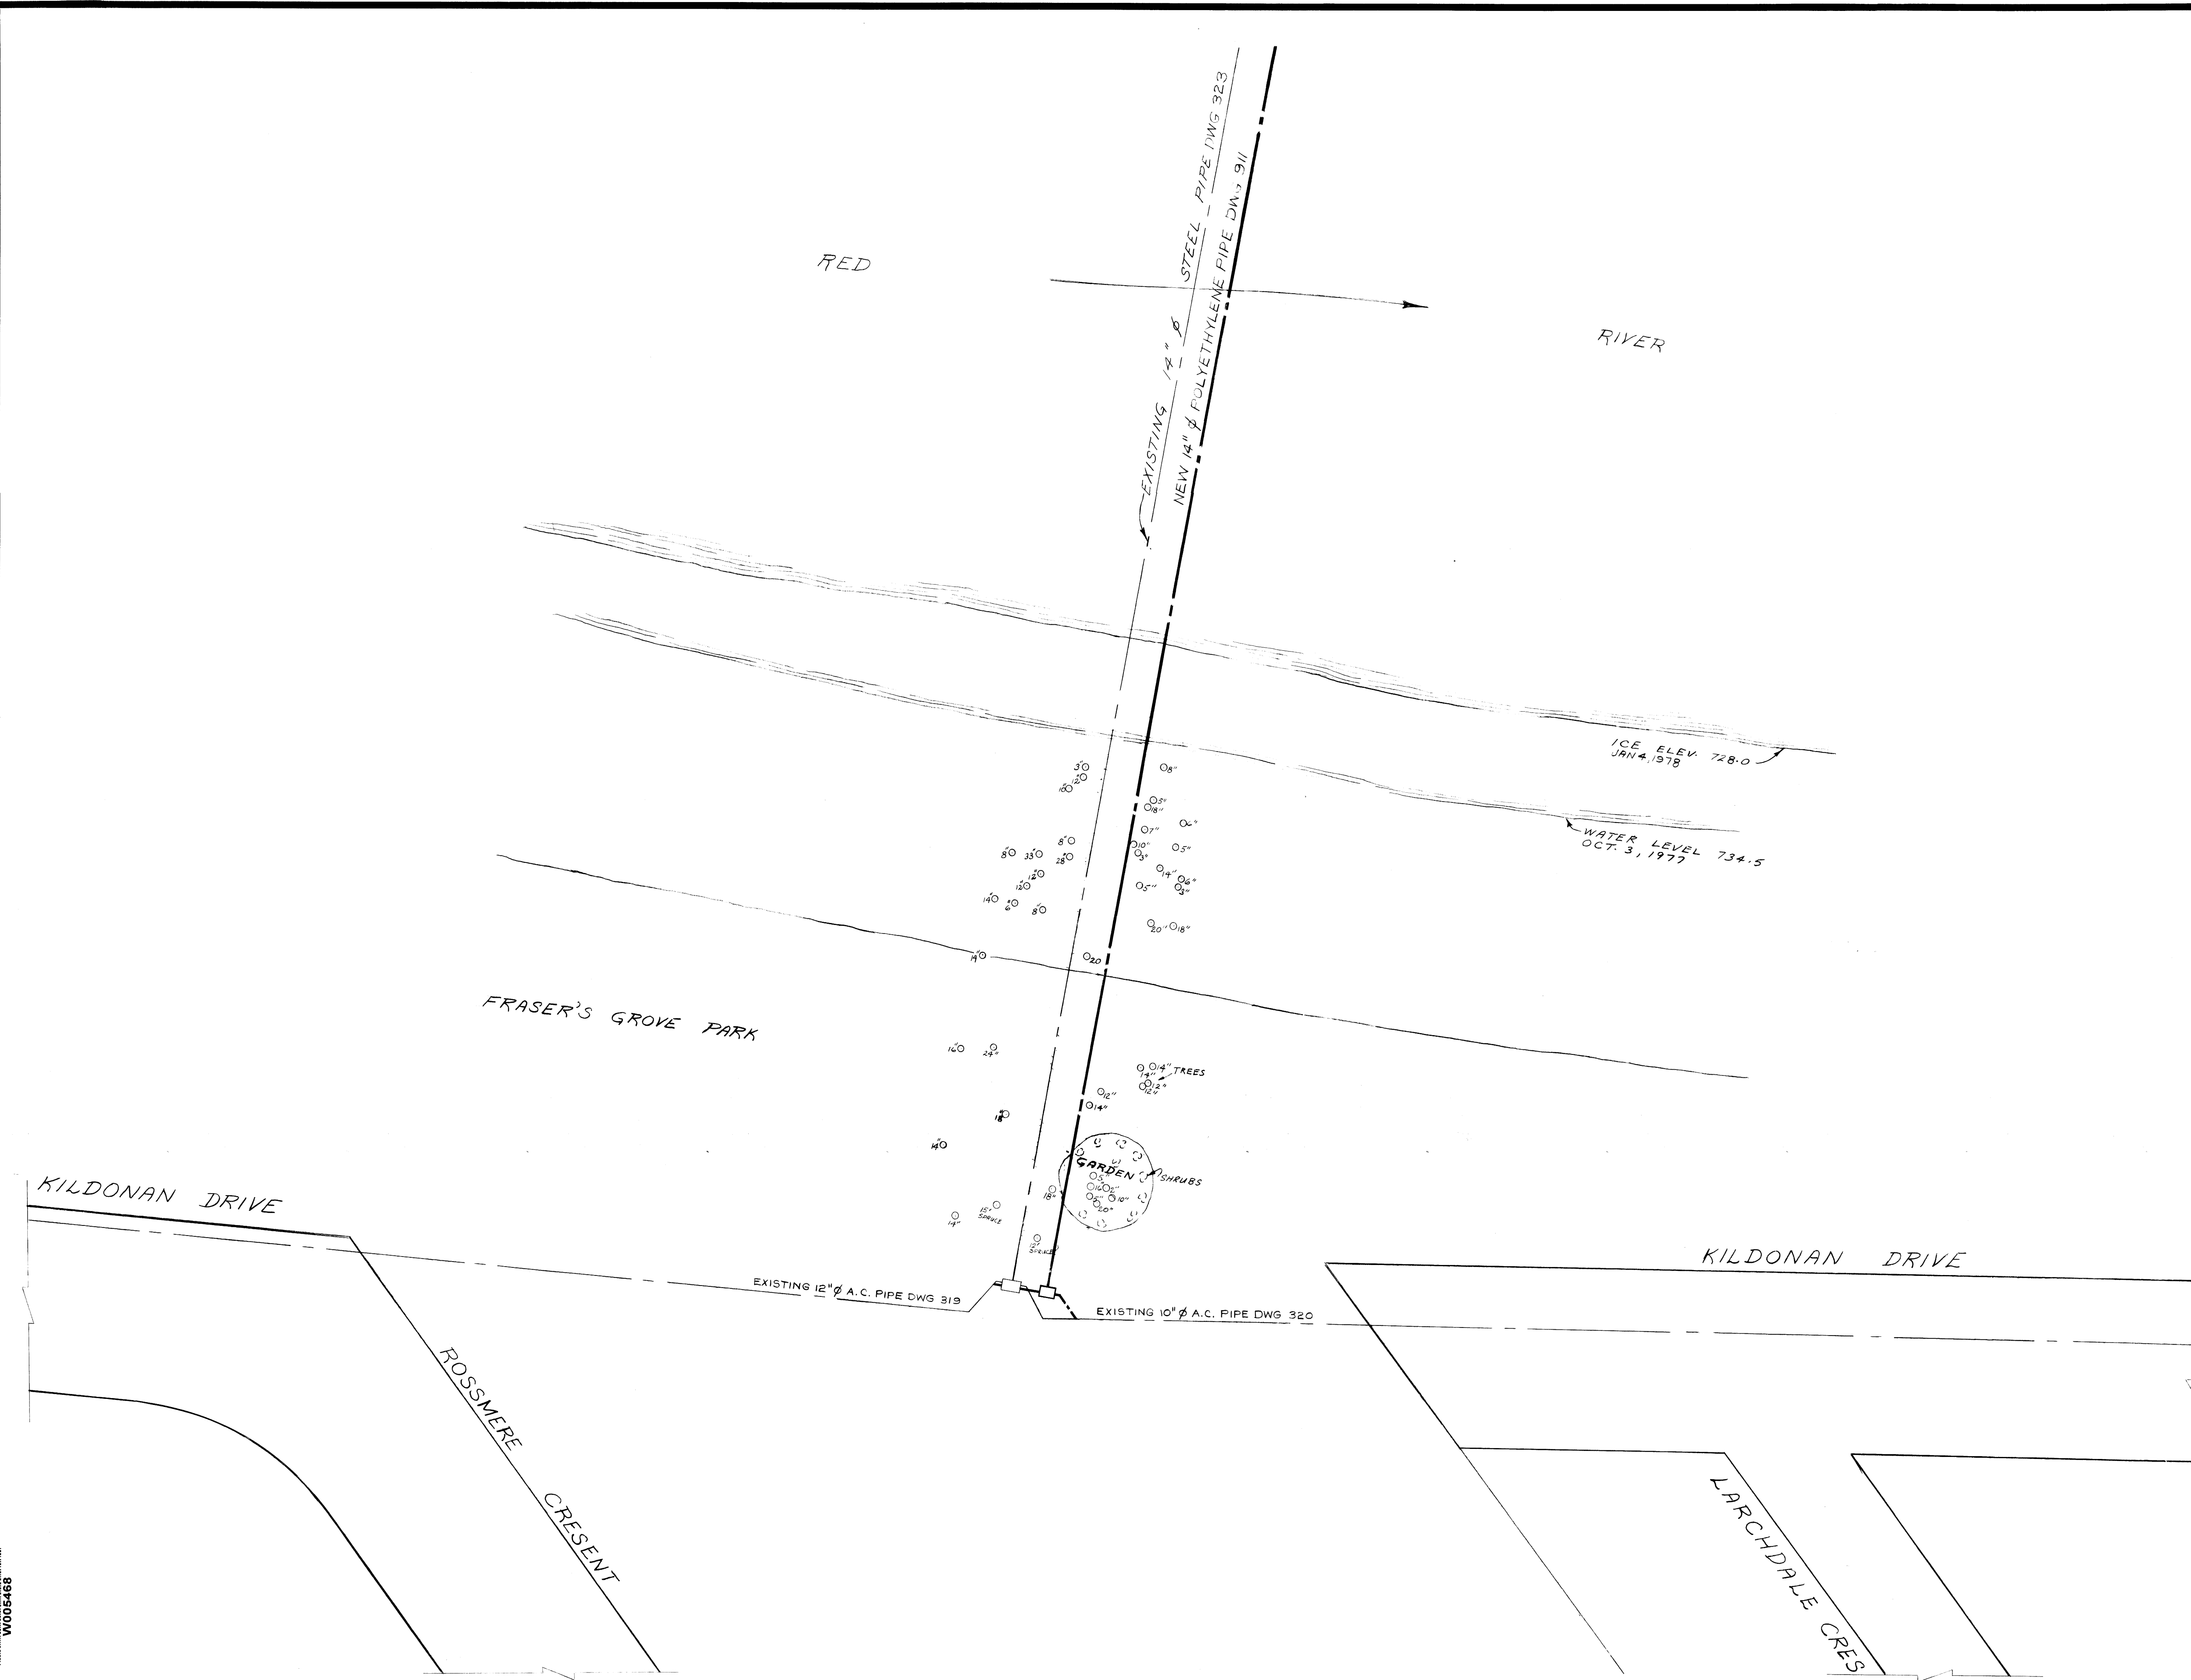


D. S. *Walsh* 78 09 05

REVISIONS	
NO.	DESCRIPTION
1	REVISED TO AS BUILT
DATE	BY
AUG 18/78	<i>[Signature]</i>
The City of Winnipeg Waterworks, Waste and Disposal Division	
ENGINEERING BRANCH WASTE DISPOSAL	
NEWTON RIVER X-ING PIPE ALIGNMENT FRASER'S GROVE PARK	
DESIGNED BY <i>B. BRICK</i>	DRAWN BY <i>V. DUMORE</i>
CHECKED BY <i>D. WILCHAY</i>	DATE OCT 3, 1977
APPROVED BY <i>[Signature]</i>	
SCALE 1" = 40'	DRAWING NO. 928

file # SS 10136