





# **APPENDIX 'E'**




## **RECORD DRAWINGS**





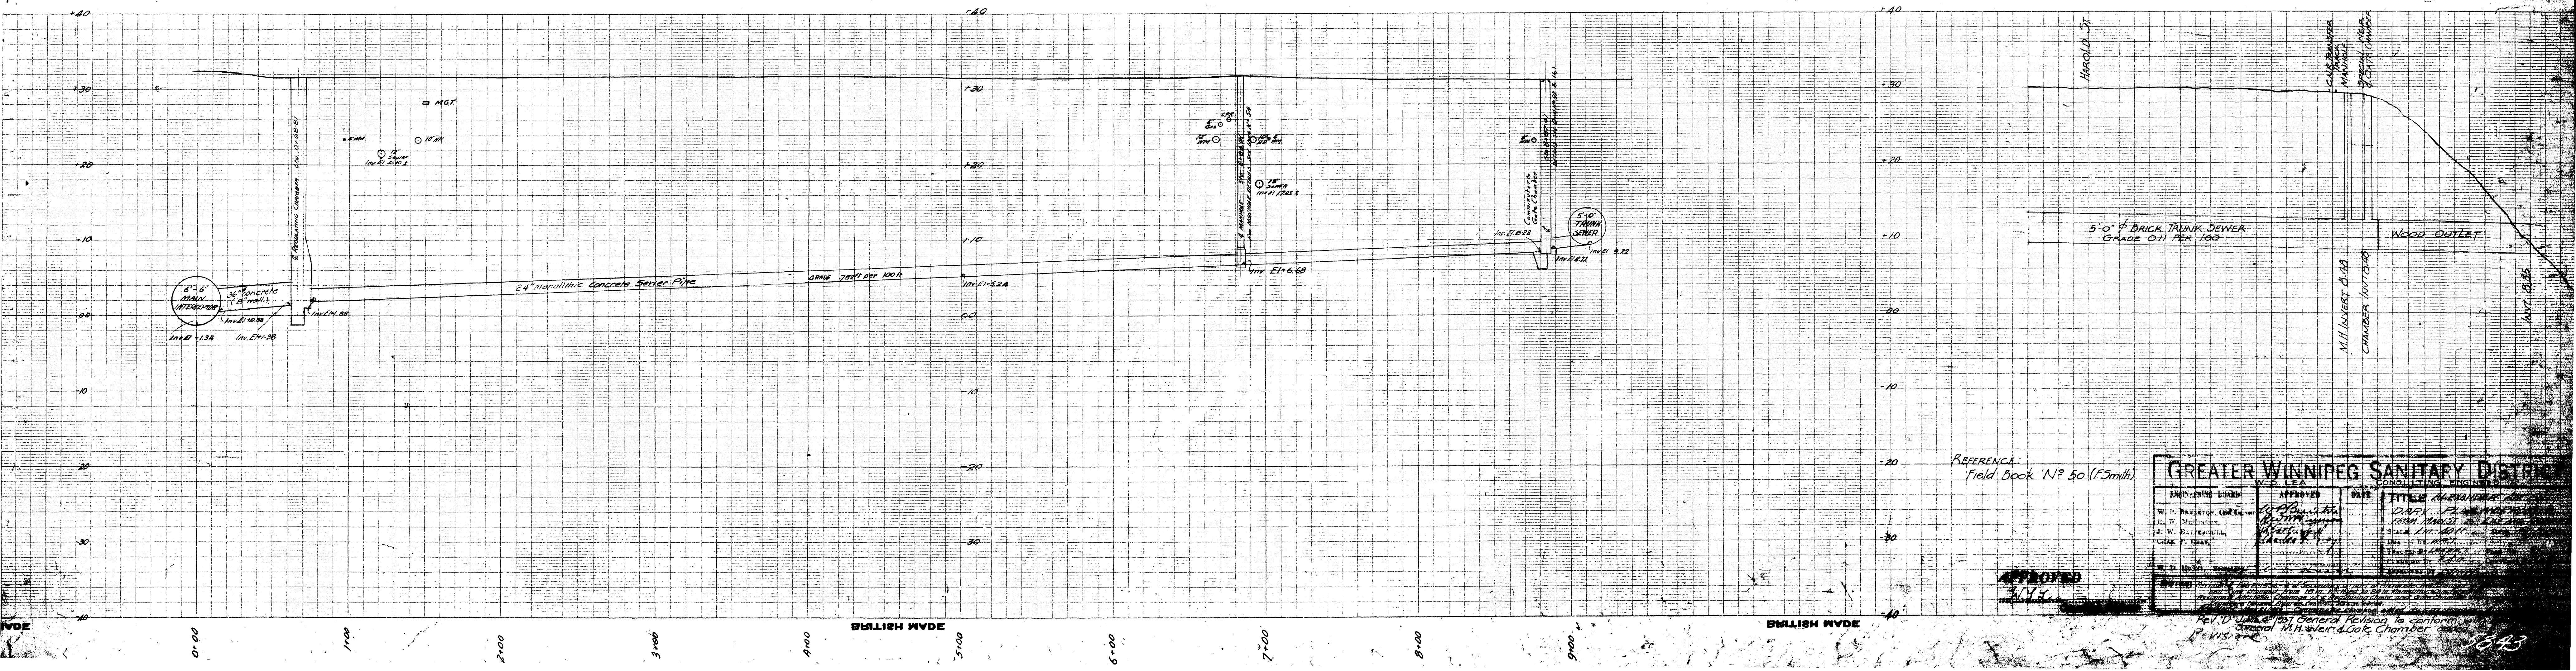


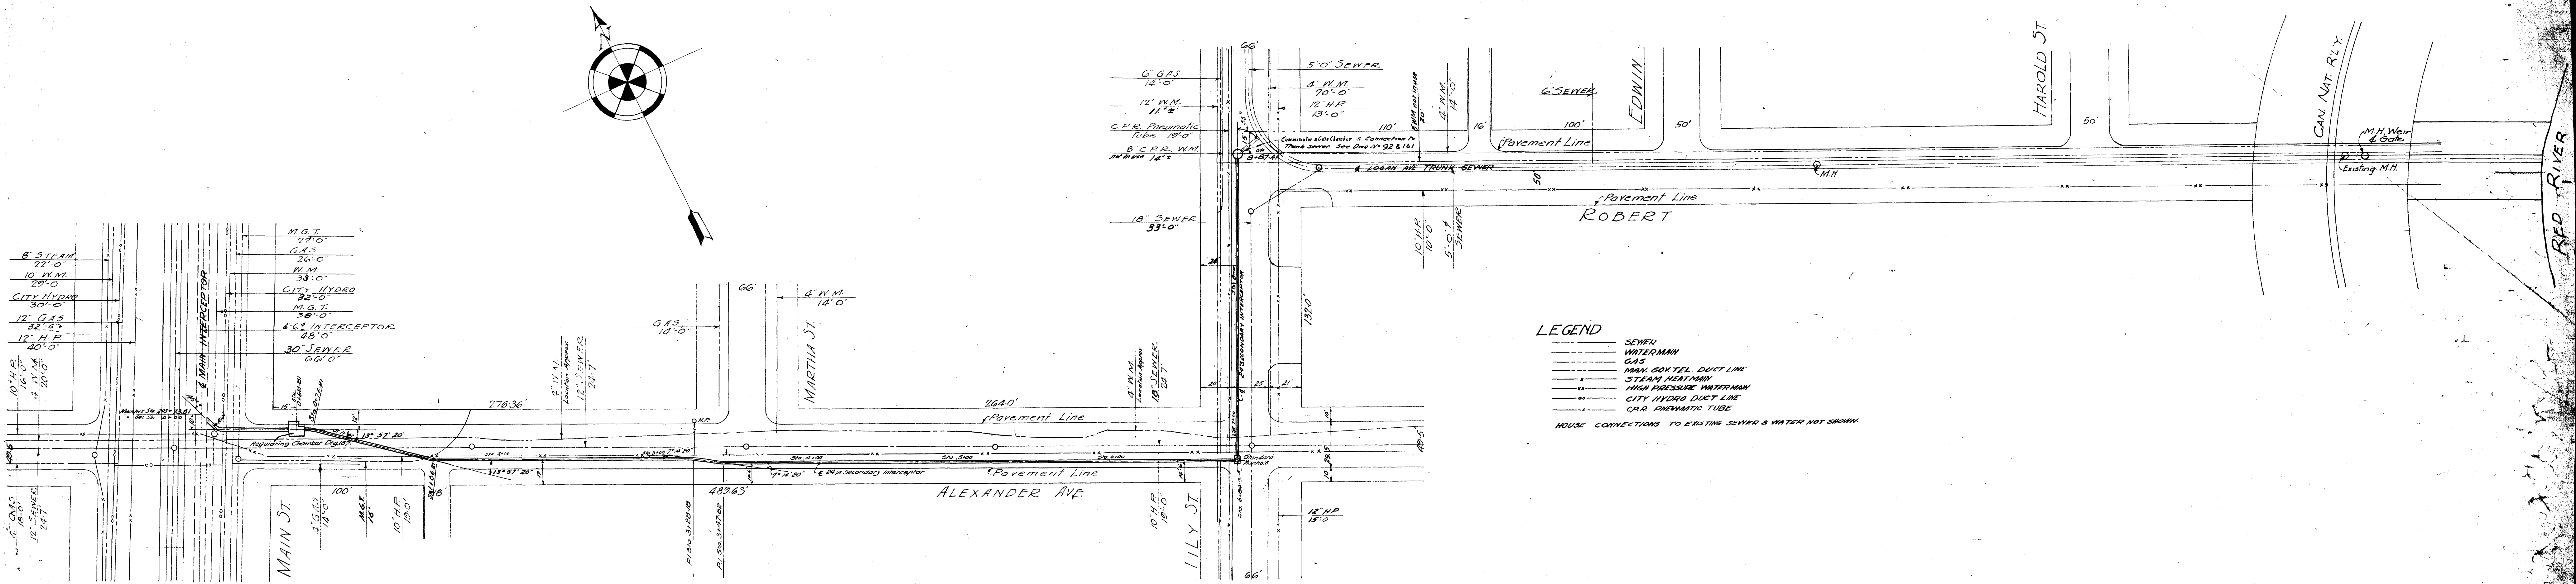

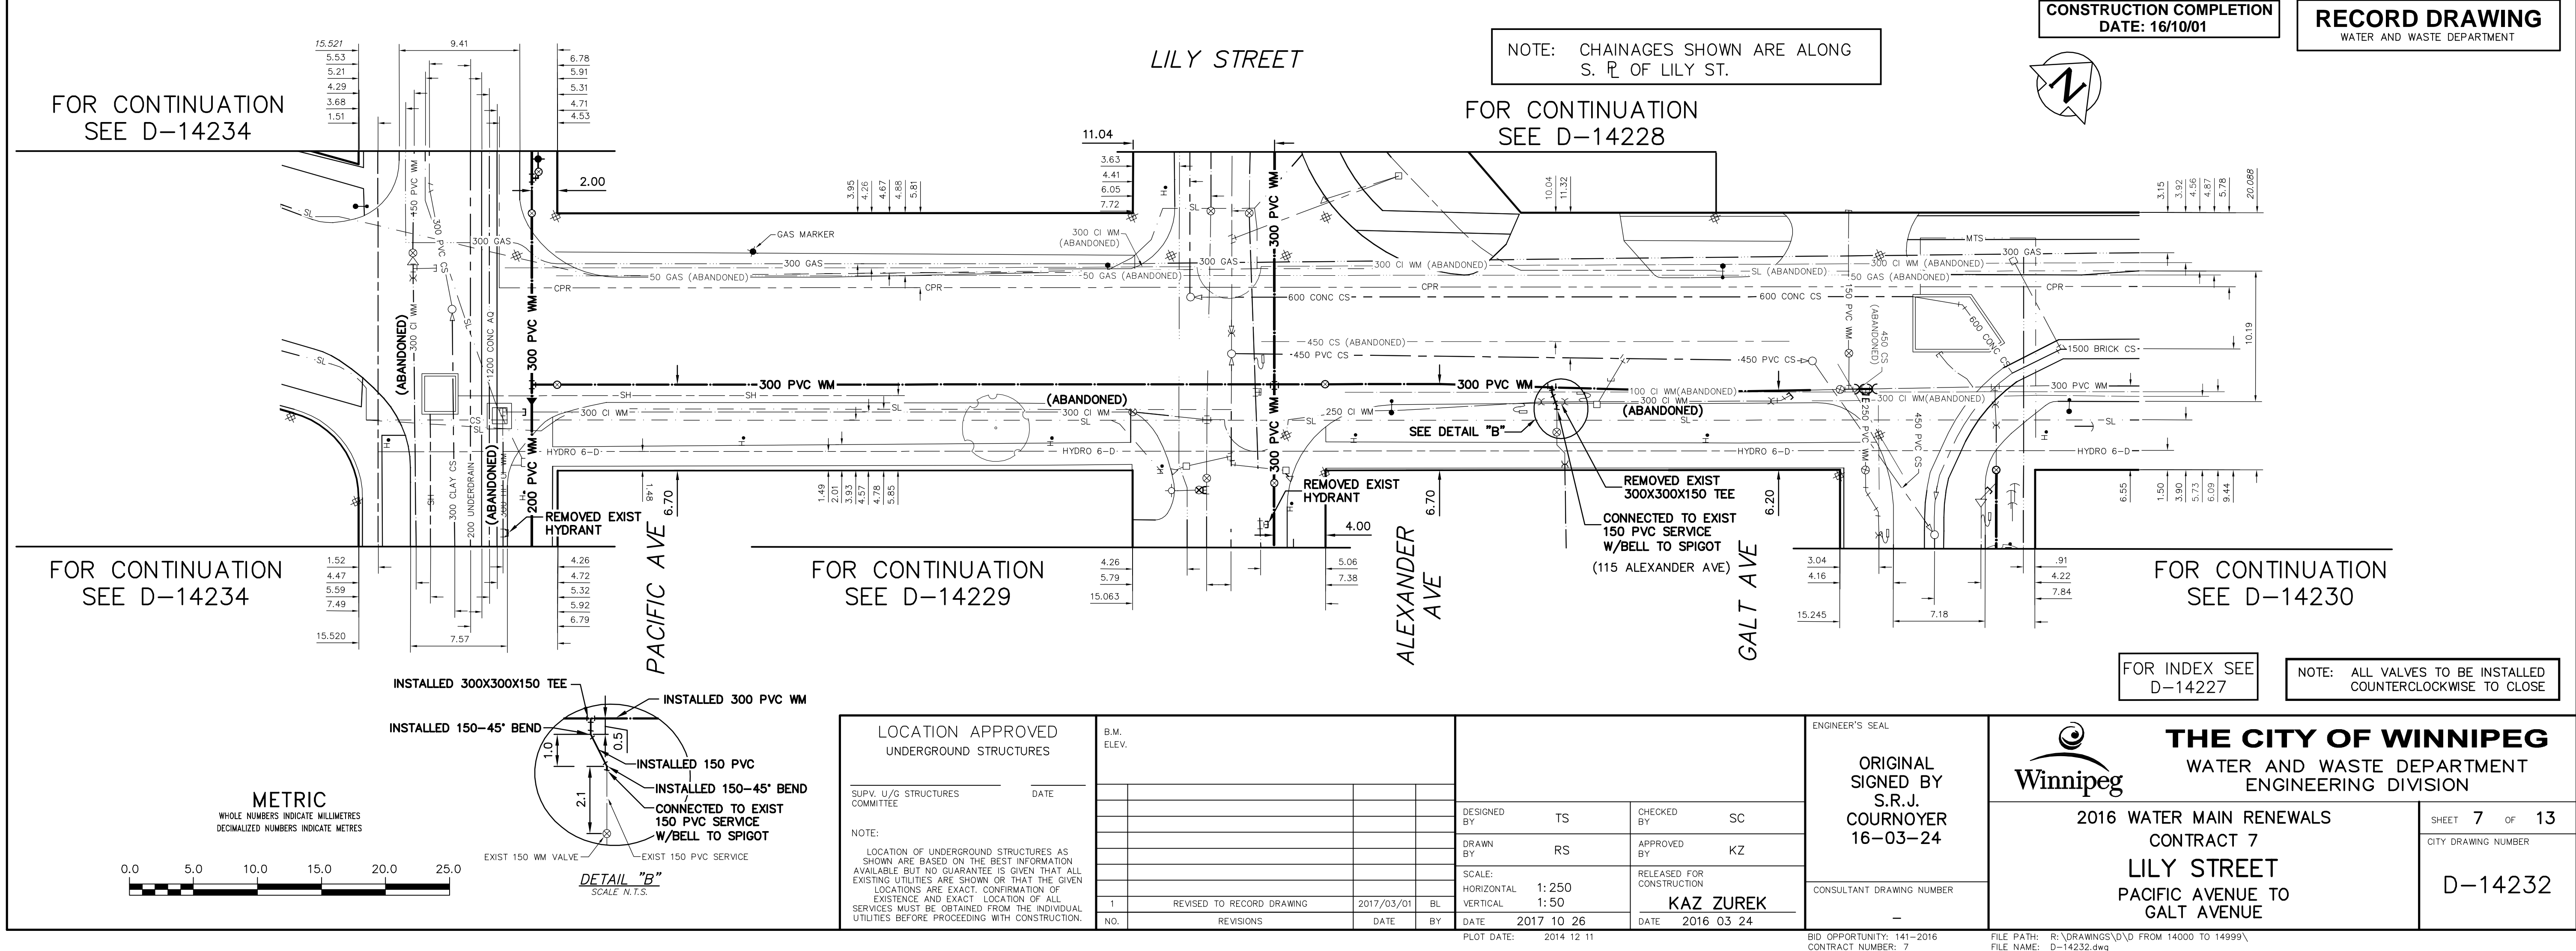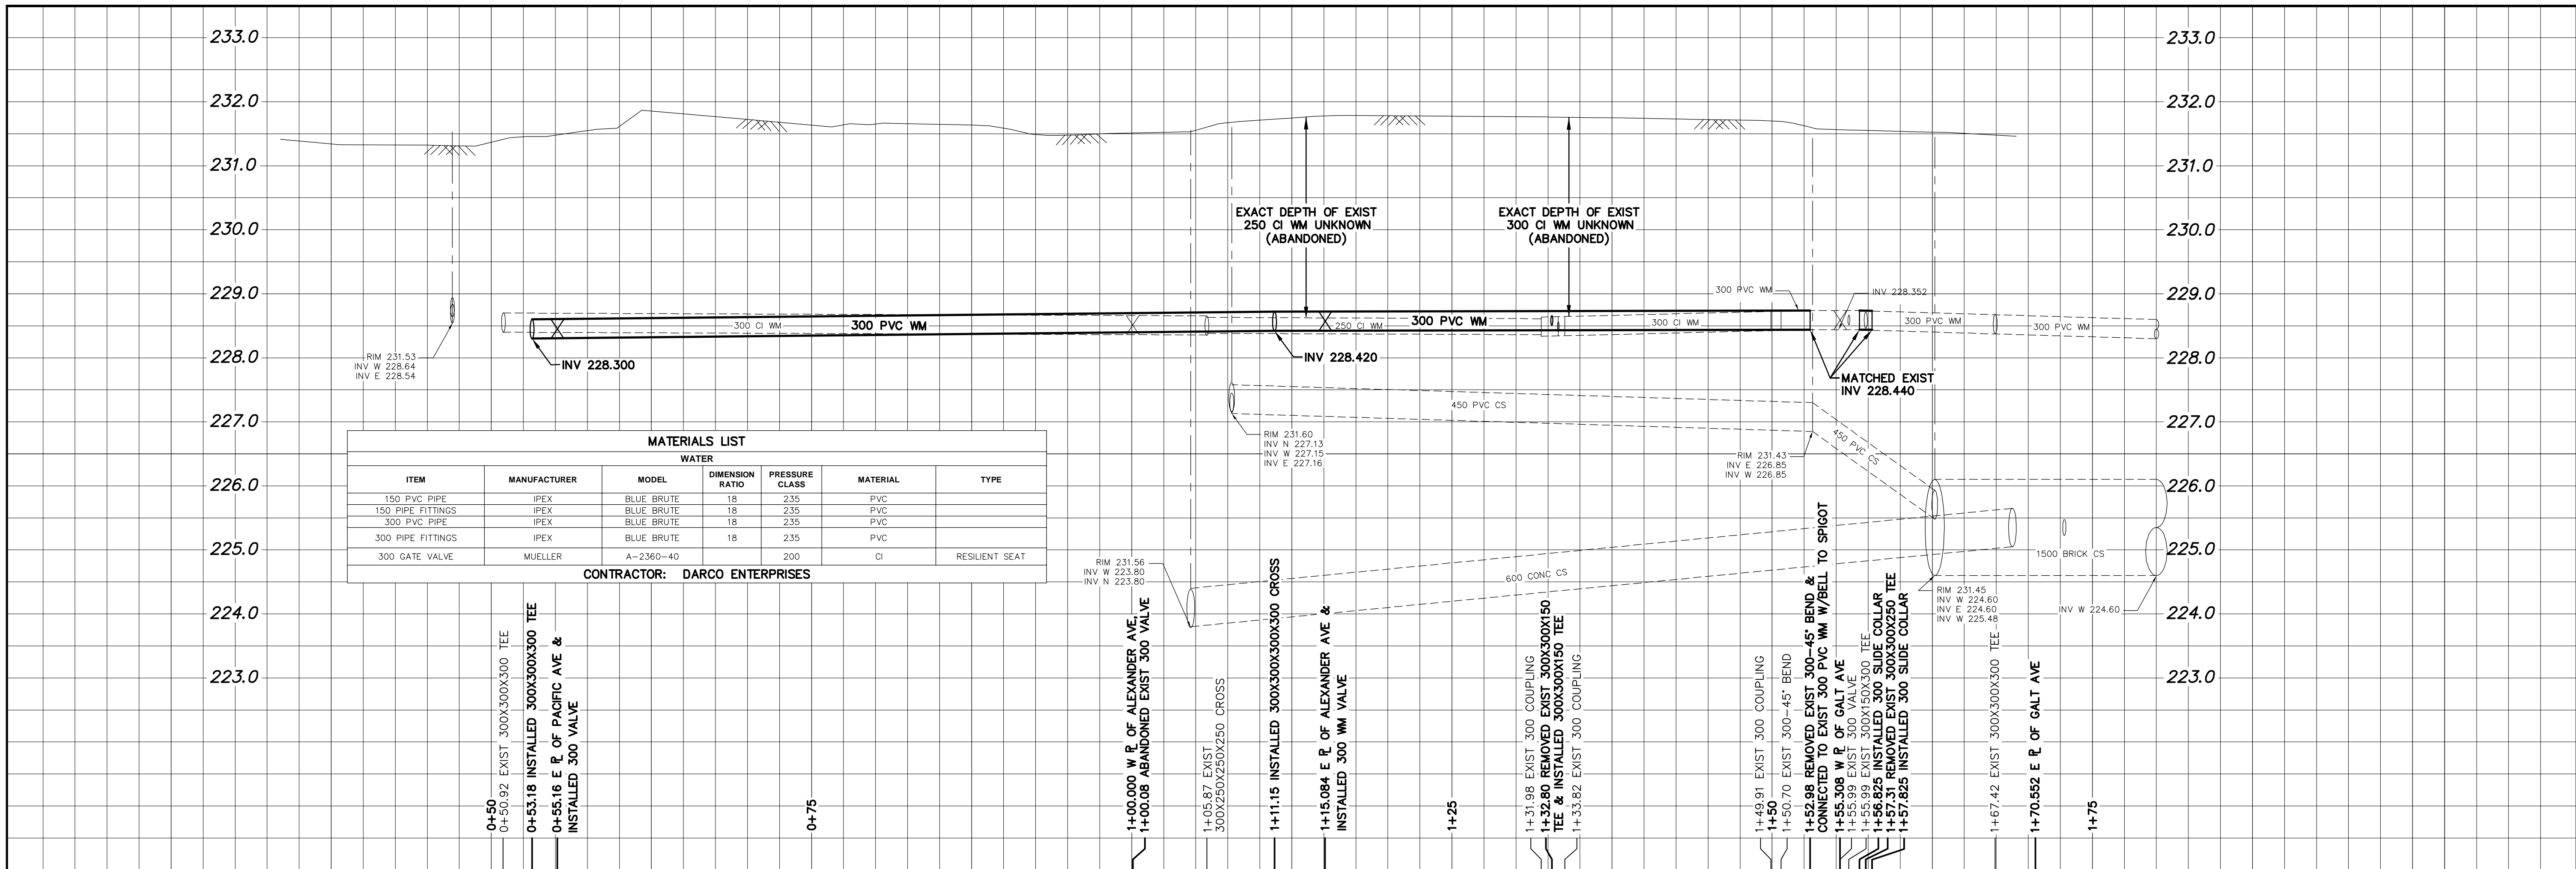


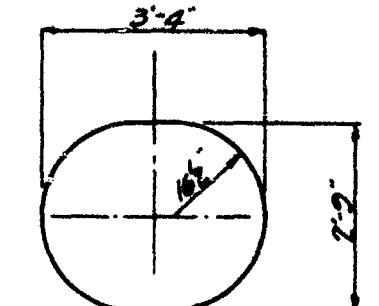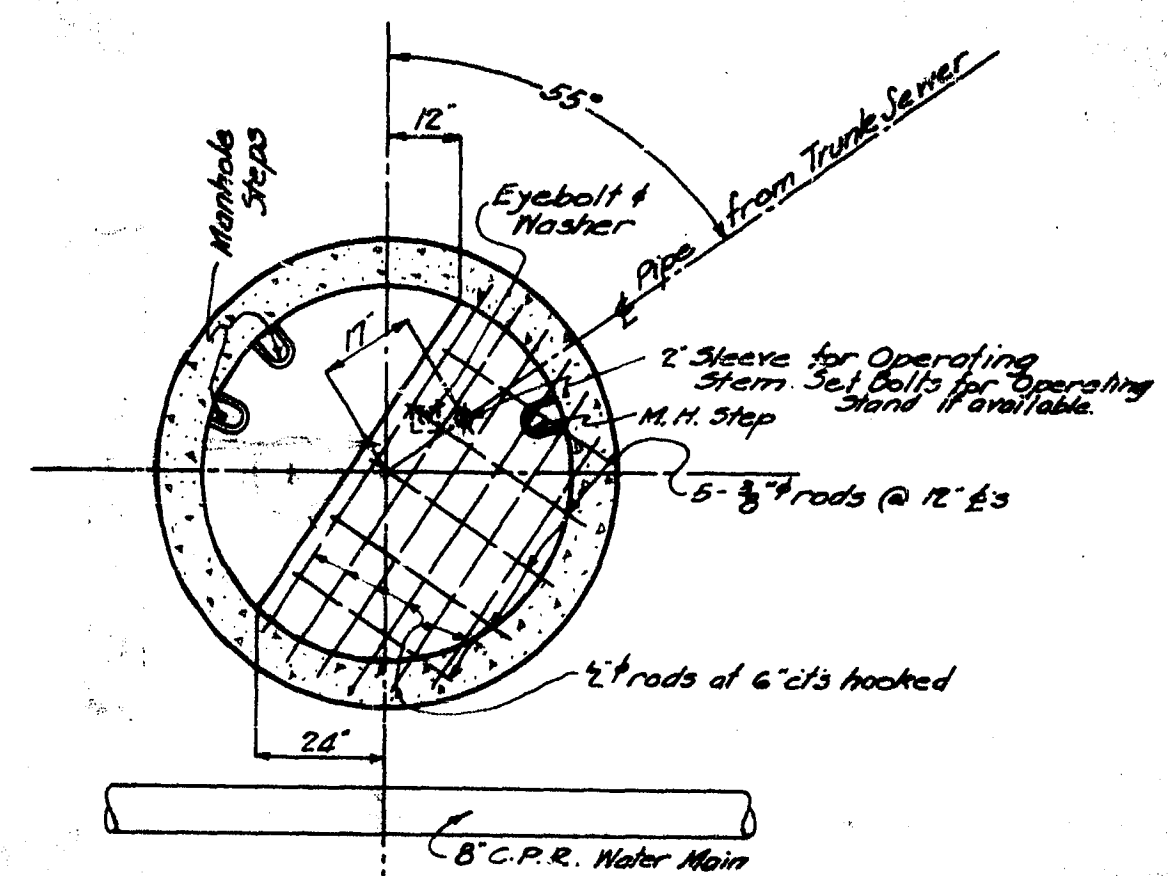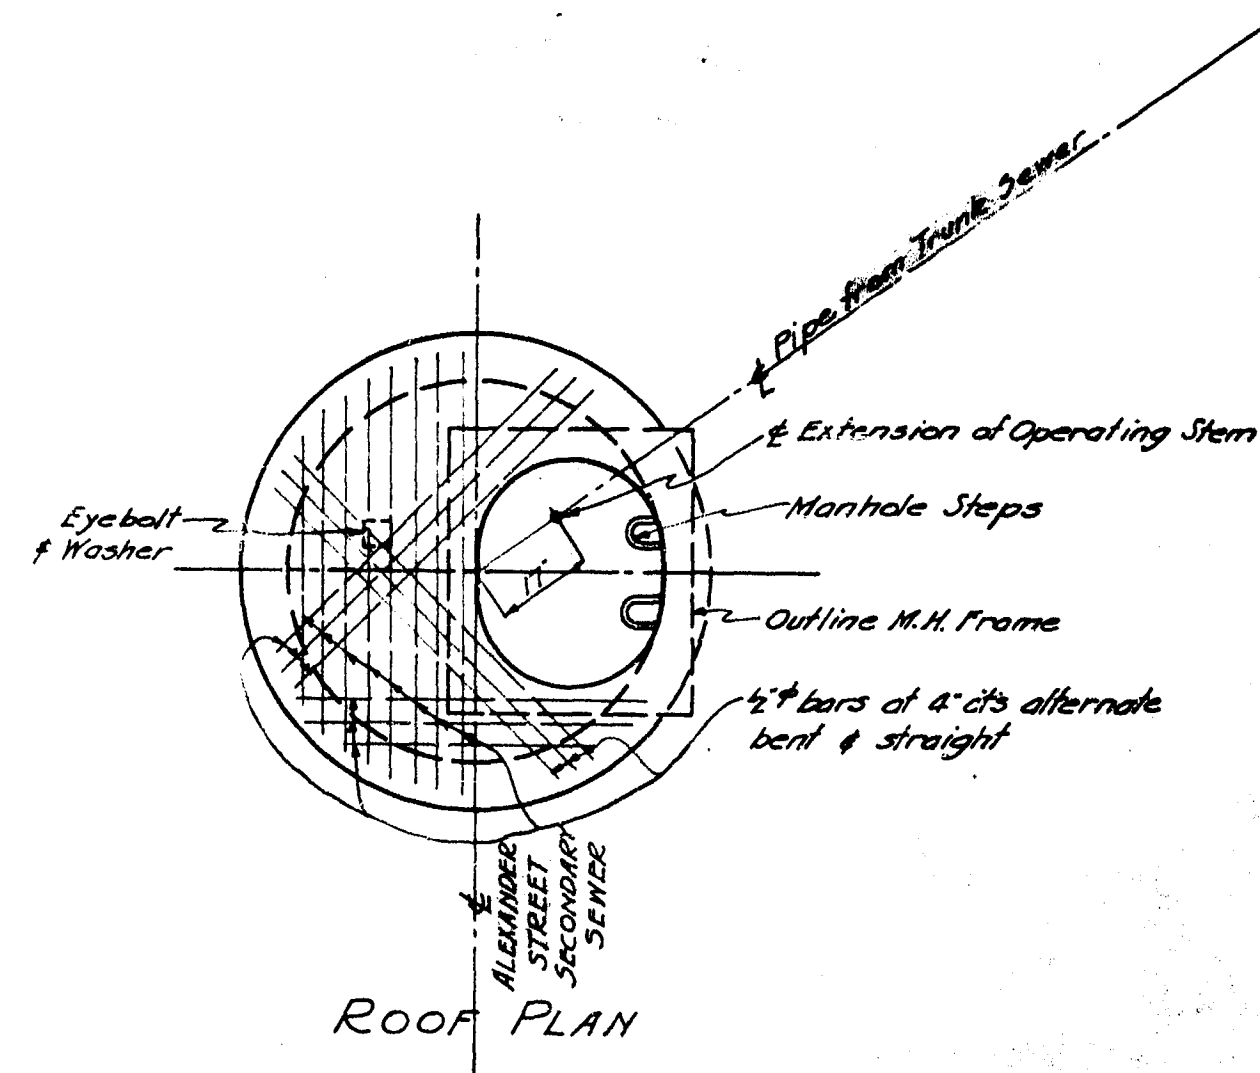

DETAIL OF HOLE FOR MANHOLE FRAME

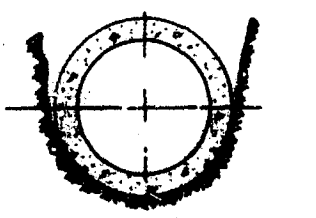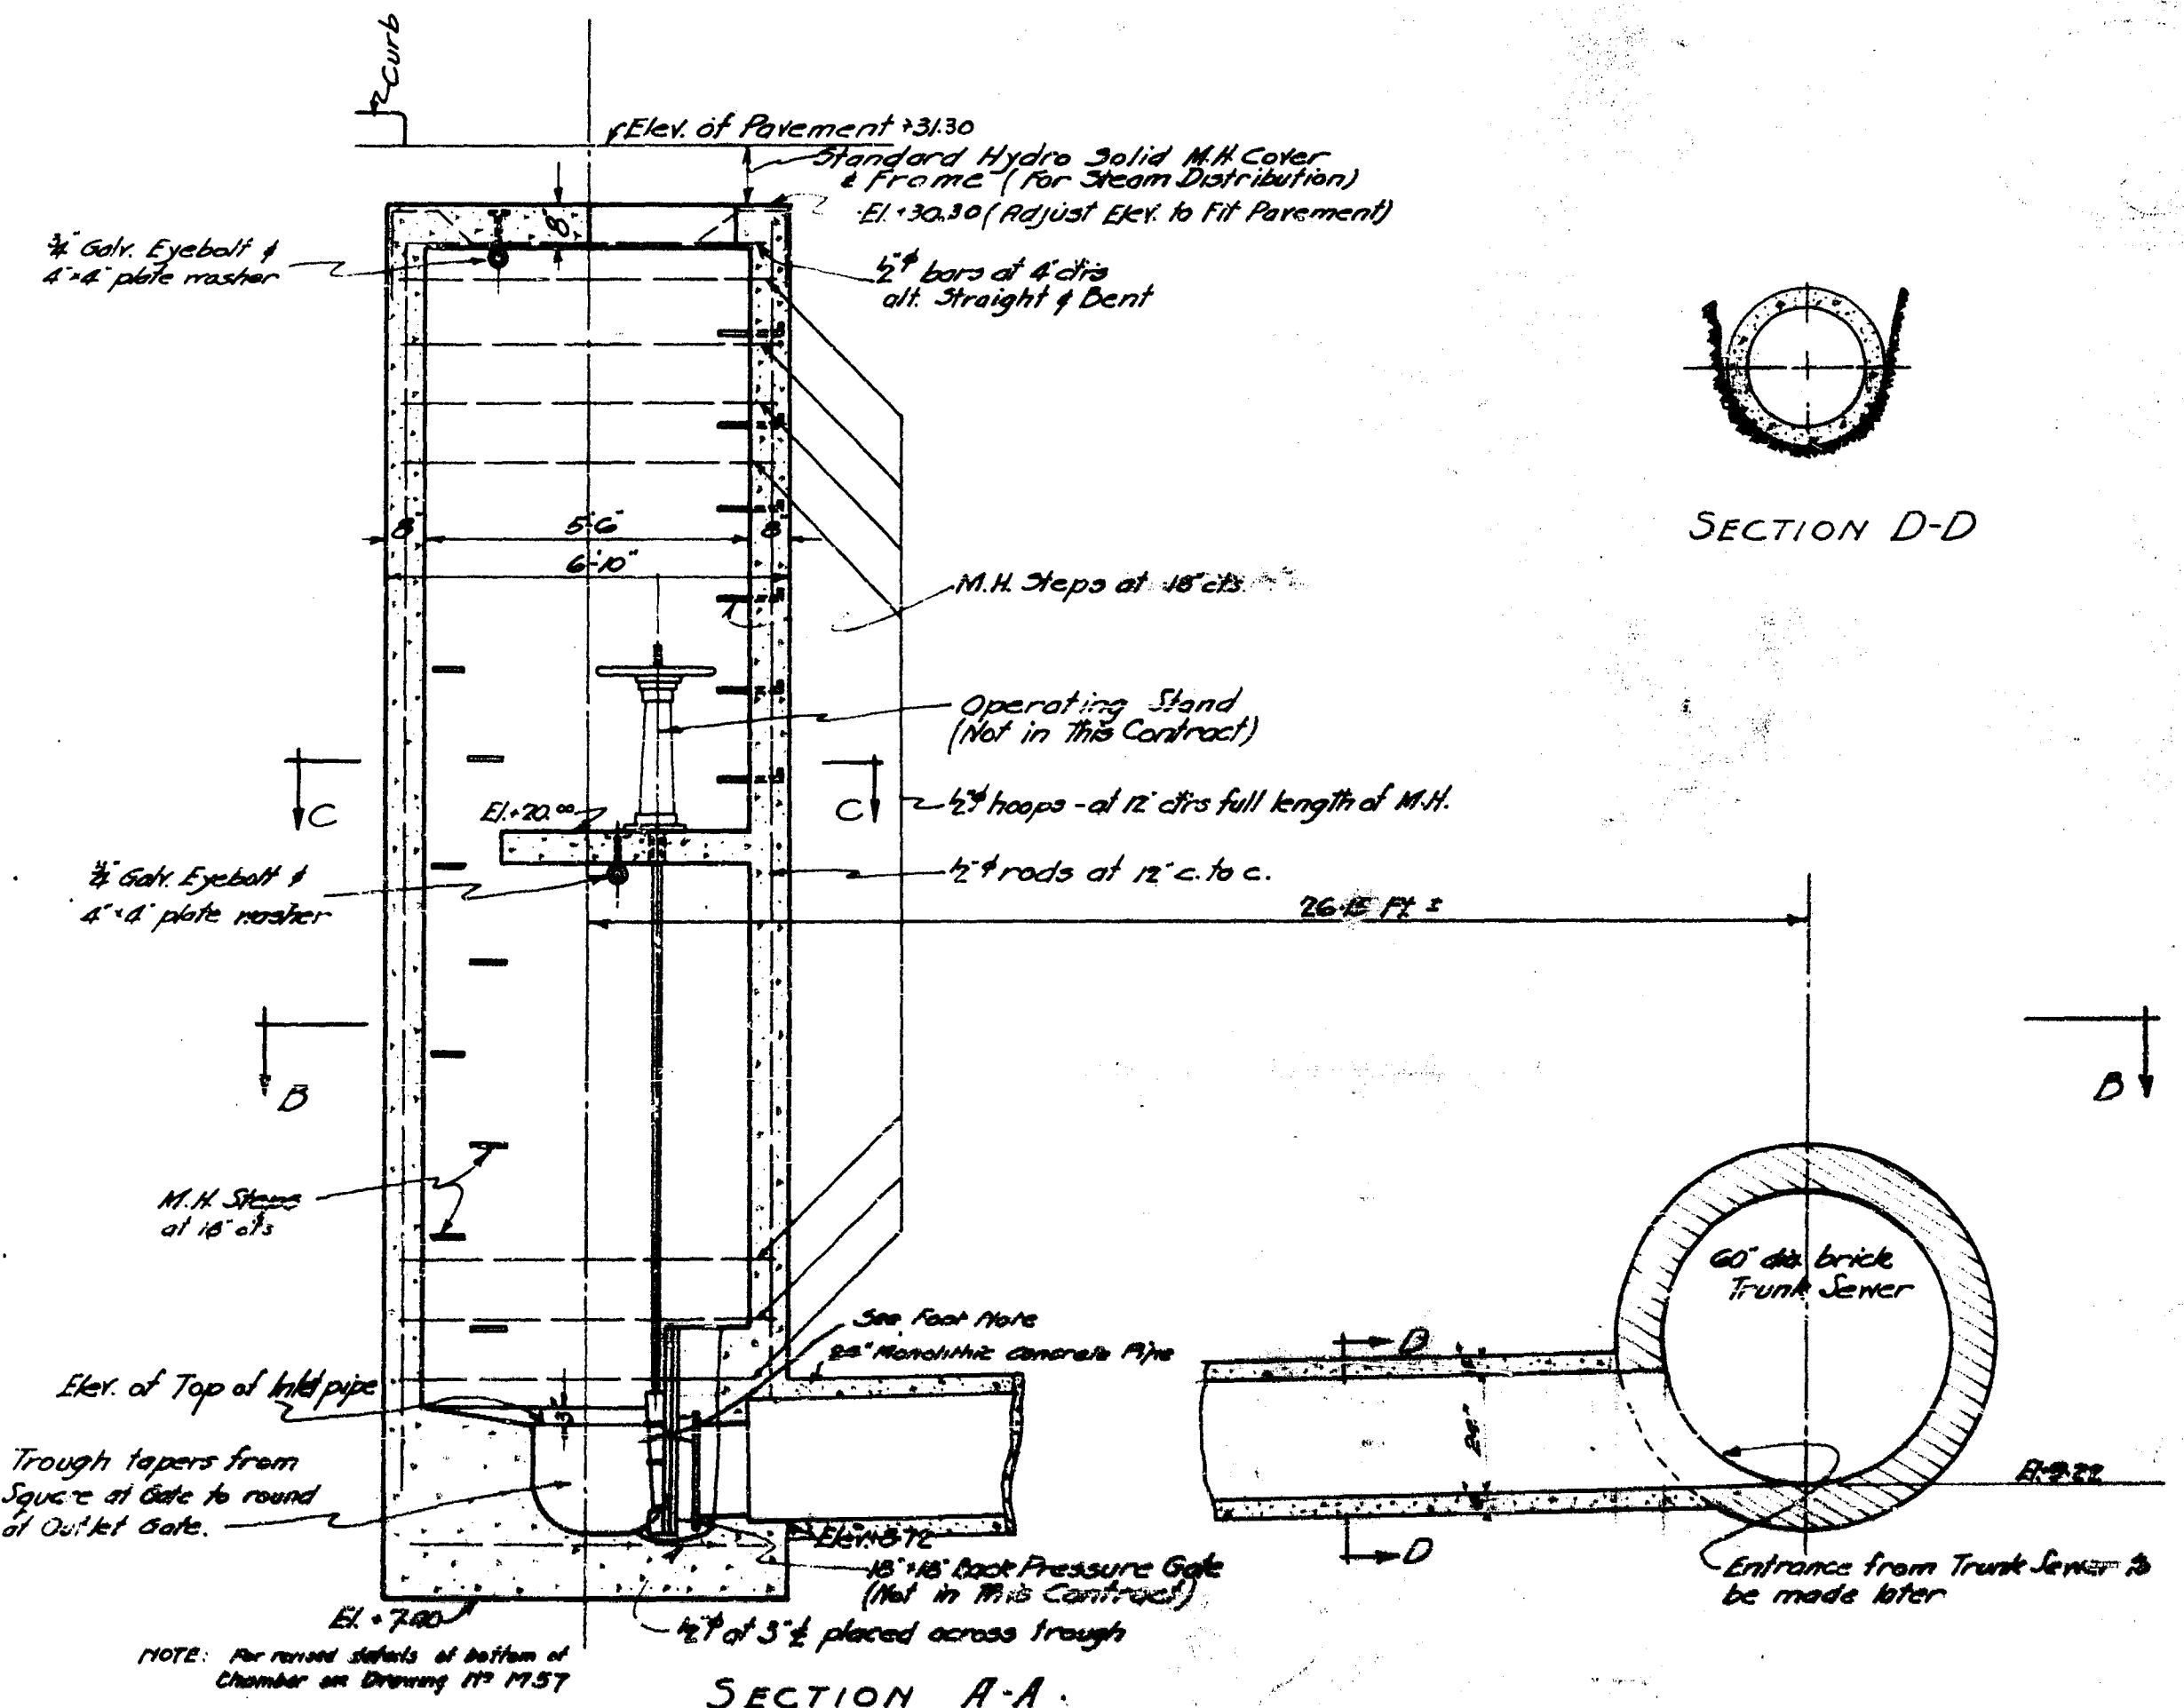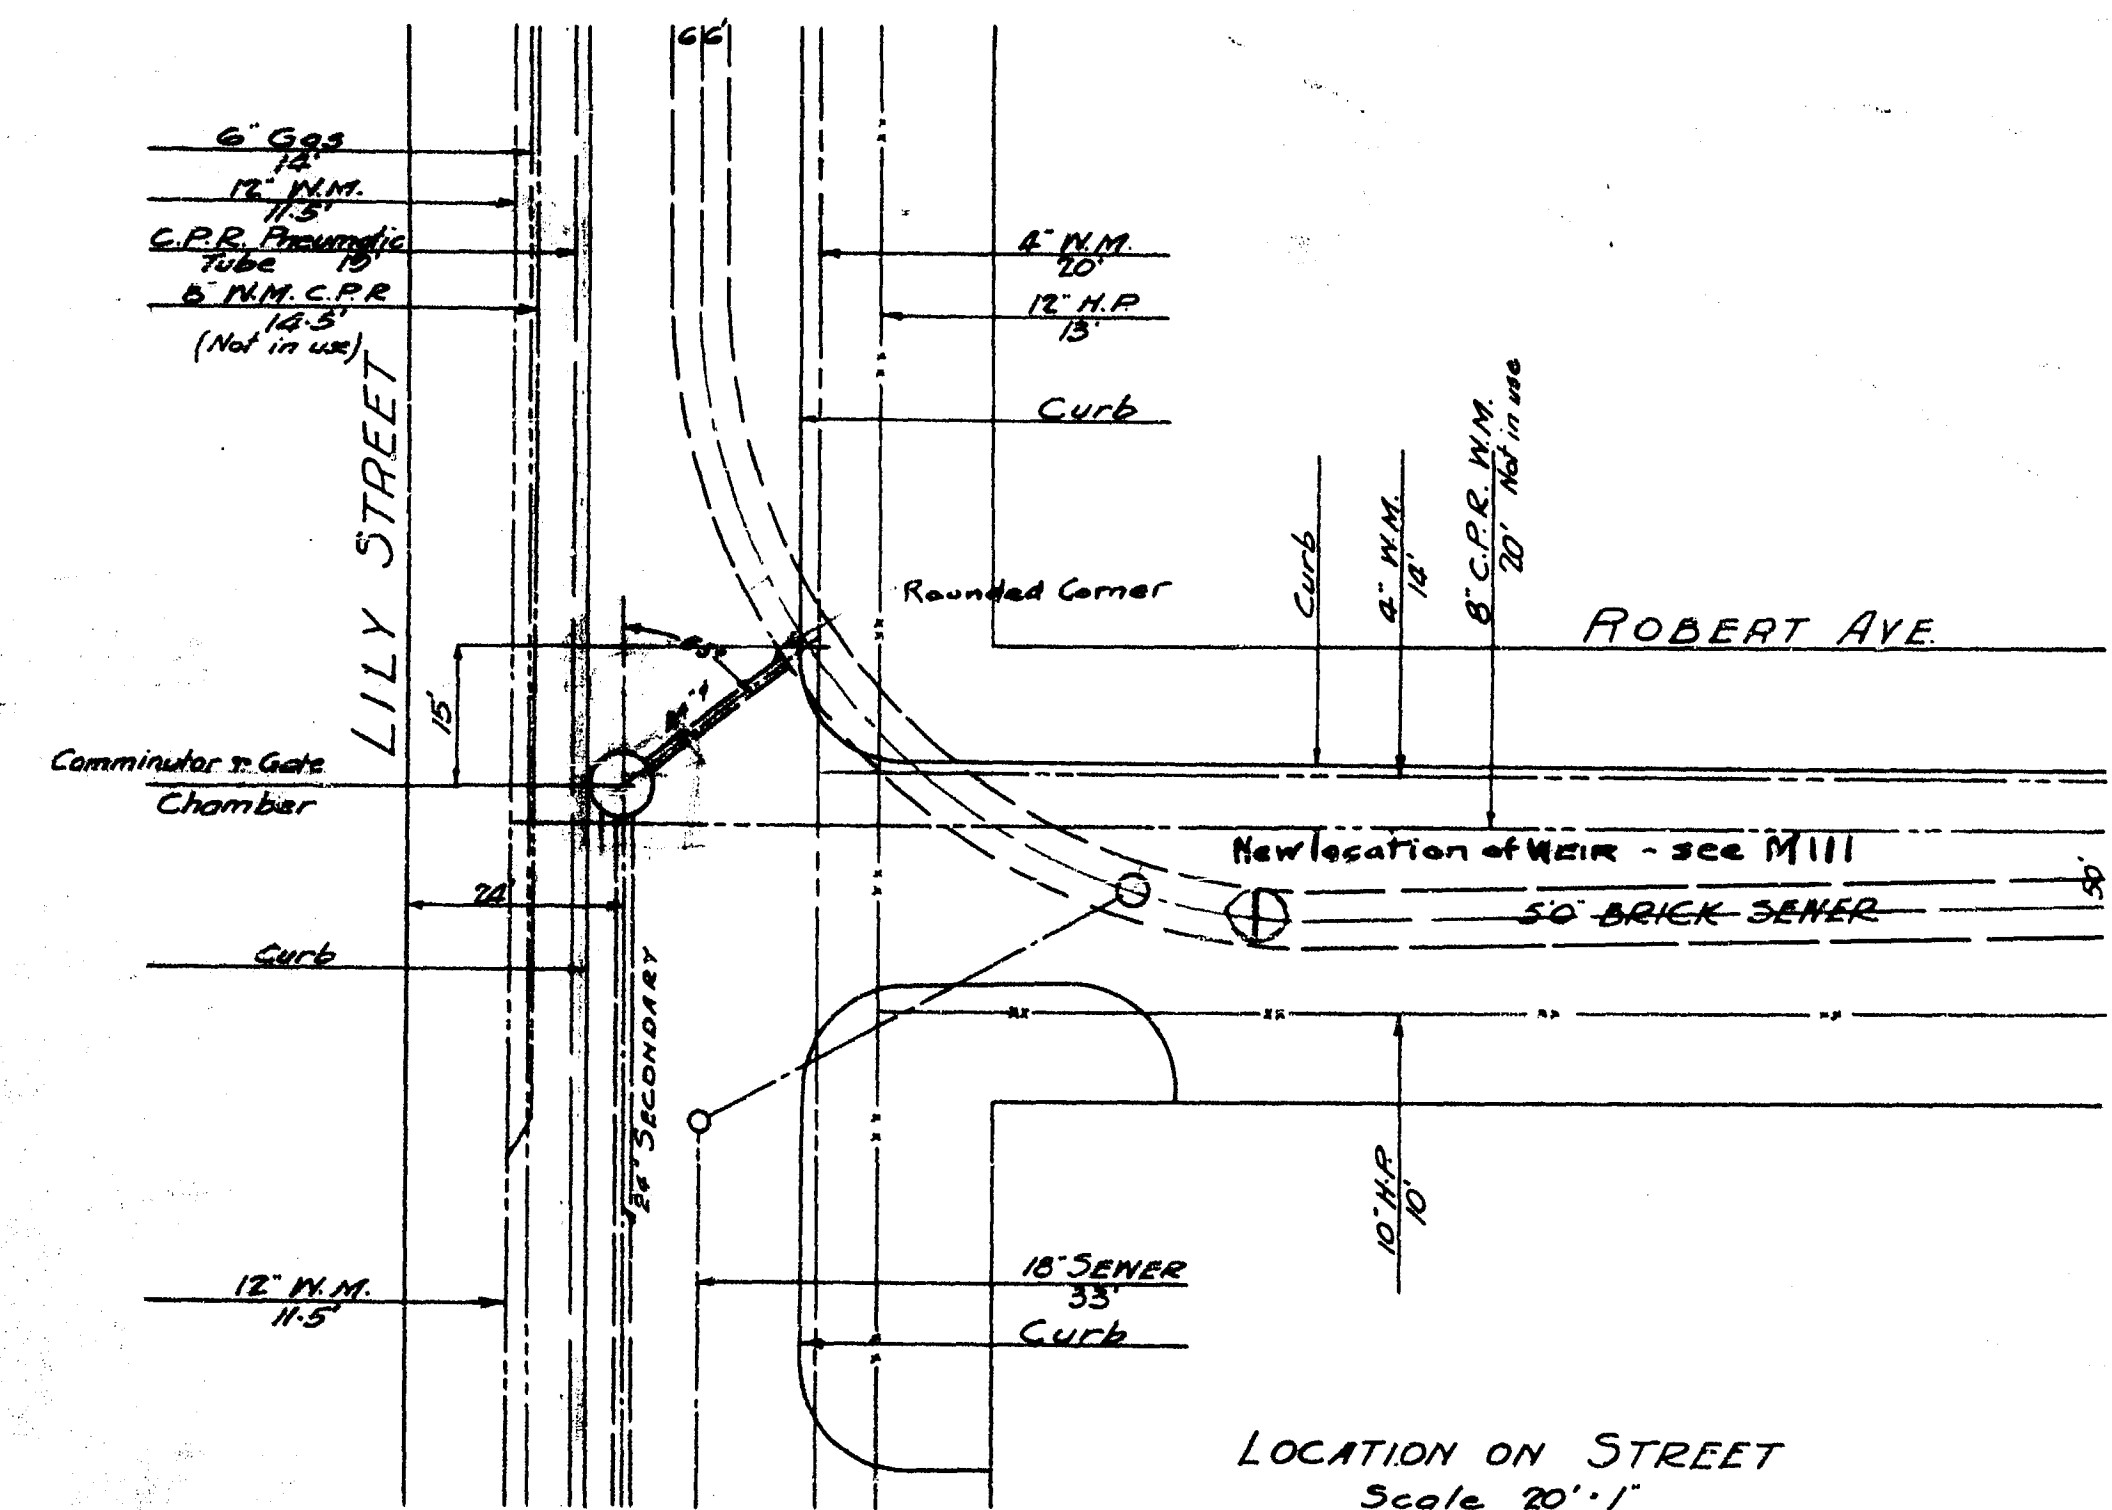

SECTION D-D

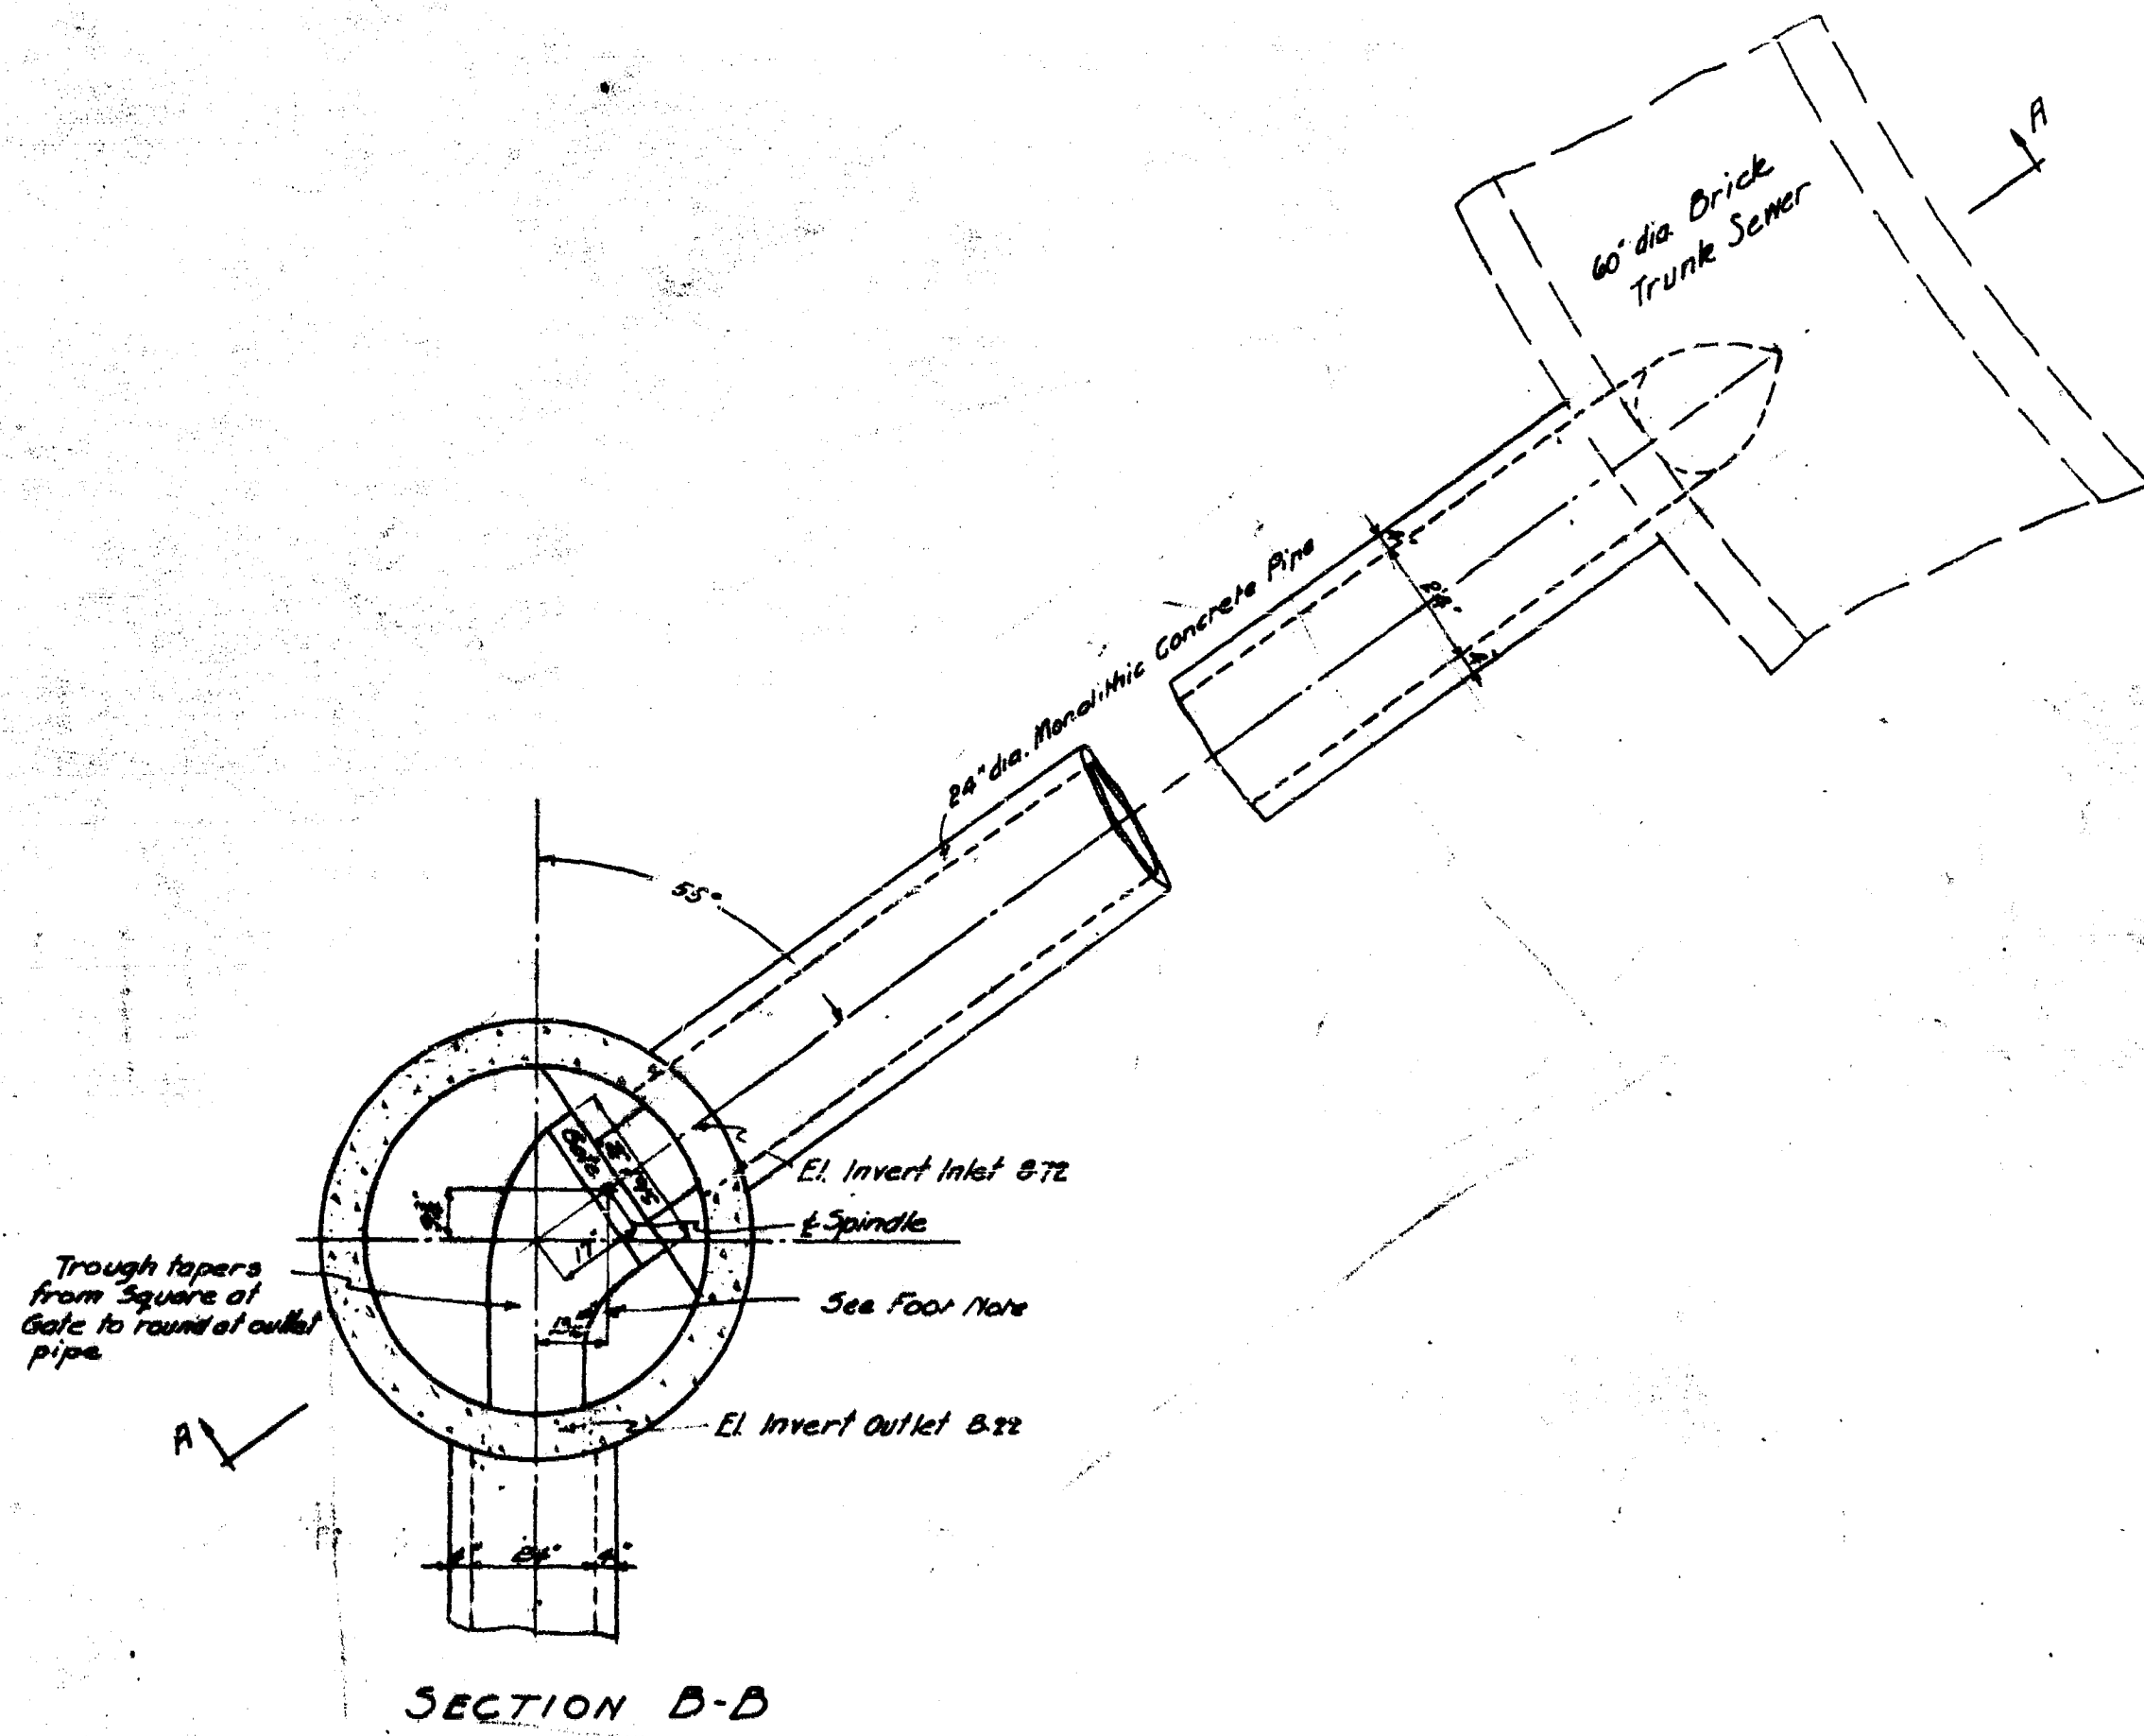

SECTION B-B

Note - For Alterations to this Chamber see Dwg. No. 115.

STATION No. 16

CREATER INREG SANITARY DISTRICT

ALEXANDER AVE

SECONDARY SEWER

DETAILS OF GATE CHAMBER AT LILY STREET




8\"/>

92






1399

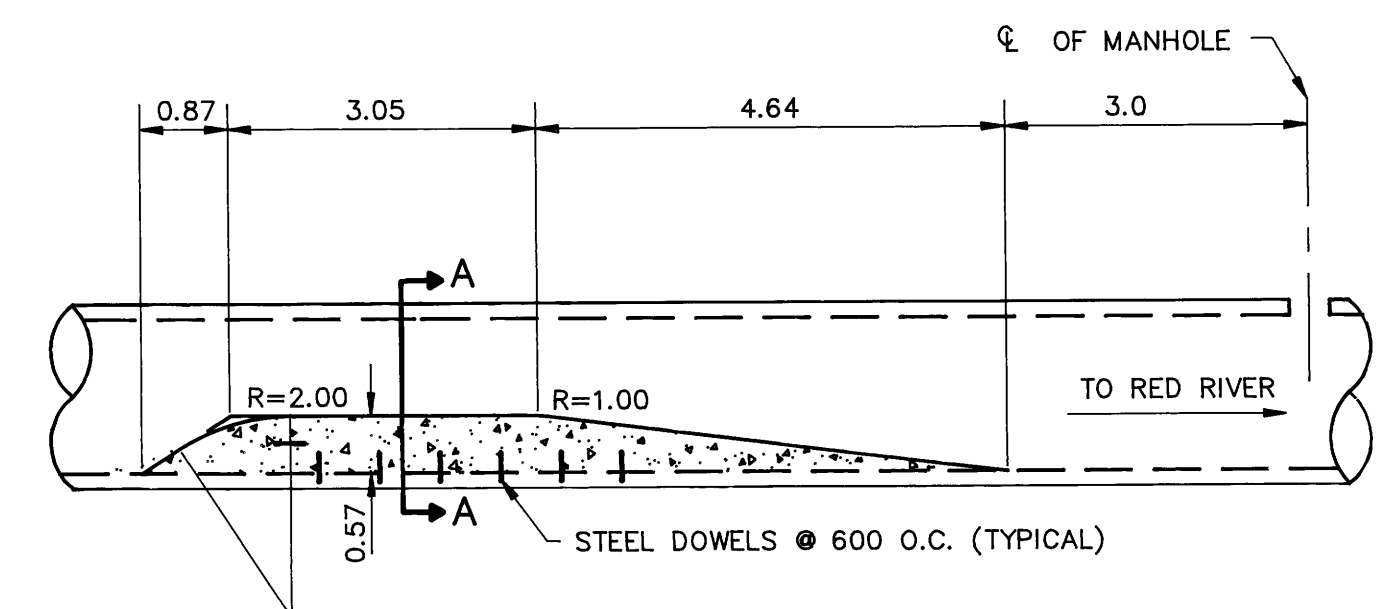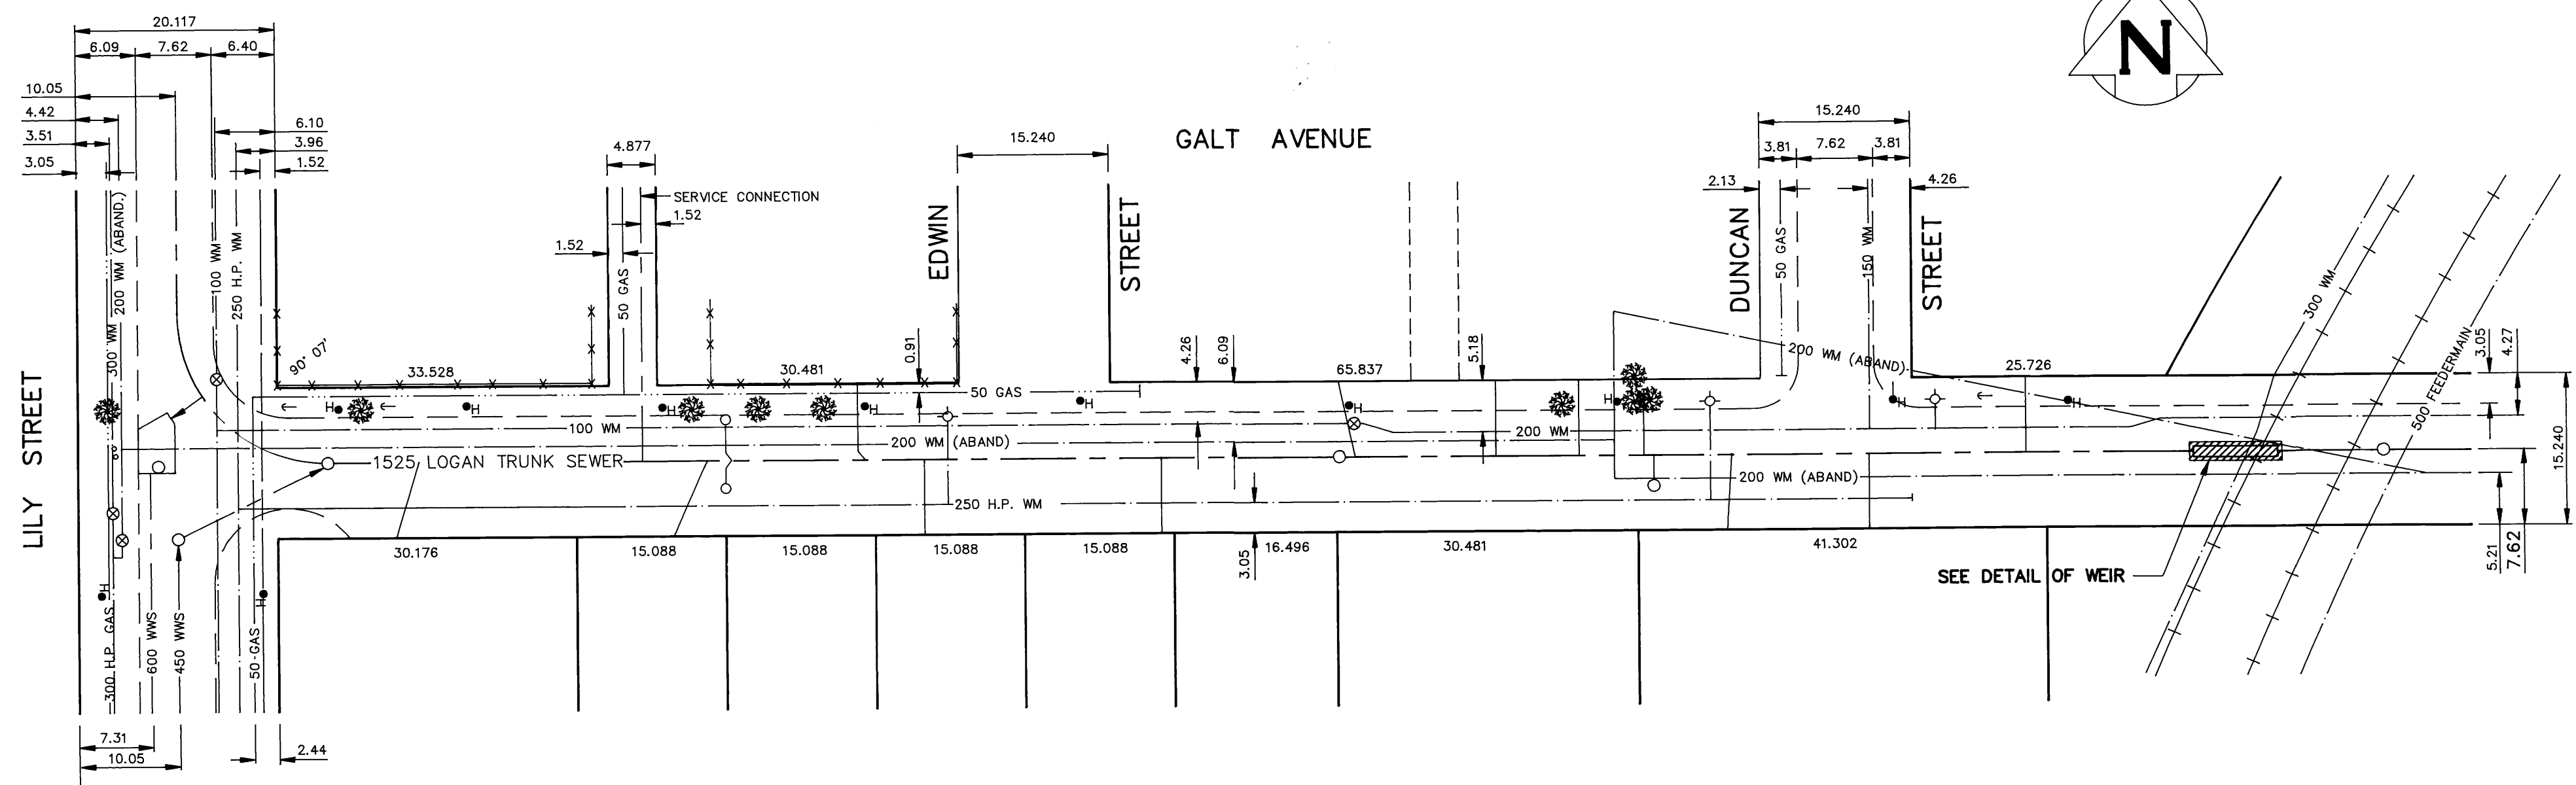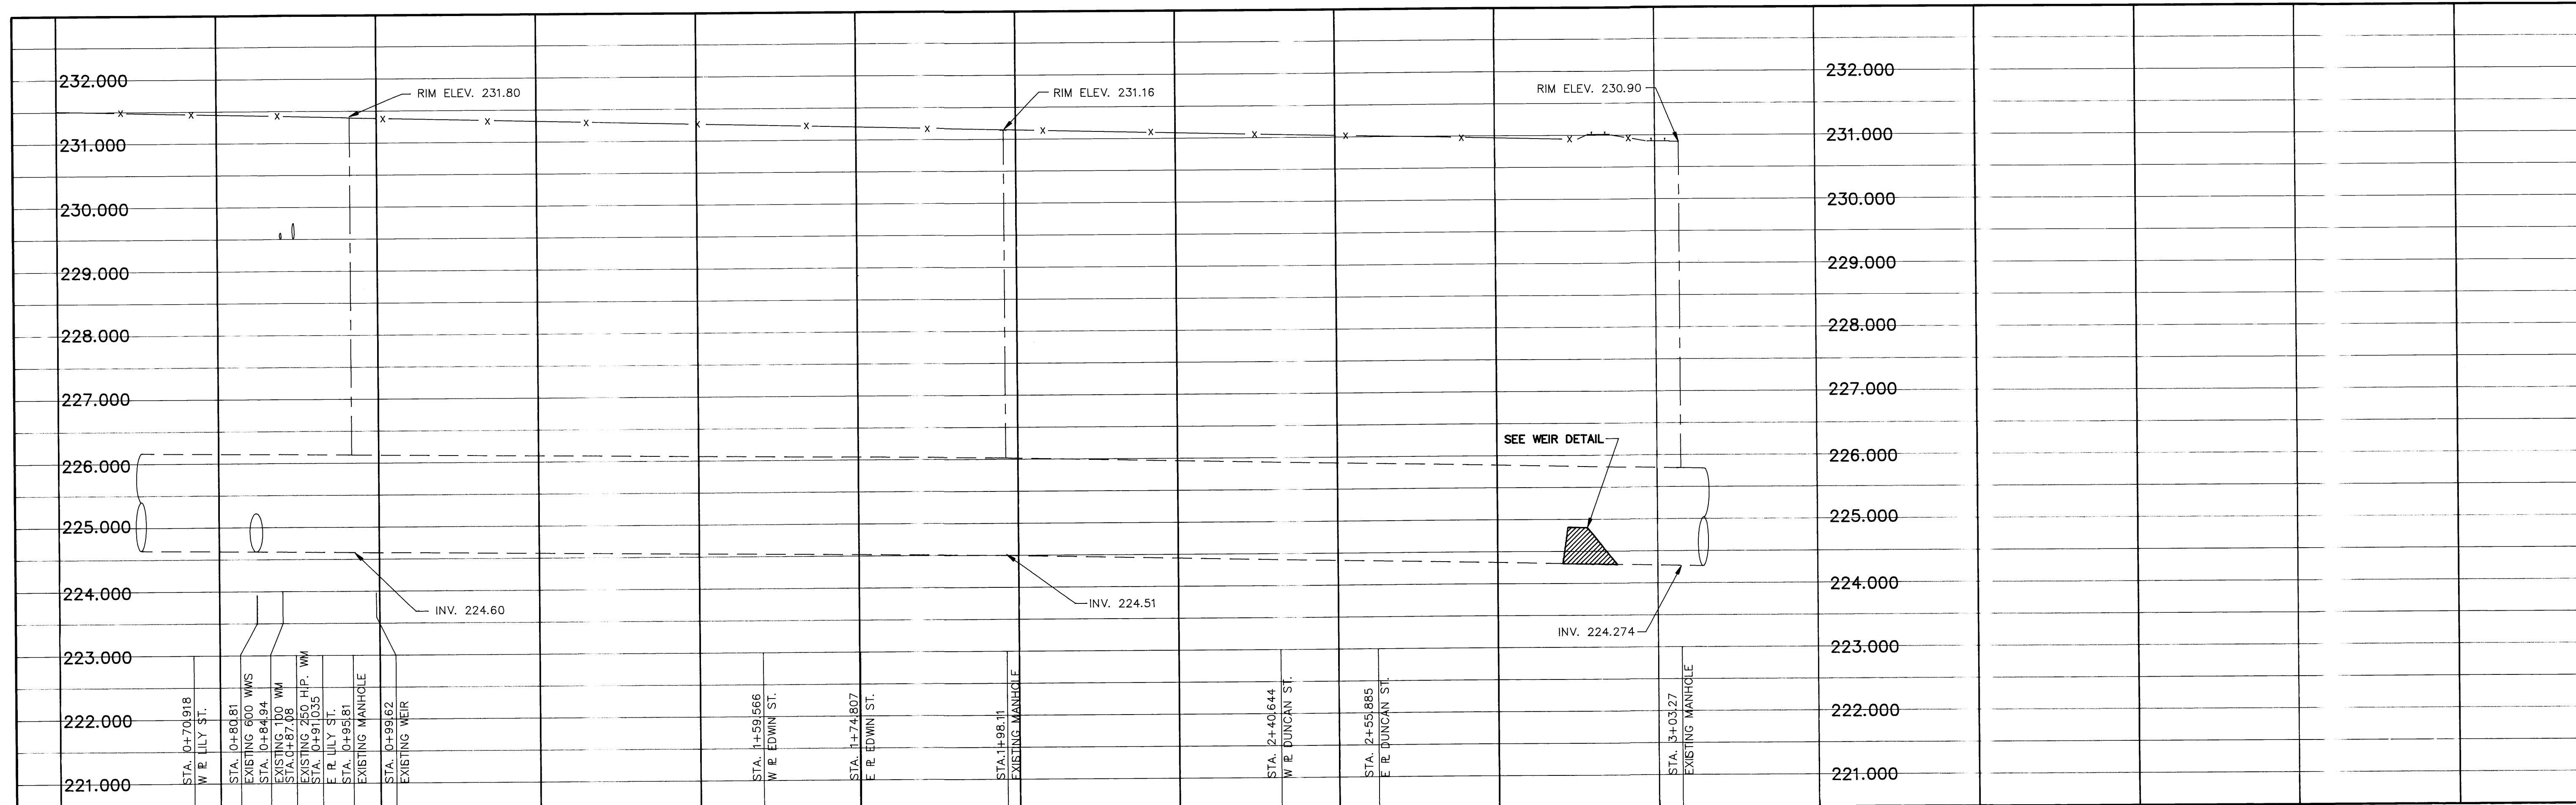

WEIR DETAIL  
SCALE 1 : 75

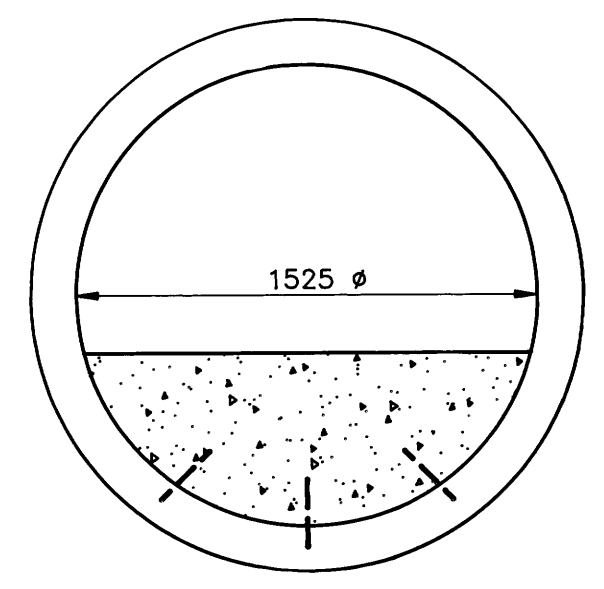

SECTION A-A  
SCALE 1 : 25

**METRIC**  
WHOLE NUMBERS INDICATE MILLIMETRES  
DECIMALIZED NUMBERS INDICATE METRES


**AS-CONSTRUCTED**  
INSPECTION / SURVEY  
TECHNICAL SERVICES  
DATE  
WATERWORKS, WASTE & DISPOSAL DEPARTMENT

EXISTING	LEGEND-PLAN	PROPOSED	EXISTING	LEGEND-PLAN	PROPOSED	EXISTING	LEGEND-PROFILE	PROPOSED
200 WM	WATERMAIN	200 WM	SL, HYDRO	150 WM	WATERMAIN	150 WM		
525 LDS	LAND DRAINAGE SEWER	525 LDS	MTS	300 LDS	LAND DRAINAGE SEWER	300 LDS		
375 WWS	WASTEWATER SEWER	375 WWS	CONCRETE	250 WWS	WASTEWATER SEWER	250 WWS		
MANHOLE		MANHOLE	PROPERTY LINE	250 WWS	WASTEWATER SEWER	250 WWS		
CATCH BASIN		CATCH BASIN	FENCE	250 WWS	WASTEWATER SEWER	250 WWS		
CURB INLET		CURB INLET	POLE - HYDRO, MTS	250 WWS	WASTEWATER SEWER	250 WWS		
JUNCTIONS		JUNCTIONS	RAILWAY SIGN	250 WWS	WASTEWATER SEWER	250 WWS		
CULVERT		CULVERT	GUY ANCHOR	250 WWS	WASTEWATER SEWER	250 WWS		
50 GAS	GAS	50 GAS	LIGHT STANDARD	250 WWS	WASTEWATER SEWER	250 WWS		
50 GAS	GAS	50 GAS	TREE	250 WWS	WASTEWATER SEWER	250 WWS		

**LOCATION APPROVED**  
UNDERGROUND STRUCTURES  
DATE  
NOTE:  
LOCATION OF UNDERGROUND STRUCTURES AS SHOWN ARE BASED ON THE BEST INFORMATION AVAILABLE BUT NO GUARANTEE IS GIVEN THAT ALL EXISTING UTILITIES ARE SHOWN OR THAT THE GIVEN LOCATIONS ARE EXACT. CONFIRMATION OF EXISTENCE AND EXACT LOCATION OF ALL SERVICES MUST BE OBTAINED FROM THE INDIVIDUAL UTILITIES BEFORE PROCEEDING WITH CONSTRUCTION.

NO.	REVISIONS	DATE	BY
1	REVISED TO AS-CONSTRUCTED	93.06.25	TM

DESIGNED BY	C.T.	CHECKED BY	J.E.
DRAWN BY	RF/MTS	APPROVED BY	DWG. ORIGINALLY SIGNED BY R.M. GIRLING, P.ENG.
HOR. SCALE	1 : 500	RELEASED FOR CONSTRUCTION	
VERTICAL	1 : 50	DATE	

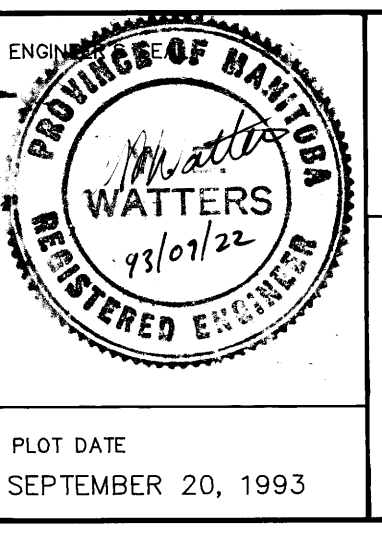

**THE CITY OF WINNIPEG**  
WORKS AND OPERATIONS DIVISION  
WATERWORKS WASTE AND DISPOSAL DEPARTMENT

**GALT AVENUE WASTEWATER SEWER**  
INSTALLATION OF WEIR  
AT STA. 2 + 88

SHEET 1399 OF CITY DRAWING NUMBER

FILE # SS10012