

# THE CITY OF WINNIPEG

## PUBLIC WORKS DEPARTMENT ENGINEERING DIVISION

### MIDTOWN BRIDGE MAINTENANCE REPAIRS AND RELATED WORKS

BID OPPORTUNITY No. 329-2025 ISSUED FOR TENDER, MAY 13, 2025






### **DRAWING LIST**

	CITY	
SHEET No.	DRAWING No.	DRAWING TITLE
1	B114-25-01	COVER SHEET AND DRAWING LIST
2	B114-25-02	DESIGN DATA AND GENERAL NOTES
3	B114-25-03	PROPOSED GENERAL ARRANGEMENT PLAN,
		ELEVATION AND RIVER SPAN CROSS-SECTION
4	B114-25-04	BEARING REPAIR DETAILS
5	B114-25-05	GIRDER REPAIR DETAILS (SHEET 1 OF 2)
$\triangle$ $\sim$ 6	B114-25-06	GIRDER REPAIR DETAILS (SHEET 2 OF 2)
<del>-</del> <del>-</del> <del>-</del> <del>-</del> <del>-</del> <del>-</del> <del>-</del> - <del>-</del>	<del>D114-25-07</del>	PIER 3 AND SOUTH ABUTMENT JACKING LOCATIONS
DRAWING REMOVED	B114-25-08	TÈMPORARY TRAFFIC SIGNAGE (SHEET 1 OF 2)
9	B114-25-09	TEMPORARY TRAFFIC SIGNAGE (SHEET 2 OF 2)

### REFERENCE DRAWING LIST

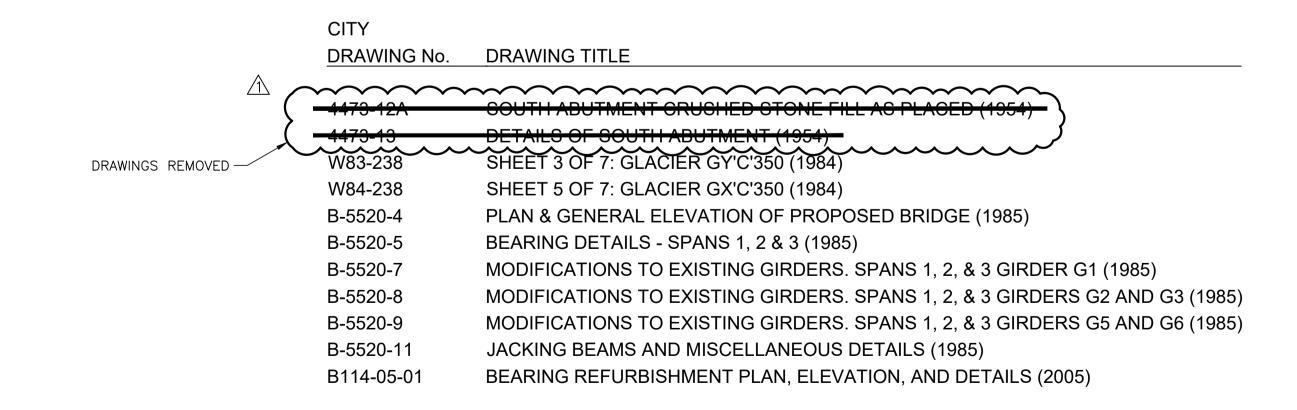



WSP Canada Inc. 1600 Buffalo Place Winnipeg MB R3T 6B8 T+ 1 204-477-6650 www.wsp.com

**RELEASED FOR CONSTRUCTION BY:** 

M. MADY, Ph.D., P.ENG. **CITY OF WINNIPEG BRIDGE PLANNING & OPERATIONS ENGINEER** 

25.05.13

CITY DRAWING No. B114-25-01

DATE

25.05.13