


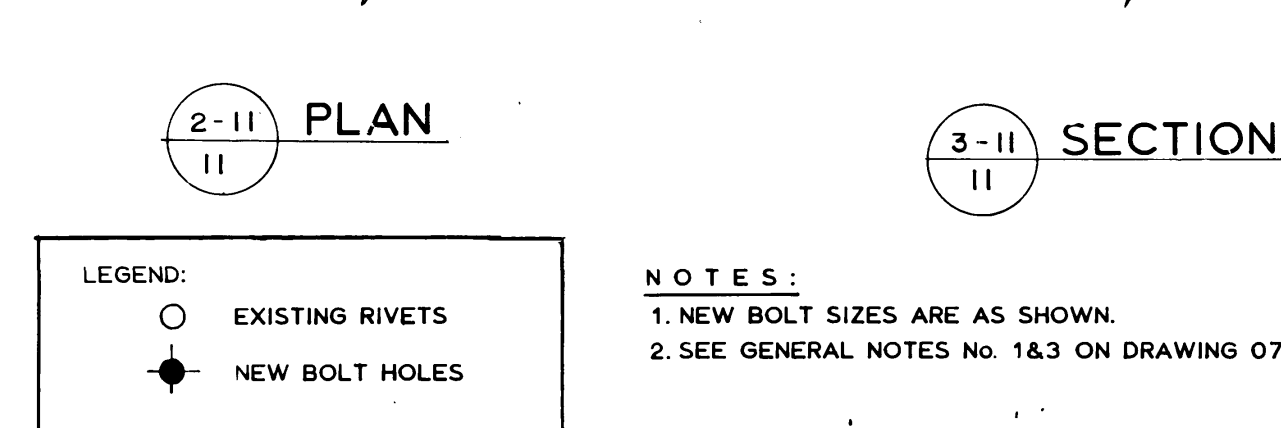
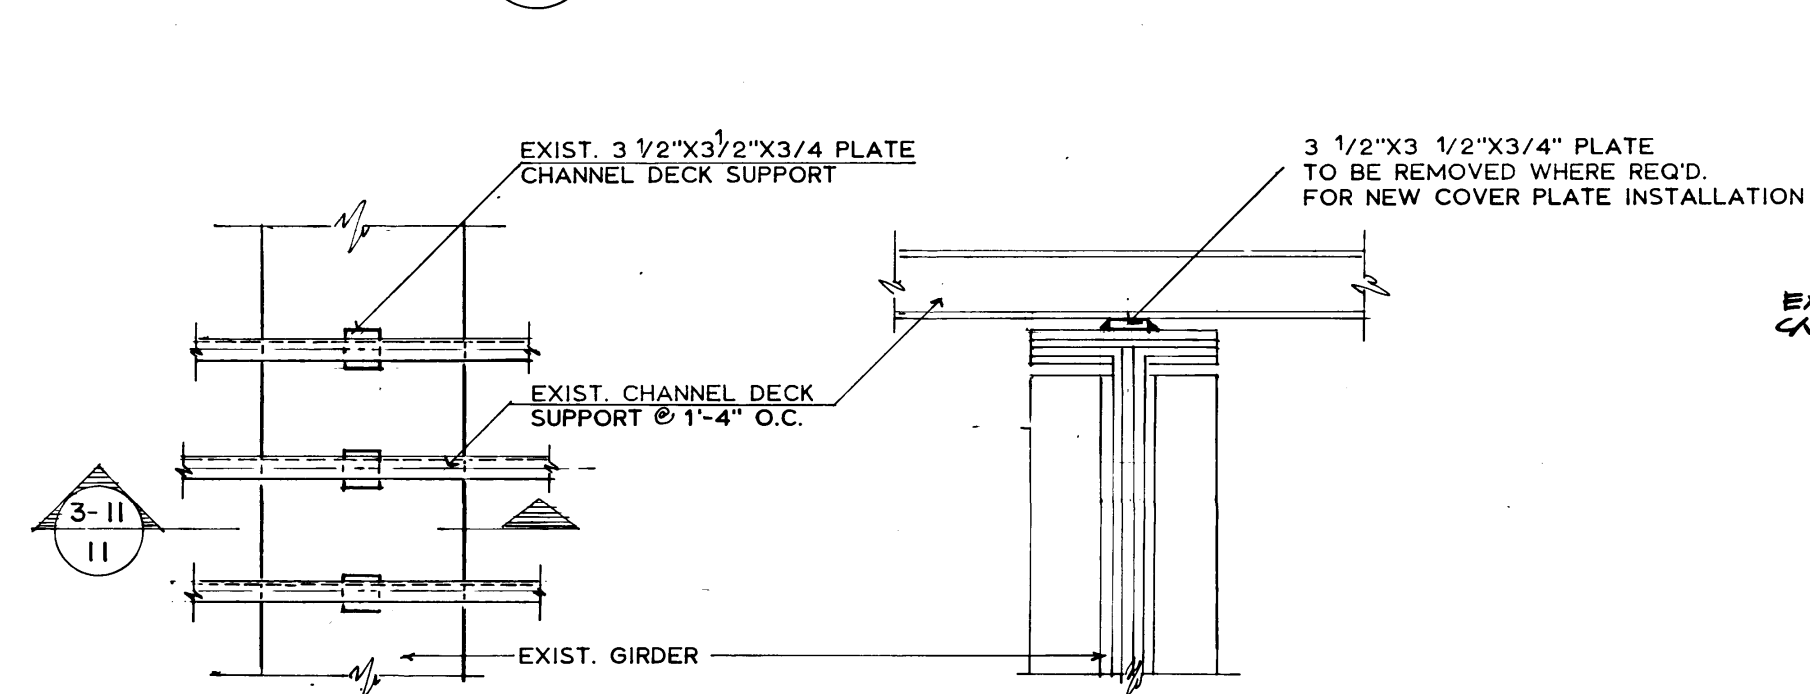
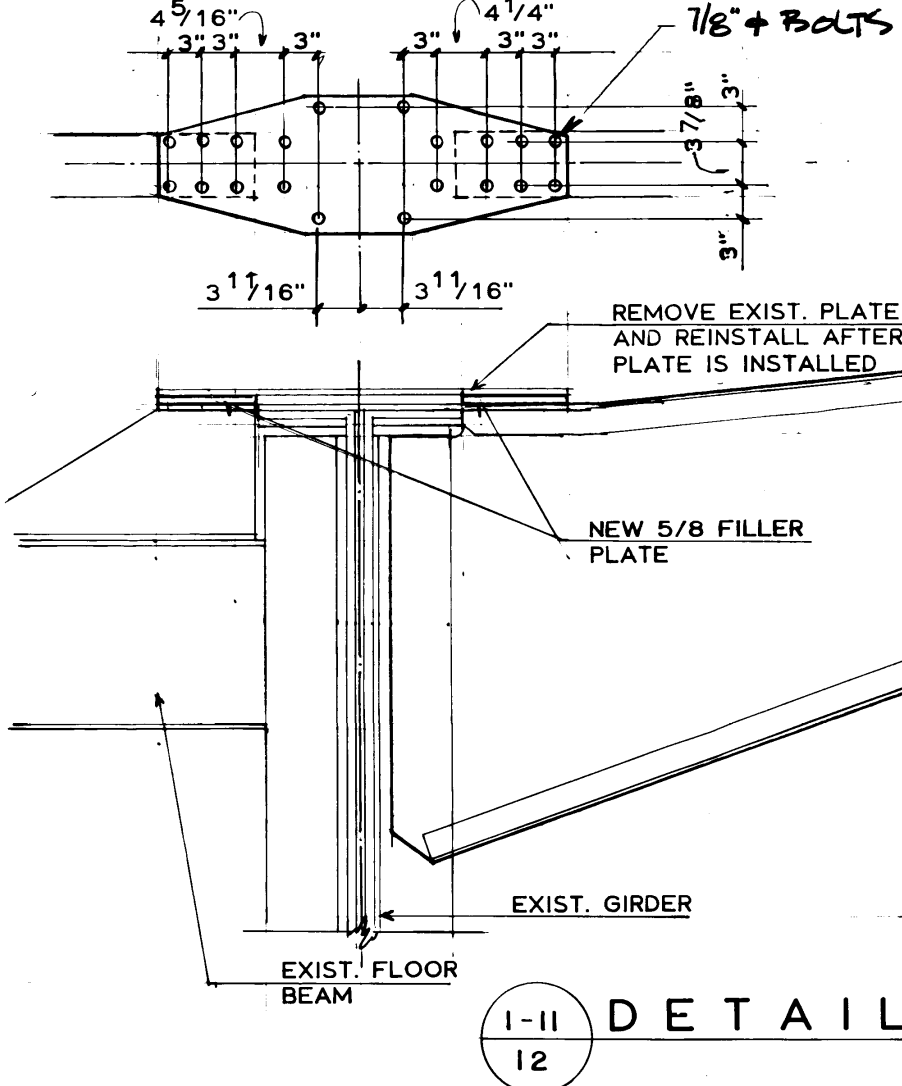


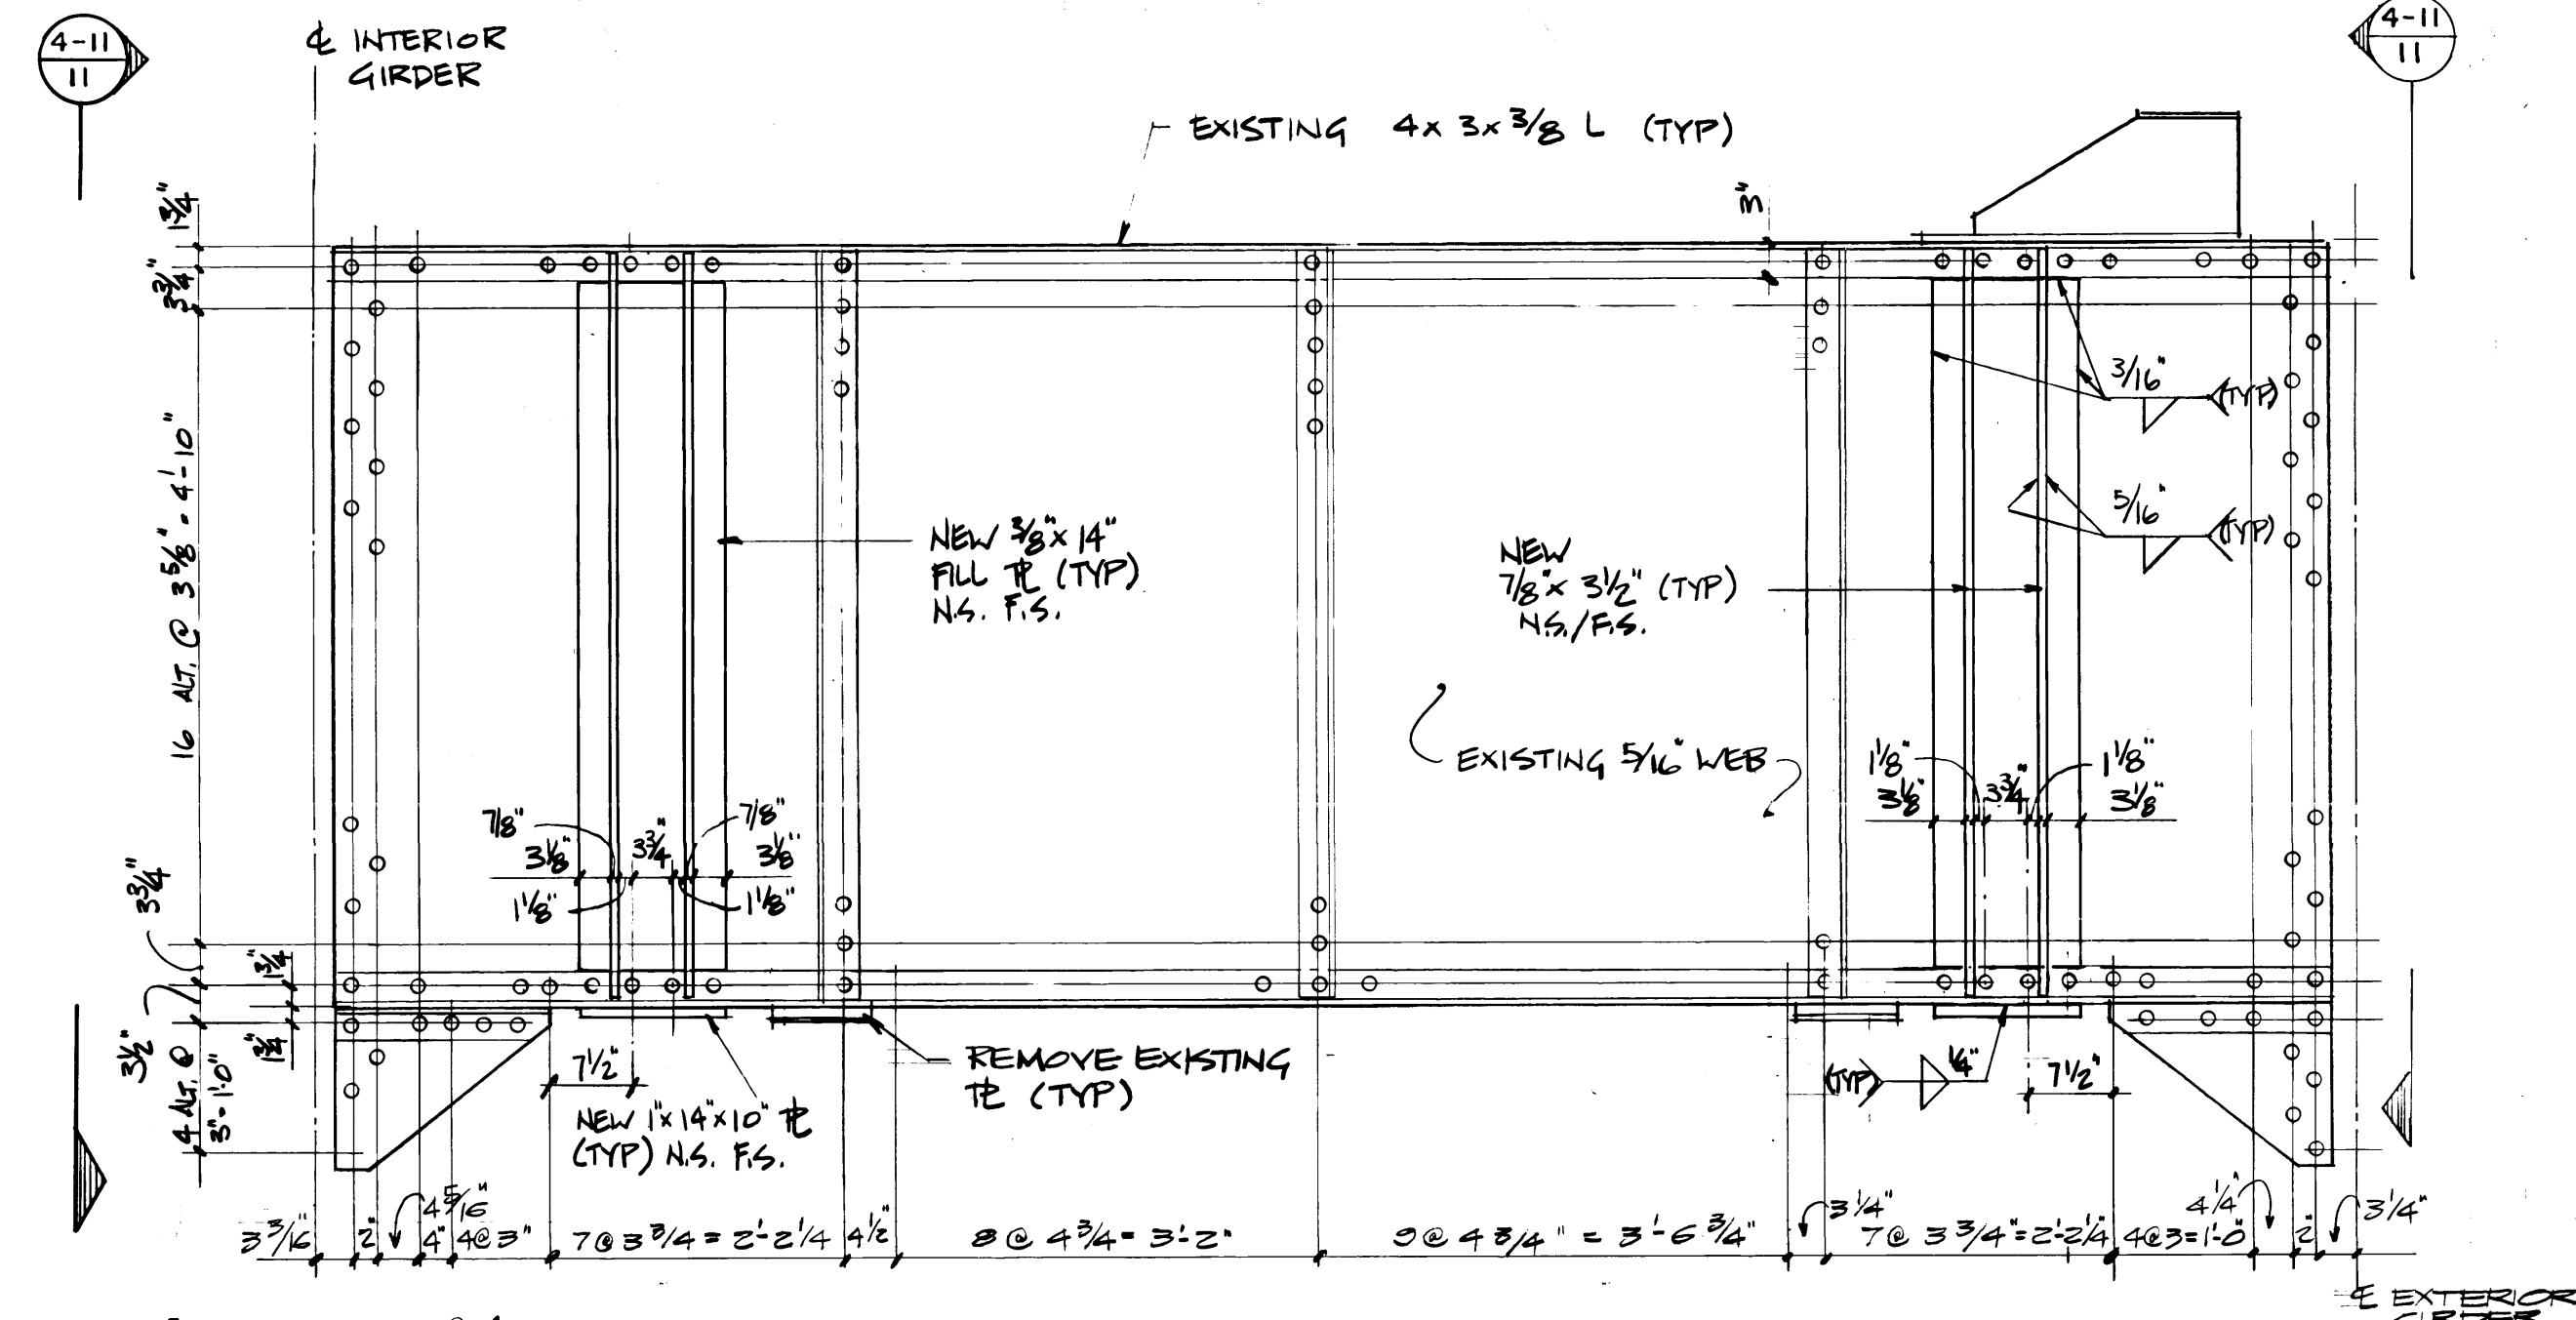


JACKING BEAMS AT SOUTH ABUTMENT & PIER 3
(2 REQUIRED AT EACH LOCATION)

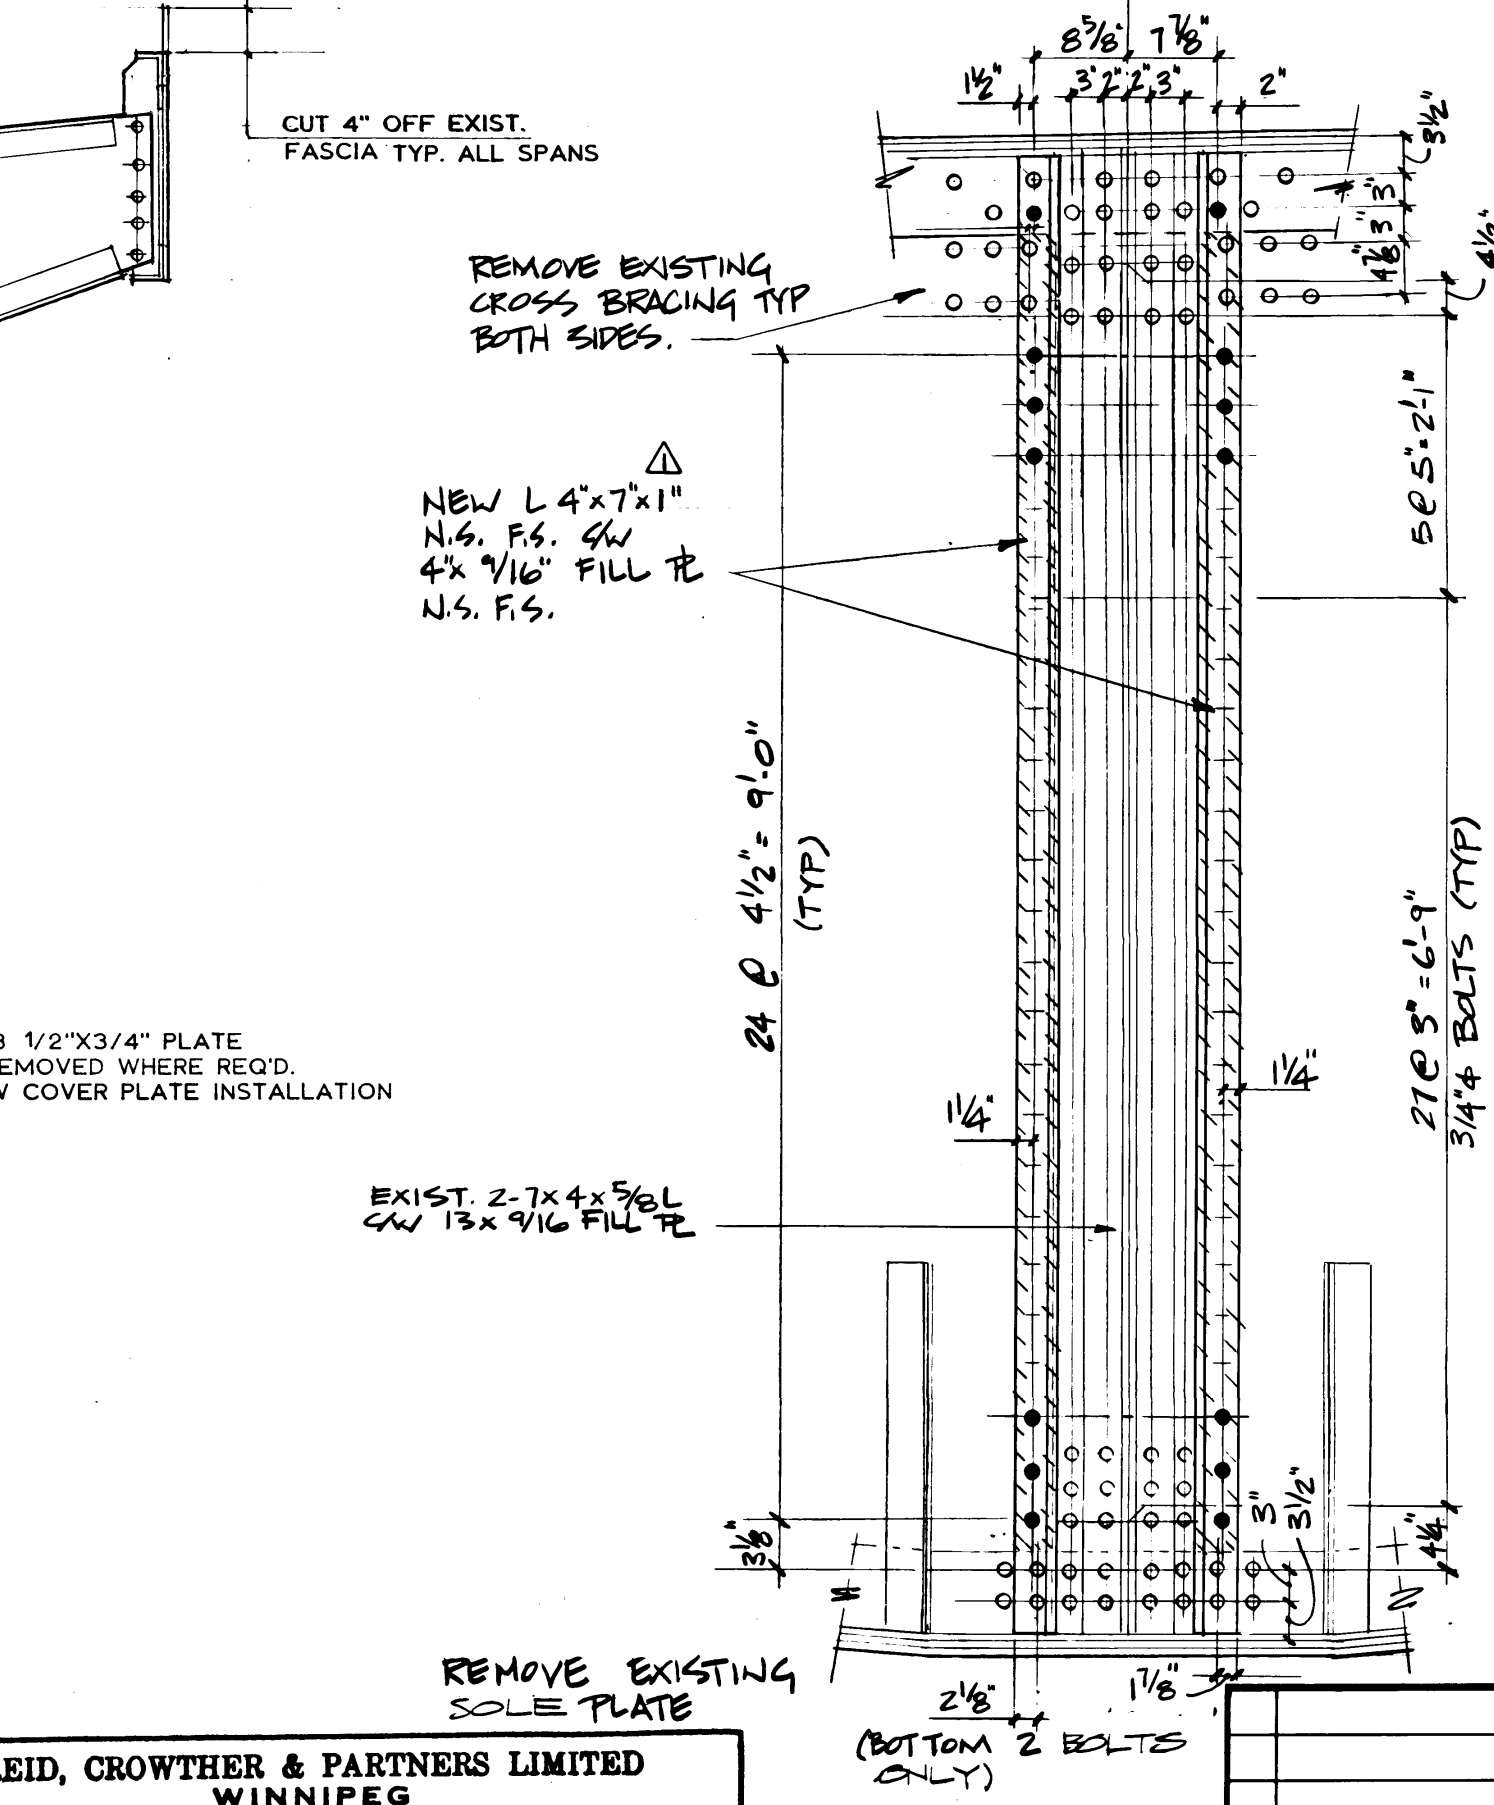


ELEVATION 7-11
(INTERIOR GIRDER)

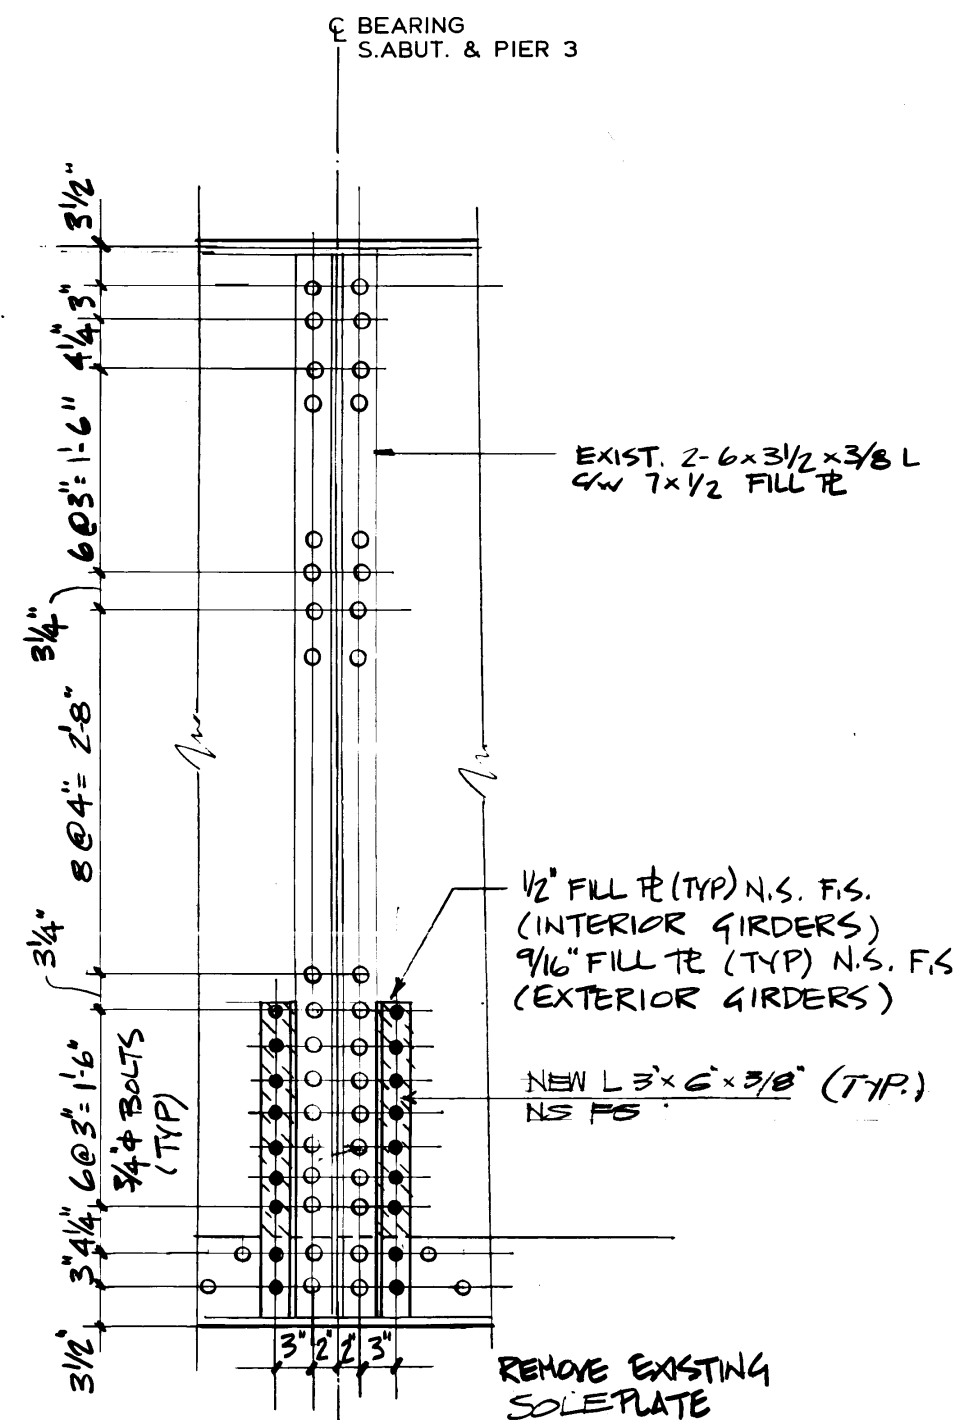

ELEVATION 4-11
(INTERIOR & EXTERIOR GIRDERS)

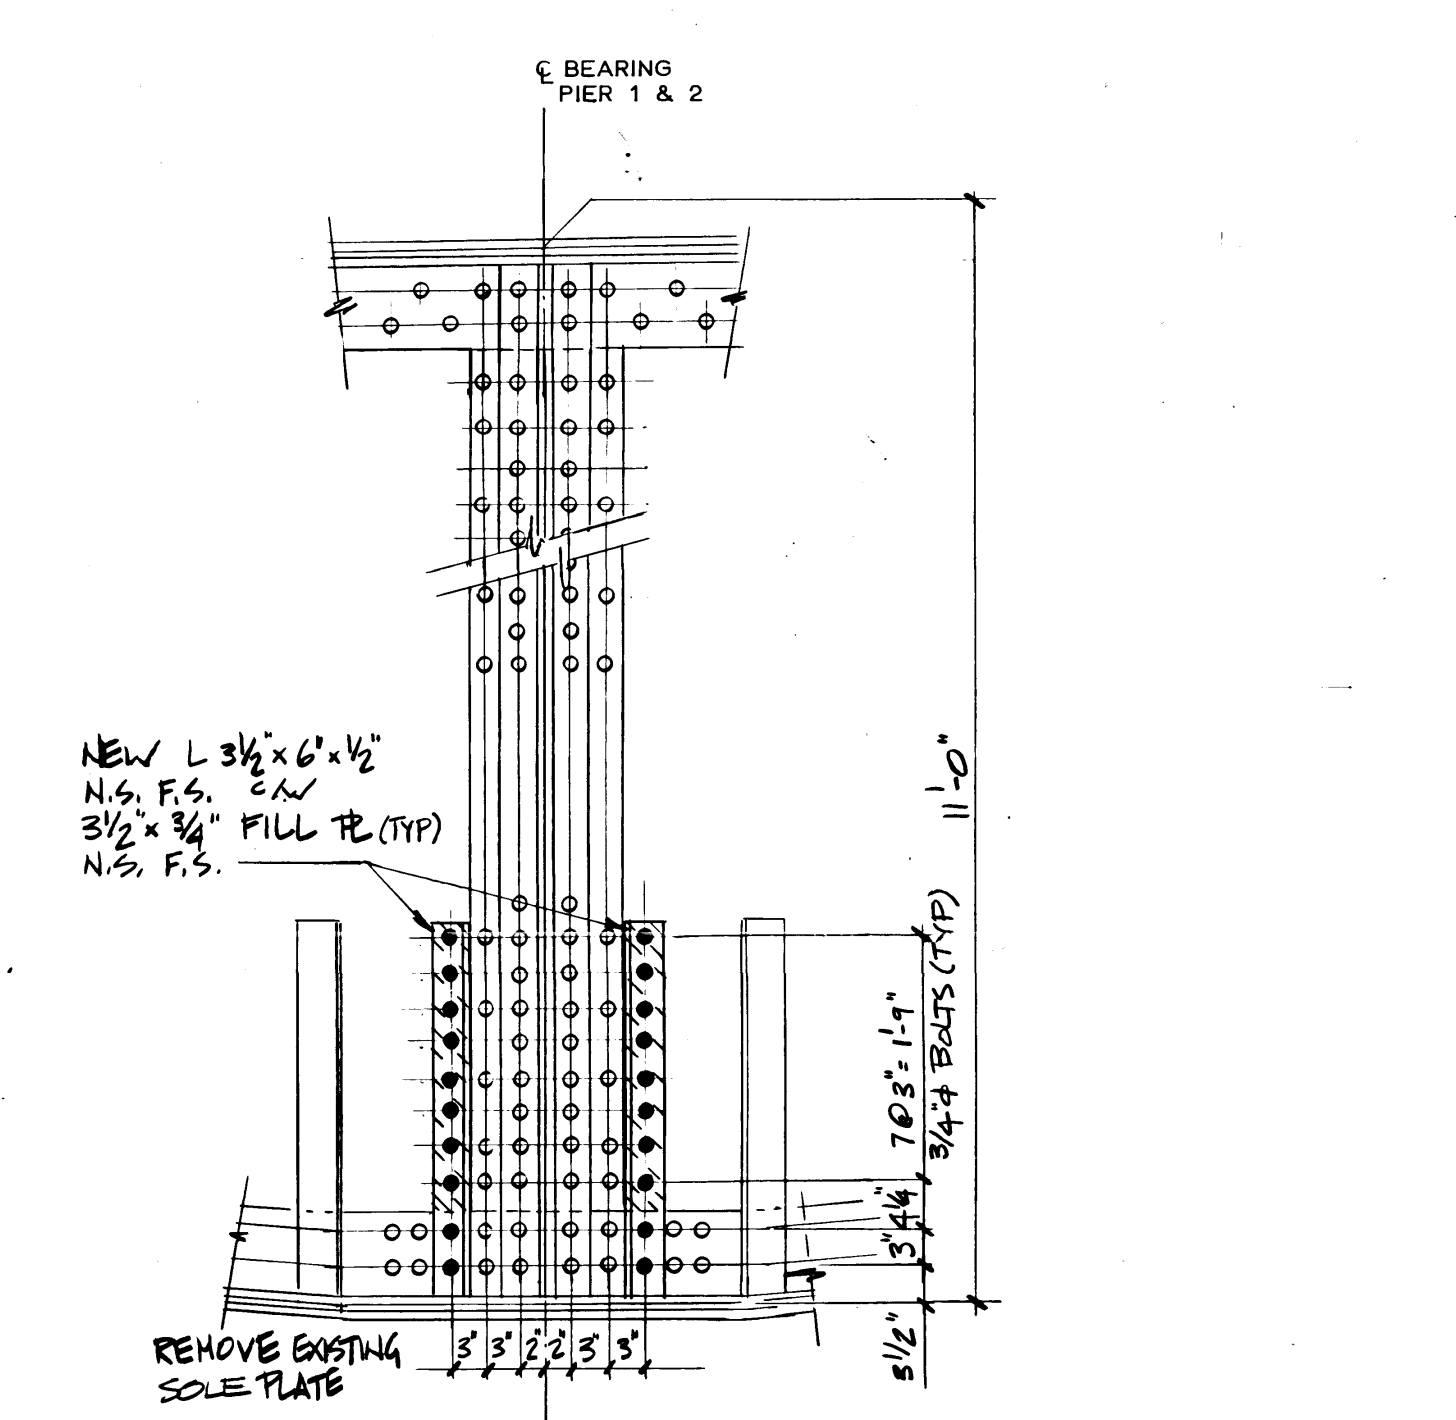

ELEVATION 5-11
(EXTERIOR GIRDERS)

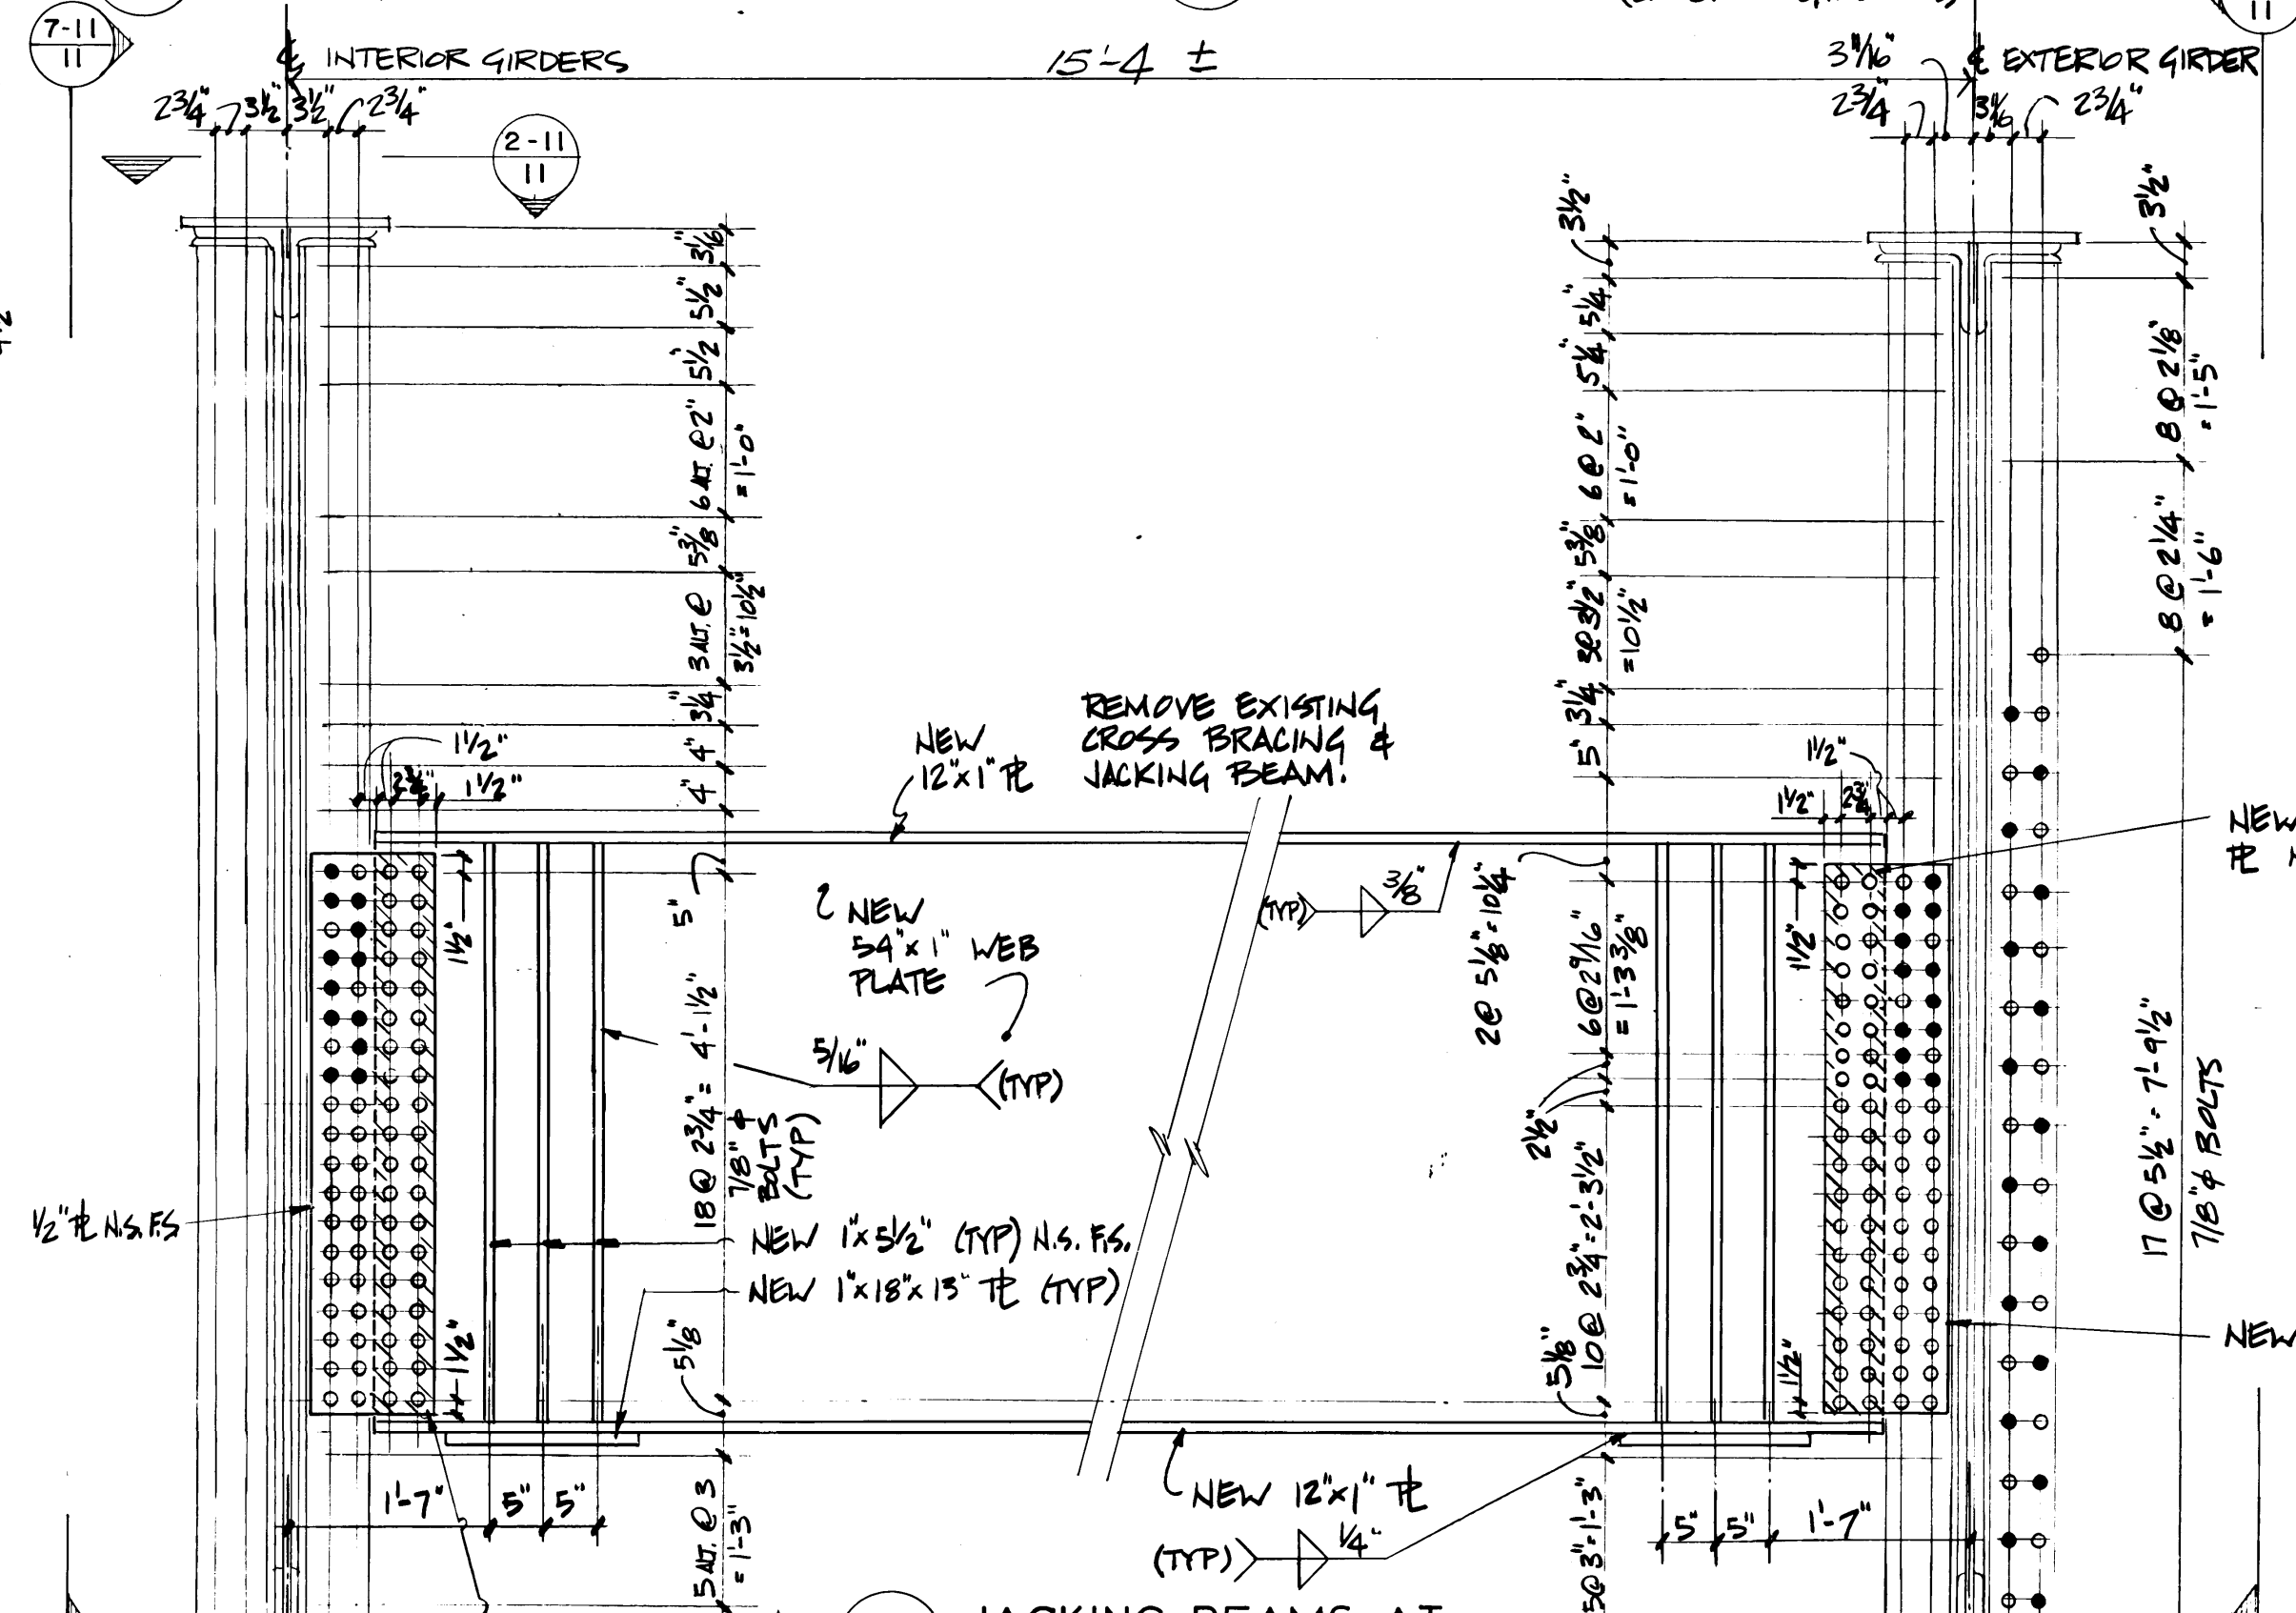


ELEVATION 6-11
(PIERS 1 & 2 (2 REQUIRED AT EACH LOCATION))

REID, CROWTHER & PARTNERS LIMITED
WINNIPEG
AS CONSTRUCTED
SIGNED: *[Signature]* DATE: 85/03/07

A. DETAIL NO.
B. DRAWING WHERE DETAIL SHOWN
C. DRAWING WHERE DETAIL TAKEN

NO.	AS BUILT	84 10 02	DATE	APP.
1				
2				
3				
4				
5				
6				
7				
8				
9				
10				

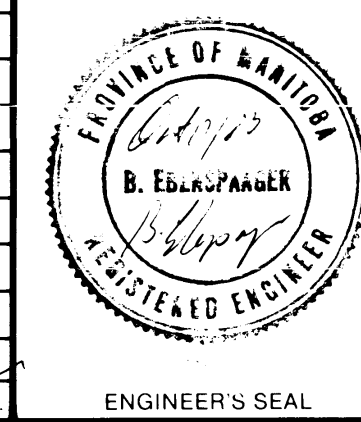

DESIGNED BY: B.E.	DRAWN BY: R.S. / P.A.L.
CHECKED BY: W.J.M.	DATE: 83 10 07
APPROVED BY: <i>[Signature]</i>	DATE: 83/10/14

THE CITY OF WINNIPEG
WORKS & OPERATIONS DIVISION
STREETS & TRANSPORTATION DEPARTMENT

MIDTOWN BRIDGE
DECK RECONSTRUCTION, STRUCTURAL STRENGTHENING AND RELATED WORKS
JACKING BEAMS & MISCELLANEOUS DETAILS
AUTHORIZED BY: *[Signature]* DATE: 83 11 28
ACCEPTED BY: *[Signature]* DATE: 83 11 28
SCALE: N.T.S. DRAWING NO. B114 - 84 - 11