

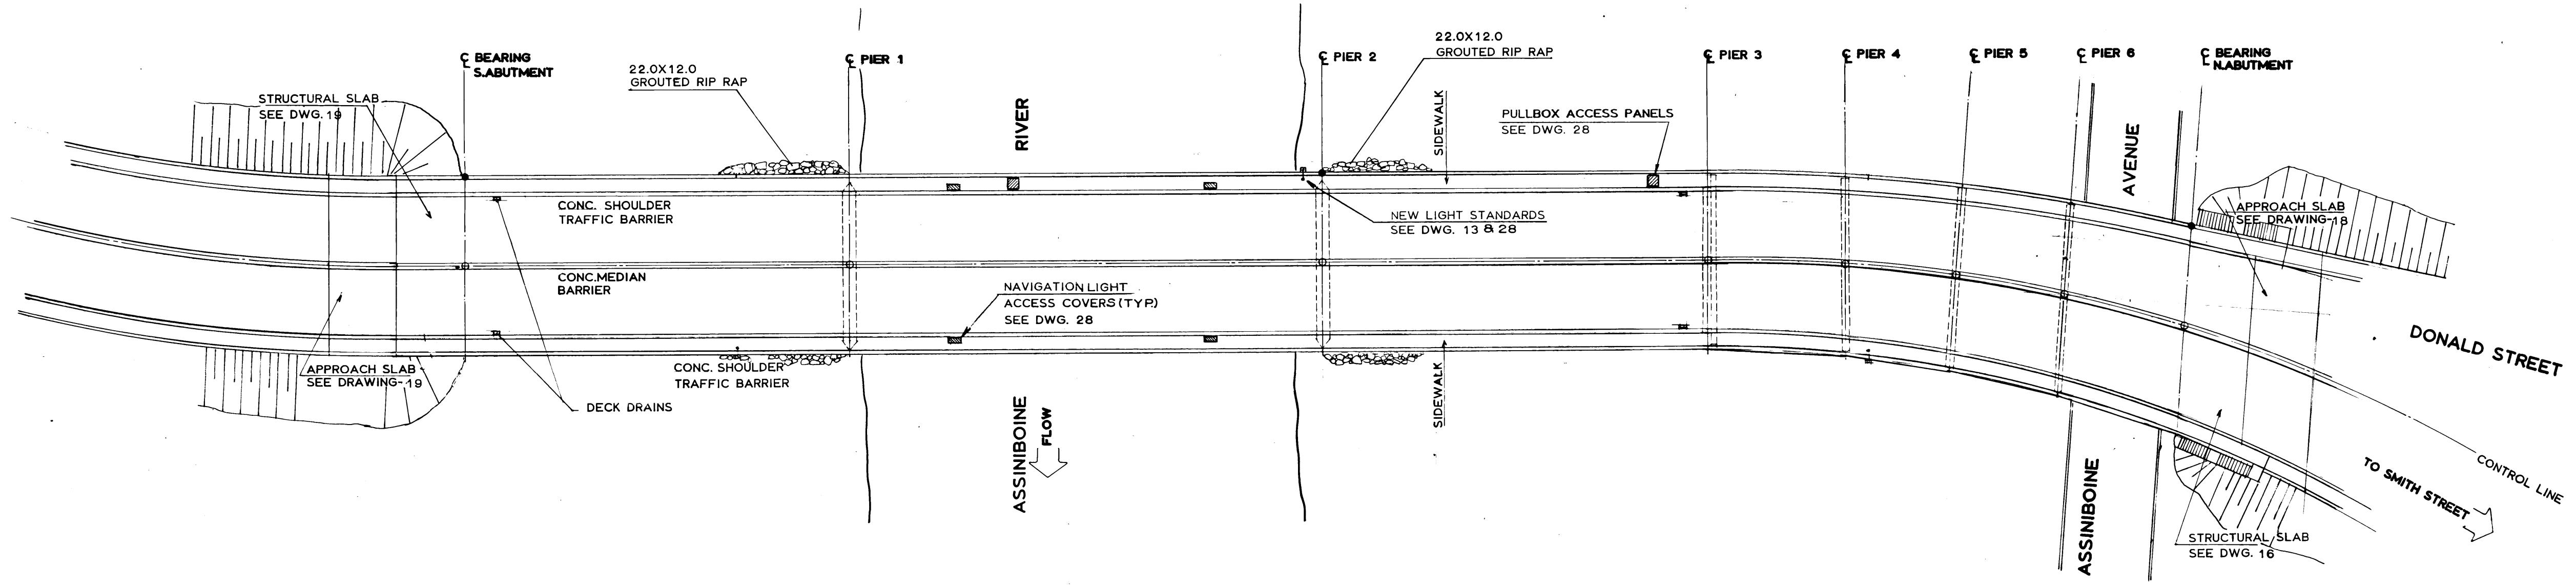


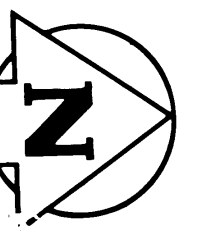

GENERAL ARRANGEMENT
NOT TO SCALE

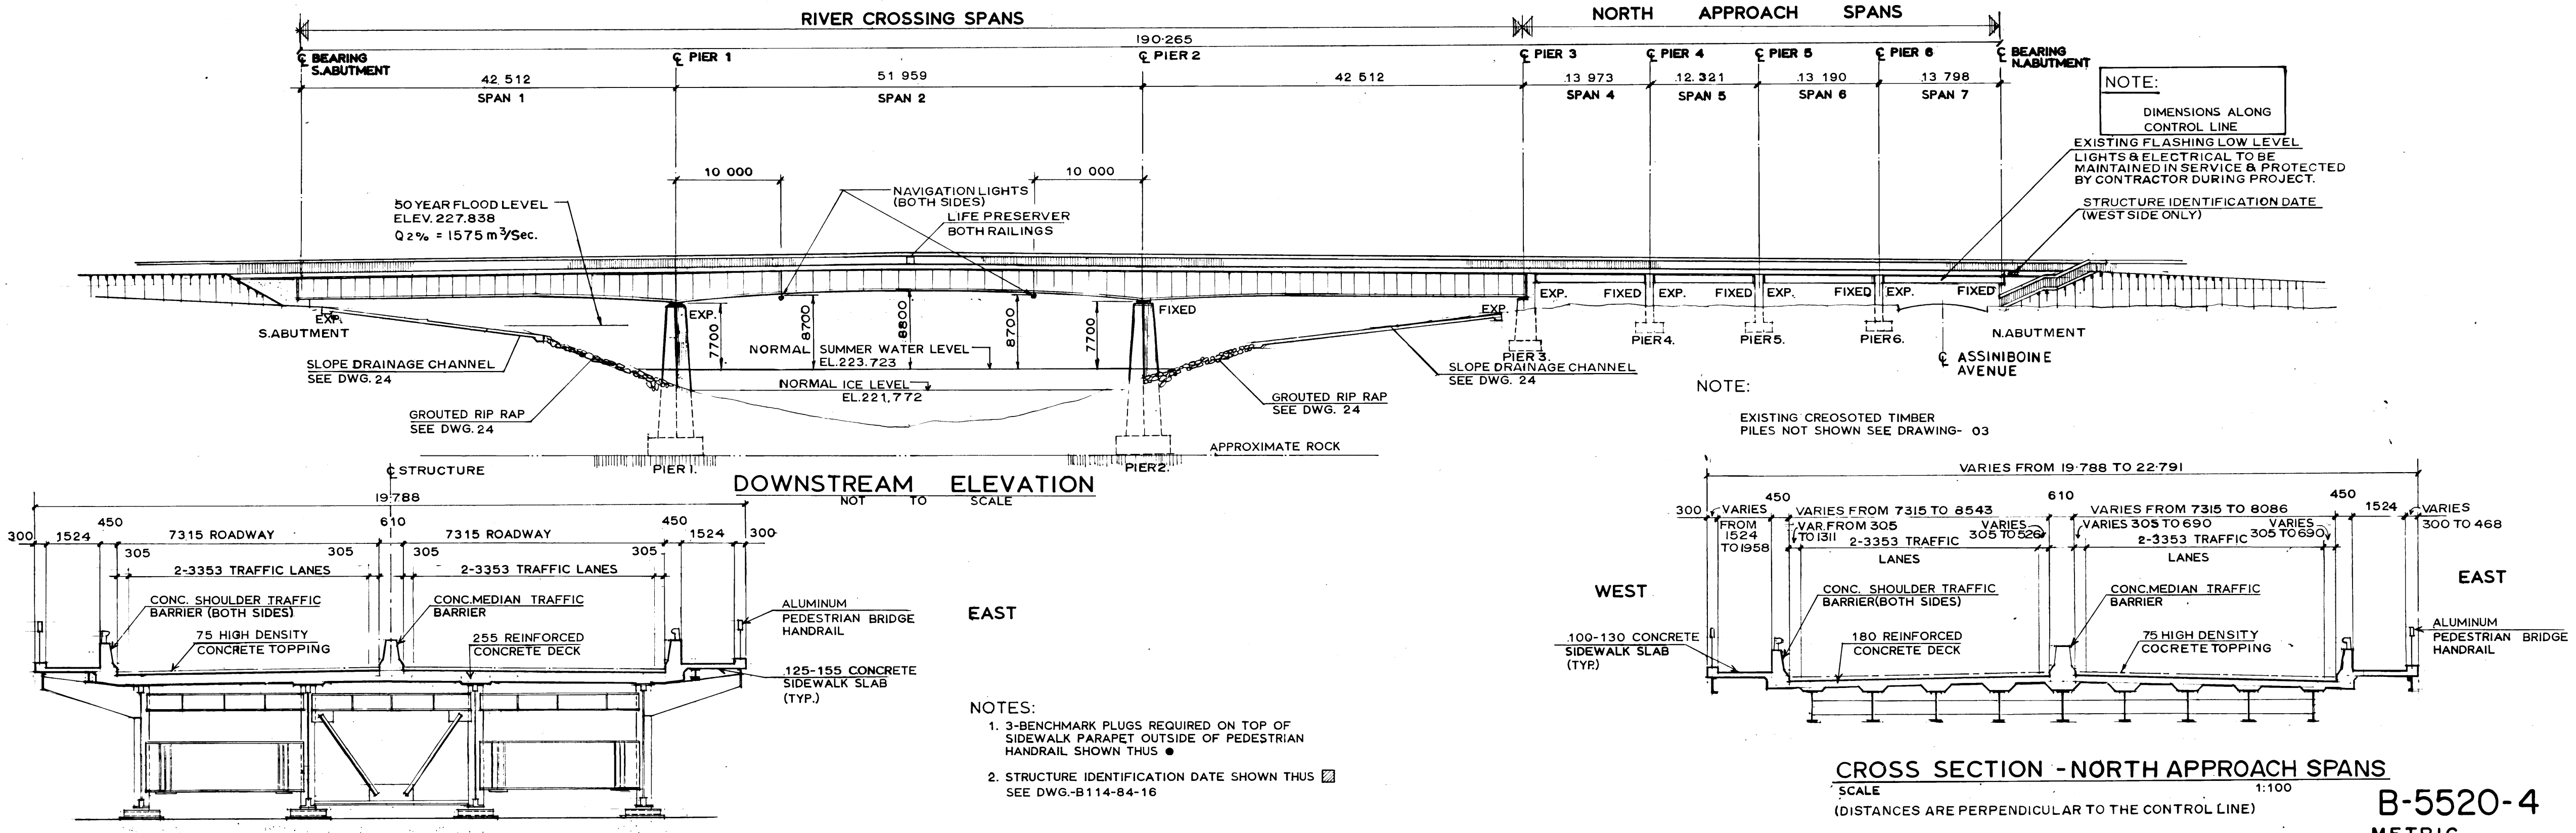

CROSS SECTION-RIVER CROSSING SPAN
SCALE 1:100

CROSS SECTION - NORTH APPROACH SPANS
SCALE 1:100
(DISTANCES ARE PERPENDICULAR TO THE CONTROL LINE)
B-5520-4
METRIC
WHOLE NUMBERS INDICATE MILLIMETRES
DECIMAL NUMBERS INDICATE METRES

REID, CROWTHER & PARTNERS LIMITED
WINNIPEG

AS CONSTRUCTED

SIG. *W.M. Callaghan* DATE: 83/03/04

A-B A. DETAIL NO.
C B. DRAWING WHERE DETAIL SHOWN
C. DRAWING WHERE DETAIL TAKEN

NO.	REVISIONS	DATE	APP.

ENGINEER'S SEAL

REID, CROWTHER & PARTNERS LIMITED
CONSULTING ENGINEERS AND PLANNERS
WINNIPEG CALGARY EDMONTON REGINA VANCOUVER

DESIGNED BY: B.E. DRAWN BY: R.S.
CHECKED BY: W.J.M. DATE: 83 10 07
APPROVED BY: *W.M. Callaghan* DATE: 83/10/12

THE CITY OF WINNIPEG
WORKS & OPERATIONS DIVISION
STREETS & TRANSPORTATION DEPARTMENT

MIDTOWN BRIDGE
DECK RECONSTRUCTION,
STRUCTURAL STRENGTHENING
AND RELATED WORKS

PLAN & GENERAL ELEVATION
OF PROPOSED BRIDGE

AUTHORIZED BY: *Winnipeg, P. Eng.* 1983-11-28
ACCEPTED BY: *Winnipeg, P. Eng.* 83-11-28
SCALE: AS SHOWN DRAWING NO. B114-84-04