


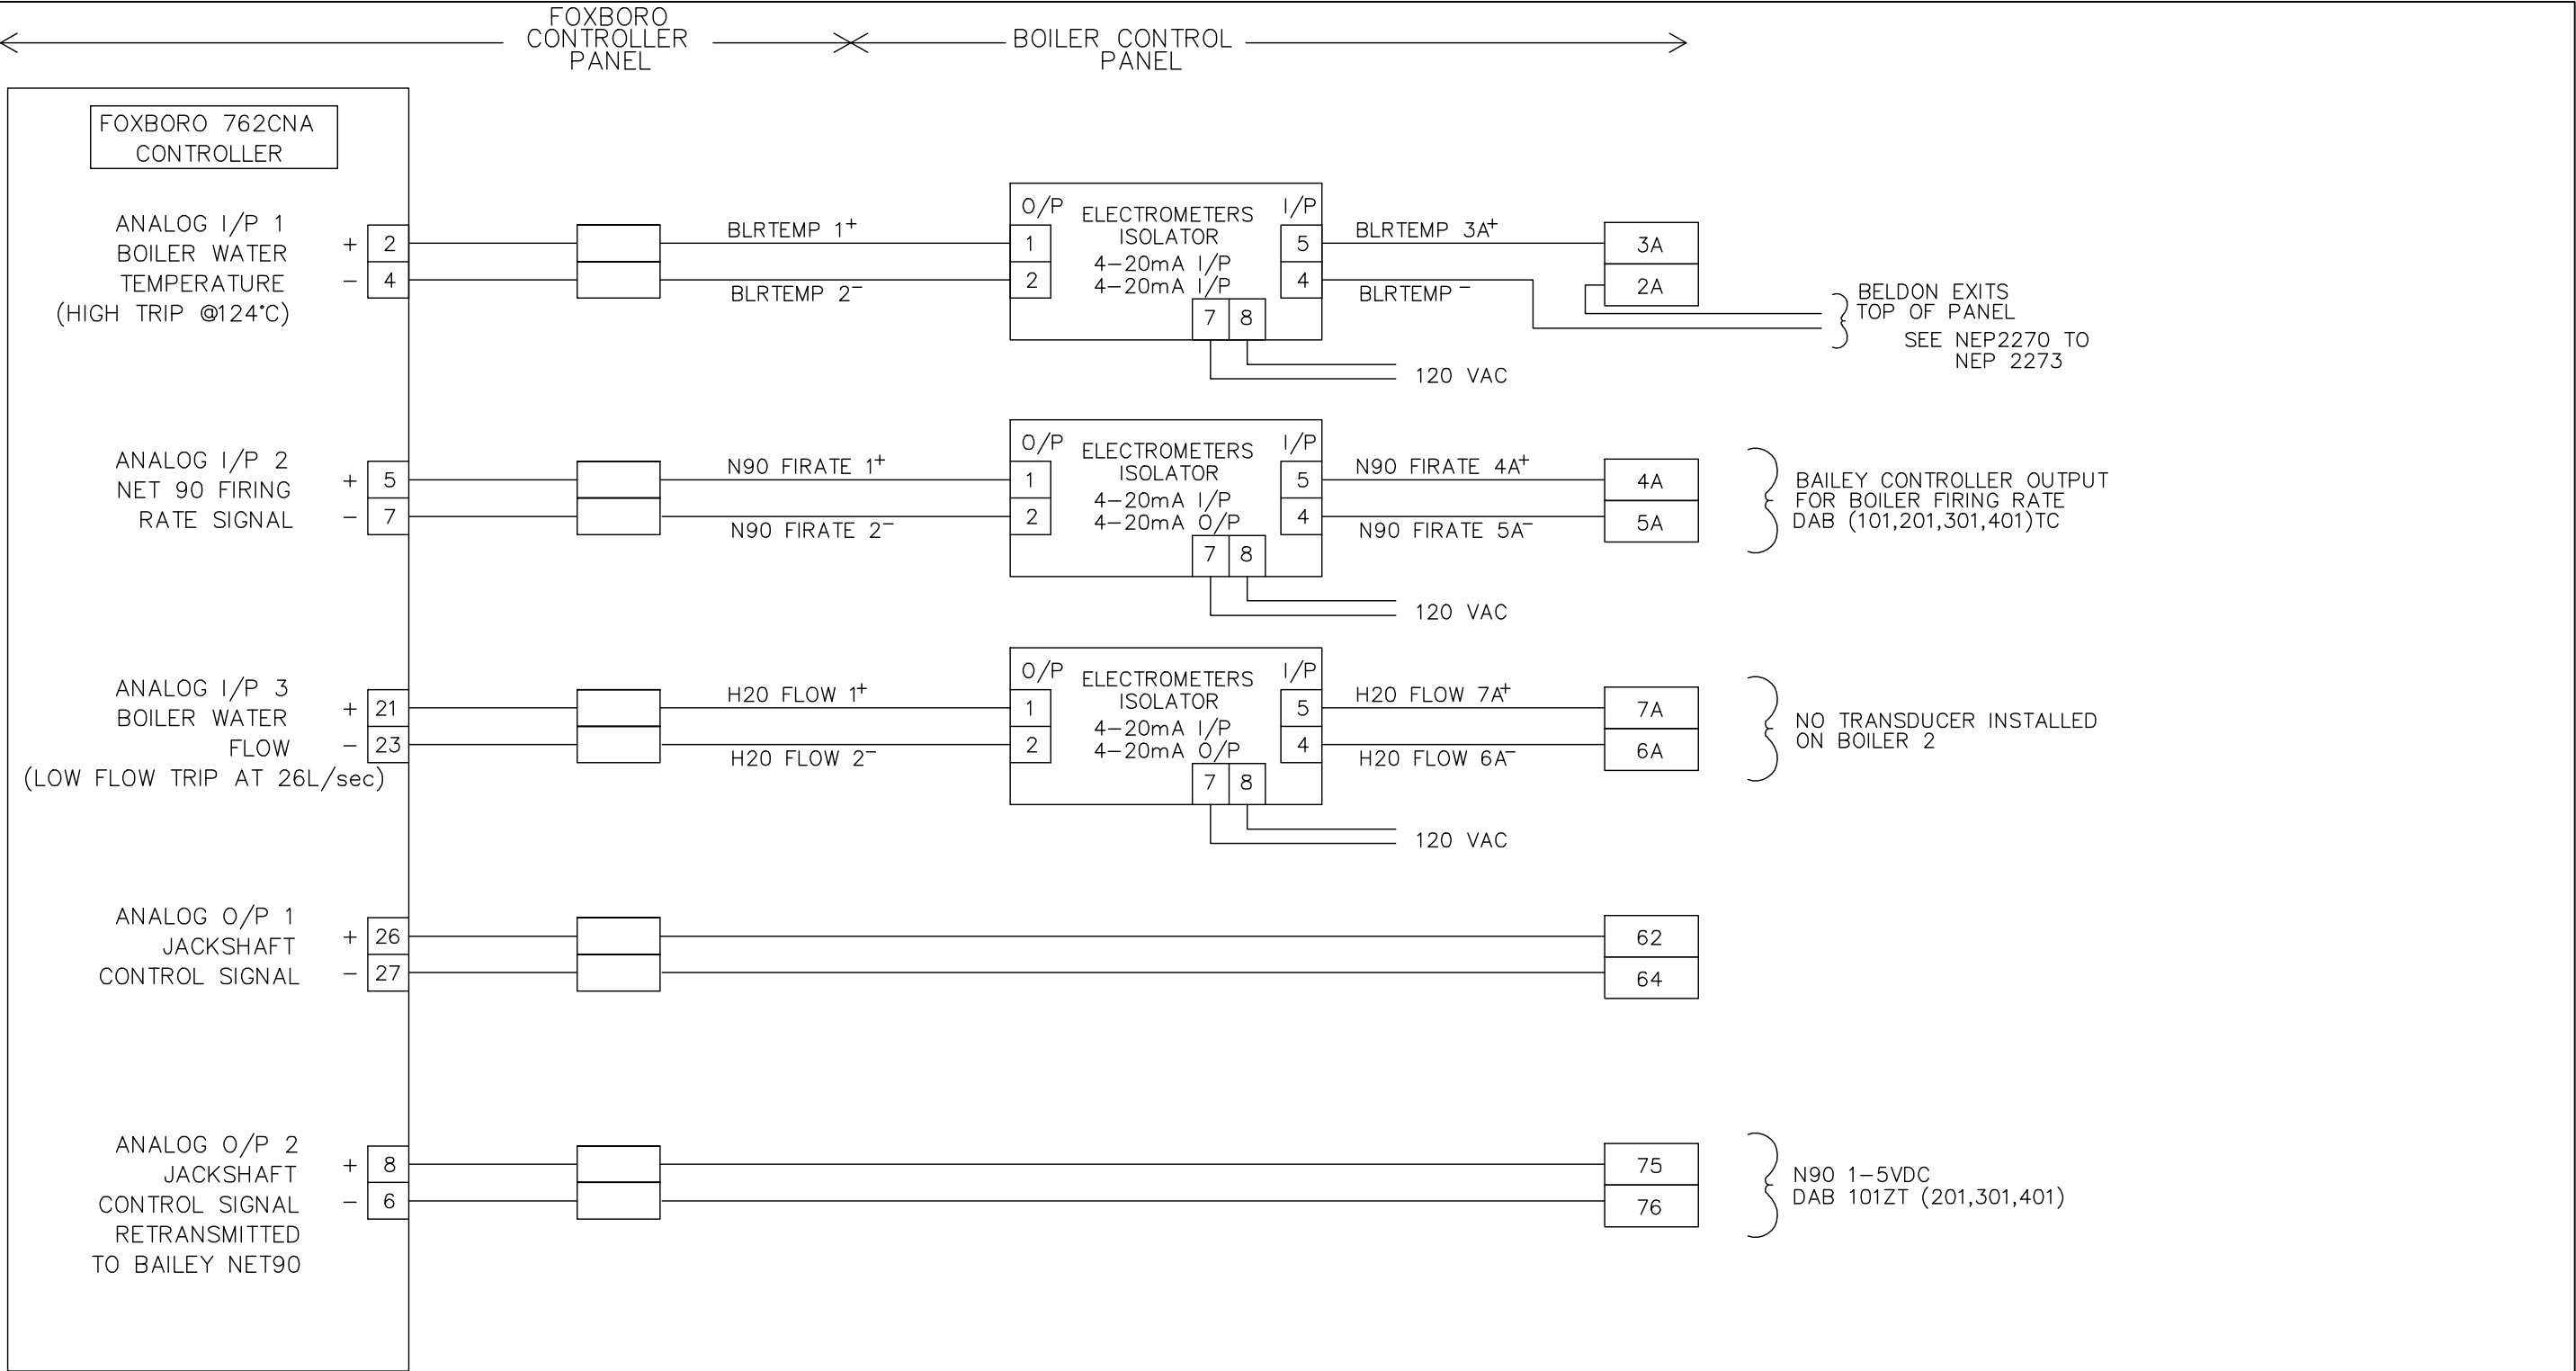

B.M. ELEV.						ENGINEER'S SEAL		THE CITY OF WINNIPEG WATER AND WASTE DEPARTMENT	
				DESIGNED BY —		CHECKED BY		NORTH END WATER POLLUTION CONTROL CENTRE BOILER CONTROLLER ANALOG I/O WIRING	
				DRAWN BY MLK		APPROVED BY			
01	DWG WAS 1-0101B-A0286-002	10.12.10	SW	HOR. SCALE N.T.S.		RELEASED FOR CONSTRUCTION		CITY DRAWING NUMBER 1-0101B-A0020-002	
0	RECORD DRAWING	08.01.17	MLK	VERTICAL					
NO.	REVISIONS	DATE	BY	DATE 2008 01 17		DATE			
						PLOT DATE: 2011 01 12			