


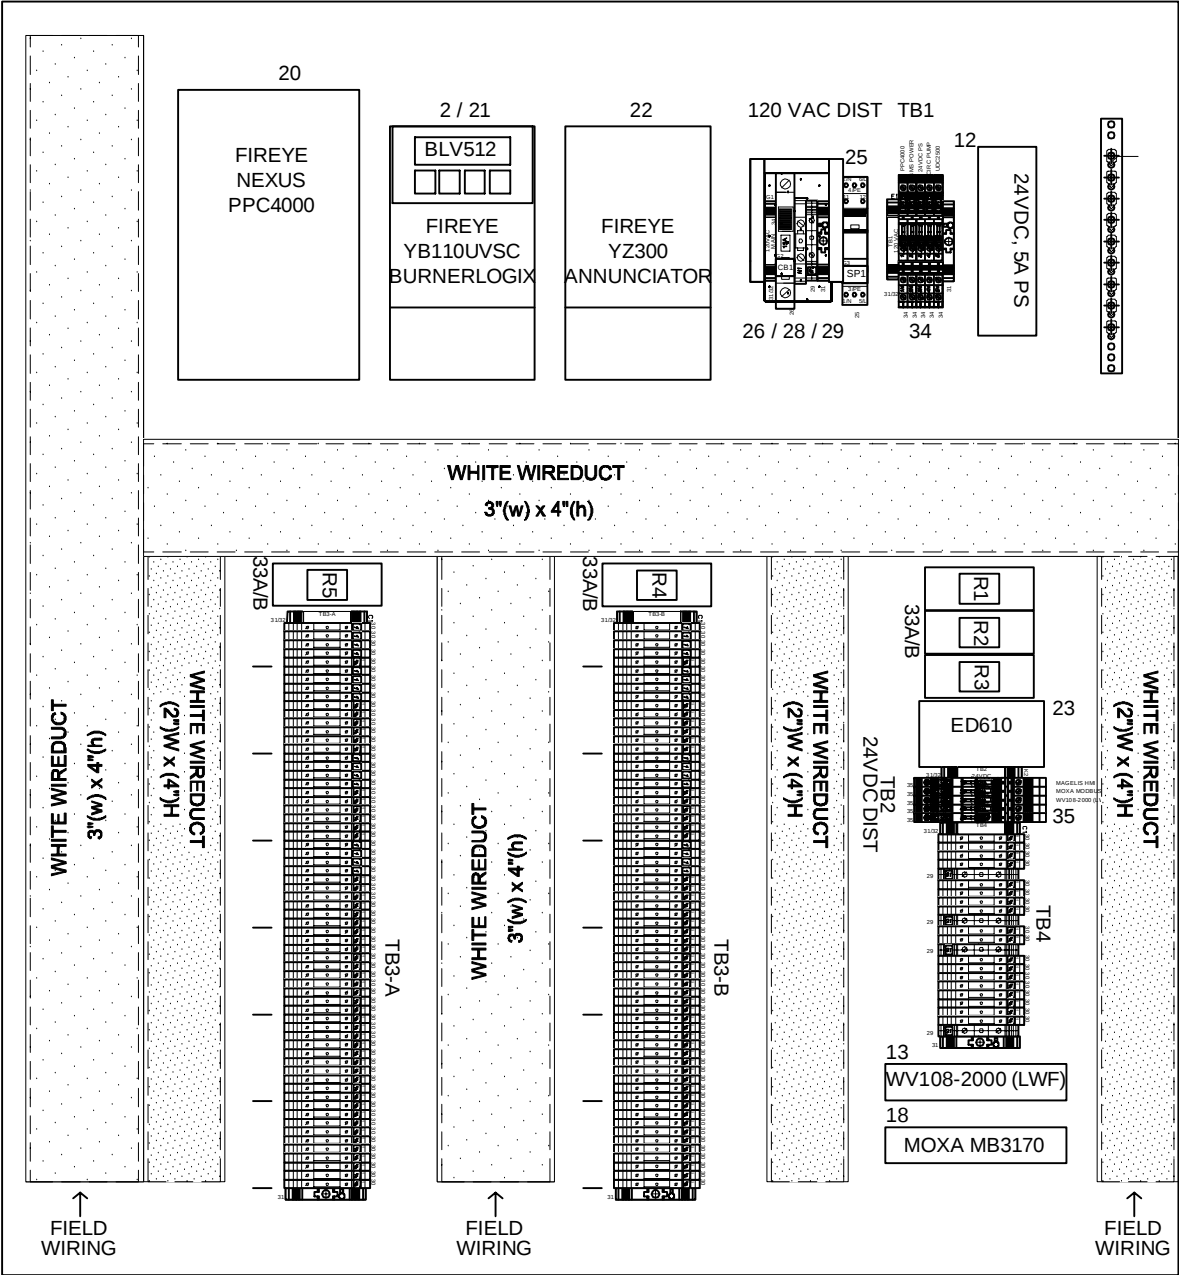

REFER TO DWG 1-0101B-E0044-001 FOR BOM LIST

REVISION ## CHANGES THE ENGINEER'S DESIGN RESPONSIBILITIES ARE LIMITED TO THE CHANGES INDICATED IN THE CLOUDED WORK	
DESIGNED BY:	CHECKED BY:
DRAWN BY:	APPROVED BY:
DATE: YYYY MM DD	RELEASED FOR CONSTR. DATE: YYYY MM DD

B.M. ELEV.			
2	AS BUILT	2019/11/06	EB
1	FOR CONSTRUCTION	2019/10/18	EB
0	FOR CUSTOMER REVIEW	2019/09/23	EB
NO.	REVISIONS	DATE (YYYY/MM/DD)	BY

DESIGNED BY	EB	CHECKED BY	JWB
DRAWN BY	SA	APPROVED BY	
SCALE:		RELEASED FOR CONSTRUCTION	
HORIZONTAL	1:250		
VERTICAL	1:50		
DATE		DATE	

PLOT DATE:

ENGINEER'S SEAL
CONSULTANT DRAWING NUMBER
19-01-601-4E003-2

THE CITY OF WINNIPEG
WATER AND WASTE DEPARTMENT
ENGINEERING DIVISION

NORTH END WATER POLLUTION CONTROL CENTER
BOILER 4
CONTROL PANEL INTERNAL LAYOUT

CITY DRAWING NUMBER	1-0101B-E0043-001	SHEET 1 OF 1
---------------------	-------------------	--------------