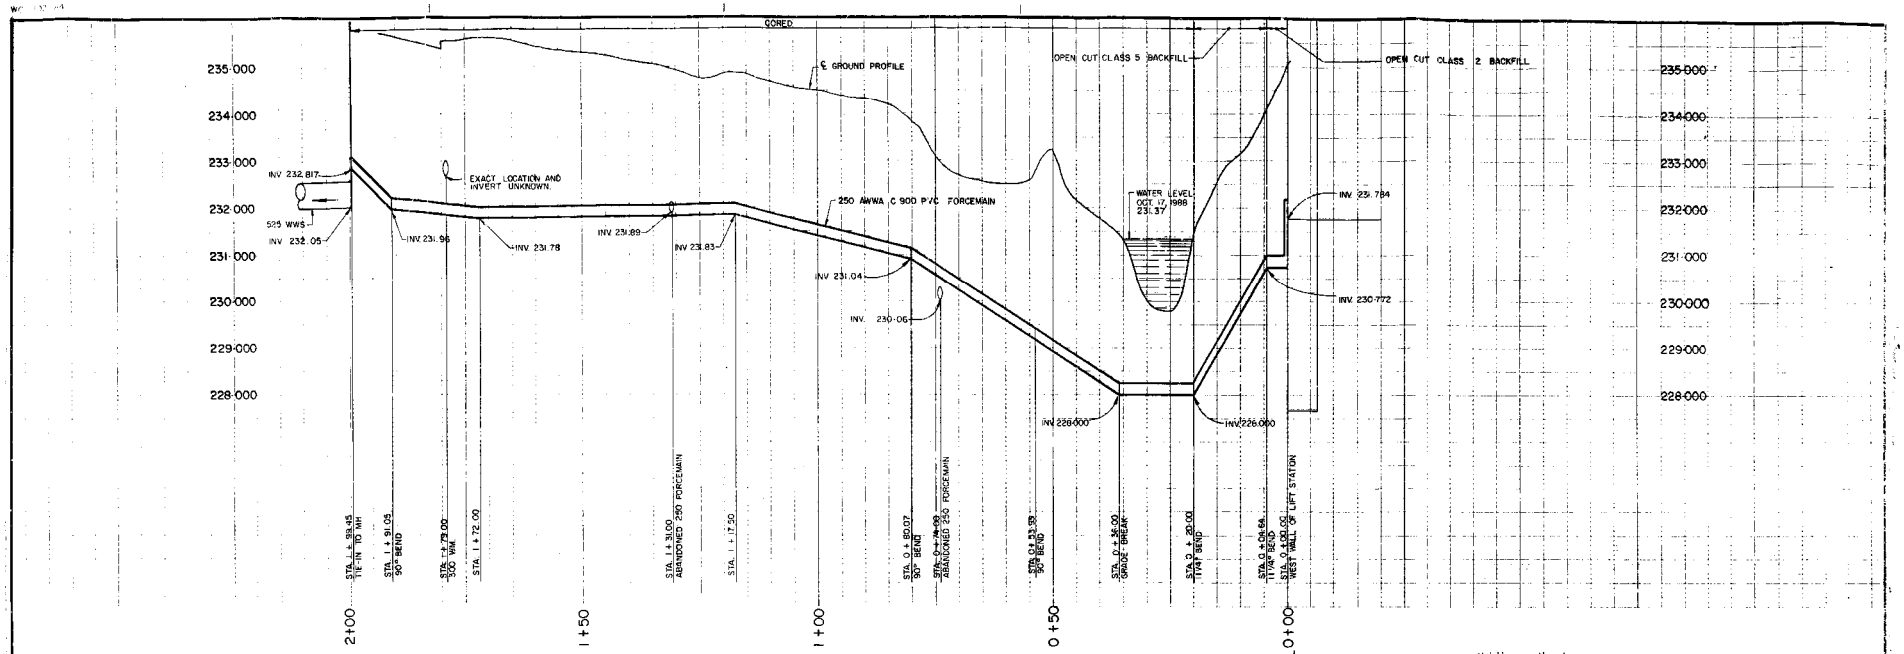

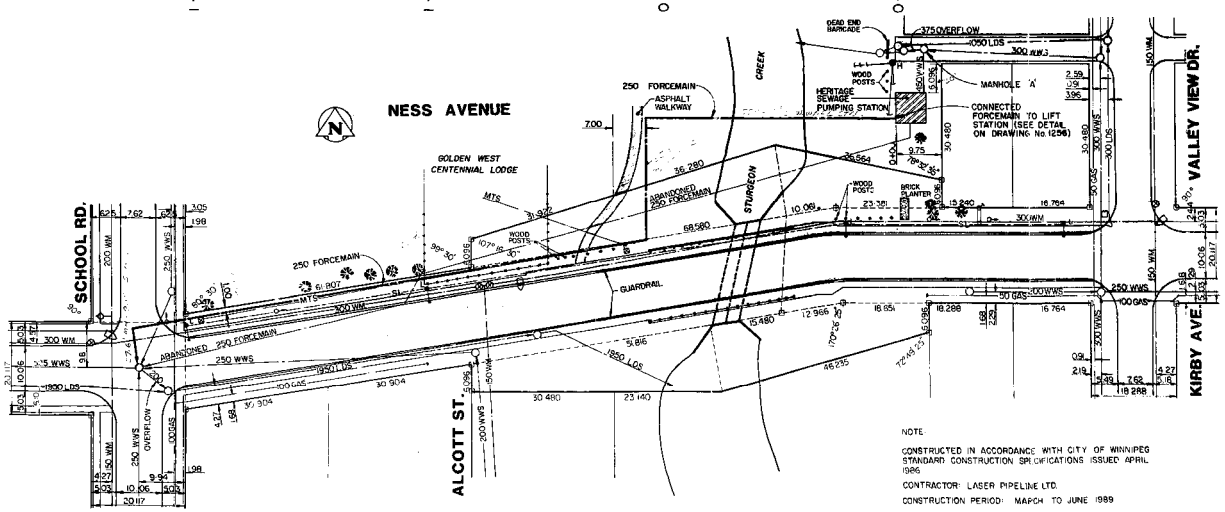

NOTE

CONSTRUCTED IN ACCORDANCE WITH CITY OF WINNIPEG STANDARD CONSTRUCTION SPECIFICATIONS ISSUED APRIL 1986

CONTRACTOR: LASER PIPELINE LTD.

CONSTRUCTION PERIOD: MARCH TO JUNE 1989

TO CONSTRUCT
J.R. Pfeiffer Facilities Dec 4/89

METRIC
WHOLE NUMBERS INDICATE MILLIMETRES
DECIMALIZED NUMBERS INDICATE METRES

EXISTING	LEGEND-PLAN	PROPOSED	EXISTING	LEGEND-PLAN	PROPOSED	EXISTING	LEGEND-PROFILE	PROPOSED
150 mm W.M	WATERMAIN	150 mm W.M		HYDRO		150 mm W.M	WATERMAIN	
	HYDRANT			MTS			HYDRANT	
	VALVE			CONCRETE			VALVE	
300 mm L.D.S	LAND DRAINAGE SEWER	300 mm L.D.S		ASPHALT		300 mm L.D.S	LAND DRAINAGE SEWER	300 mm L.D.S
250 mm W.W.S	WASTE WATER SEWER	250 mm W.W.S		PROPERTY LINE		250 mm W.W.S	WASTE WATER SEWER	250 mm W.W.S
	MANHOLE			SURVEY BAR			℄ PROFILE	
	CATCH BASIN			TREE				
	CURB INLET			CHAIN LINK FENCE				
	JUNCTIONS			SIGN				
	CULVERT			C.T.S. BOX				
	GAS			LIGHT STANDARD				

LOCATION APPROVED
UNDERGROUND STRUCTURES

NOTE

B.M. 40-044
ELEV. 235.588

NO	REVISIONS	DATE	BY
1	REVISED TO AS-BUILT	89/10/18	TM

WORKS & OPERATIONS DIVISION
WATERWORKS, WASTE & DISPOSAL DEPARTMENT

DESIGNED BY	T.J.W.	CHECKED BY	RAS
DRAWN BY	TM	APPROVED BY	
HOR. SCALE	1:500	RELEASED FOR CONSTRUCTION	
VERTICAL	1:50		
DATE	OCTOBER 1988	DATE	

ENGINEER SEAL
PROVINCE OF MANITOBA
R. A. Sorokowski
SOROKOWSKI
JAN. 13/89
REGISTERED PROFESSIONAL ENGINEER

CONSULTANT DRAWING NO.

THE CITY OF WINNIPEG
WORKS AND OPERATIONS DIVISION

HERITAGE LIFT STATION
FORCEMAIN RENEWAL

CITY DRAWING NUMBER
SHEET 1 OF 2
1255