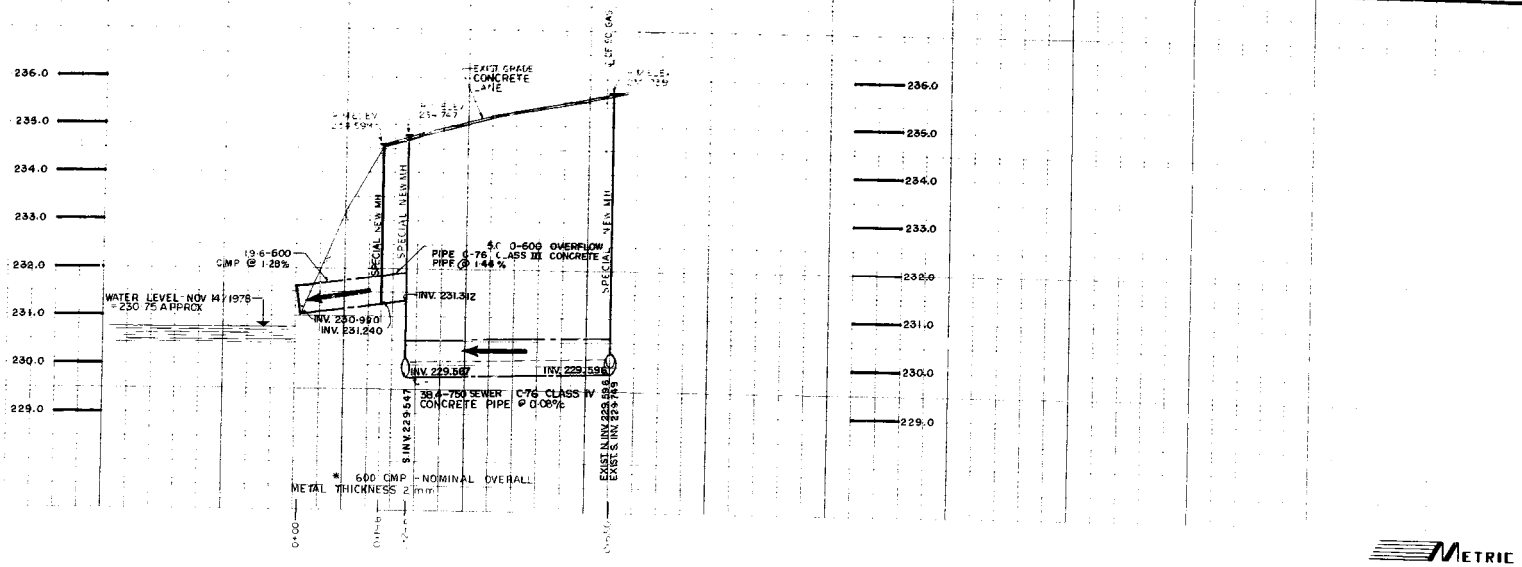

METRIC

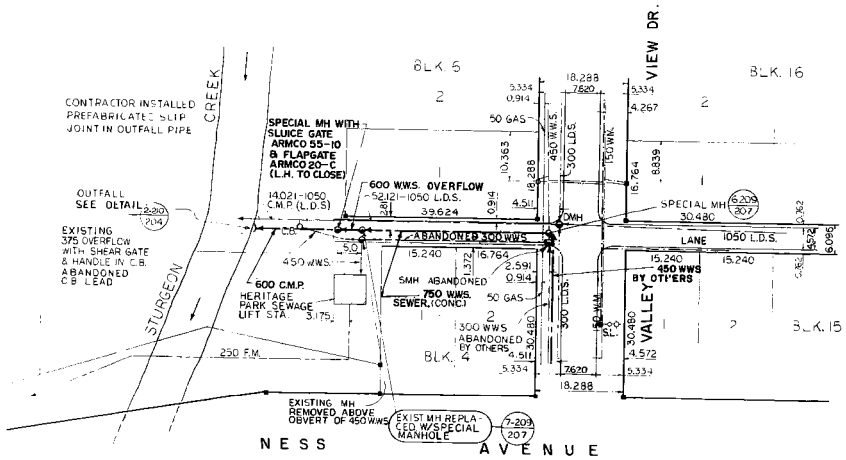

NOTES

1. COVER SHEET REF. NO.-11.
2. FIELD BOOK NO. 2123 USED.
3. BENCH MARK NO. 40-016 N.E. CORNER OF SCHOOL RD. AND NESS AVE., T.B.L.T. IN MOST WESTERLY CONC. FOUNDATION OF SALVATION DRIVE. GOLDEN WEST CENTENNIAL LODGE NO. 811 SCHOOL RD., 1 m N. AND 0.1 m BELOW BRICK C... CORNER OF MOST WESTERLY WALL OF BLDG. EL. 236.749
4. LEGAL PLAN – 7,868 ; 7,968

LEGEND

WATERMAINS	(W.M.)	
WASTE WATER SEWER	(W.W.S.)	EXISTING
LAND DRAIN SEWER	(L.D.S.)	PROPOSED
MAN TELEPHONE SYSTEM	(MTS.)	
GAS		
FORCEMAIN	(F.M.)	
PAVEMENT		
LANDSCAPE or BLDG GR		30.50
HYDRANT		
WATER VALVE	(WV)	
GAS VALVE	(GV)	
SERVICE BOX		
MANHOLE MTS (M) HYDRO (H) SEWER (S)		
CURB INLET		
CATCH BASIN		
SURVEY BAR		

WARNING READ THIS BEFORE YOU BEGIN WORK – IF POWER EQUIPMENT OR EXPLOSIVES ARE TO BE USED FOR THE EXCAVATION AUTHORIZED BY THE ATTACHED PERMIT, NO WORK SHALL BE COMMENCED BEFORE (1) THE LOCAL OFFICE OF THE G. S COMPANY HAS BEEN NOTIFIED OF THE PROPOSED EXCAVATION, and (2) HE GAS COMPANY HAS MARKED OUT THE LOCATION OF ANY ENDANGERED GAS INSTALLATIONS OR THE GAS COMPANY HAS ADVISED THAT NO GA INSTALLATIONS WILL BE ENDANGERED BY THE PROPOSED EXCAVATION. FOI SPECIFIC DETAILS REFER TO MANITOBA REGULATIONS 210 72 MADE UND THE GAS PIPE LINE ACT

A-B / C
A. DETAIL NO.
B. DRAWING WHERE DETAIL SHOWN
C. DRAWING WHERE DETAIL TAKEN

UNDERGROUND STRUCTURES

LOCATIONS OF UNDERGROUND STRUCTURES AS SHOWN ARE BASED ON THE BEST INFORMATION AVAILABLE BUT NO GUARANTEE IS GIVEN THAT ALL EXISTING UTILITIES ARE SHOWN OR THAT THE GIVEN LOCATIONS ARE EXACT. CONFIRMATION OF EXISTENCE AND EXACT LOCATION OF ALL SERVICES MUST BE OBTAINED FROM THE INDIVIDUAL UTILITIES BEFORE PROCEEDING WITH CONSTRUCTION

1 AS CONSTRUCTED JAN 80

No	REVISIONS	DATE	APP.

Reid, Crowther & Partners Limited
CONSULTING ENGINEERS AND PLANNERS
WINNIPEG EDMONTON REGINA WINNIPEG TORONTO OTTAWA
MONTREAL MILTON PARK BRANDON

DESIGNED BY G.E.M.	DRAWN BY R.A.C.
CHECKED BY W.P.W.	DATE APRIL 6 1979
APPROVED BY	DATE 79-04-27

THE CITY OF WINNIPEG
WORKS & OPERATIONS DEPARTMENT
WATERWORKS, WASTE & DISPOSAL DIVISION

PARKDALE SANITARY SEWER DISTRICT
RELIEF SEWER CONSTRUCTION
SEWER RENEWAL & OVERFLOW ON PUBLIC LANE
VALLEY VIEW DR. TO STURGEON CREEK

AUTHORIZED BY ... DATE ...
SCALE HOR. 1:500 VERT. 1:50
DRAWING NO LD-207

R.C.P.L. #60003-11