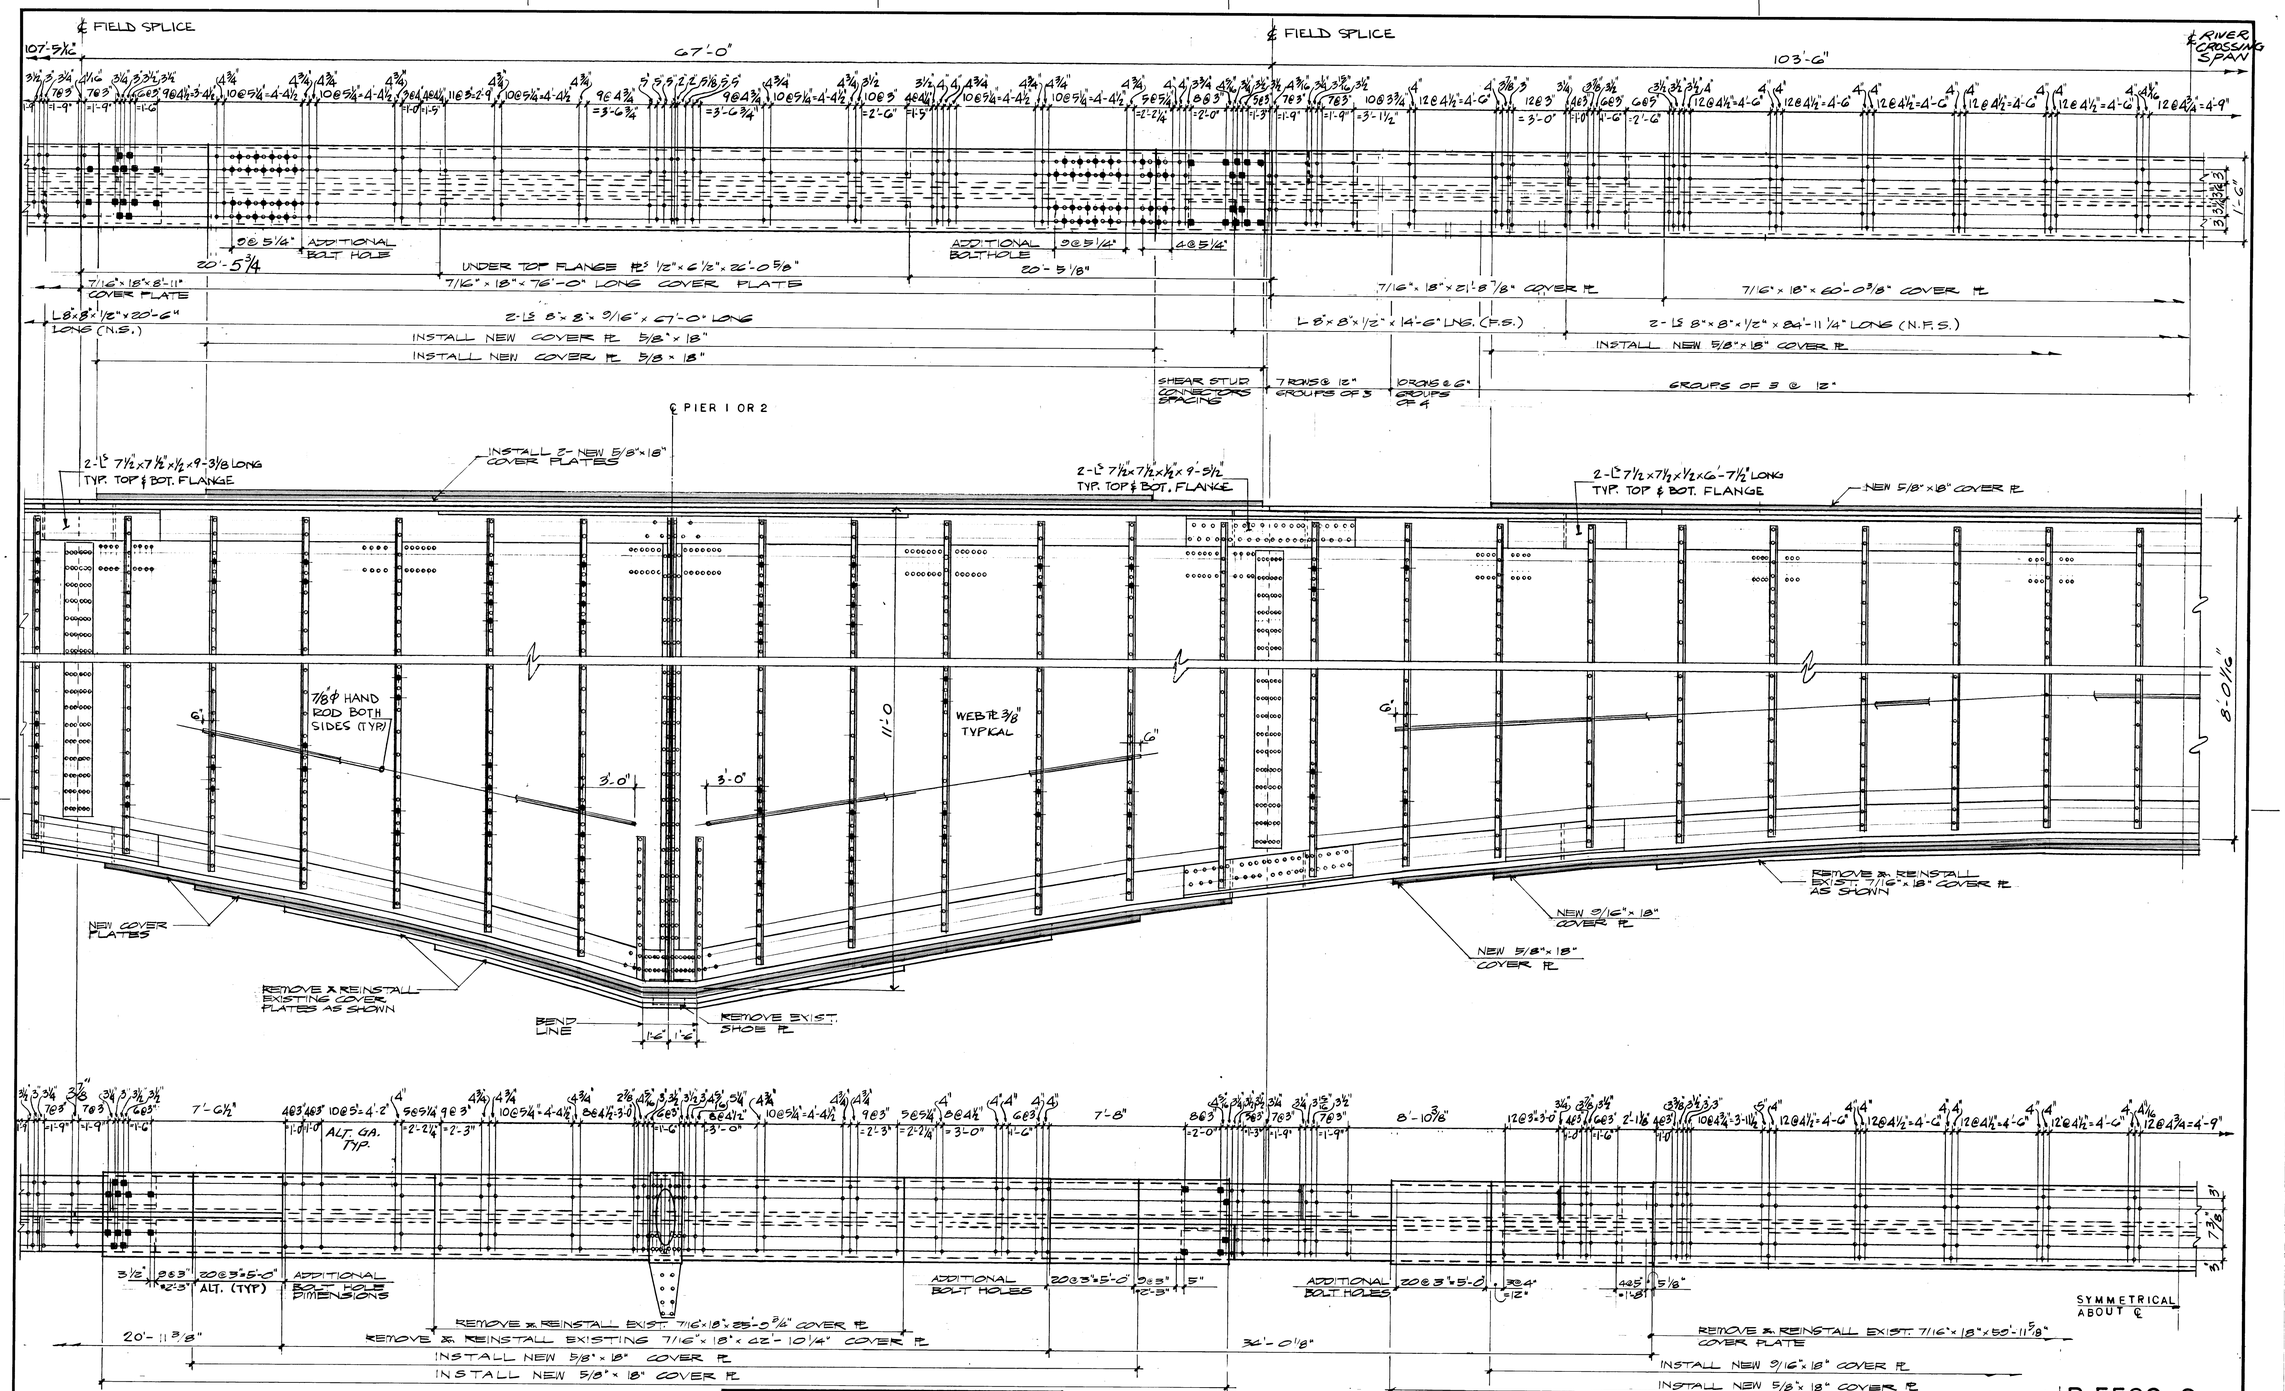

B-5520-9

LEGEND:
- ○ EXISTING 3/4" ϕ RIVETS
- ◆ NEW BOLT HOLES
- ■ 7/8" ϕ BOLTS

SEE GENERAL NOTES DWG. - 07

REID, CROWTHER & PARTNERS LIMITED
WINNIPEG
AS CONSTRUCTED
SIG. W. McCullen DATE 83/03/04

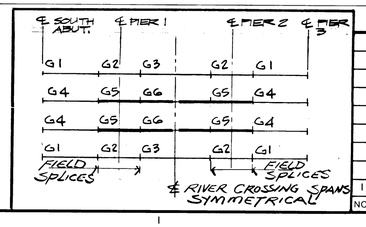

NO	REVISIONS	DATE	APP
1	AS BUILT	84 10 04	

ENGINEER'S SEAL

Reid, Crowther & Partners Limited
CONSULTING ENGINEERS AND PLANNERS
VANCOUVER CALGARY EDMONTON REGINA WINNIPEG TORONTO

DESIGNED BY: B.E.	DRAWN BY: R.S./G.A.S.
CHECKED BY: W.J.M.	DATE: 83 10 07
APPROVED BY: W. McCullen	DATE: 83/10/14

THE CITY OF WINNIPEG
WORKS & OPERATIONS DIVISION
STREETS & TRANSPORTATION DEPARTMENT

MIDTOWN BRIDGE
DECK RECONSTRUCTION, STRUCTURAL STRENGTHENING AND RELATED WORKS
MODIFICATIONS TO EXISTING GIRDERS
SPANS 1, 2 & 3 GIRDERS G5 & G6

AUTHORIZED BY: Columbia, P.Eng. 1983-11-28 STREETS & BRIDGES ENGINEER DATE
ACCEPTED BY: [illegible] P.Eng 83 11 28 BRIDGE ENGINEER DATE
SCALE: N.T.S.
DRAWING NO. B114 - 84 - 09

R.C.P.L. Nº 60532-09