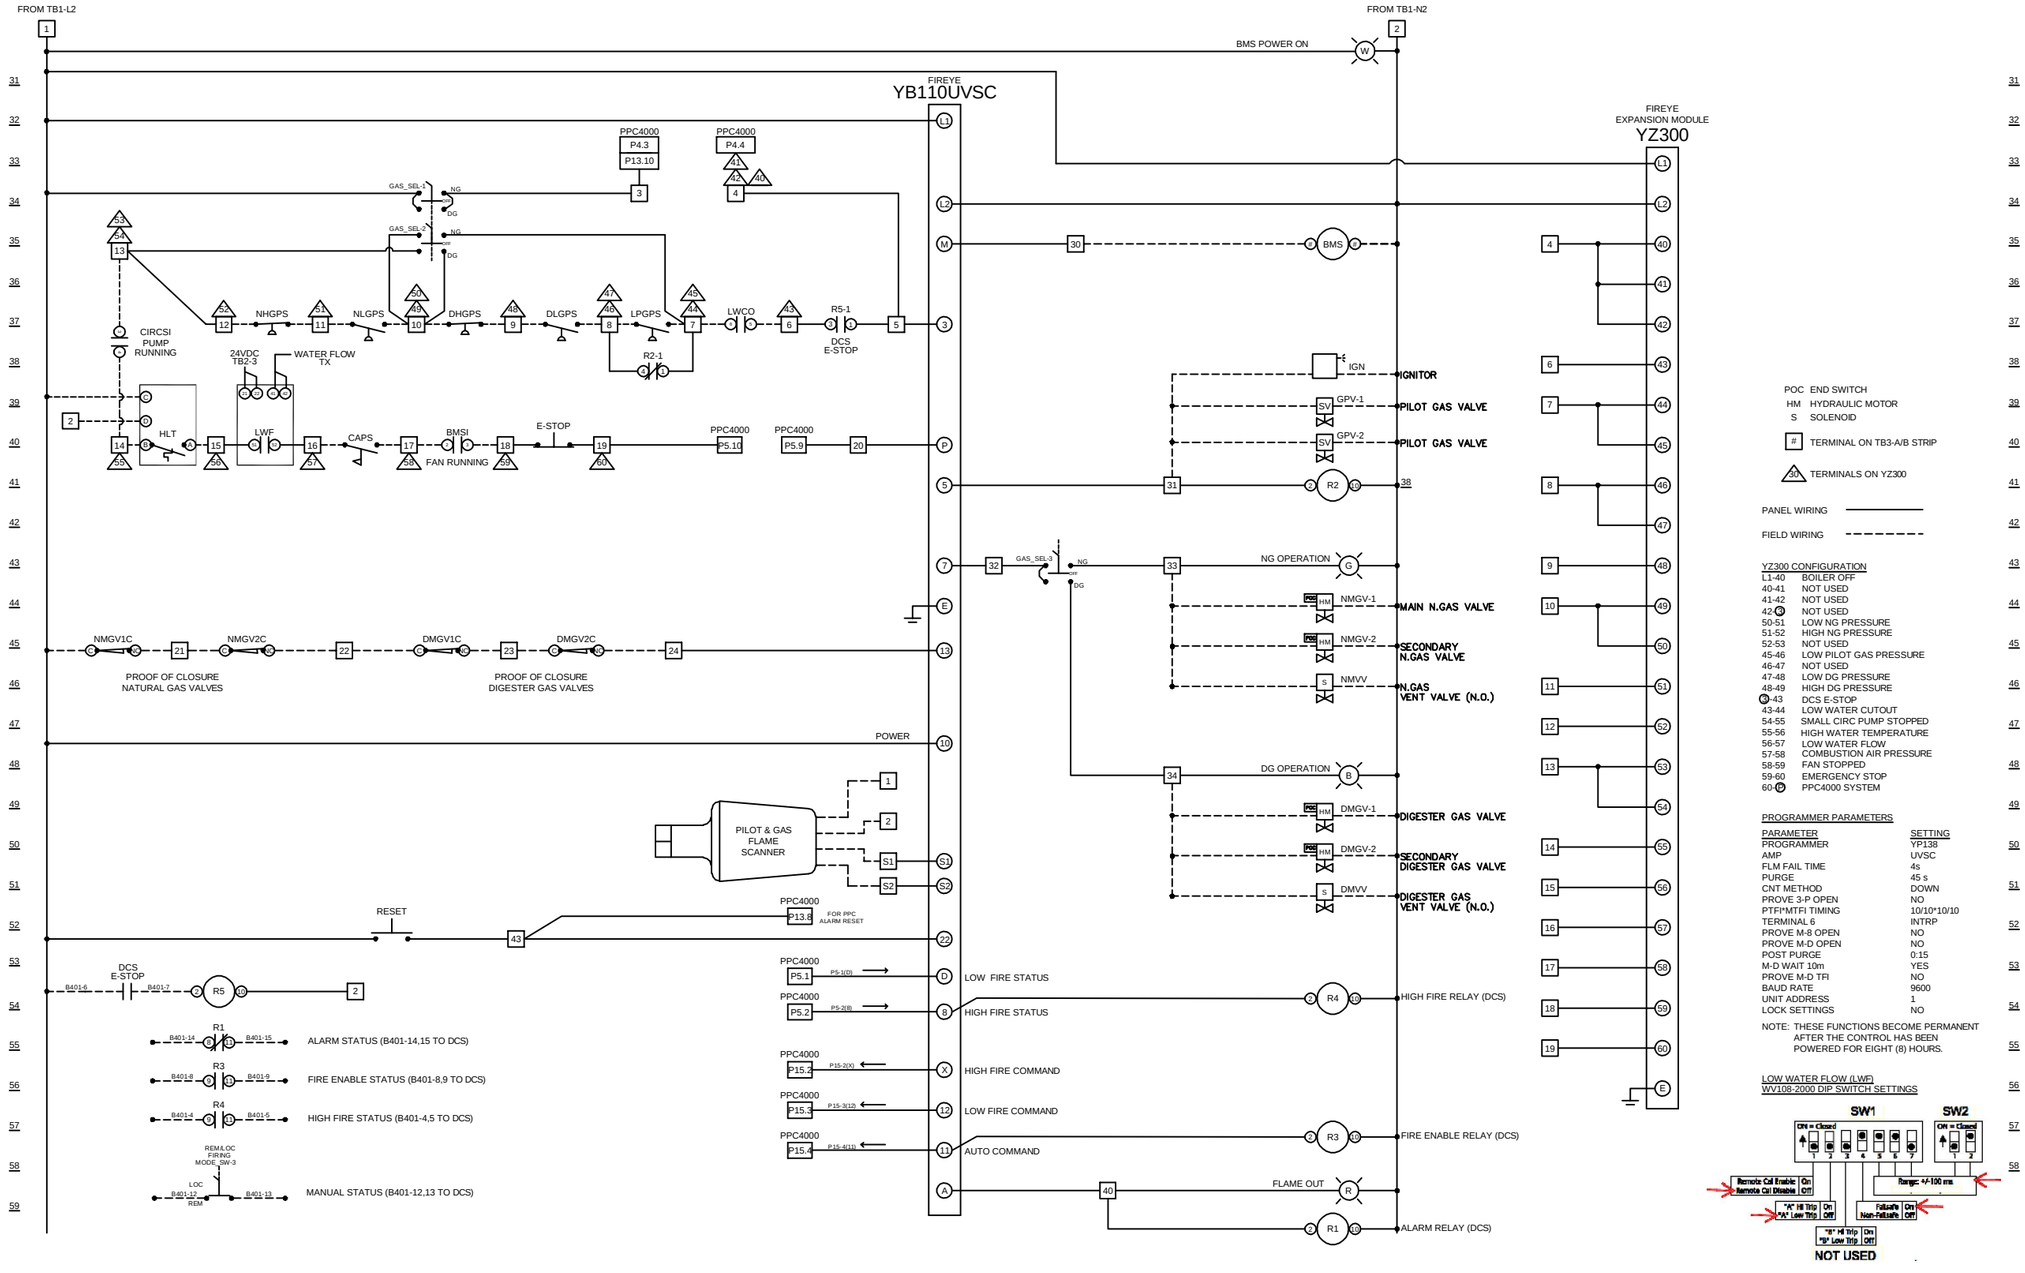


REVISION ## CHANGES
THE ENGINEER'S DESIGN RESPONSIBILITIES ARE LIMITED TO THE CHANGES INDICATED IN THE CLOUDED WORK

| | |
|---|---|
| DESIGNED BY: | CHECKED BY: |
| DRAWN BY: | APPROVED BY: |
| DATE: YYYY MM DD | RELEASED FOR CONSTR. DATE: YYYY MM DD |

B.M.
ELEV.

| NO. | REVISIONS | DATE (YYYY/MM/DD) | BY |
|---|---|---|---|
| 2 | AS BUILT | 2019/11/06 | EB |
| 1 | FOR CONSTRUCTION | 2019/10/18 | EB |
| 0 | FOR CUSTOMER REVIEW | 2019/09/23 | EB |

LAKESIDE

| | | | |
|---|---|---|---|
| DESIGNED BY | EB | CHECKED BY | JWB |
| DRAWN BY | SA | APPROVED BY | |
| SCALE: HORIZONTAL | 1:250 | RELEASED FOR CONSTRUCTION | |
| SCALE: VERTICAL | 1:50 | | |
| DATE | | DATE | |
| PLOT DATE: | | | |

ENGINEER'S SEAL

CONSULTANT DRAWING NUMBER
19-01-601-4E002-3

THE CITY OF WINNIPEG
WATER AND WASTE DEPARTMENT
ENGINEERING DIVISION

NORTH END WATER POLLUTION CONTROL CENTER
BOILER 4
# BMS SCHEMATIC

CITY DRAWING NUMBER
1-0101B-E0038-001

SHEET 1 OF 1